

COLUMBIA COUNTY PERMIT WORKSHEET

page 1 of 2


These worksheets must be completed and signed by the installer.
Submit the originals with the packet.

Installer Glenn Williams Jr License # 1H 1054858
 911 Address where home is being installed 1533 NW. Burch St.
 Manufacturer Fleetwood Length x width 28 x 48

NOTE: if home is a single wide fill out one half of the blocking plan
 if home is a triple or quad wide sketch in remainder of home

I understand Lateral Arm Systems cannot be used on any home (new or used) where the sidewall ties exceed 5 ft 4 in

Installer's initials GW

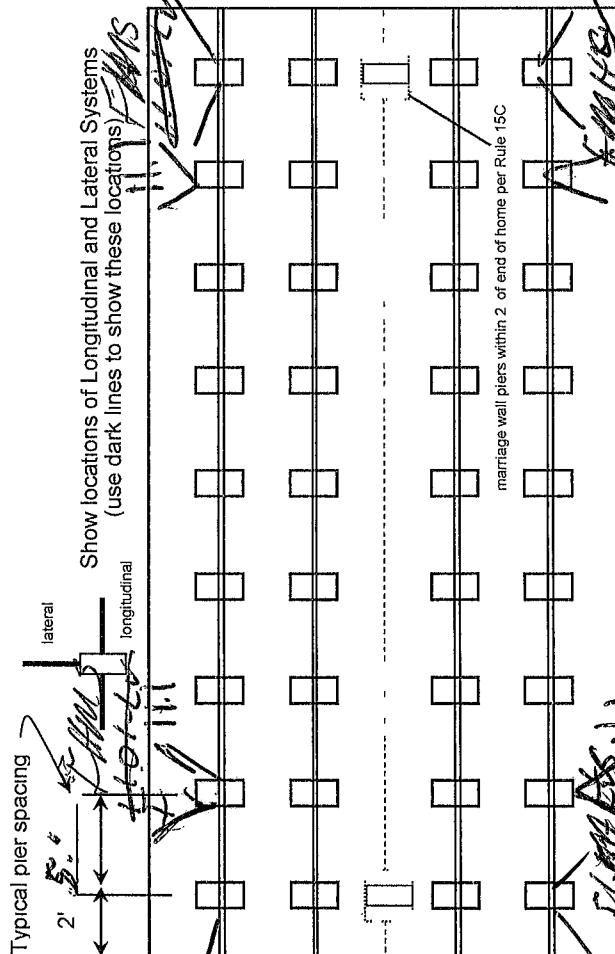

New Home ☐ Used Home ☒
 Home installed to the Manufacturer's Installation Manual ☐
 Home is installed in accordance with Rule 15-C ☒
 Single wide ☐ Wind Zone II ☒ Wind Zone III ☐
 Double wide ☒ Installation Decal # 21079
 Triple/Quad ☐ Serial # 7051134483089

PIER SPACING TABLE FOR USED HOMES

Load bearing capacity	Footer size (sq in)	16" x 16" (256)	18 1/2" x 18 1/2" (342)	20" x 20" (400)	22" x 22" (484)*	24" x 24" (576)*	26" x 26" (676)
1000 psf	3'	4'	5'	6'	7'	8'	8'
1500 psf	4'	5'	6'	7'	8'	8'	8'
2000 psf	6'	8'	8'	8'	8'	8'	8'
2500 psf	7'	8'	8'	8'	8'	8'	8'
3000 psf	8'	8'	8'	8'	8'	8'	8'
3500 psf	8'	8'	8'	8'	8'	8'	8'

* interpolated from Rule 15C-1 pier spacing table

PIER PAD SIZES

I-beam pier pad size 18 x 18
 Perimeter pier pad size 16 x 16
 Other pier pad sizes (required by the mfg) _____

Draw the approximate locations of marriage wall openings 4 foot or greater Use this symbol to show the piers

List all marriage wall openings greater than 4 foot and their pier pad sizes below

Opening Pier pad size
18 x 18
18 x 18

TIEDOWN COMPONENTS

Longitudinal Stabilizing Device (LSD)
 Manufacturer FLM
 Longitudinal Stabilizing Device w/ Lateral Arms
 Manufacturer _____

OTHER TIES

Sidewall _____
 Longitudinal _____
 Marriage wall _____
 Shearwall _____

Number 15

ANCHORS

4 ft 5 ft

FRAME TIES

within 2' of end of home spaced at 5' 4" oc ☒

COLUMBIA COUNTY PERMIT WORKSHEET

page 2 of 2

POCKET PENETROMETER TEST

The pocket penetrometer tests are rounded down to 1500 psf or check here to declare 1000 lb soil _____ without testing

x1500 x1500 x1500

POCKET PENETROMETER TESTING METHOD

- 1 Test the penmeter of the home at 6 locations
- 2 Take the reading at the depth of the footer
- 3 Using 500 lb increments, take the lowest reading and round down to that increment

x1500 x1500 x1500

TORQUE PROBE TEST

The results of the torque probe test is 280 inch pounds or check here if you are declaring 5' anchors without testing _____ A test showing 275 inch pounds or less will require 5 foot anchors

Note: A state approved lateral arm system is being used and 4 ft anchors are allowed at the sidewall locations I understand 5 ft anchors are required at all centerline tie points where the torque test reading is 275 or less and where the mobile home manufacturer may requires anchors with 4000 lb holding capacity _____ Installer's initials

ALL TESTS MUST BE PERFORMED BY A LICENSED INSTALLER

Installer Name Chad Williams JR
Date Tested 2-18-14

Electrical

Connect electrical conductors between multi-wide units, but not to the main power source This includes the bonding wire between multi-wide units Pg 15

Plumbing

Connect all sewer drains to an existing sewer tap or septic tank. Pg 15
Connect all potable water supply piping to an existing water meter, water tap, or other independent water supply systems Pg 15

Site Preparation

Debris and organic material removed Yes
Water drainage Natural _____ Swale _____ Pad ☒ Other _____

Fastening multi wide units

Floor Type Fastener lag Length 6 Spacing 12"
Walls Type Fastener Self Length 4 Spacing 12"
Roof Type Fastener Nail Length 6 Spacing 12"
For used homes a min 30 gauge, 8" wide, galvanized metal strip will be centered over the peak of the roof and fastened with galv roofing nails at 2" on center on both sides of the centerline

Gasket (weatherproofing requirement)

I understand a properly installed gasket is a requirement of all new and used homes and that condensation, mold, mildew and buckled marriage walls are a result of a poorly installed or no gasket being installed I understand a strip of tape will not serve as a gasket.

Installer's initials _____

Type gasket Foam

Installed ☒
Between Floors Yes ☒
Between Walls Yes ☒
Bottom of ridgebeam Yes ☒

Weatherproofing

The bottomboard will be repaired and/or taped Yes ☒ Pg 15
Siding on units is installed to manufacturer's specifications Yes ☒
Fireplace chimney installed so as not to allow intrusion of rain water Yes ☒

Miscellaneous

Skirting to be installed Yes ☒ No ☒
Dryer vent installed outside of skirting Yes ☒ N/A ☒
Range downflow vent installed outside of skirting Yes ☒ N/A ☒
Drain lines supported at 4 foot intervals Yes ☒
Electrical crossovers protected Yes ☒
Other _____

Installer verifies all information given with this permit worksheet is accurate and true based on the

Installer Signature Chad Williams JR Date 2-18-14