



Mobile Home Permit Worksheet

Installer:

Jerome Jordan License # IH 1129310

Address of home
being installed163 SW Riddle Ln
Lake City, FL 32024


Manufacturer

Length x width 56 x 24

NOTE: If home is a single wide fill out one half of the blocking plan
If home is a triple or quad wide sketch in remainder of home

I understand Lateral Arm Systems cannot be used on any home (new or used)
where the sidewall ties exceed 5 ft 4 in.

Installer's initials

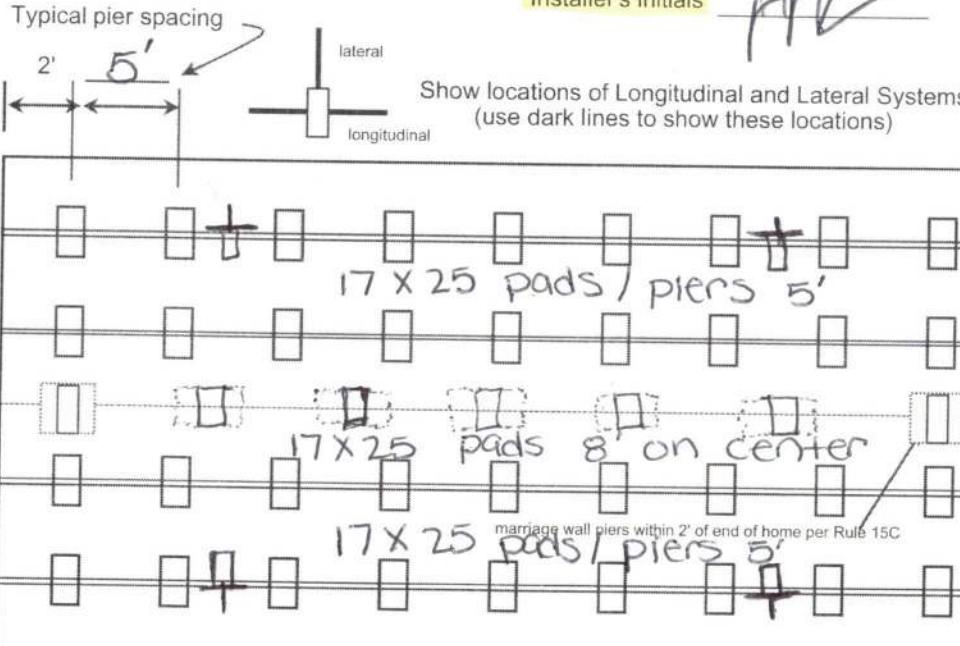

Permit Number: _____

Date: 11/11/25

New Home Used Home Home installed to the Manufacturer's Installation Manual
Home is installed in accordance with Rule 15-C

Single wide Wind Zone II Wind Zone III
 Double wide Installation Decal # _____
 Triple/Quad Serial # FLHMLCP36310830A1B

PIER SPACING TABLE FOR USED HOMES

Load bearing capacity	Footer size (sq in)	16" x 16" (256)	18 1/2" x 18 1/2" (342)	20" x 20" (400)	22" x 22" (484)*	24" X 24" (576)*	26" x 26" (676)
1000 psf	3'	4'	5'	6'	7'	8'	
1500 psf	4'6"	6'	7'	8'	8'	8'	
2000 psf	6'	8'	8'	8'	8'	8'	
2500 psf	7'6"	8'	8'	8'	8'	8'	
3000 psf	8'	8'	8'	8'	8'	8'	
3500 psf	8'	8'	8'	8'	8'	8'	

*interpolated from Rule 15C-1 pier spacing table.

PIER PAD SIZES

I-beam pier pad size

17 x 25

Perimeter pier pad size

16 x 16

Other pier pad sizes
(required by the mfg.)

—

Draw the approximate locations of marriage wall openings 4 foot or greater. Use this symbol to show the piers.

List all marriage wall openings greater than 4 foot and their pier pad sizes below.

Opening

Pier pad size

—	—	4 ft	5 ft	X
—	—			
—	—			

ANCHORS

FRAME TIES

within 2' of end of home
spaced at 5' 4" oc 40=50

TIEDOWN COMPONENTS

Longitudinal Stabilizing Device (LSD)

Manufacturer Oliver Technologies

Longitudinal Stabilizing Device w/ Lateral Arms

Manufacturer Oliver Technologies

Number

Sidewall
Longitudinal
Marriage Wall
Shear Wall4
3



Mobile Home Permit Worksheet

POCKET PENETROMETER TEST

The pocket penetrometer tests are rounded down to _____ psf or check here to declare 1000 lb. soil without testing.

X _____ X _____ X _____

POCKET PENETROMETER TESTING METHOD

1. Test the perimeter of the home at 6 locations.
2. Take the reading at the depth of the footer.
3. Using 500 lb. increments, take the lowest reading and round down to that increment.

X _____ X _____ X _____

TORQUE PROBE TEST

The results of the torque probe test is _____ inch pounds or check here if you are declaring 5' anchors without testing . A test showing 275 inch pounds or less will require 5' anchors.

Note: A state approved lateral arm system is being used and 4 ft. anchors are allowed at the sidewall locations. I understand 5' anchors are required at all centerline tie points where the torque test reading is 275 or less and where the mobile home manufacturer may require anchors with 4000 lb. holding capacity.

Installer's initials

ALL TESTS MUST BE PERFORMED BY A LICENSED INSTALLER

Installer Name Jerome Jordan

Date Tested _____

ELECTRICAL

Connect electrical conductors between multi-wide units, but not to the main power source. This includes the bonding wire between multi-wide units. Pg. 108

PLUMBING

Connect all sewer drains to an existing sewer tap or septic tank. Pg. 108

Connect all potable water supply piping to an existing water meter, water tap, or other independent water supply systems. Pg. 108

Permit Number: _____

Date: 11/11/25

Site Preparation

Debris and organic material removed _____.
Water drainage: Natural _____ Swale _____ Pad Other _____

Fastening multi wide units

Floor- Type Fastener: LAG Length: 6' Spacing: 24"
Walls- Type Fasterner: LAG Length: 6' Spacing: 24"
Roof- Type Fastener: LAG Length: 6' Spacing: 24"

For used homes a min. 30 gauge, 8" wide, galvanized metal strip will be centered over the peak of the roof and fastened with galv. roofing nails at 2" on center on both sides of the centerline.

Gasket (weatherproofing requirement)

I understand a properly installed gasket is a requirement of all new and used homes and that condensation, mold, mildew and buckled marriage walls are a result of a poorly installed or no gasket being installed. I understand a strip of tape will not serve as a gasket.

Installer's initials

Type gasket Foam

Pg. _____

Installed:

Between Floors-----Yes

Between Walls-----Yes

Bottom of ridge beam---Yes

Weatherproofing

The bottom board will be repaired and/or taped-----Yes Pg. _____.
Siding on units is installed to manufacturer's specifications-----Yes _____.
Fireplace chimney installed so as not to allow intrusion of rain water---Yes _____

Miscellaneous

Skirting to be installed.-----Yes No N/A
Dryer vent installed outside of skirting.-----Yes No N/A
Range downflow vent installed outside of skirting.---Yes No N/A
Drain lines supported at 4' intervals.-----Yes No N/A
Electrical crossovers protected.-----Yes No N/A
Other: _____

Installer verifies all information given with this permit worksheet is accurate and true based on the manufacturer's installation instructions and or Rule 15C-1 & 2

Installer's Signature

Date 11/11/25