

COLUMBIA COUNTY PERMIT WORKSHEET

page 1 of 2

These worksheets must be completed and signed by the installer.
Submit the originals with the packet.

Installer Glenn Williams SR License # IH-1054858
911 Address where home is being installed 898 SW Mauldin Ave
Lake City FL 32085
Manufacturer Fleetwood Length x width 14X70

NOTE: if home is a single wide fill out one half of the blocking plan
if home is a triple or quad wide sketch in remainder of home

I understand Lateral Arm Systems cannot be used on any home (new or used) where the sidewall ties exceed 5 ft 4 in
Installer's initials SW

New Home ☐ Used Home ☒
Home installed to the Manufacturer's Installation Manual ☐
Home is installed in accordance with Rule 15-C ☒
Single wide ☒ Wind Zone II ☒ Wind Zone III ☐
Double wide ☐ Installation Decal # 21060
Triple/Quad ☐ Serial # 9196

PIER SPACING TABLE FOR USED HOMES

Load bearing capacity	Footer size (sq in)	16" x 16" (256)	18 1/2" x 18 1/2" (342)	20" x 20" (400)	22" x 22" (484)*	24" x 24" (576)*	26" x 26" (676)
1000 psf	3'	3'	4'	5'	6'	7'	8'
1500 psf	4'	4'	6'	7'	8'	8'	8'
2000 psf	6'	6'	8'	8'	8'	8'	8'
2500 psf	7'	7'	8'	8'	8'	8'	8'
3000 psf	8'	8'	8'	8'	8'	8'	8'
3500 psf	8'	8'	8'	8'	8'	8'	8'

* interpolated from Rule 15C-1 pier spacing table

PIER PAD SIZES

I-beam pier pad size

17X22

Perimeter pier pad size

17X22

Other pier pad sizes (required by the mfg)

Draw the approximate locations of marriage wall openings 4 foot or greater Use this symbol to show the piers

List all marriage wall openings greater than 4 foot and their pier pad sizes below

Opening

Pier pad size

ANCHORS
4 ft X 5 ft

FRAME TIES

within 2' of end of home spaced at 5' 4" oc 2

TIEDOWN COMPONENTS

Longitudinal Stabilizing Device (LSD)

Manufacturer

Longitudinal Stabilizing Device w/ Lateral Arms

Manufacturer

OTHER TIES


Number

Sidewall

Longitudinal

Marriage wall

Shearwall

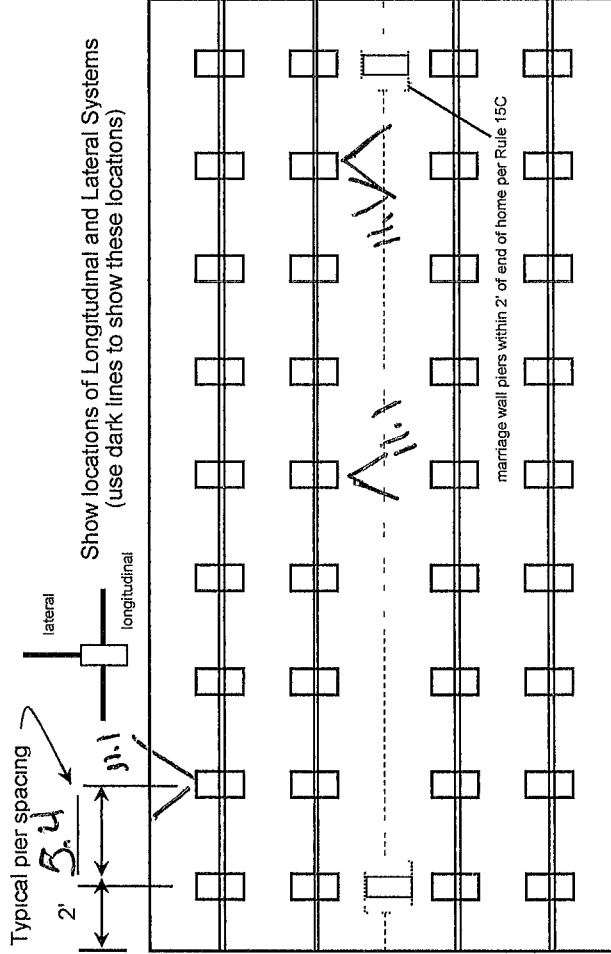

COLUMBIA COUNTY PERMIT WORKSHEET

page 2 of 2

POCKET PENETROMETER TEST

The pocket penetrometer tests are rounded down to 2000 psf or check here to declare 1000 lb soil without testing

x 2000 x 2000 x 2000

POCKET PENETROMETER TESTING METHOD

- 1 Test the perimeter of the home at 6 locations
- 2 Take the reading at the depth of the footer
- 3 Using 500 lb increments, take the lowest reading and round down to that increment.

x 2000 x 2000 x 2000

TORQUE PROBE TEST

The results of the torque probe test is 290 inch pounds or check here if you are declaring 5' anchors without testing A test showing 275 inch pounds or less will require 5 foot anchors

Note: A state approved lateral arm system is being used and 4 ft. anchors are allowed at the sidewall locations. I understand 5 ft anchors are required at all centerline tie points where the torque test reading is 275 or less and where the mobile home manufacturer may require anchors with 4000 lb holding capacity

Installer's initials

ALL TESTS MUST BE PERFORMED BY A LICENSED INSTALLER

Installer Name

Allen Williams Jr

Date Tested

4-30-14

Electrical

Connect electrical conductors between multi-wide units, but not to the main power source This includes the bonding wire between multi-wide units Pg

Plumbing

Connect all sewer drains to an existing sewer tap or septic tank Pg X

Connect all potable water supply piping to an existing water meter, water tap, or other independent water supply systems Pg

Site Preparation

Debris and organic material removed _____
Water drainage Natural _____ Swale _____ Pad X Other _____

Fastening multi wide units

Floor Type Fastener _____ Length _____ Spacing _____
Walls Type Fastener _____ Length _____ Spacing _____
Roof Type Fastener _____ Length _____ Spacing _____
For used homes a min 30 gauge, 8" wide, galvanized metal strip will be centered over the peak of the roof and fastened with galv roofing nails at 2" on center on both sides of the centerline

Gasket (weatherproofing requirement)

I understand a properly installed gasket is a requirement of all new and used homes and that condensation, mold, mildew and buckled marnage walls are a result of a poorly installed or no gasket being installed I understand a strip of tape will not serve as a gasket.

Installer's initials

Type gasket _____
Pg _____

Installed
Between Floors Yes
Between Walls Yes
Bottom of ridgebeam Yes

Weatherproofing

The bottomboard will be repaired and/or taped Yes X Pg _____
Siding on units is installed to manufacturer's specifications Yes _____
Fireplace chimney installed so as not to allow intrusion of rain water Yes _____

Miscellaneous

Skirting to be installed Yes _____ No X
Dryer vent installed outside of skirting Yes _____ N/A
Range downflow vent installed outside of skirting Yes _____ N/A
Drain lines supported at 4 foot intervals Yes _____
Electrical crossovers protected Yes _____
Other _____

Installer verifies all information given with this permit worksheet is accurate and true based on the

Installer Signature

Allen Williams Jr

Date

4-30-14