




Mobile Home Permit Worksheet

Installer: Stephen Weeks License # 141025306
 Address of home being installed: 13D Wilson Springs


Manufacturer: Champion Homes Length x width: 28x64

NOTE: If home is a single wide fill out one half of the blocking plan
 If home is a triple or quad wide sketch in remainder of home
 I understand Lateral Arm Systems cannot be used on any home (new or used)
 where the sidewall ties exceed 5 ft 4 in.

Installer's initials: SW

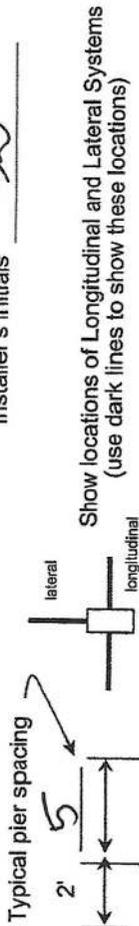

Show locations of Longitudinal and Lateral Systems
 (use dark lines to show these locations)

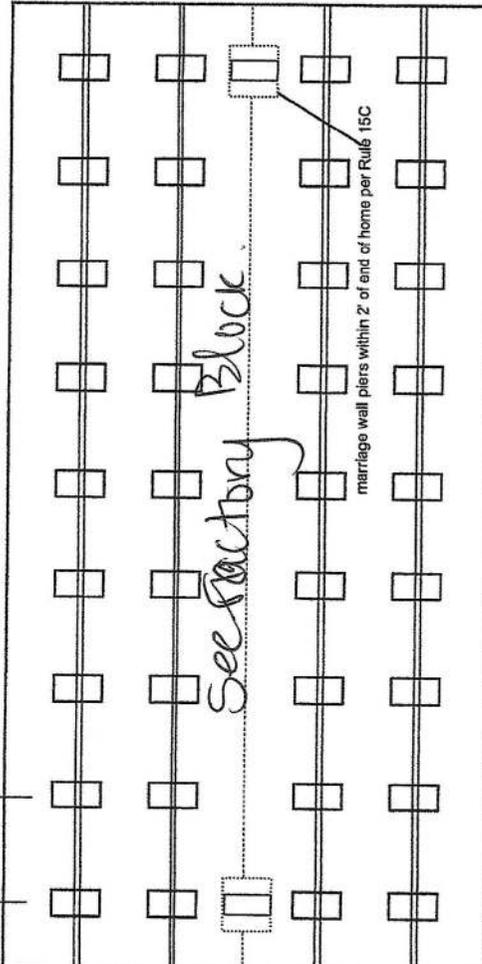

Permit Number: _____ Date: _____

New Home Used Home

Home installed to the Manufacturer's Installation Manual
 Home is installed in accordance with Rule 15-C

Single wide Wind Zone II Wind Zone III

Double wide Installation Decal # 125458

Triple/Quad Serial # 062-000-H-AS23073AB

PIER SPACING TABLE FOR USED HOMES

Load bearing capacity	Footer size (sq in)	16" x 16" (256)	18 1/2" x 18 1/2" (342)	20" x 20" (400)	22" x 22" (484)*	24" X 24" (576)*	26" x 26" (676)
1000 psf	3'	4'	5'	6'	7'	8'	8'
1500 psf	4'6"	6'	7'	8'	8'	8'	8'
2000 psf	6'	8'	8'	8'	8'	8'	8'
2500 psf	7'6"	8'	8'	8'	8'	8'	8'
3000 psf	8'	8'	8'	8'	8'	8'	8'
3500 psf	8'	8'	8'	8'	8'	8'	8'

*interpolated from Rule 15C-1 pier spacing table.

PIER PAD SIZES

I-beam pier pad size: 24x24
 Perimeter pier pad size: 16x16
 Other pier pad sizes (required by the mfg.): 24x24

POPULAR PAD SIZES

Pad Size	Sq In
16 x 16	256
16 x 18	288
18.5 x 18.5	342
16 x 22.5	360
17 x 22	374
13 1/2 x 26 1/4	348
20 x 20	400
17 3/16 x 25 3/16	441
17 1/2 x 25 1/2	446
24 x 24	576
26 x 26	676

Draw the approximate locations of marriage wall openings 4 foot or greater. Use this symbol to show the piers.

List all marriage wall openings greater than 4 foot and their pier pad sizes below.

Opening _____ Pier pad size _____

4 ft 5 ft

See factory Blocking Plan

ANCHORS
FRAME TIES

within 2' of end of home, spaced at 5' 4" oc

TIEDOWN COMPONENTS

Longitudinal Stabilizing Device (LSD)
 Manufacturer: Home pride
 Longitudinal Stabilizing Device w/ Lateral Arms
 Manufacturer: Home pride

OTHER TIES

Sidewall _____ Number _____
 Longitudinal _____
 Marriage Wall _____
 Shear Wall _____



Mobile Home Permit Worksheet

POCKET PENETROMETER TEST

The pocket penetrometer tests are rounded down to _____ psf or check here to declare 1000 lb. soil _____ without testing.

x 1000 x 1000 x 1000

POCKET PENETROMETER TESTING METHOD

1. Test the perimeter of the home at 6 locations.
2. Take the reading at the depth of the footer.
3. Using 500 lb. increments, take the lowest reading and round down to that increment.

x 1000 x 1000 x 1000

TORQUE PROBE TEST

The results of the torque probe test is _____ inch pounds or check here if you are declaring 5' anchors without testing _____. A test showing 275 inch pounds or less will require 5' anchors.

Note: A state approved lateral arm system is being used and 4 ft. anchors are allowed at the sidewall locations. I understand 5' anchors are required at all centerline tie points where the torque test reading is 275 or less and where the mobile home manufacturer may require anchors with 4000 lb. holding capacity.

Installer's initials SW

ALL TESTS MUST BE PERFORMED BY A LICENSED INSTALLER

Installer Name Stephen Weeks

Date Tested 12/11/2025

ELECTRICAL

Connect electrical conductors between multi-wide units, but not to the main power source. This includes the bonding wire between multi-wide units. Pg. _____

PLUMBING

Connect all sewer drains to an existing sewer tap or septic tank. Pg. _____
Connect all potable water supply piping to an existing water meter, water tap, or other independent water supply systems. Pg. _____

Permit Number: _____ Date: _____

Site Preparation

Debris and organic material removed
Water drainage: Natural _____ Swale _____ Pad Other _____

Fastening multi wide units

Floor- Type Fastener: lags Length: 4 Spacing: 7
 Walls- Type Fastener: lags Length: 7 Spacing: 7
 Roof- Type Fastener: lags Length: 7 Spacing: 7

For used homes a min. 30 gauge, 8" wide, galvanized metal strip will be centered over the peak of the roof and fastened with galv. roofing nails at 2" on center on both sides of the centerline.

Gasket (weatherproofing requirement)

I understand a properly installed gasket is a requirement of all new and used homes and that condensation, mold, mildew and buckled marriage walls are a result of a poorly installed or no gasket being installed. I understand a strip of tape will not serve as a gasket.

Installer's initials SW

Type gasket _____

Fluon

Installed:

Between Floors: _____ Yes

Between Walls: _____ Yes

Bottom of ridge beam: _____ Yes

Weatherproofing


The bottom board will be repaired and/or taped. _____ Yes Pg. _____
 Siding on units is installed to manufacturer's specifications. _____ Yes
 Fireplace chimney installed so as not to allow intrusion of rain water. _____ Yes

Miscellaneous

Skirting to be installed. _____ Yes No _____ N/A
 Dryer vent installed outside of skirting. _____ Yes No _____ N/A
 Range downflow vent installed outside of skirting. _____ Yes No _____ N/A
 Drain lines supported at 4' intervals. _____ Yes No _____ N/A
 Electrical crossovers protected. _____ Yes No _____ N/A
 Other: _____

Installer verifies all information given with this permit worksheet is accurate and true based on the manufacturer's installation instructions and or Rule 15C-1 & 2

Installer's Signature Stephen Weeks Date 12/11/2025

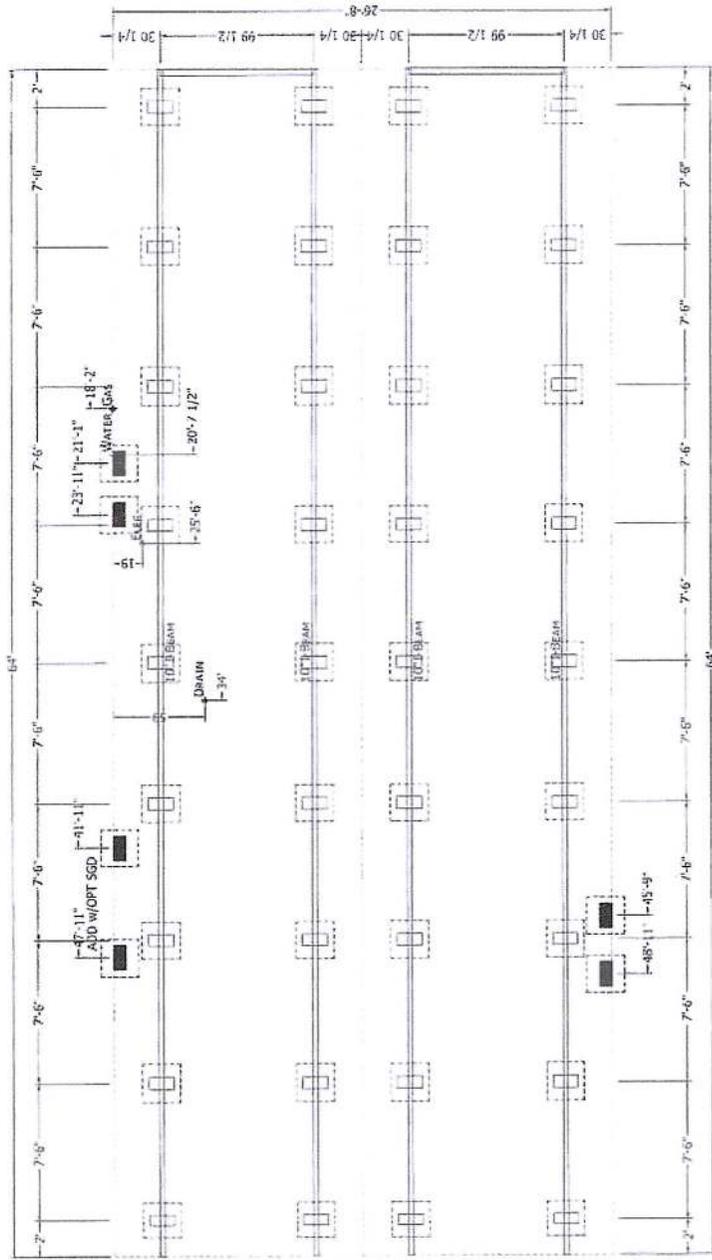

= FRAME PIER
 SEE INSTALLATION MANUAL FOR LOADS:

= POINT LOAD PIER
 SEE INSTALLATION MANUAL FOR LOADS

PLEASE READ AND UNDERSTAND THE FOLLOWING INFORMATION. THE MANUFACTURER DOES NOT DO FOUNDATION INSTALLATION OF HOMES IT WILL BE THE RESPONSIBILITY OF THE DEALER/SITE CONTRACTOR TO INSURE THAT ALL SITE WORK WILL CORRELATE WITH THE UNIT ORDERED

NOTICE TO HOME INSTALLERS: MANUFACTURED HOMES WEIGH SEVERAL TONS DO NOT ATTEMPT TO INSTALL ANY HOME ON SITE WITHOUT HAVING EXPERIENCE, KNOWLEDGE, AND UNDERSTANDING OF ALL INSTALLATION REQUIREMENTS. FAILURE TO MEET THESE REQUIREMENTS MAY RESULT IN SERIOUS INJURY OR DEATH TO AN INEXPERIENCED INSTALLER. INSTALLERS, PLEASE READ AND UNDERSTAND THE SET-UP AND INSTALLATION MANUAL SUPPLIED WITH THE HOME BEFORE ATTEMPTING ANY INSTALLATION OF ANY MANUFACTURED HOME

- 1) THE MANUFACTURER ASSUMES NO RESPONSIBILITY FOR ACTUAL FOUNDATION DESIGN AND CONSTRUCTION.
- 2) ADDITIONAL BLOCKING IS REQUIRED AT EACH SIDE OF EXTERIOR DOORS AND AT EACH SIDE OF SIDEWALL OPENINGS GREATER THAN 4 FEET IN WIDTH (I.E. PATIO DOORS, PICTURE WINDOWS, ETC.).
- 3) FOR PIER REQUIREMENTS AT ENDWALL SEE FIGURE 8 IN THE INSTALLATION MANUAL.
- 4) ALL DWV, PLUMBING, GAS SUPPLY, ETC. DIMENSIONS ON PRINT MAY BE + OR - 12".
- 5) IT WILL BE THE RESPONSIBILITY OF THE SITE CONTRACTOR TO VERIFY THE PROPER LOCATION OF COLUMN SUPPORT BLOCKING AND TO VERIFY THE PROPER MATING LINE GROWTH DIMENSIONS BASED UPON ACTUAL SITE CONDITIONS AND REQUIREMENTS (DOUBLE WIDES ONLY).
- 6) ALLOW 1/2" AT MATING LINE FOR MATE UP GROWTH.
- 7) SEE SET-UP AND INSTALLATION MANUAL FOR PERIMETER BLOCKING REQUIREMENTS.
- 8) FOOTER SIZES ARE DEPENDENT ON MATERIAL USED, SOIL CONDITIONS, AND LOADS GENERATED FROM THE INSTALLATION MANUAL.

PERMANENT FOUNDATIONS: CHECK LOCAL BUILDING CODES AND REGULATIONS AND CONSULT A REGISTERED PROFESSIONAL OR STRUCTURAL ENGINEER WHEN YOU ARE SITING YOUR HOME ON A PERMANENT FOUNDATION (SUCH AS A FULL BASEMENT, CRAWL SPACE, OR LOAD BEARING PERIMETER FOUNDATION)



255 W. I-65 SERVICE ROAD, SUITE 1000, TROY, MI 48068
PHONE: 248-464-8200

MODIFICATIONS

PROJECT

TITLE

SHEET

PIER FOUNDATION PLAN

PR-101

2864H42A7C
64'-0" X 26'-8"
4 BD 2 BT



MEMBER: DA-2001-R20C(20A)

DRAWN BY: SP/CH/MLM
DATE: 11-13-24
SCALE: 1/8" = 1'-0"


PROPRIETARY AND CONFIDENTIAL
© 2024 CHAMPION HOMES, A DIVISION OF CHAMPION
11/24/24 10:00 AM 10/24/24

Q2013051

Stock

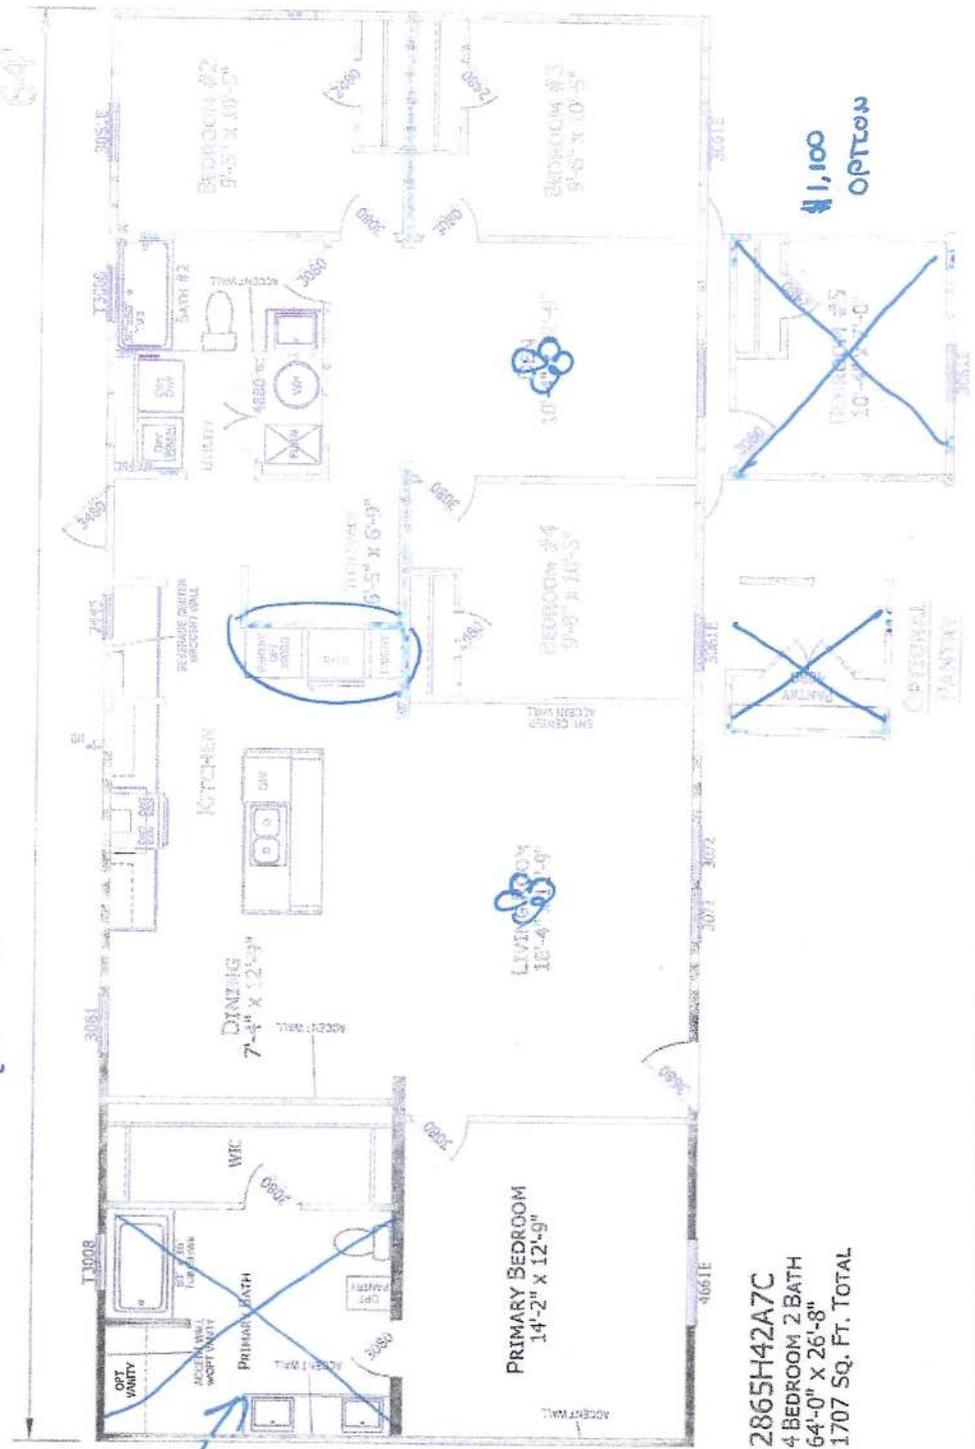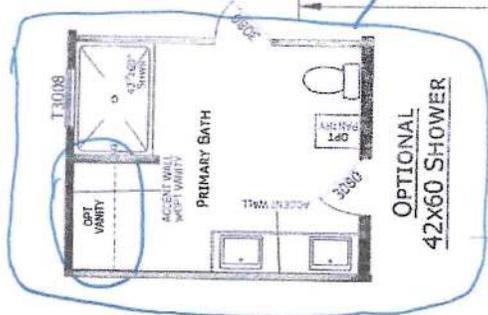

2865H42A7C
 4 BEDROOM 2 BATH
 64'-0" x 26'-8"
 1707 Sq. Ft. TOTAL

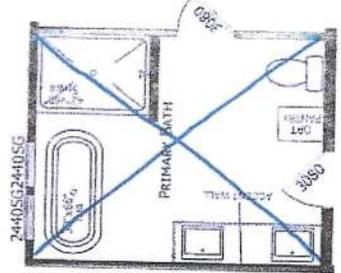

PROJECT	2865H42A7C	DATE	11/13/24
CLIENT	64'-0" x 26'-8"	DESIGNED BY	2865H42A7C
DATE	11/13/24	SCALE	1/4" = 1'-0"
PROJECT	2865H42A7C	DATE	11/13/24
CLIENT	64'-0" x 26'-8"	DESIGNED BY	2865H42A7C
DATE	11/13/24	SCALE	1/4" = 1'-0"
PROJECT	2865H42A7C	DATE	11/13/24
CLIENT	64'-0" x 26'-8"	DESIGNED BY	2865H42A7C
DATE	11/13/24	SCALE	1/4" = 1'-0"

OPTIONAL GLAMOUR BATH