



PERMIT WORKSHEET

page 1 of 2

PERMIT NUMBER

Installer Ernest Scott Johnson License # IH-1025249Installer Mobile Phone # 352-494-8099Address of home
being installed _____Manufacturer ScotBilt Length x width 56x28NOTE: If home is a single wide fill out one half of the blocking plan
if home is a triple or quad wide sketch in remainder of homeI understand Lateral Arm Systems cannot be used on any home (new or used)
where the sidewall ties exceed 5 ft 4 in.Installer's initials ES

Typical pier spacing

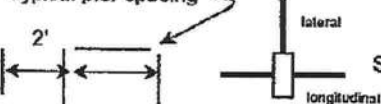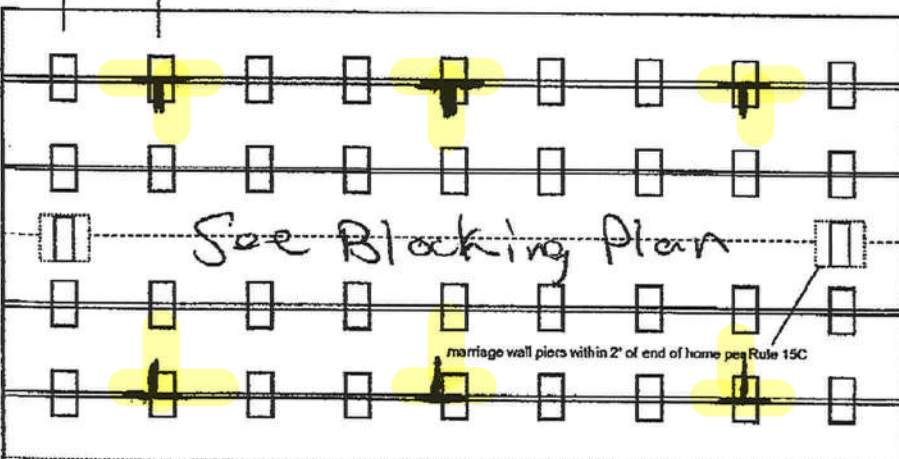Show locations of Longitudinal and Lateral Systems
(use dark lines to show these locations)Digitally signed
by Laurie
HodsonDate:
2020.10.09
11:26:26 -04'00'New Home ☒ Used Home ☐Home installed to the Manufacturer's Installation Manual ☒Home is installed in accordance with Rule 15-C ☐Single wide ☐ Wind Zone II ☒ Wind Zone III ☐Double wide ☒ Installation Decal # 74429Triple/Quad ☐ Serial # _____Roof System: ☒ Typical ☐ Hinged

PIER SPACING TABLE FOR USED HOMES

Load bearing capacity	Footer size (sq in)	16' x 16' (256)	18 1/2' x 18 1/2' (342)	20' x 20' (400)	22' x 22' (484)*	24' x 24' (576)*	26' x 26' (676)
1000 psf		3'	4'	5'	6'	7'	8'
1500 psf		4' 6"	6'	7'	8'	8'	8'
2000 psf		6'	8'	8'	8'	8'	8'
2500 psf		7' 6"	8'	8'	8'	8'	8'
3000 psf		8'	8'	8'	8'	8'	8'
3500 psf		8'	8'	8'	8'	8'	8'

* Interpolated from Rule 15C-1 pier spacing table.

PIER PAD SIZES

I-beam pier pad size 23x31 70c
Perimeter pier pad size 11 or 16x18Other pier pad sizes
(required by the mfg.) _____

Draw the approximate locations of marriage wall openings 4 foot or greater. Use this symbol to show the piers.

List all marriage wall openings greater than 4 foot and their pier pad sizes below.

Opening Pier pad size

- ① 17.5x25.5 ④ 17.5x25.5
 ② Triple 17.5x25.5
 ③ 17.5x25.5

TIEDOWN COMPONENTS

Longitudinal Stabilizing Device (LSD)

Manufacturer _____

Longitudinal Stabilizing Device w/ Lateral Arms

Manufacturer Oliver 1101

POPULAR PAD SIZES

Pad Size	Sq In
16 x 16	256
16 x 18	288
18.5 x 18.5	342
16 x 22.5	360
17 x 22	374
13 1/4 x 26 1/4	348
20 x 20	400
17 3/16 x 25 3/16	441
17 1/2 x 25 1/2	448
24 x 24	576
26 x 26	676

ANCHORS

4 ft 5 ft

FRAME TIES

within 2' of end of home
spaced at 5' 4" oc

OTHER TIES

Sidewall
Longitudinal
Marriage wall
ShearwallNumber
26
8
10
2

PERMIT NUMBER

PERMIT WORKSHEET

page 2 of 2

POCKET PENETROMETER TEST

The pocket penetrometer tests are rounded down to _____ psf or check here to declare 1000 lb. soil _____ without testing.

x 1200 x 1000 x 1000

POCKET PENETROMETER TESTING METHOD

1. Test the perimeter of the home at 6 locations.
2. Take the reading at the depth of the footer.
3. Using 500 lb. increments, take the lowest reading and round down to that increment.

x 1000 x 1000 x 1000

TORQUE PROBE TEST

The results of the torque probe test is _____ inch pounds or check here if you are declaring 5' anchors without testing _____. A test showing 275 inch pounds or less will require 5 foot anchors.

Note: A state approved lateral arm system is being used and 4 ft. anchors are allowed at the sidewall locations. I understand 5 ft anchors are required at all centerline tie points where the torque test reading is 275 or less and where the mobile home manufacturer may require anchors with 4000 lb holding capacity.

ES Installer's initials

ALL TESTS MUST BE PERFORMED BY A LICENSED INSTALLER

Installer Name Ernest Scott Johnson

Date Tested Assumed Oliver 1101 v uses

485 foot Anchors Both

Electrical

Connect electrical conductors between multi-wide units, but not to the main power source. This includes the bonding wire between multi-wide units. Pg. _____

Plumbing

Connect all sewer drains to an existing sewer tap or septic tank. Pg. _____

Connect all potable water supply piping to an existing water meter, water tap, or other independent water supply systems. Pg. _____



Site Preparation

Debris and organic material removed _____
Water drainage: Natural _____ Swale _____ Pad X Other _____

Fastening multi wide units

Floor: Type Fastener: lag Length: 7 Spacing: 24
Walls: Type Fastener: lag Length: 4 Spacing: 12
Roof: Type Fastener: lag Length: 7 Spacing: 24
For used homes a min. 30 gauge, 8" wide, galvanized metal strip will be centered over the peak of the roof and fastened with galv. roofing nails at 2" on center on both sides of the centerline.

Gasket (weatherproofing requirement)

I understand a properly installed gasket is a requirement of all new and used homes and that condensation, mold, mildew and buckled marriage walls are a result of a poorly installed or no gasket being installed. I understand a strip of tape will not serve as a gasket.

Installer's initials ES

Type gasket _____
Pg. 211

Installed:
Between Floors Yes X
Between Walls Yes X
Bottom of ridgebeam Yes X

Weatherproofing

The bottomboard will be repaired and/or taped. Yes X Pg. _____
Siding on units is installed to manufacturer's specifications. Yes X
Fireplace chimney installed so as not to allow intrusion of rain water. Yes X

Miscellaneous

Skirting to be installed. Yes X No X
Dryer vent installed outside of skirting. Yes X N/A X
Range downflow vent installed outside of skirting. Yes X N/A X
Drain lines supported at 4 foot intervals. Yes X
Electrical crossovers protected. Yes X
Other: _____

Installer verifies all information given with this permit worksheet is accurate and true based on the manufacturer's installation instructions and or Rule 15C-1 & 2

Installer Signature Ernest Scott Johnson Date _____

DATE: 02/02/2017
 VERSION: A
 REFERENCE: M256

AREA

TOTAL: 1,456 R²
 LIVING SPACE: 1,456 R²
 PORCH: 0 R²

UNIT SPECIFICATIONS:

GRAND SLAM
 28' X 50'
 3 BEDROOM / 2 BATH


DRAWING/MODEL NUMBER:

2856256GSM

ScotBlit
 HOMES, INC.



HITCH-END

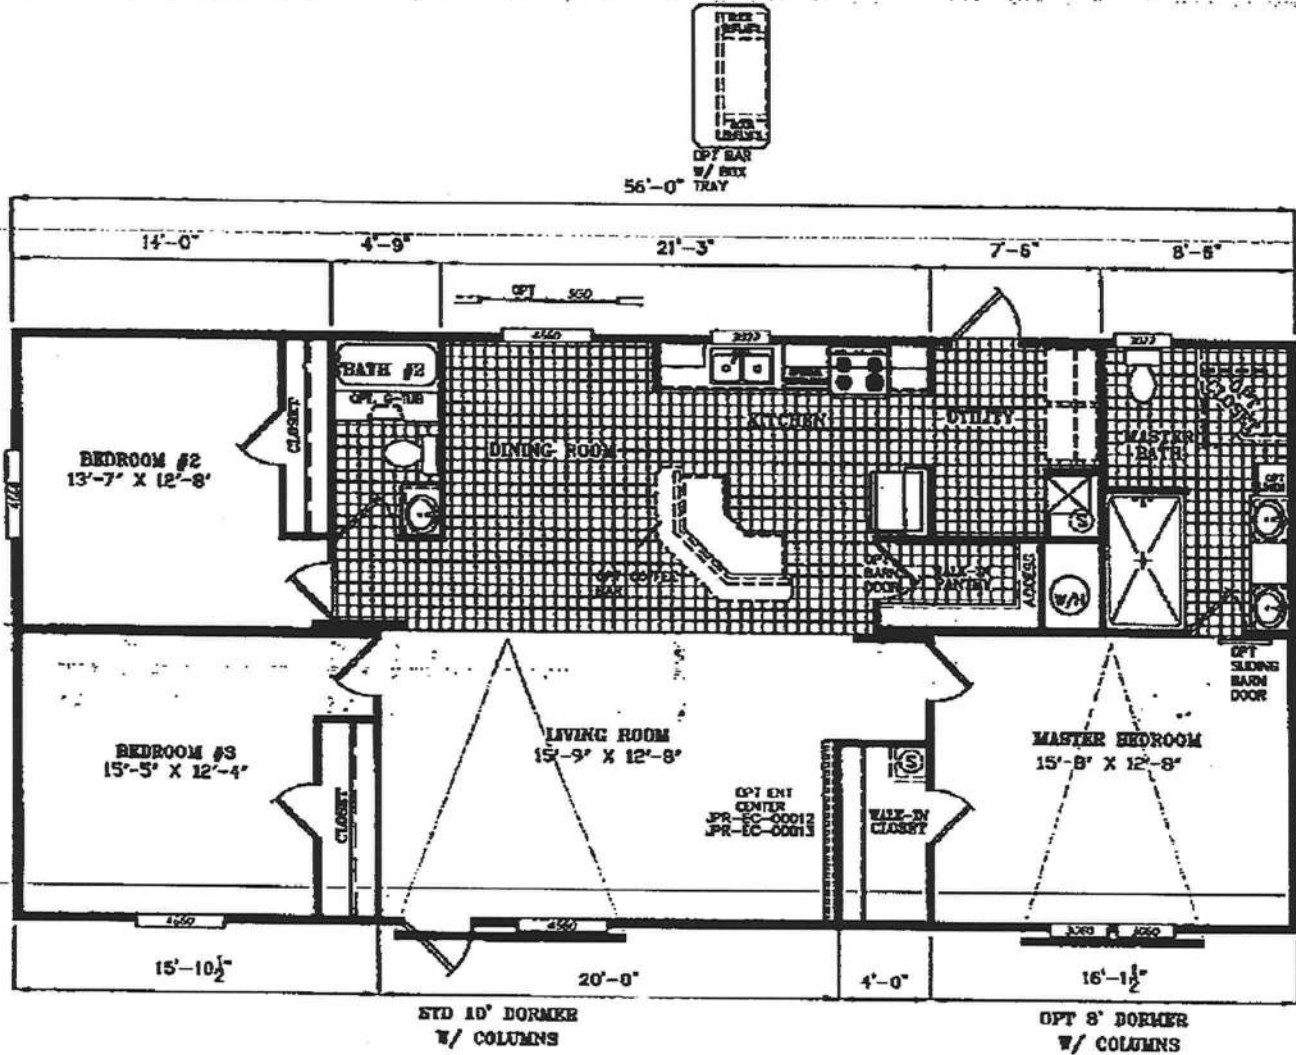

2020-10-05 10:25

C&G Mfg. Homes 3867552386 >> 3524814807

p 6/6

PIER	PIER LOAD (LBS)	REQ. FOOTING AREA (SQ. IN.)
A	1365	267
B	3315	579
C	1755	329
D	1950	360

DATE: 02/02/2017

VERSION C

REFERENCE: M356

AREA	TOTAL:	1,455 ft ²
LIVING SPACE:	1,455 ft ²	
PORCH:	0 ft ²	


UNIT SPECIFICATIONS:

GRAND SLAM
28' x 50'
3 BEDROOM / 2 BATH

DRAWING/MODEL NUMBER:

2856256GSM

ScotBlitt
HOMES, INC.

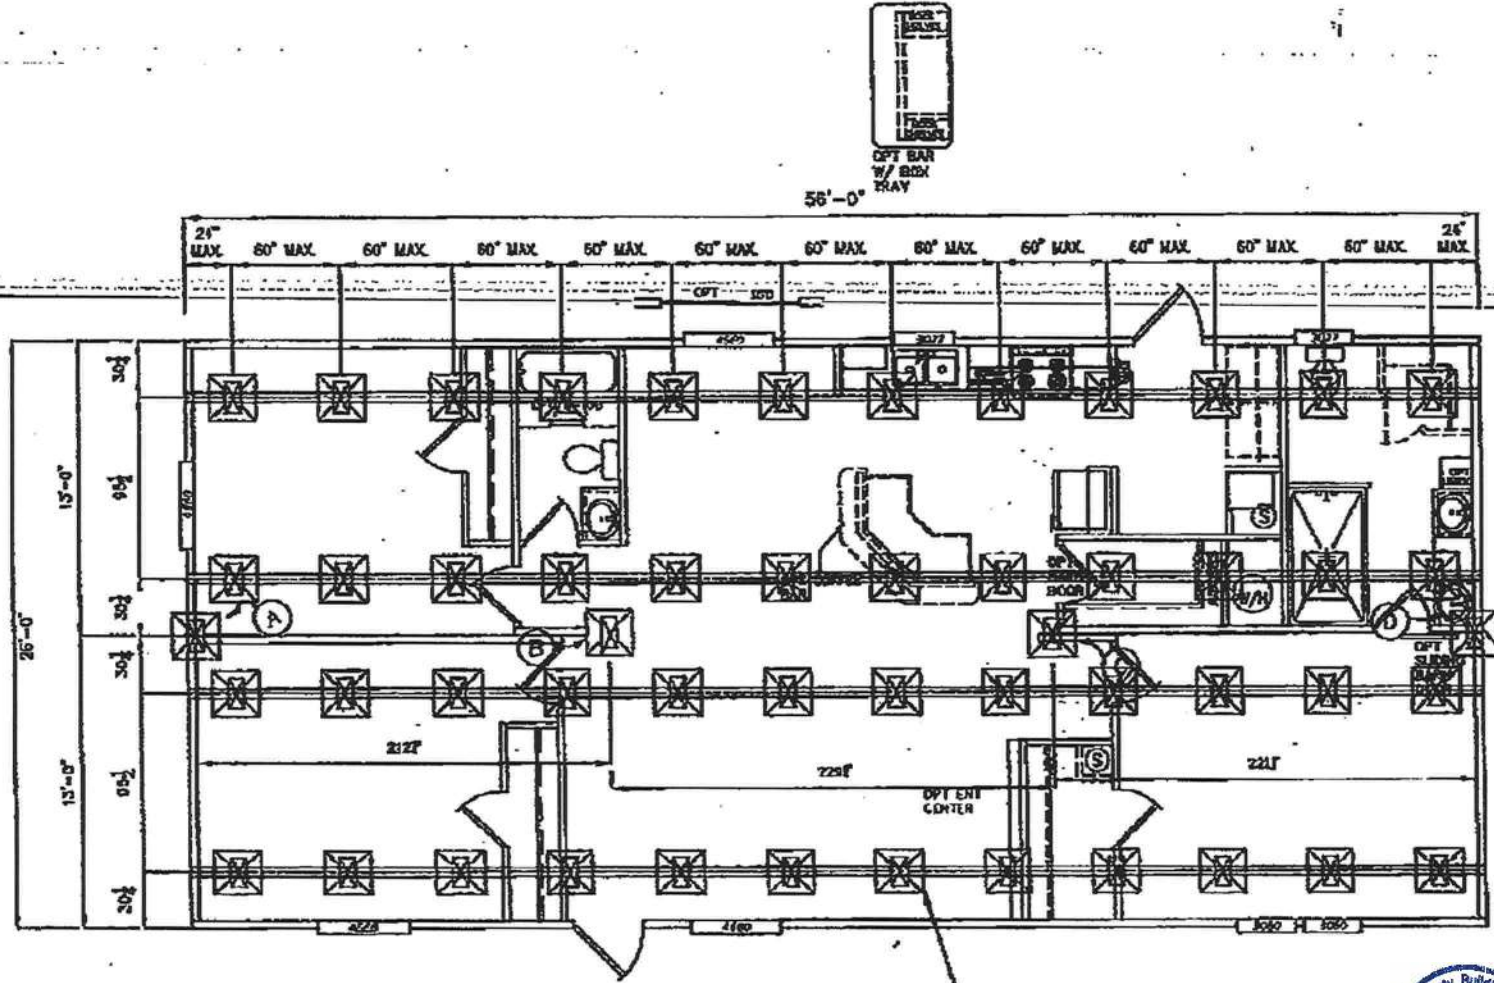

FLORIDA MULTIWIDE PIERING DIAGRAM
TYPICAL PIER PAD
20'x20' MIN. @ 60" O.C. MAX.