



Mobile Home Permit Worksheet

Installer : Gary Brock

License # ih1138289

Address of home
being installed

175 SW Bessie Glen
Lake City FL 32024
CHAMPION 44 x 23'4"


Manufacturer

NOTE: If home is a single wide fill out one half of the blocking plan
If home is a triple or quad wide sketch in remainder of home


I understand Lateral Arm Systems cannot be used on any home (new or used)
where the sidewall ties exceed 5 ft 4 in.

Installer's initials GB

Typical pier spacing

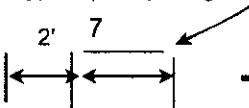

Show locations of Longitudinal and Lateral Systems
(use dark lines to show these locations)

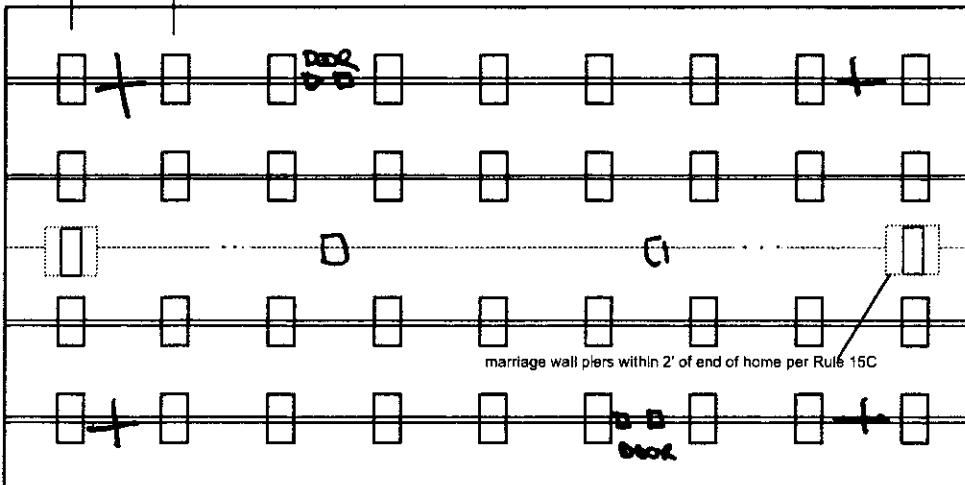

Permit Number: _____ Date: _____

New Home Used Home

Home installed to the Manufacturer's Installation Manual
Home is installed in accordance with Rule 15-C

Single wide Wind Zone II Wind Zone III
Double wide Installation Decal # 123614
Triple/Quad Serial # FL26100PHA16793A1B

PIER SPACING TABLE FOR USED HOMES

Load bearing capacity	Footer size (sq in)	16" x 16" (256)	18 1/2" x 18 1/2" (342)	20" x 20" (400)	22" x 22" (484)*	24" X 24" (576)*	26" x 26" (676)
✓ 1000 psf	3'	4'	5'	6'	7' ✓	8'	
1500 psf	4'6"	6'	7'	8'	8'	8'	
2000 psf	6'	8'	8'	8'	8'	8'	
2500 psf	7'6"	8'	8'	8'	8'	8'	
3000 psf	8'	8'	8'	8'	8'	8'	
3500 psf	8'	8'	8'	8'	8'	8'	

*interpolated from Rule 15C-1 pier spacing table.

PIER PAD SIZES

I-beam pier pad size 24x24

Perimeter pier pad size 16x16

Other pier pad sizes (required by the mfg.)

Draw the approximate locations of marriage wall openings 4 foot or greater. Use this symbol to show the piers.

List all marriage wall openings greater than 4 foot and their pier pad sizes below.

Opening Pier pad size 4 ft X 5 ft

8' 24 x 24

ANCHORS

FRAME TIES

within 2' of end of home - spaced at 5' 4" oc

TIEDOWN COMPONENTS

Longitudinal Stabilizing Device (LSD)

Manufacturer Oliver

Longitudinal Stabilizing Device w/ Lateral Arms

Manufacturer Oliver

Number

Sidewall 9

Longitudinal 4

Marriage Wall 10

Shear Wall 4



Mobile Home Permit Worksheet

POCKET PENETROMETER TEST

The pocket penetrometer tests are rounded down to _____ psf or check here to declare 1000 lb. soil without testing.

POCKET PENETROMETER TESTING METHOD

1. Test the perimeter of the home at 6 locations.
2. Take the reading at the depth of the footer.
3. Using 500 lb. increments, take the lowest reading and round down to that increment.

TORQUE PROBE TEST

The results of the torque probe test is ²⁸⁶ inch pounds or check here if you are declaring 5' anchors without testing . A test showing 275 inch pounds or less will require 5' anchors.

Note: A state approved lateral arm system is being used and 4 ft. anchors are allowed at the sidewall locations. I understand 5' anchors are required at all centerline tie points where the torque test reading is 275 or less and where the mobile home manufacturer may require anchors with 4000 lb. holding capacity.

Installer's initials GB

ALL TESTS MUST BE PERFORMED BY A LICENSED INSTALLER

Installer Name GARY BROCK

Date Tested _____

ELECTRICAL

Connect electrical conductors between multi-wide units, but not to the main power source. This includes the bonding wire between multi-wide units. Pg. ¹⁵

PLUMBING

Connect all sewer drains to an existing sewer tap or septic tank. Pg. ¹⁵

Connect all potable water supply piping to an existing water meter, water tap, or other independent water supply systems. Pg. ¹⁵

Permit Number: _____

Date: _____

Site Preparation

Debris and organic material removed

Water drainage: Natural Swale Pad Dirt Other

Fastening multi wide units

Floor- Type Fastener: 3x8x6 Length: 6 Spacing: 18

Walls- Type Fastener: 3x8x6 Length: 6 Spacing: 24

Roof- Type Fastener: 3x8x6 Length: 6 Spacing: 18

For used homes a min. 30 gauge, 8" wide, galvanized metal strip will be centered over the peak of the roof and fastened with galv. roofing nails at 2" on center on both sides of the centerline.

Gasket (weatherproofing requirement)

I understand a properly installed gasket is a requirement of all new and used homes and that condensation, mold, mildew and buckled marriage walls are a result of a poorly installed or no gasket being installed. I understand a strip of tape will not serve as a gasket.

Installer's initials GB

Type gasket-----Foam

Pg. 14

Installed:

Between Floors-----Yes

Between Walls-----Yes

Bottom of ridge beam-----Yes

Weatherproofing

The bottom board will be repaired and/or taped.-----Yes Pg. _____

Siding on units is installed to manufacturer's specifications.-----Yes

Fireplace chimney installed so as not to allow intrusion of rain water.-----Yes

Miscellaneous

Skirting to be installed.-----Yes No N/A

Dryer vent installed outside of skirting.-----Yes No N/A

Range downflow vent installed outside of skirting.-----Yes No N/A

Drain lines supported at 4' intervals.-----Yes No N/A

Electrical crossovers protected.-----Yes No N/A


Other: _____

Installer verifies all information given with this permit worksheet is accurate and true based on the manufacturer's installation instructions and or Rule 15C-1 & 2

Installer's Signature

Date

end to end flip- all measurements from hitch end

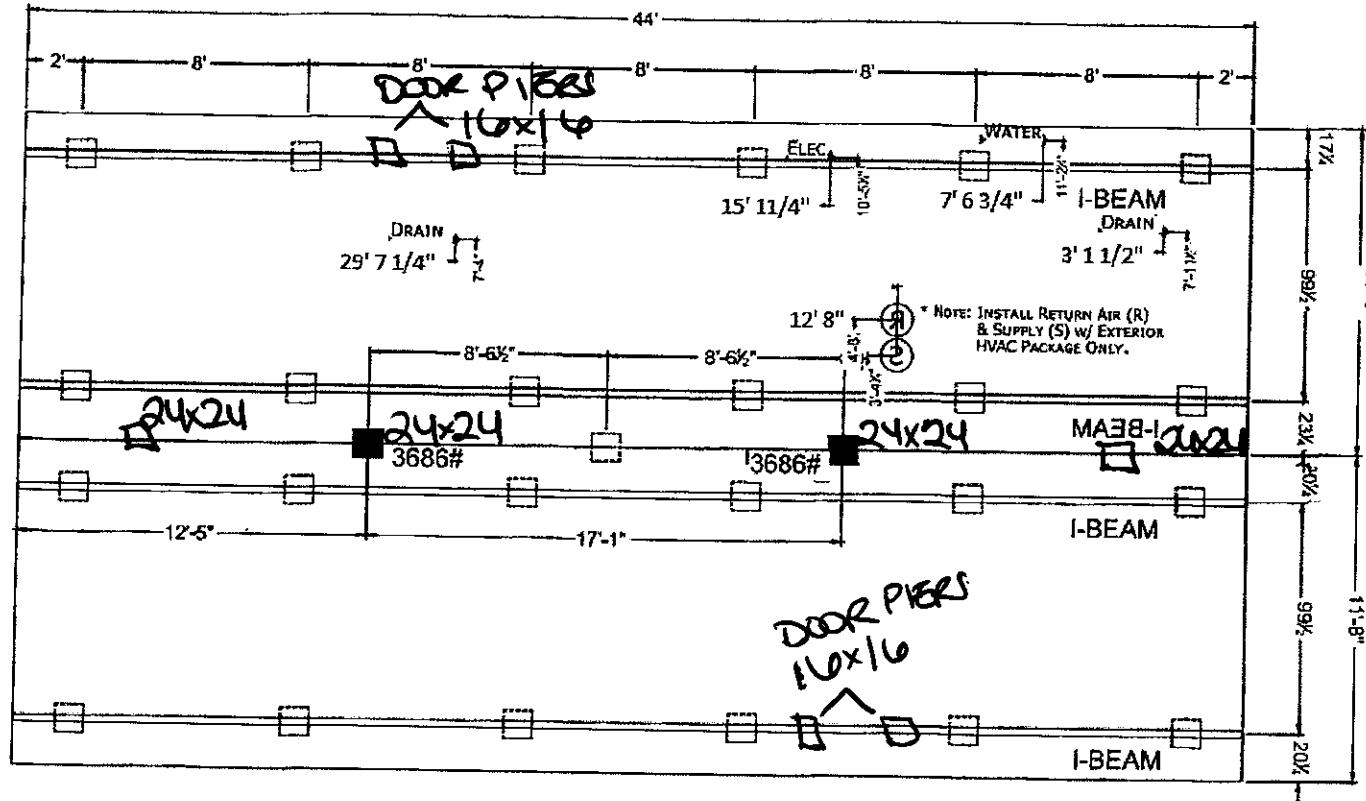

COLUMN BLOCKING
SEE SOIL BEARING CAPACITY CHARTS FOR PAD SIZE
 BLOCKING

1) ALL EXTERIOR DOORS, BAY WINDOWS, RECESSED
SIDEWALLS AND EXTERIOR WALL OPENINGS 48" OR
GREATER. WILL REQUIRE BLOCKING ON EACH SIDE.

HOME BUILDERS	DESIGNER	PROJECT	FILE	SHET
HOME BUILDERS		261-SIG3442A 44'-0" x 23'-4" 2 BD 2 BT	PIER FOUNDATION PLAN	PR-101

PROPRIETARY AND CONFIDENTIAL
NOT FOR DISTRIBUTION OUTSIDE THE ORGANIZATION
OR FOR USE BY OTHER THAN THE DESIGNER
HOME BUILDERS