

# PERMIT WORKSHEET

page 1 of 2


## PERMIT NUMBER

Installer Robert Sheppard License # IH 1025386  
 Installer Mobile Phone # 386-623-2203  
 Address of home being installed 184 NW McCall Trail  
Lake City, FL 32055  
 Manufacturer Fleetwood/Raded Length x width 60x14

NOTE: if home is a single wide fill out one half of the blocking plan  
 if home is a triple or quad wide sketch in remainder of home

I understand Lateral Arm Systems cannot be used on any home (new or used)  
 where the sidewall ties exceed 5 ft 4 in.

Installer's initials R.S.

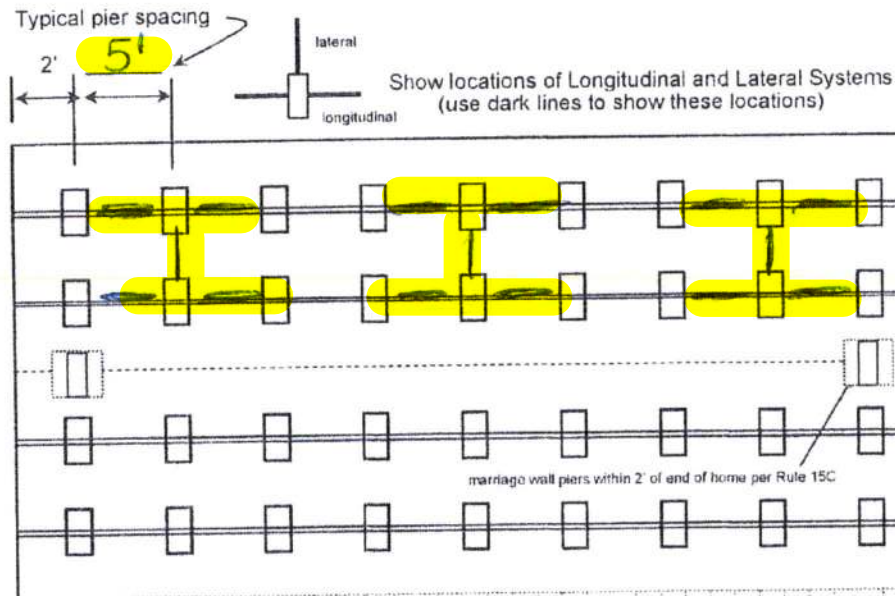

**APPROVED**

By Laure Hodson at 12:04 pm, Nov 12, 2021

New Home ☐ Used Home ☒  
 Home installed to the Manufacturer's Installation Manual ☐  
 Home is installed in accordance with Rule 15-C ☒  
 Single wide ☒ Wind Zone II ☐ Wind Zone III ☐  
 Double wide ☐ Installation Decal # 65822  
 Triple/Quad ☐ Serial # GAFLT39A06683-V421  
 Roof System: ☒ Typical ☐ Hinged

## PIER SPACING TABLE FOR USED HOMES

Load bearing capacity	Footer size (sq in)	16" x 16" (256)	18 1/2" x 18 1/2" (342)	20" x 20" (400)	22" x 22" (484)*	24" x 24" (576)*	26" x 26" (676)
1000 psf		3'	4'	5'	6'	7'	8'
1500 psf		4' 6"	6'	7'	8'	8'	8'
2000 psf		6'	8'	8'	8'	8'	8'
2500 psf		7' 6"	8'	8'	8'	8'	8'
3000 psf		8'	8'	8'	8'	8'	8'
3500 psf		8'	8'	8'	8'	8'	8'

\* interpolated from Rule 15C-1 pier spacing table

## PIER PAD SIZES

I-beam pier pad size 17x25  
 Perimeter pier pad size 16x16  
 Other pier pad sizes (required by the mfg.) 17x25

Draw the approximate locations of marriage wall openings 4 foot or greater. Use this symbol to show the piers.

List all marriage wall openings greater than 4 foot and their pier pad sizes below.

Opening Pier pad size

\_\_\_\_\_  
 \_\_\_\_\_  
 \_\_\_\_\_

## TIEDOWN COMPONENTS

Longitudinal Stabilizing Device (LSD)  
 Manufacturer \_\_\_\_\_  
 Longitudinal Stabilizing Device w/ Lateral Arms  
 Manufacturer DRIVERHOIV

## POPULAR PAD SIZES

Pad Size	Sq In
16 x 16	256
16 x 18	288
18.5 x 18.5	342
16 x 22.5	360
17 x 22	374
13 1/4 x 26 1/4	348
20 x 20	400
17 3/16 x 25 3/16	441
17 1/2 x 25 1/2	446
24 x 24	576
26 x 26	676

## ANCHORS

4 ft ☒ 5 ft ☐

## FRAME TIES

within 2' of end of home spaced at 5' 4" oc ☒

## OTHER TIES

Number  
 Sidewall 26  
 Longitudinal 6  
 Marriage wall 8  
 Shearwall 4



## PERMIT NUMBER

## POCKET PENETROMETER TEST

The pocket penetrometer tests are rounded down to \_\_\_\_\_ psf or check here to declare 1000 lb. soil ☒ without testing.

x 1000

x 1000

x 1000

## POCKET PENETROMETER TESTING METHOD

1. Test the perimeter of the home at 6 locations.
2. Take the reading at the depth of the footer.
3. Using 500 lb. increments, take the lowest reading and round down to that increment.

x 1000

x 1000

x 1000

## TORQUE PROBE TEST

The results of the torque probe test is 275 inch pounds or check here if you are declaring 5' anchors without testing \_\_\_\_\_. A test showing 275 inch pounds or less will require 5 foot anchors.

**Note:** A state approved lateral arm system is being used and 4 ft. anchors are allowed at the sidewall locations. I understand 5 ft anchors are required at all centerline tie points where the torque test reading is 275 or less and where the mobile home manufacturer may require anchors with 4000 lb holding capacity.

R.S.

Installer's initials

## ALL TESTS MUST BE PERFORMED BY A LICENSED INSTALLER

Installer Name

Robert Sheppard

Date Tested

10-13-2021

## Electrical

Connect electrical conductors between multi-wide units, but not to the main power source. This includes the bonding wire between multi-wide units. Pg. 29

## Plumbing

Connect all sewer drains to an existing sewer tap or septic tank. Pg. 28

Connect all potable water supply piping to an existing water meter, water tap, or other independent water supply systems. Pg. 29

## Site Preparation

Debris and organic material removed ☒  
Water drainage: Natural ☒ Swale ☐ Pad ☒ Other ☐

## Fastening multi wide units

Floor: Type Fastener: \_\_\_\_\_ Length: \_\_\_\_\_ Spacing: \_\_\_\_\_  
Walls: Type Fastener: \_\_\_\_\_ Length: \_\_\_\_\_ Spacing: \_\_\_\_\_  
Roof: Type Fastener: \_\_\_\_\_ Length: \_\_\_\_\_ Spacing: \_\_\_\_\_  
For used homes a min. 30 gauge, 8" wide, galvanized metal strip will be centered over the peak of the roof and fastened with galv. roofing nails at 2" on center on both sides of the centerline.

## Gasket (weatherproofing requirement)

I understand a properly installed gasket is a requirement of all new and used homes and that condensation, mold, mildew and buckled marriage walls are a result of a poorly installed or no gasket being installed. I understand a strip of tape will not serve as a gasket.

Installer's initials

Installed:

Between Floors Yes ☒Between Walls Yes ☒Bottom of ridgebeam Yes ☒

## Weatherproofing

The bottomboard will be repaired and/or taped. Yes ☒ Pg. \_\_\_\_\_  
Siding on units is installed to manufacturer's specifications. Yes ☒  
Fireplace chimney installed so as not to allow intrusion of rain water. Yes ☒

## Miscellaneous

Skirting to be installed. Yes ☒ No ☐  
Dryer vent installed outside of skirting. Yes ☐ N/A ☒  
Range downflow vent installed outside of skirting. Yes ☐ N/A ☒  
Drain lines supported at 4 foot intervals. Yes ☒  
Electrical crossovers protected. Yes ☒  
Other: \_\_\_\_\_

Installer verifies all information given with this permit worksheet is accurate and true based on the manufacturer's installation instructions and or Rule 15C-1 & 2

Installer Signature

Robert Sheppard

Date


10-13-2021



ADVANTA IRA  
SERVICES LLC  
Living Area  
728 SQ

(Larry Campa)  
840  
WITH  
Porch

Proposed

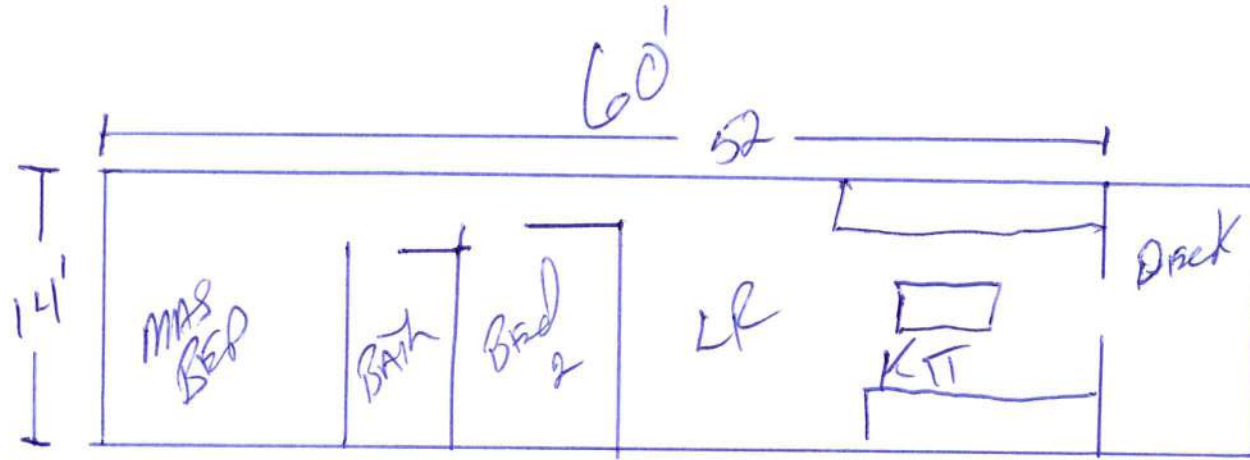

2BR / 1 BA

 10/7/21



FLEETWOOD HOMES OF GEORGIA, INC.  
144 STUART WAY/P. O. BOX 5007  
FITZGERALD, GA 31750

Plant Number #39

Date of Manufacture HUD Label No(s)

5-13-96

GE0939368

Manufacturer's Serial Number and Model Unit Designation

GAFIT39A06683-V421

2502K

RADOO

Design Approval by (D.A.P.I.A.)

This manufactured home is designed to comply with the federal manufactured home construction and safety standards in force at time of manufacture.  
(For additional information, consult owner's manual.)

The factory installed equipment includes:

Equipment	Manufacturer	Model Designation
For heating	COLMAN	EB106
For air cooling		
For cooking	MAGIC CHEF	3500DPW
Refrigerator	MAGIC CHEF	RB150AV
Water Heater	WHITEM	71-205
Washer		
Clothes Dryer		
Dishwasher		
Garbage Disposal		
Fireplace		
Stereo		
Smoke Detector		

HOME CONSTRUCTED FOR

☒ Zone I

☒ Zone II

☐ Zone III

This home has not been designed for the higher wind pressure and anchoring provisions required for coastal areas and should not be located within 1500' of the coastline in Wind Zones II and III, unless the home and its anchoring and foundation system have been designed for the increased requirements specified for Exposure D in ASHRAE 150.

This home has been equipped with storm shutters or other protective coverings for windows and exterior door openings. If or homes designed to be located in Wind Zones II and III, which have not been provided with shutters or equivalent covering devices, it is strongly recommended that the home be made ready to be equipped with these devices in accordance with the method recommended in manufacturer's printed instructions.

BASIC WIND ZONE MAP



DESIGN ROOF LOAD ZONE MAP



### COMFORT HEATING

This manufactured home has been thermally insulated to conform with the federal manufactured home construction and safety standards.

within U/O value zone 1

Heating equipment manufacturer and model (see list at left).

The above heating equipment has the capacity to maintain an average 70° F

this home at outdoor temperatures of -4° F.

To maximize furnace operating economy, and to conserve energy, it is recommended that the home be installed where the outdoor winter design temperature (97.1° F) is 18

degrees Fahrenheit.

The above information has been calculated assuming a maximum wind velocity standard atmospheric pressure.

### COMFORT COOLING

☐ Air conditioner provided at factory (Alternate I)

Air conditioner manufacturer and model (see list at left).

Certified capacity 8,000 B.T.U./hour in accordance with the air conditioning and refrigeration institute standards.

The central air conditioning system provided in this home has been sized at

orientation of the front (hitch end) of the home facing On this system is designed to maintain an indoor temperature of 75° F when

temperatures are ° F dry bulb and ° F wet bulb.

The temperature to which this home can be cooled will change depending on amount of exposure of the windows of this home to the sun's radiant heat. These home's heat gains will vary dependent upon its orientation to the sun and any shading provided. Information concerning the calculation of cooling loads at locations, window exposures and shadings are provided in Chapter 22 of the 1989 of the ASHRAE Handbook of Fundamentals.

Information necessary to calculate cooling loads at various locations and orientation provided in the special comfort cooling information provided with this home.

☒ Air conditioner not provided at factory (Alternate II)

The air distribution system of this home is suitable for the installation of central conditioning.

The supply air distribution system installed in this home is sized for a manufactured central air conditioning system of up to 34,000 B.T.U./hr. rated capacity which

certified in accordance with the appropriate air conditioning and refrigeration institute standards, when the air circulations of such air conditioners are rated at 0.3 inch a column static pressure or greater for the cooling air delivered to the manufactured home supply air duct system.

Information necessary to calculate cooling loads at various locations and orientation provided in the special comfort cooling information provided with this manufactured home.

☐ Air conditioning not recommended (Alternate III)

The air distribution system of this home has not been designed in anticipation of its use with a central air conditioning system.

To determine the required capacity of equipment to cool a home efficiently and economically a cooling load heat gain calculation is required. The cooling load is dependent on the orientation, location, and the structure of the home. Central air conditioners operate most efficiently and provide the greatest comfort when their capacity closely approximates the calculated cooling load. Each home's air conditioner should be sized in accordance with Chapter 22 of the American Society of Heating, Refrigerating and Air Conditioning Engineers (ASHRAE) Handbook of Fundamentals 1989 edition, once the location and orientation are known.

### INFORMATION PROVIDED BY THE MANUFACTURER NECESSARY TO CALCULATE SENSIBLE HEAT GAIN

Walls (without windows and doors)	✓ .09
Ceilings and roofs of light color	✓ .05
Ceilings and roofs of dark color	✓ .05
Floors	✓ .07
Air ducts in floor	✓ .14
Air ducts in ceiling	✓ .00
Doors (included outside the home)	✓ .00
Windows (see the duct system in this home)	✓ .00
Doors in floor	48.0 ft
Doors in ceiling	0.0 ft
Walls outside the home	0.0 ft

U/O VALUE ZONE MAP

