


Mobile Home Permit Worksheet


Installer: Richard Raybon License # IH1025436
 Address of home being installed: 188 Southeast Page Lane
Laurel City
 Manufacturer: HOFT Length x width: 14x66

NOTE: if home is a single wide fill out one half of the blocking plan if home is a triple or quad wide sketch in remainder of home and understand Lateral Arm Systems cannot be used on any home (few or used) where the sidewall ties exceed 5 ft 4 in.


Installer's initials: [Signature]

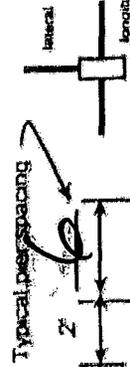

Show locations of Longitudinal and Lateral Systems (use dark lines to show these locations)

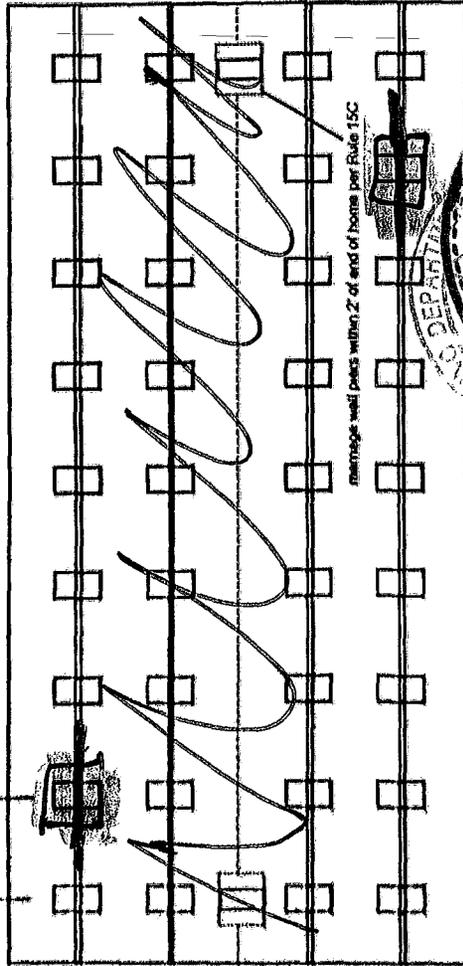

marriage wall piers within 2' of end of home per Rule 15C

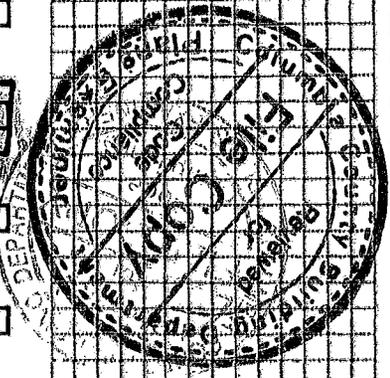

Application Number: _____

Date: 10-10-25

New Home Used Home
 Home installed to the Manufacturer's Installation Manual
 Home is installed in accordance with Rule 15-C
 Single wide Wind Zone II Wind Zone III
 Double wide Installation Decal # 13A
 Triple/Quad Serial # _____

PIER SPACING TABLE FOR USED HOMES

Load bearing capacity	Footer size (sq in)	16" x 16" (256)	18 1/2" x 18 1/2" (342)	20" x 20" (400)	22" x 22" (484)	24" x 24" (576)	28" x 28" (678)
1000 psf	3'	4'	5'	6'	7'	8'	8'
1500 psf	4'	6'	8'	8'	8'	8'	8'
2000 psf	6'	8'	8'	8'	8'	8'	8'
2500 psf	7'	8'	8'	8'	8'	8'	8'
3000 psf	8'	8'	8'	8'	8'	8'	8'
3500 psf	8'	8'	8'	8'	8'	8'	8'

* interpolated from Rule 15C-1 pier spacing table.

PIER PAD SIZES

I-beam pier pad size: 16x16
 Perimeter pier pad size: 16x16
 Other pier pad sizes (required by the mfg.): 16x16 DOORS

POPULAR PAD SIZES

Pad Size	Sq in
16 x 16	256
16 x 18	288
18.5 x 18.5	342
16 x 22.5	360
17 x 22	374
13 1/4 x 26 1/4	348
20 x 20	400
17 3/16 x 25 3/16	441
17 1/2 x 25 1/2	446
24 x 24	576
26 x 26	676

Draw the approximate locations of marriage wall openings 4 foot or greater. Use this symbol to show the piers.

List all marriage wall openings greater than 4 foot and their pier pad sizes below.

Opening Pier pad size
Doors 16x16

ANCHORS

4 ft 5 ft

FRAME TIES

within 2' of end of home spaced at 5' 4" oc

TIEDOWN COMPONENTS

Longitudinal Stabilizing Device (LSD) Manufacturer: Older
 Longitudinal Stabilizing Device w/ Lateral Arms Manufacturer: _____

OTHER TIES

Sidewall Longitudinal Marriage wall Shearwall Number: 2

Block missing

Mobile Home Permit Worksheet

POCKET PENETROMETER TEST

The pocket penetrometer tests are rounded down to 1500 psl or check here to declare 1000 lb. soil without testing.

1500 x 1500 x 1500

POCKET PENETROMETER TESTING METHOD

1. Test the penmeter of the home at 6 locations.
2. Take the reading at the depth of the footer.
3. Using 500 lb. increments, take the lowest reading and round down to that increment.

1500 x 1500 x 1500

TORQUE PROBE TEST

The results of the torque probe test is 285 inch pounds or check here if you are declaring 5' anchors without testing. A test showing 275 inch pounds or less will require 5 foot anchors.

Note: A state approved lateral arm system is being used and 4 ft anchors are allowed at the sidewall locations. Understand 5 ft anchors are required at all of the tie line tie points where the torque test reading is 275 or less and here the mobile home manufacturer may require anchors with 40% holding capacity.

Installer's initials: RS

ALL TESTS MUST BE PERFORMED BY A LICENSED INSTALLER

Installer Name

Richard Rayborn

Date Tested

10-15-25

Electrical

Connect electrical conductors between multi-wide units, but not to the main power source. This includes the bonding wire between multi-wide units, Pg. 3

Plumbing

Connect all sewer drains to an existing sewer tap or septic tank. Pg. 3
 Connect all potable water supply piping to an existing water meter, water tap, or other independent water supply systems. Pg. 3

Application Number: _____

Date: _____

Site Preparation

Debris and organic material removed Swale Pad Other

Fastening multi wide units

Floor: _____ Spacing: _____
 Walls: _____ Length: _____
 Type Fastener: _____ Spacing: _____
 Type Fastener: _____ Spacing: _____
 For used homes a min. 30 gauge, 8" wide, galvanized metal strip will be centered over the peak of the roof and fastened with galv. roofing nails at 2" on center on both sides of the centerline.

Gasket (weatherproofing requirement)

Understand a properly installed gasket is a requirement of all new and used homes and that condensation, mold, mildew and buckled marriage walls are a result of a poorly installed or no gasket being installed. I understand a strip of a gasket will not serve as a gasket.

Installer's initials

Type gasket Pg. _____

Installed: _____
 Between Floors Yes
 Between Walls Yes
 Bottom of ridgebeam Yes

Weatherproofing

The bottomboard will be repaired and/or taped. Pg. 3
 Siding on units is installed to manufacturer's specifications.
 Fireplace chimney installed so as not to allow intrusion of rain water.

Miscellaneous

Skirting to be installed. No N/A
 Dryer vent installed outside of skirting. N/A
 Range downflow vent installed outside of skirting. N/A
 Drain lines supported at 4 foot intervals.
 Electrical crossovers protected.
 Other: _____

Installer verifies all information given with this permit worksheet is accurate and true based on the manufacturer's installation instructions and or Rule 15C-1 & 2

Installer Signature

Richard Rayborn Date 10-15-25