

PERMIT WORKSHEET

page 1 of 2


PERMIT NUMBER

Installer Richard Rayborn License # IH 1025436
 Installer Mobile Phone # 352-257-1282
 Address of home being installed 129 SW Majestic
Fort White, FL
 Manufacturer Density Length x width 28x60

NOTE: if home is a single wide fill out one half of the blocking plan
 if home is a triple or quad wide sketch in remainder of home

I understand Lateral Arm Systems cannot be used on any home (new or used)
 where the sidewall ties exceed 5 ft 4 in.

Installer's initials

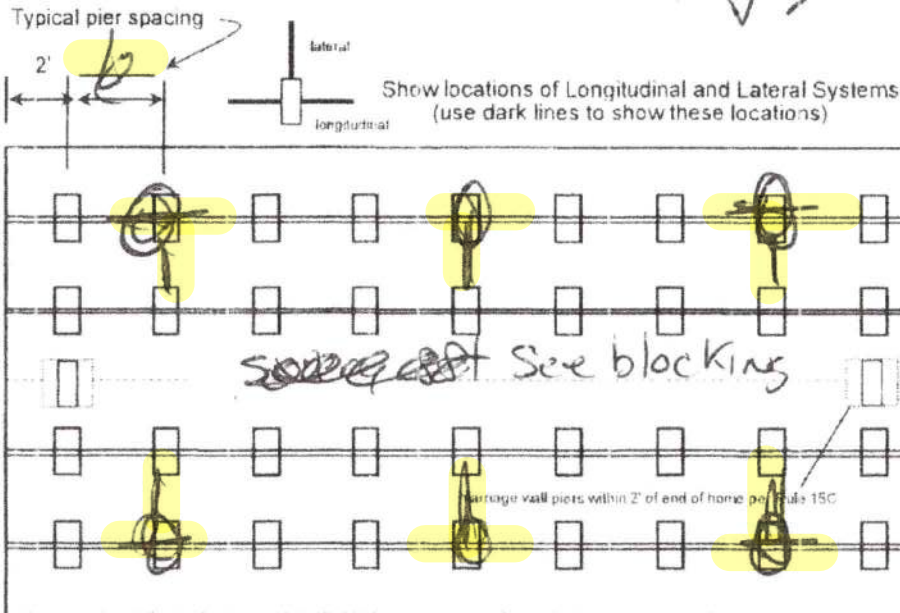

New Home



Used Home



Home installed to the Manufacturer's Installation Manual



Home is installed in accordance with Rule 15-C



Single wide



Wind Zone II



Wind Zone III



Double wide



Installation Decal #

72644

Triple/Quad



Serial #

Dsh 104996AAB

Roof System: Typical Hinged

PIER SPACING TABLE FOR USED HOMES

Load bearing capacity	Footer size (sq in)	16" x 16" (256)	18 1/2" x 18 1/2" (342)	20" x 20" (400)	22" x 22" (484)*	24" x 24" (576)*	26" x 26" (676)
1000 psf		3'	4'	5'	6'	7'	8'
1500 psf		4' 6"	6'	7'	8'	8'	8'
2000 psf		6'	8'	8'	8'	8'	8'
2500 psf		7' 6"	8'	8'	8'	8'	8'
3000 psf		8'	8'	8'	8'	8'	8'
3500 psf		8'	8'	8'	8'	8'	8'

* interpolated from Rule 15C-1 pier spacing table.

PIER PAD SIZES

I-beam pier pad size

17x25

Perimeter pier pad size

Other pier pad sizes

(required by the mfg.)

Draw the approximate locations of marriage wall openings 4 foot or greater. Use this symbol to show the piers.

List all marriage wall openings greater than 4 foot and their pier pad sizes below.

Opening door Pier pad size 16x16

POPULAR PAD SIZES

Pad Size	Sq In
16 x 16	256
16 x 18	288
18.5 x 18.5	342
16 x 22.5	360
17 x 22	374
13 1/4 x 26 1/4	348
20 x 20	400
17 3/16 x 25 3/16	441
17 1/2 x 25 1/2	446
24 x 24	576
26 x 26	676

ANCHORS

4 ft 5 ft

FRAME TIES

within 2' of end of home
 spaced at 5' 4" oc

TIEDOWN COMPONENTS

Longitudinal Stabilizing Device (LSD)

Manufacturer

Longitudinal Stabilizing Device w/ Lateral Arms

Manufacturer

DUVER

Sidewall

Longitudinal

Marriage wall

Shearwall

Number



Laurie
 Hodson

Digitally signed
 by Laurie Hodson
 Date: 2020.08.26
 12:19:04 -04'00'

PERMIT NUMBER

PERMIT WORKSHEET

page 2 of 2

POCKET PENETROMETER TEST

The pocket penetrometer tests are rounded down to 1500 psf or check here to declare 1000 lb. soil without testing

x 1500 x 1500 x 1500

POCKET PENETROMETER TESTING METHOD

1. Test the perimeter of the home at 6 locations.
2. Take the reading at the depth of the footer.
3. Using 500 lb. increments, take the lowest reading and round down to that increment

x 1500 x 1500 x 1500

TORQUE PROBE TEST

The results of the torque probe test is 275 inch pounds or check here if you are declaring 5' anchors without testing 4. A test showing 275 inch pounds or less will require 5 foot anchors.

Note: A state approved lateral arm system is being used and 4 ft anchors are allowed at the sidewall locations. I understand 5 ft anchors are required at all centerline tie points where the torque test reading is 275 or less and where the mobile home manufacturer may require anchors with 4000 lb. holding capacity.

Installer's initials

ALL TESTS MUST BE PERFORMED BY A LICENSED INSTALLER

Installer Name

RICHARD FAUBORN

Date Tested

8-19-20

Electrical

Connect electrical conductors between multi-wide units, but not to the main power source. This includes the bonding wire between multi-wide units. Pg 3

Plumbing

Connect all sewer drains to an existing sewer tap or septic tank. Pg 3

Connect all potable water supply piping to an existing water meter, water tap, or other independent water supply systems. Pg 3



Site Preparation

Debris and organic material removed Yes
Water drainage: Natural X Swale Pad Other

Fastening multi-wide units

Floor: Type Fastener 195 Length: 6 Spacing: 18
Walls: Type Fastener 195 Length: 6 Spacing: 18
Roof: Type Fastener 195 Length: 6 Spacing: 18
For used homes a min. 30 gauge, 8" wide, galvanized metal strip will be centered over the peak of the roof and fastened with galv roofing nails at 2" on center on both sides of the centerline.

Gasket (weatherproofing requirement)

I understand a properly installed gasket is a requirement of all new and used homes and that condensation, mold, mildew and buckled marriage walls are a result of a poorly installed or no gasket being installed. I understand a strip of tape will not serve as a gasket.

Installer's initials

Type gasket

Pg 30AR

Installed:

Between Floors Yes ✓

Between Walls Yes ✓

Bottom of ridgebeam Yes ✓

Weatherproofing

The bottomboard will be repaired and/or taped. Yes ✓ Pg 3
Siding on units is installed to manufacturer's specifications. Yes ✓
Fireplace chimney installed so as not to allow intrusion of rain water. Yes ✓

Miscellaneous

Skirting to be installed. Yes ✓ No
Dryer vent installed outside of skirting. Yes ✓ N/A
Range downflow vent installed outside of skirting. Yes ✓ N/A
Drain lines supported at 4 foot intervals. Yes ✓
Electrical crossovers protected. Yes ✓
Other



Installer verifies all information given with this permit worksheet is accurate and true based on the manufacturer's installation instructions and or Rule 15C-1 & 2

Installer Signature

Date

8-19-20

SOIL BEARING LOAD 1000LBS
 1500LBS=16"x16" ABS FOOTER
 1778LBS=16"x16" ABS FOOTER
 3000LBS=17.5"x25.5" ABS FOOTER
 4800LBS=23.25"x31.25" ABS FOOTER

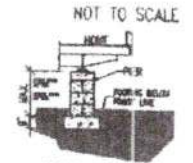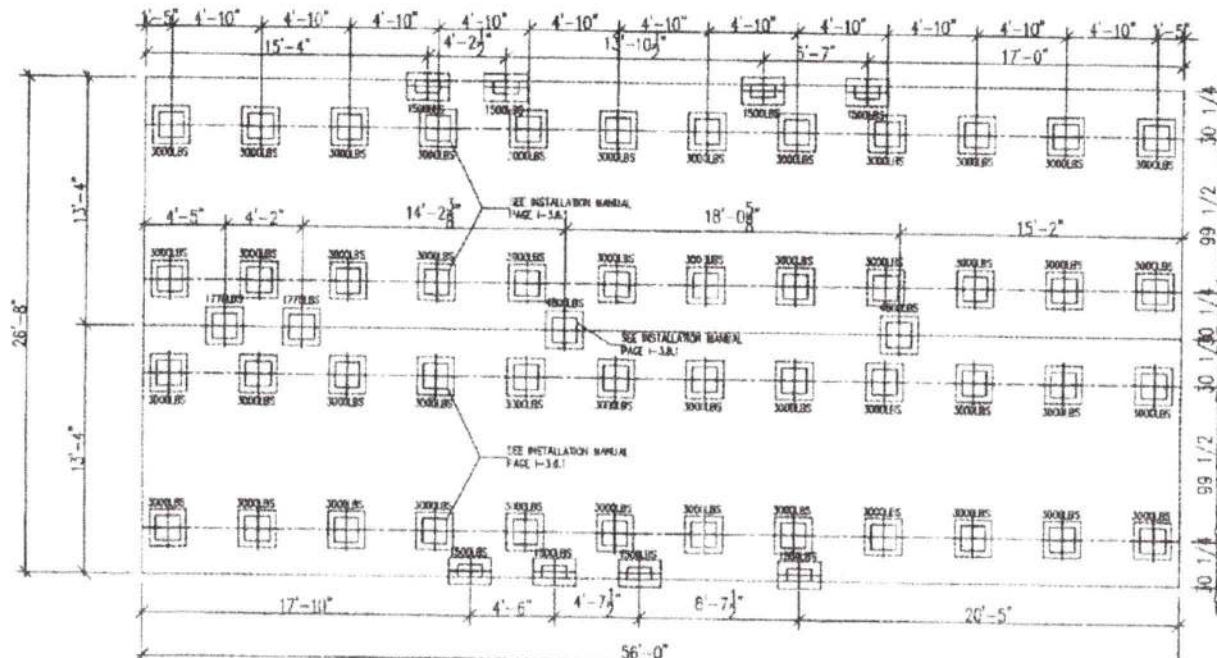

NOTE: SEE I-3.2
 INSTALLATION MANUAL

MAXIMUM SPAN BETWEEN PIERS UNDER I-BEAMS (FEET)							MAXIMUM CLEAR SPAN FOR MATING LINE SUPPORTS (FEET)							OVAL PAD SIZES		MAX. LOAD FOR 1000 PSF SOIL CAPACITY		MAX. LOAD FOR 1500 PSF SOIL CAPACITY		MAX. LOAD FOR 2000 PSF SOIL CAPACITY				
PAD SIZE	PAD AREA (SQ. FT.)	BOX WIDTH (IN.)					PAD SIZE	PAD AREA (SQ. FT.)	BOX WIDTH (IN.)					16"x18.5"	17.5"x25.5"	23.25"x31.25"	16"x18.5"	17.5"x25.5"	23.25"x31.25"	16"x18.5"	17.5"x25.5"	23.25"x31.25"		
		SINGLE WIDE	DOUBLE WIDE	SINGLE WIDE	DOUBLE WIDE	SINGLE WIDE			DOUBLE WIDE	SINGLE WIDE	DOUBLE WIDE	SINGLE WIDE	DOUBLE WIDE										SINGLE WIDE	DOUBLE WIDE
16"x18.5"	2.70	164	186	140	100	180	16"x18.5"	2.70	N/A	N/A	N/A	N/A	N/A	N/A	17.5"x25.5"	3.00	4.00	16"x18.5"	2.70	3.00	4.00	16"x18.5"	2.70	3.00
17.5"x25.5"	3.00	186	214	140	100	180	17.5"x25.5"	3.00	N/A	N/A	N/A	N/A	N/A	N/A	17.5"x25.5"	3.00	4.00	17.5"x25.5"	3.00	3.00	4.00	17.5"x25.5"	3.00	3.00
23.25"x31.25"	4.00	214	242	140	100	180	23.25"x31.25"	4.00	N/A	N/A	N/A	N/A	N/A	N/A	23.25"x31.25"	4.00	4.00	23.25"x31.25"	4.00	3.00	4.00	23.25"x31.25"	4.00	3.00
16"x16"	1.78	140	140	100	100	100	16"x16"	1.78	N/A	N/A	N/A	N/A	N/A	N/A	16"x16"	1.78	1.78	16"x16"	1.78	2.00	2.00	16"x16"	1.78	2.00
17.5"x16"	2.35	140	140	100	100	100	17.5"x16"	2.35	N/A	N/A	N/A	N/A	N/A	N/A	17.5"x16"	2.35	2.35	17.5"x16"	2.35	2.00	2.00	17.5"x16"	2.35	2.00
23.25"x16"	3.93	140	140	100	100	100	23.25"x16"	3.93	N/A	N/A	N/A	N/A	N/A	N/A	23.25"x16"	3.93	3.93	23.25"x16"	3.93	2.00	2.00	23.25"x16"	3.93	2.00
16"x18.5"	2.70	164	186	140	100	180	16"x18.5"	2.70	N/A	N/A	N/A	N/A	N/A	N/A	16"x18.5"	2.70	2.70	16"x18.5"	2.70	2.00	2.00	16"x18.5"	2.70	2.00
17.5"x25.5"	3.00	186	214	140	100	180	17.5"x25.5"	3.00	N/A	N/A	N/A	N/A	N/A	N/A	17.5"x25.5"	3.00	3.00	17.5"x25.5"	3.00	2.00	2.00	17.5"x25.5"	3.00	2.00
23.25"x31.25"	4.00	214	242	140	100	180	23.25"x31.25"	4.00	N/A	N/A	N/A	N/A	N/A	N/A	23.25"x31.25"	4.00	4.00	23.25"x31.25"	4.00	2.00	2.00	23.25"x31.25"	4.00	2.00

THIS LETTER SHALL CERTIFY THAT ABS FOUNDATION PADS MANUFACTURED BY OLIVER TECHNOLOGIES, INC. MAY BE USED IN THE LIEU OF POURED CONCRETE FOOTINGS AS A SUPPORT FOR SINGLE & DOUBLE STACKED FOUNDATION PIDS PROVIDED THE FOLLOWING CRITERIA ARE MET:

1. THE ABS PIDS MUST BE INSTALLED PER OLIVER TECHNOLOGIES INSTALLATION INSTRUCTIONS.
2. THE PIDS MUST BE USED TO SUPPORT A CONTINUOUS FOUNDATION WALL. THE PIDS MAY ONLY BE USED FOR INDIVIDUAL FOUNDATION PIDS.
3. THE ABS PIDS MAY BE COMBINED TO COVER A LARGER AREA IN THIS CASE THE MAX. ALLOWABLE LOADS MUST BE COMBINED AS WELL.
4. IF THE REQUIREMENTS OF DESTINY IND. INSTALLATION MANUAL CONFLICT WITH THE REQUIREMENTS OF THE OLIVER TECHNOLOGIES INSTALLATIONS THE MORE STRINGENT REG. SHALL BE USED.

Destiny Industries, LLC
 PHONE: 888-782-8800 FAX: 229-873-6820
 www.destinyhomebuilders.com

REVISIONS

1000LBS ABSPAD FOUNDATION PLAN

PROJECT: TIMBERLINE MODEL: JD603-824-96
 DATE: 11/13/2013 SHEET: 1-C17
 DRAWING FILE INFORMATION: 28X60 3BR-2B
 DRAWN BY: DONNY TRULL

Destiny Warranty
10 year


Central Mobile Homes, Inc. #6 Delivery & Set-up

5050 Highway 27 South
Sebring, FL 33870

A/C STEPS SKIETING
82.900

Phone# (863) 451-5101

Fax # (863) 451-5104

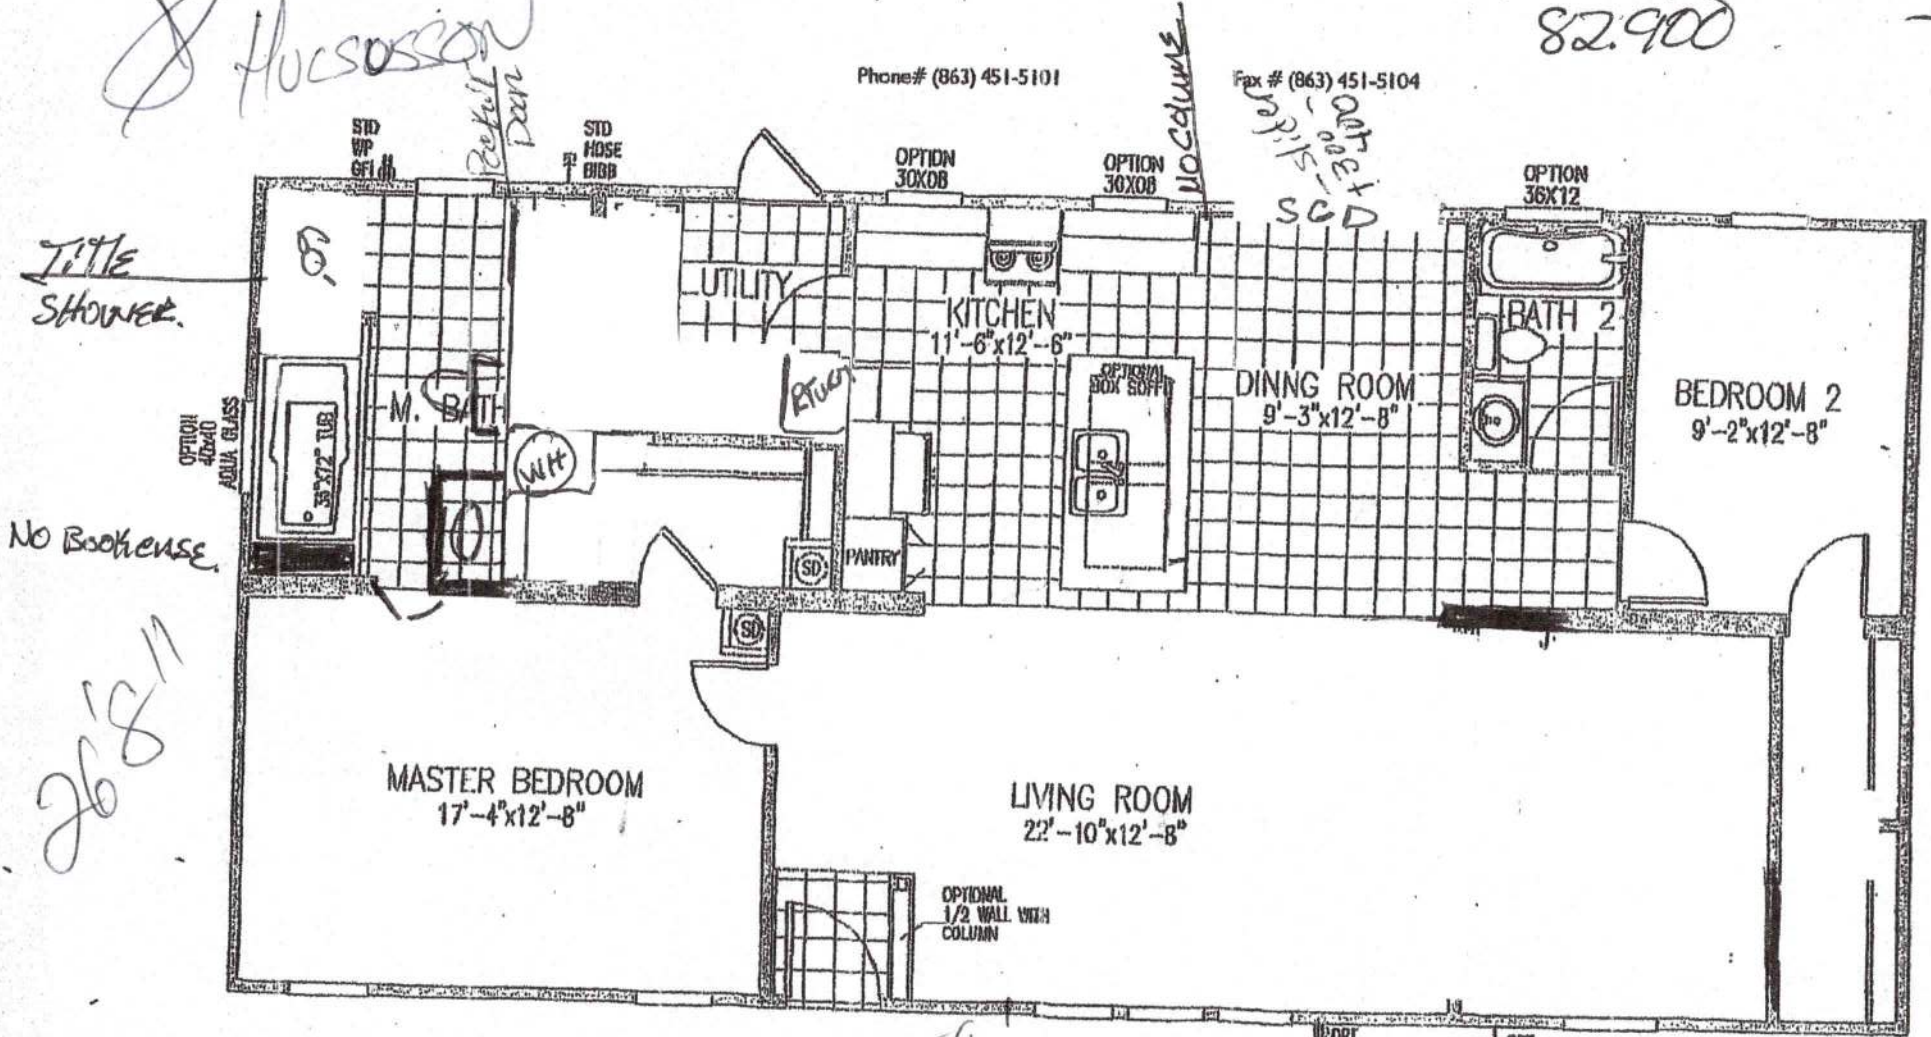

MODEL D603-824 BBR ~ 2BA
28'-0" X 60'-0" ~ 1,493 SQ. FT.
ALSO AVAILABLE 32' WIDE

ADD BUILT IN MIC
SPACE WINDOWS

PROPOSED

8/21/20