

CASH

PERMIT APPLICATION / MANUFACTURED HOME INSTALLATION APPLICATION

For Office Use Only

(Revised 9-22-06)

Zoning Official

Building Official

AP#

0710-42

Date Received

10/22/07

By

G

Permit #

26360

Flood Zone

X

Development Permit

—

Zoning

A-3

Land Use Plan Map Category

A-3

Comments

Existing MH to be removed

FEMA Map#

Elevation

Finished Floor

River

In Floodway

☒ Site Plan with Setbacks Shown

☒ EH Signed Site Plan

☐ EH Release

☐ Well letter

☒ Existing well

☒ Copy of Recorded Deed or Affidavit from land owner

☐ Letter of Authorization from installer

☐ State Road Access

☐ Parent Parcel #

☐ STUP-MH

Property ID #

36-45-17-09048-001

Subdivision

▪ New Mobile Home

✓

Used Mobile Home

Year

2008

▪ Applicant

Robert Sheppard

Phone #

386-623-2203

▪ Address

6355 SE CR 245 Lake City FL 32025

▪ Name of Property Owner

Phone#

▪ 911 Address

6355 SE CR 245 Lake City FL

▪ Circle the correct power company -

FL Power & Light

Clay Electric

(Circle One) -

Suwannee Valley Electric

Progress Energy

▪ Name of Owner of Mobile Home

Robert Sheppard

Phone #

386-623-2203

Address

6355 SE CR 245 Lake City FL 32025

▪ Relationship to Property Owner

▪ Current Number of Dwellings on Property

1

▪ Lot Size

330 X 668

Total Acreage

5 Acres

▪ Do you : Have

Existing Drive

or Private Drive

or need Culvert Permit

or Culvert Waiver (Circle one)

(Currently using)

(Blue Road Sign)

(Putting in a Culvert)

(Not existing but do not need a Culvert)

▪ Is this Mobile Home Replacing an Existing Mobile Home

Yes

▪ Driving Directions to the Property

100 to Price Creek Rd take right

go 5 miles

Just before hopeful Church on left

green dw

▪ Name of Licensed Dealer/Installer

Robert Sheppard

Phone #

623-2203

▪ Installers Address

6355 SE CR 245 Lake City FL 32025

▪ License Number

TH 0600833

Installation Decal #

278546

PERMIT WORKSHEET

PERMIT NUMBER

Installer Robert Sheppard License # 4H0000833


Address of home being installed 6355 SE CR245 Lake City FI 3025

Manufacturer Fleetwood Length x width 32x60

NOTE: if home is a single wide fill out one half of the blocking plan
if home is a triple or quad wide sketch in remainder of home

I understand Lateral Arm Systems cannot be used on any home (new or used) where the sidewall ties exceed 5 ft 4 in.

Installer's initials RS

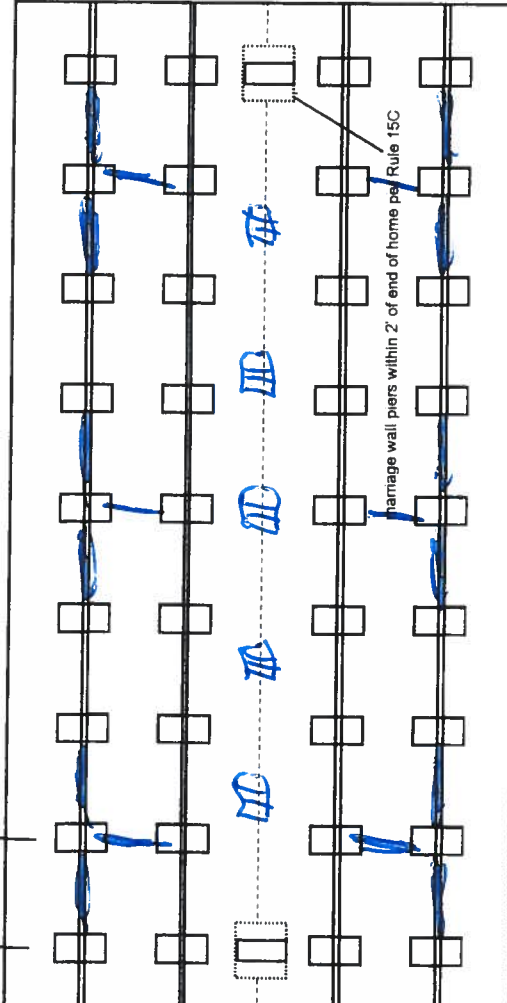

PIER SPACING TABLE FOR USED HOMES

Load bearing capacity	Footer size (sq in)	16" x 16" (256)	18 1/2" x 18 1/2" (342)	20" x 20" (400)	22" x 22" (484)*	24" x 24" (576)*	26" x 26" (676)
1000 psf	3'						
1500 psf	4'6"						
2000 psf	6'						
2500 psf	7'6"						
3000 psf	8'						
3500 psf	8'						

* Interpolated from Rule 15C-1 pier spacing table.

PIER PAD SIZES

I-beam pier pad size 17x22
Perimeter pier pad size 17x22
Other pier pad sizes (required by the mfg.) 17x22

Draw the approximate locations of marriage wall openings 4 foot or greater. Use this symbol to show the piers.

List all marriage wall openings greater than 4 foot and their pier pad sizes below.

Opening Pier pad size

ANCHORS

4 ft 5 ft

FRAME TIES

within 2' of end of home spaced at 5' 4" oc

TIEDOWN COMPONENTS

Longitudinal Stabilizing Device (LSD)
Manufacturer oliver 1101v
Longitudinal Stabilizing Device w/ Lateral Arms
Manufacturer oliver 1101v

OTHER TIES

Sidewall
Longitudinal
Marriage wall
Shearwall
Number 22
68
4

PERMIT NUMBER

POCKET PENETROMETER TEST

The pocket penetrometer tests are rounded down to 1500 psf or check here to declare 1000 lb. soil without testing.

X 1700 x 1700 x 1700

POCKET PENETROMETER TESTING METHOD

1. Test the perimeter of the home at 6 locations.
2. Take the reading at the depth of the footer.
3. Using 500 lb. increments, take the lowest reading and round down to that increment.

X 1700 X 1700 X 1700

TORQUE PROBE TEST

The results of the torque probe test is inch pounds or check here if you are declaring 5' anchors without testing. A test showing 275 inch pounds or less will require 5 foot anchors.

Note: A state approved lateral arm system is being used and 4 ft. anchors are allowed at the sidewall locations. I understand 5 ft anchors are required at all centerline tie points where the torque test reading is 275 or less and where the mobile home manufacturer may requires anchors with 4000 lb holding capacity.

Installer's initials

ALL TESTS MUST BE PERFORMED BY A LICENSED INSTALLER

Installer Name

Robert Sheppard

Date Tested

10-22-07

Electrical

Connect electrical conductors between multi-wide units, but not to the main power source. This includes the bonding wire between multi-wide units. Pg. 28

Plumbing

Connect all sewer drains to an existing sewer tap or septic tank. Pg. 28

Connect all potable water supply piping to an existing water meter, water tap, or other independent water supply systems. Pg. 22

Site Preparation

Debris and organic material removed ☒
Water drainage: Natural ☒ Swale ☐ Pad ☐ Other ☐

Fastening multi wide units

Floor: Type Fastener: lags Length: 5" Spacing: 16"
Walls: Type Fastener: screws Length: 4" Spacing: 16"
Roof: Type Fastener: lags Length: 6" Spacing: 16"
For used homes a min. 30 gauge, 8" wide, galvanized metal strip will be centered over the peak of the roof and fastened with galv. roofing nails at 2" on center on both sides of the centerline.

Gasket (weatherproofing requirement)

I understand a properly installed gasket is a requirement of all new and used homes and that condensation, mold, mildew and buckled marriage walls are a result of a poorly installed or no gasket being installed. I understand a strip of tape will not serve as a gasket.

Installer's initials

RS

Type gasket

Foam

Installed:

Between Floors Yes ☒
Between Walls Yes ☒
Bottom of ridgebeam Yes ☒

Weatherproofing

The bottomboard will be repaired and/or taped. Yes ☒ Pg. 28
Siding on units is installed to manufacturer's specifications. Yes ☒
Fireplace chimney installed so as not to allow intrusion of rain water. Yes ☒

Miscellaneous

Skirting to be installed. Yes ☒ No ☐
Dryer vent installed outside of skirting. Yes ☒ N/A ☐
Range downflow vent installed outside of skirting. Yes ☒
Drain lines supported at 4 foot intervals. Yes ☒
Electrical crossovers protected. Yes ☒
Other: ☐ N/A ☒

Installer verifies all information given with this permit worksheet is accurate and true based on the manufacturer's installation instructions and or Rule 15C-1 & 2

Installer Signature

Robert Sheppard

Date

10-22-07

CHASSIS INFO	
M.R. SPACING	95 1/2"
I-BEAM SIZE	10"

EFOST DATA			
LIVE LOAD: 20 LBS.			
	LABEL	LOCATION	UNIT PLF LGAD*
A			3006
B	15'-4 1/4"	E	
B	15'-4 1/4"	E	6660
C	15'-4 1/4"	E	
C	32'-2 5/8"	A	4709
C	32'-2 5/8"	E	
D	40'-1 1/4"	A	6590
D	40'-1 1/4"	E	
E	55'-0"	A	
E	55'-0"	E	3400

DRAWING TITLE	
PIER LAYOUT	
20# ROOF LOAD	
DRAWN BY:	MARIBEL L.
DATE:	04/03/07
SMT	REV
SP.1C.1	

341TW0563T

INDEX

STANDARD
FOOTING

NOTES:

1. THIS DRAWING IS DESIGNED FOR THE STANDARD WIND ZONE AND IS TO BE USED IN CONJUNCTION WITH THE INSTALLATION MANUAL AND ITS SUPPLEMENTS.

2. FOOTINGS ARE SHOWN FOR EXAMPLE ONLY. QUANTITY AND SPACING MAY VARY BASED ON PAD TYPE, SOIL CONDITION, ETC.

3. FOOTING PADS & PIERS ARE REQUIRED AT SUPPORT POSTS. SEE INSTALLATION MANUAL FOR REQUIREMENTS.



FLEETWOOD

WILLALOUCHE
34

PRODUCT NAME

TIMBERWOOD

MODEL NO.

0563T

DRAWING TITLE

PIER LAYOUT
20# ROOF LOAD

DRAFTED BY:
MARIBEL L.

DATE: 04/03/07

5HT	RE
-----	----


SP.1C.1

STATE OF FLORIDA
DEPARTMENT OF HEALTH
APPLICATION FOR ONSITE SEWAGE DISPOSAL SYSTEM CONSTRUCTION PERMIT

Permit Application Number 07-819E

----- PART II - SITEPLAN -----

Scale: 1 inch = 50 feet.

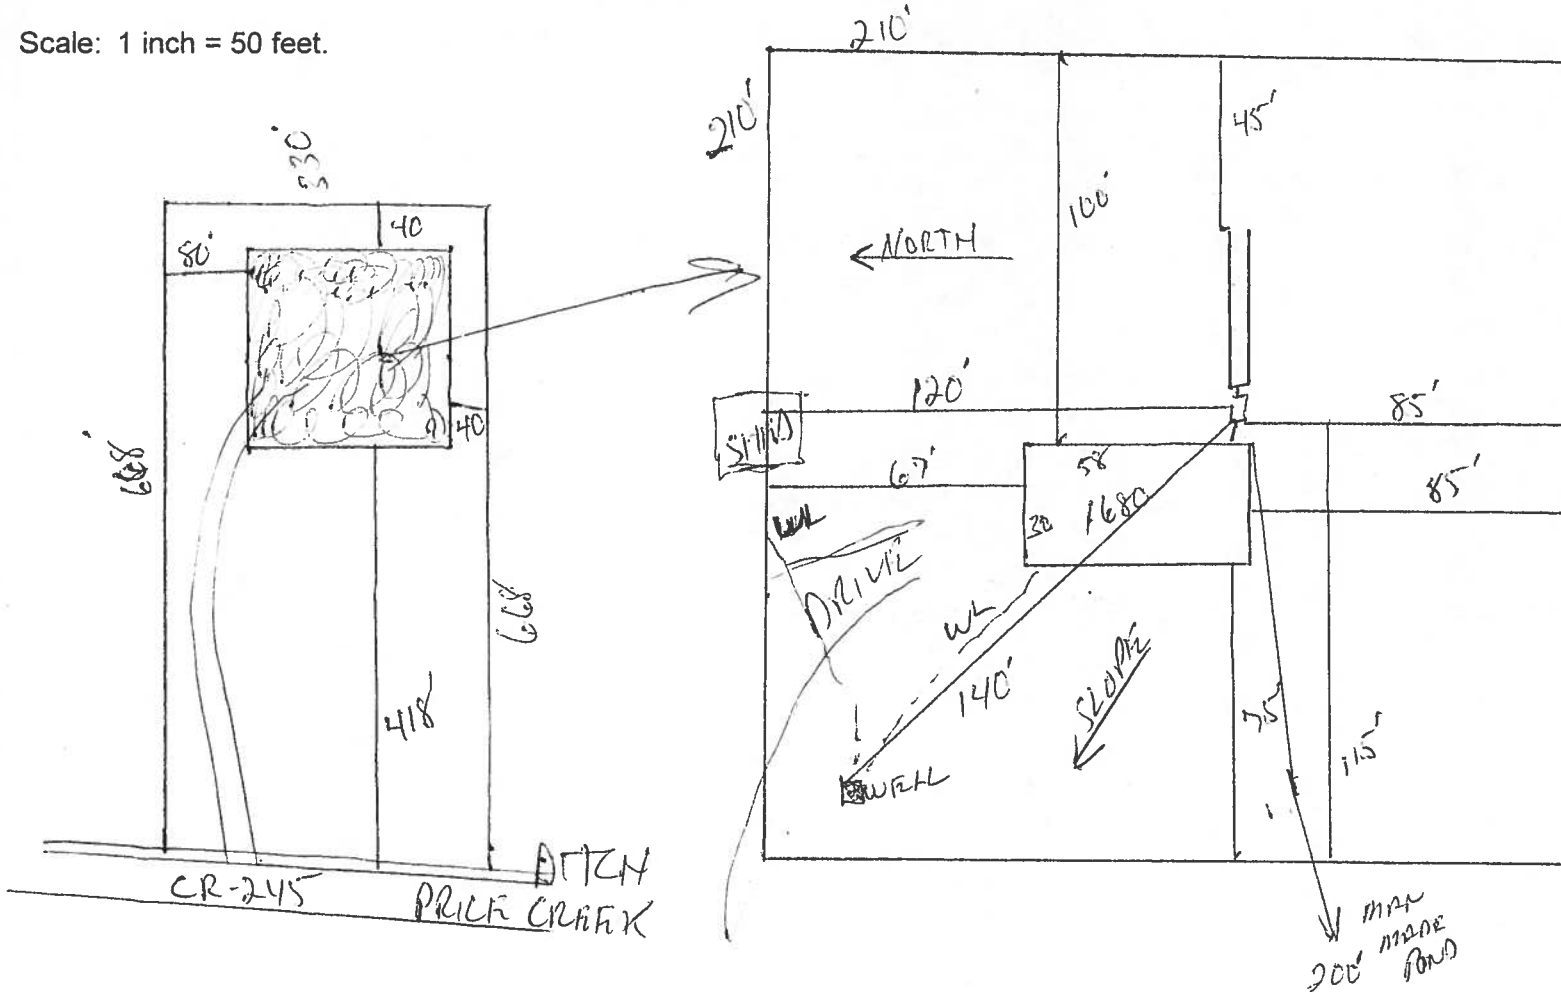

Notes: 1 of 5 ACRES

Site Plan submitted by: Rock 07-0

MASTER CONTRACTOR

Plan Approved ☒

Not Approved ☐

Date 10/24/07

By M & M

Columbia

County Health Department

ALL CHANGES MUST BE APPROVED BY THE COUNTY HEALTH DEPARTMENT

@ CAM112M01	S	CamaUSA Appraisal System		Columbia County
10/22/2007	8:46	Legal Description Maintenance	52800	Land 002
Year T	Property	Sel		AG 000
2007 R	36-4S-17-09048-001	...	19387	Bldg 001 *
	6355 COUNTY ROAD 245 SE		4100	Xfea 004
HX	SHEPPARD ROBERT DALE		76287	TOTAL B*

1	COMM NW COR OF SW1/4 OF NW1/4,	RUN E 111.70 FT TO E R/W	2
3	CR-245 FOR POB, CONT E 668.30	FT, S 330.75 FT, W 668.30 FT	4
5	TO SAID E R/W LINE, N ALONG	R/W 330.75 FT TO POB.	6
7	ORB 818-1969		8
9			10
11			12
13			14
15			16
17			18
19			20
21			22
23			24
25			26
27			28

Mnt 9/19/1997 TERR

F1=Task F3=Exit F4=Prompt F10=GoTo PgUp/PgDn F24=More

COLUMBIA COUNTY INSPECTION SHEET

DATE 10/26/2007

TAKEN BY HD

INSPECTION DATE: 10-26-07

BUILDING PERMIT # 000026360 CULVERT / WAIVER PERMIT # _____ WAIVER _____

PARCEL ID # 36-4S-17-09048-001 ZONING A-3

TYPE OF DEVELOPMENT MH, UTILITY

SETBACKS: FRONT 30.00 REAR 25.00 SIDE 25.00 HEIGHT _____

FLOOD ZONE X SEPTIC 07-819 NO. EXISTING D.U. 0

SUBDIVISION _____ Lot _____ Block _____ Unit _____ Phase _____

OWNER ROBERT SHEPPARD PHONE _____

ADDRESS _____ FL _____

CONTRACTOR ROBERT SHEPPARD PHONE 623-2203

LOCATION 100, TR PRICE CREEK RD, , JUST BEFORE HOPEFUL CHURCH

ON LEFT _____

COMMENTS: FLOOR ONE FOOT ABOVE THE ROAD

*Did not get release from E&H
E&H was notified
GP*

INSPECTION(S) REQUESTED:

☐ Temp Power ☐ Foundation ☐ Set backs
☐ Mono Slab ☐ Under Slab Rough-in ☐ Slab
☐ Sheathing/Nailing ☐ Framing ☐ Other
☐ Above slab Rough-in ☐ Electrical Rough-in
☐ Heat & A/C ☐ Beam (Lintel) ☐ Perm Power
☐ CO Final ☐ Culvert ☐ Reconnection
☐ Pool ☒ MH Perm Power ☐ Utility Pole
☐ RV Power ☐ Re-Roof ☐ MH Pole

INSPECTORS:

APPROVED ☒ NOT APPROVED _____ BY 301 POWER CO. clay

INSPECTORS COMMENTS: _____

referred to E&H 10/29/07