


Mobile Home Permit Worksheet

Installer: Michael Brannon License # TH/1025396
 Address of home being installed 1197 SW Hartford Way
Lake City, FL, 32024
 Manufacturer Fleetwood Length x width 70 x 14

NOTE: If home is a single wide fill out one half of the blocking plan
 If home is a triple or quad wide sketch in remainder of home
 I understand Lateral Arm Systems cannot be used on any home (new or used)
 where the sidewall ties exceed 5 ft 4 in.

Installer's initials MB

Typical pier spacing

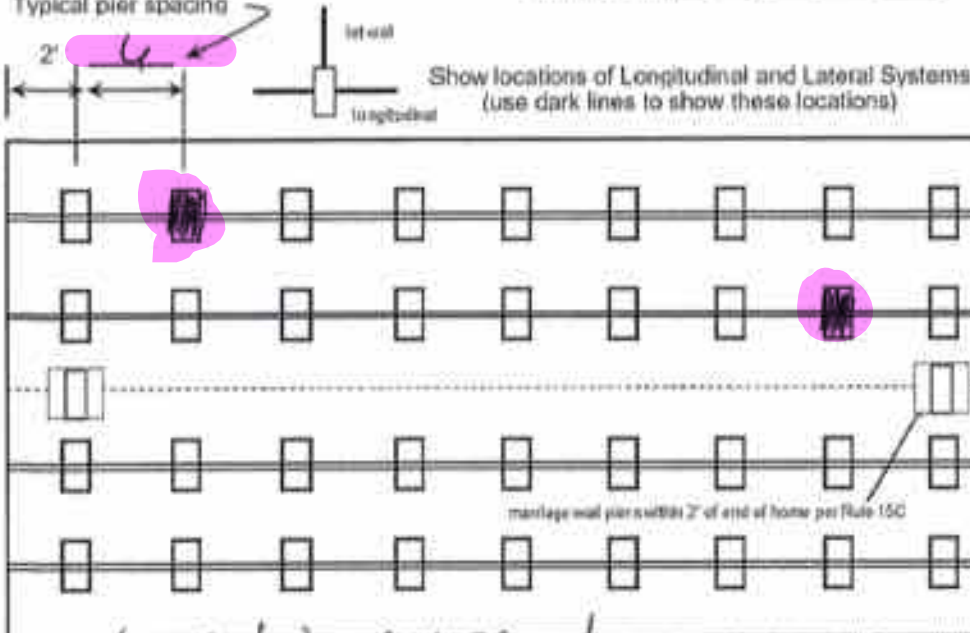

110IU All steel
EL 17x25 ABS I beam 6' OC



Application Number: _____ Date: _____

New Home ☐ Used Home ☒
 Home installed to the Manufacturer's Installation Manual ☒
 Home is installed in accordance with Rule 15-C
 Single wide ☒ Wind Zone II ☒ Wind Zone III ☐
 Double wide ☐ Installation Decal # 121472
 Triple/Quad ☐ Serial # FLFLN70A2D344CM/2662A

PIER SPACING TABLE FOR USED HOMES

Load bearing capacity	Footer size (sq in)	16" x 16" (256)	18 1/2" x 18 1/2" (342)	20" x 20" (400)	22" x 22" (484)	24" x 24" (576)	26" x 26" (676)
1000 psf		3'	4'	5'	6'	7'	8'
1500 psf		4' 6"	5'	7'	8'	8'	8'
2000 psf		6'	6'	8'	8'	8'	8'
2500 psf		7' 6"	8'	8'	8'	8'	8'
3000 psf		8'	8'	8'	8'	8'	8'
3500 psf		8'	8'	8'	8'	8'	8'

* interpolated from Rule 15C-1 pier spacing table

PIER PAD SIZES

I-beam pier pad size 17x25
 Perimeter pier pad size 16x16
 Other pier pad sizes (required by the mfg.) _____

Draw the approximate locations of marriage wall openings 4 foot or greater. Use this symbol to show the piers.

List all marriage wall openings greater than 4 foot and their pier pad sizes below

Opening	Pier pad size

POPULAR PAD SIZES

Pad Size	Sq In
18 x 18	256
18 x 18	288
18.5 x 18.5	342
16 x 22.5	360
17 x 22	374
13 1/4 x 26 1/4	348
20 x 20	400
17 3/16 x 25 3/16	441
17 1/2 x 25 1/2	446
24 x 24	576
26 x 26	676

ANCHORS

4 ft 5 ft
 within 2' of end of home spaced at 5' 4" oc

FRAME TIES

OTHER TIES

	Number
Sidewall	4
Longitudinal	2
Marriage wall	
Shearwall	

TIEDOWN COMPONENTS

Longitudinal Stabilizing Device (LSD)
 Manufacturer OT
 Longitudinal Stabilizing Device w/ Lateral Arms
 Manufacturer _____

Mobile Home Permit Worksheet

Application Number: _____ Date: _____

POCKET PENETROMETER TEST

The pocket penetrometer tests are rounded down to 1500 psf or check here to declare 1000 lb. soil without testing.

x 1.5 x 1.5 x 1.5

POCKET PENETROMETER TESTING METHOD

1. Test the perimeter of the home at 6 locations.
2. Take the reading at the depth of the footer.
3. Using 500 lb. increments, take the lowest reading and round down to that increment.

x 1.5 x 1.5 x 1.5

TORQUE PROBE TEST

The results of the torque probe test is _____ inch pounds or check here if you are declaring 5' anchors without testing. A test showing 275 inch pounds or less will require 5 foot anchors.

Note: A state approved lateral arm system is being used and 4 ft. anchors are allowed at the sidewall locations. I understand 5 ft. anchors are required at all centerline tie points where the torque test reading is 275 or less and where the mobile home manufacturer may require anchors with 4000 lb holding capacity.

ABJ Installer's initials

ALL TESTS MUST BE PERFORMED BY A LICENSED INSTALLER

Installer Name

Manuel B. Brown

Date Tested

7-14-25

Electrical

Connect electrical conductors between multi-wide units, but not to the main power source. This includes the bonding wire between multi-wide units. Pg. 15C

Plumbing

Connect all sewer drains to an existing sewer tap or septic tank. Pg. 15C

Connect all potable water supply piping to an existing water meter, water tap, or other independent water supply systems. Pg. _____



Site Preparation

Debris and organic material removed _____
Water drainage: Natural _____ Swale _____ Pad (X) Other _____

Fastening multi wide units

Floor: Type Fastener: _____ Length: _____ Spacing: _____
Walls: Type Fastener: _____ Length: _____ Spacing: _____
Roof: Type Fastener: Self Length: _____ Spacing: _____
For used homes a min. 30 gauge, 8' wide, galvanized metal strip will be centered over the peak of the roof and fastened with adv. roofing nails at 2" on center on both sides of the centerline.

Gasket (weatherproofing required)

I understand a properly installed gasket is a requirement of all new and used homes and that condensation, mold, mildew and buckled marriage walls are a result of a poorly installed or no gasket being installed. I understand a strip of tape will not serve as a gasket.

Installer's initials

Type gasket
Pg. _____

Installed: CW
Between Floors Yes
Between Walls Yes
Bottom of ridgebeam Yes

Weatherproofing

The bottomboard will be repaired and/or taped. Yes (X) Pg. _____
Siding on units is installed to manufacturer's specifications. Yes (X)
Fireplace chimney installed so as not to allow intrusion of rain water. Yes (X)

Miscellaneous

Skirting to be installed. Yes (X) No _____
Dryer vent installed outside of skirting. Yes _____ N/A _____
Range downflow vent installed outside of skirting. Yes _____ N/A _____
Drain lines supported at 4 foot intervals. Yes (X)
Electrical crossovers protected. Yes _____
Other: _____

Installer verifies all information given with this permit worksheet is accurate and true based on the manufacturer's installation instructions and or Rule 15C-1 & 2

Installer Signature

Manuel B. Brown

Date

7-14-25

Watson - D.S.

License Number: TH / 1025396 / 1 Name: MANUEL M. BRANNAN

Order # 6664	Label # 121472	Manufacturer Fleetwood	(Check Size of Home)
Homeowner Adam & Kristian Ford	Year Model 1992		Single _____
Address	Length & Width 70 x 14		Double _____
City/State/Zip	Type Longitudinal System		Triple _____
Phone #	Type Lateral Arm System		HUD Label # _____
Date Installed	New Home _____ Used Home _____		Soil Bearing / PSF _____
Installed Wind Zone	Data Plate Wind Zone		Torque Probe / in-lbs _____
Note:			Permit # _____



STATE OF FLORIDA
INSTALLATION CERTIFICATION LABEL

121472

LABEL # DATE OF INSTALLATION

MANUEL M. BRANNAN

NAME

TH / 1025396 / 1 6664

LICENSE # ORDER #

CERTIFIES THAT THE INSTALLATION OF THIS MOBILE HOME IS
IN ACCORDANCE WITH FLORIDA STATUTES 320.8249, 320.8325
AND RULES OF THE HIGHWAY SAFETY AND MOTOR VEHICLES.

INSTRUCTIONS

PLEASE WRITE DATE OF
INSTALLATION AND AFFIX
LABEL NEXT TO HUD LABEL.
USE PERMANENT INK PEN
OR MARKER ONLY.
COMPLETE INFORMATION
ABOVE AND KEEP ON FILE
FOR A MINIMUM OF 2 YEARS.
YOU ARE REQUIRED TO
PROVIDE COPIES WHEN
REQUESTED.