




# Mobile Home Permit Worksheet

Installer: Rodney Carmichael License # IH/1025656  
 Address of home being installed: 2349 SW Centerline Ave FT White

Manufacturer: Pion Length x width: 16x76

**NOTE:** If home is a single wide fill out one half of the blocking plan if home is a triple or quad wide sketch in remainder of home I understand Lateral Arm Systems cannot be used on any home (new or used) where the sidewall ties exceed 5 ft 4 in.

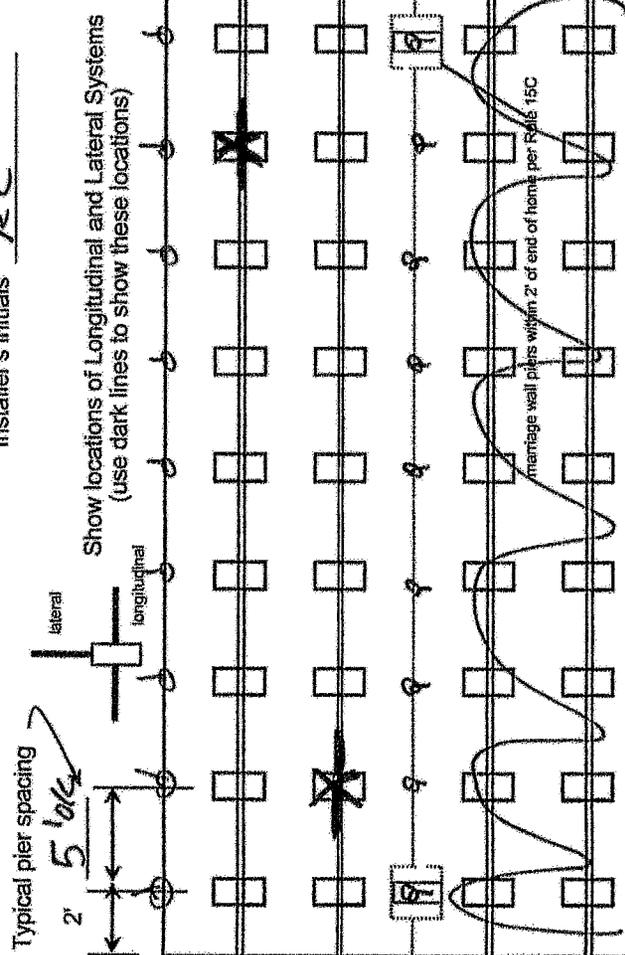

**PIER SPACING TABLE FOR USED HOMES**

Load bearing capacity	Footer size (sq in)	16" x 16" (256)	18 1/2" x 18 1/2" (342)	20" x 20" (400)	22" x 22" (484)*	24" x 24" (576)*	26" x 26" (676)
1000 psf	3'	4'	5'	6'	7'	8'	8'
1500 psf	4'6"	6'	7'	8'	8'	8'	8'
2000 psf	6'	8'	8'	8'	8'	8'	8'
2500 psf	7'6"	8'	8'	8'	8'	8'	8'
3000 psf	8'	8'	8'	8'	8'	8'	8'
3500 psf	8'	8'	8'	8'	8'	8'	8'

\*Interpolated from Rule 15C-1 pier spacing table.

**POPULAR PAD SIZES**

Pad Size	Sq In
16 x 16	256
16 x 18	288
18.5 x 18.5	342
16 x 22.5	360
17 x 22	374
13 1/4 x 26 1/4	348
20 x 20	400
17 3/16 x 25 3/16	441
17 1/2 x 25 1/2	446
24 x 24	576
26 x 26	676

Permit Number: \_\_\_\_\_ Date: \_\_\_\_\_  
 New Home  Used Home  
 Home installed to the Manufacturer's Installation Manual  
 Home is installed in accordance with Rule 15-C   
 Single wide  Wind Zone II  Wind Zone III   
 Double wide  Installation Decal # on order  
 Triple/Quad  Serial # PH1506GA11047


**PIER PAD SIZES**  
 I-beam pier pad size: 17x85"  
 Perimeter pier pad size: 16x16  
 Other pier pad sizes (required by the mfg.): N/A

Draw the approximate locations of marriage wall openings 4 foot or greater. Use this symbol to show the piers.  
 List all marriage wall openings greater than 4 foot and their pier pad sizes below.

4 ft  5 ft \_\_\_\_\_

**ANCHORS**  
**FRAME TIES**  
 within 2' of end of home spaced at 5' 4" oc AL  
**OTHER TIES**  
 Number 6  
 Sidewall 2  
 Longitudinal Marriage Wall N/A  
 Shear Wall N/A

**TIEDOWN COMPONENTS**  
 Longitudinal Stabilizing Device (LSD)  
 Manufacturer Oliver Technologies 1021 LV  
 Longitudinal Stabilizing Device w/ Lateral Arms  
 Manufacturer N/A

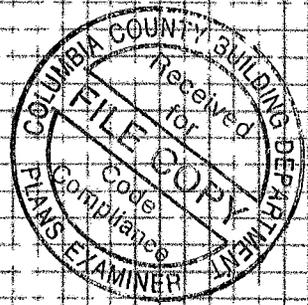



# Mobile Home Permit Worksheet

## POCKET PENETROMETER TEST

The pocket penetrometer tests are rounded down to \_\_\_\_\_ psf or check here to declare 1000 lb. soil  without testing.

X 1000 psf

## POCKET PENETROMETER TESTING METHOD

1. Test the perimeter of the home at 6 locations.
2. Take the reading at the depth of the footer.
3. Using 500 lb. increments, take the lowest reading and round down to that increment.

X

## TORQUE PROBE TEST

The results of the torque probe test is 290 inch pounds or check here if you are declaring 5' anchors without testing. A test showing 275 inch pounds or less will require 5' anchors.

**Note:** A state approved lateral arm system is being used and 4 ft. anchors are allowed at the sidewall locations. I understand 5' anchors are required at all centerline tie points where the torque test reading is 275 or less and where the mobile home manufacturer may require anchors with 4000 lb. holding capacity.

Installer's initials RC

## ALL TESTS MUST BE PERFORMED BY A LICENSED INSTALLER

Installer Name Rodney Carricho

Date Tested 11-20-25

## ELECTRICAL

Connect electrical conductors between multi-wide units, but not to the main power source. This includes the bonding wire between multi-wide units. Pg. N/A

## PLUMBING

Connect all sewer drains to an existing sewer tap or septic tank. Pg. 15-22

Connect all potable water supply piping to an existing water meter, water tap, or other independent water supply systems. Pg. 15-25

Permit Number: \_\_\_\_\_

Date: \_\_\_\_\_

## Site Preparation

Debris and organic material removed YES  
Water drainage: Natural \_\_\_\_\_ Swale \_\_\_\_\_ Pad  Other \_\_\_\_\_

## Fastening multi wide units

Floor- Type Fastener: \_\_\_\_\_ Length: \_\_\_\_\_ Spacing: \_\_\_\_\_  
 Walls- Type Fastener: N/A Length: N/A Spacing: N/A  
 Roof- Type Fastener: \_\_\_\_\_ Length: \_\_\_\_\_ Spacing: \_\_\_\_\_

For used homes a min. 30 gauge, 8" wide, galvanized metal strip will be centered over the peak of the roof and fastened with galv. roofing nails at 2' on center on both sides of the centerline.

## Gasket (weatherproofing requirement)

I understand a properly installed gasket is a requirement of all new and used homes and that condensation, mold, mildew and buckled marriage walls are a result of a poorly installed or no gasket being installed. I understand a strip of tape will not serve as a gasket.

Installer's initials \_\_\_\_\_

Type gasket N/A Installed: \_\_\_\_\_

Between Floors N/A Yes  No \_\_\_\_\_

Between Walls N/A Yes  No \_\_\_\_\_

Bottom of ridge beam N/A Yes  No \_\_\_\_\_

## Weatherproofing

The bottom board will be repaired and/or taped. Yes  No \_\_\_\_\_ Pg. \_\_\_\_\_

Siding on units is installed to manufacturer's specifications. Yes  No \_\_\_\_\_

Fireplace chimney installed so as not to allow intrusion of rain water. Yes N/A No \_\_\_\_\_

## Miscellaneous

Skirting to be installed. Yes  No \_\_\_\_\_

Dryer vent installed outside of skirting. Yes  No \_\_\_\_\_

Range downflow vent installed outside of skirting. Yes  No \_\_\_\_\_

Drain lines supported at 4' intervals. Yes  No \_\_\_\_\_

Electrical crossovers protected. Yes  No \_\_\_\_\_

Other: \_\_\_\_\_

Installer verifies all information given with this permit worksheet is accurate and true based on the manufacturer's installation instructions and or Rule 15C-1 & 2

Installer's Signature [Signature] Date 11-20-25