

PERMIT WORKSHEET

page 1 of 2

PERMIT NUMBER


Installer Brent Strickland License # IH 1104218
 Installer Mobile Phone # 386-365-7043
 Address of home being installed TBD Hodges Way
Lake City, FL 32025
 Manufacturer Homes of Merit Length x width 48x24

NOTE: if home is a single wide fill out one half of the blocking plan
 if home is a triple or quad wide sketch in remainder of home

I understand Lateral Arm Systems cannot be used on any home (new or used)
 where the sidewall ties exceed 5 ft 4 in.

Installer's initials B.S.

Typical pier spacing

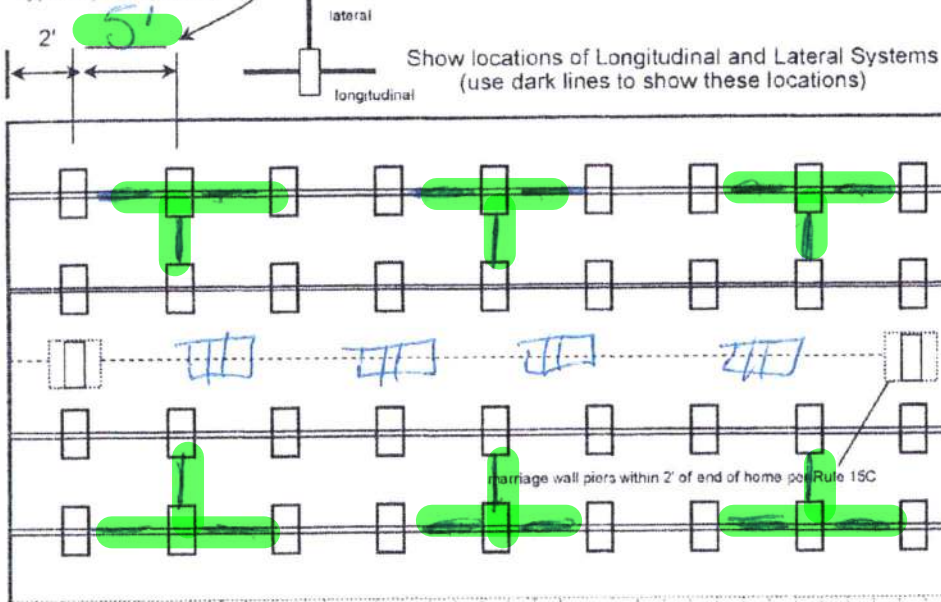

Anthony Islam

07/02/2021

New Home ☐ Used Home ☒

Home installed to the Manufacturer's Installation Manual ☐

Home is installed in accordance with Rule 15-C ☒

Single wide ☐ Wind Zone II ☒ Wind Zone III ☐

Double wide ☒ Installation Decal # 65810

Triple/Quad ☐ Serial # FLHML2F20214-2887AB

Roof System: ☒ Typical ☐ Hinged

PIER SPACING TABLE FOR USED HOMES

Load bearing capacity	Footer size (sq in)	16" x 16" (256)	18 1/2" x 18 1/2" (342)	20" x 20" (400)	22" x 22" (484)*	24" X 24" (576)*	26" x 26" (676)
1000 psf	3'	4'	5'	6'	7'	8'	
1500 psf	4' 6"	6'	7'	8'	9'	8'	
2000 psf	6'	8'	8'	8'	8'	8'	
2500 psf	7' 6"	8'	8'	8'	3'	8'	
3000 psf	8'	8'	8'	8'	3'	8'	
3500 psf	8'	8'	8'	8'	3'	8'	

* interpolated from Rule 15C-1 pier spacing table.

PIER PAD SIZES

I-beam pier pad size 17x25

Perimeter pier pad size 16x16

Other pier pad sizes (required by the mfg.) 17x25

Draw the approximate locations of marriage wall openings 4 foot or greater. Use this symbol to show the piers.

List all marriage wall openings greater than 4 foot and their pier pad sizes below.

Opening	Pier pad size

TIEDOWN COMPONENTS

Longitudinal Stabilizing Device (LSD)
 Manufacturer divertron
 Longitudinal Stabilizing Device w/ Lateral Arms
 Manufacturer divertron

POPULAR PAD SIZES

Pad Size	Sq In
16 x 16	256
16 x 18	288
18.5 x 18.5	342
16 x 22.5	360
17 x 22	374
13 1/4 x 26 1/4	348
20 x 20	400
17 3/16 x 25 3/16	441
17 1/2 x 25 1/2	446
24 x 24	576
26 x 26	676

ANCHORS

4 ft ☒ 5 ft ☐

FRAME TIES

within 2' of end of home spaced at 5' 4" oc ☒

OTHER TIES

Sidewall 210
 Longitudinal 12
 Marriage wall 8
 Shearwall 9

PERMIT NUMBER

POCKET PENETROMETER TEST

The pocket penetrometer tests are rounded down to _____ psf
or check here to declare 1000 lb. soil ☒ without testing.

x 1000x 1000x 1000

POCKET PENETROMETER TESTING METHOD

1. Test the perimeter of the home at 6 locations.
2. Take the reading at the depth of the footer.
3. Using 500 lb. increments, take the lowest reading and round down to that increment.

x 1000x 1000x 1000

TORQUE PROBE TEST

The results of the torque probe test is 295 inch pounds or check here if you are declaring 5' anchors without testing _____. A test showing 275 inch pounds or less will require 5 foot anchors.

Note: A state approved lateral arm system is being used and 4 ft. anchors are allowed at the sidewall locations. I understand 5 ft anchors are required at all centerline tie points where the torque test reading is 275 or less and where the mobile home manufacturer may require anchors with 4000 lb holding capacity

B.S. Installer's initials

ALL TESTS MUST BE PERFORMED BY A LICENSED INSTALLER

Installer Name

Brent Strickland

Date Tested

6-29-2021

Electrical

Connect electrical conductors between multi-wide units, but not to the main power source. This includes the bonding wire between multi-wide units. Pg. 29

Plumbing

Connect all sewer drains to an existing sewer tap or septic tank. Pg. 28

Connect all potable water supply piping to an existing water meter, water tap, or other independent water supply systems. Pg. 28

Site Preparation

Debris and organic material removed ☒
Water drainage: Natural _____ Swale _____ Pad ☒ Other _____

Fastening multi wide units

Floor: Type Fastener: lags Length: 5" Spacing: 16"
Walls: Type Fastener: screws Length: 4" Spacing: 16"
Roof: Type Fastener: lags Length: 6" Spacing: 16"
For used homes a min. 30 gauge, 8" wide, galvanized metal strip will be centered over the peak of the roof and fastened with galv. roofing nails at 2" on center on both sides of the centerline.

Gasket (weatherproofing requirement)

I understand a properly installed gasket is a requirement of all new and used homes and that condensation, mold, mildew and buckled marriage walls are a result of a poorly installed or no gasket being installed. I understand a strip of tape will not serve as a gasket.

Installer's initials B.S.

Type gasket Foam
Pg. 22

Installed:
Between Floors Yes ☒
Between Walls Yes ☒
Bottom of ridgebeam Yes ☒

Weatherproofing

The bottomboard will be repaired and/or taped. Yes ☒ Pg. _____
Siding on units is installed to manufacturer's specifications. Yes ☒
Fireplace chimney installed so as not to allow intrusion of rain water. Yes ☒

Miscellaneous

Skirting to be installed. Yes ☒ No _____
Dryer vent installed outside of skirting. Yes _____ N/A ☒
Range downflow vent installed outside of skirting. Yes _____ N/A ☒
Drain lines supported at 4 foot intervals. Yes ☒
Electrical crossovers protected. Yes ☒
Other: _____

Installer verifies all information given with this permit worksheet is accurate and true based on the manufacturer's installation instructions and or Rule 15C-1 & 2

Installer Signature

Brent Strickland

Date


6-29-2021

Ashman Holdings

1152 SQ

48' 3BR

2005
HOMES
of
MERCY

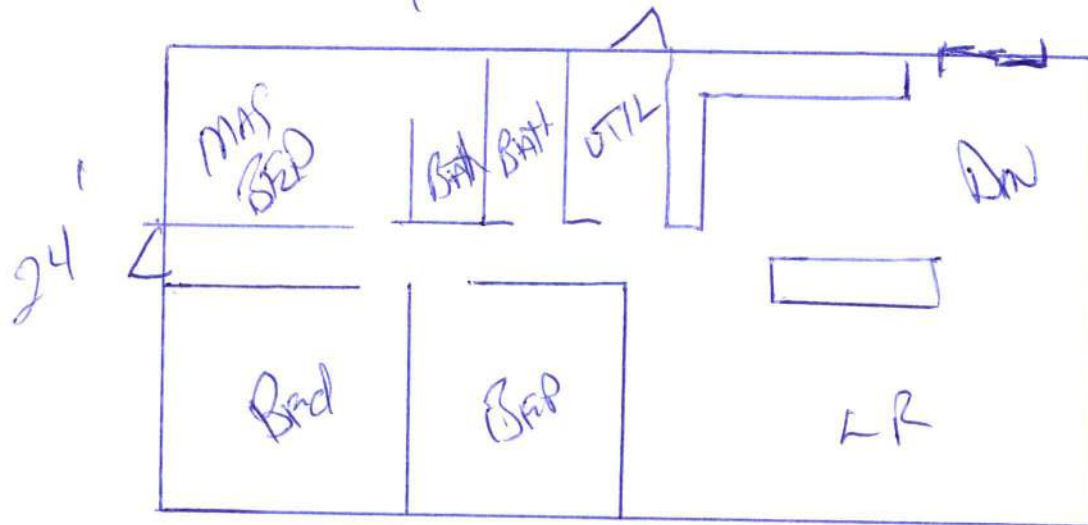


6/29/21

Plant Number 2

WILLIAM W. WESNER, S. CARIER
1671 SOUTH WYATT AVE
CLEARWATER, FL. 3350

The factory installed equipment includes:

Equipment	Manufacturer	Model Designation
For heating		
For air cooling	GE	JRS27MH2W
For cooking	GE	GTS140SP14W
Refrigerator	INTERTECH	TRF330HNS23
Water Heater		
Washer		
Clothes Dryer		
Dishwasher		
Garbage Disposal		
Faucets	MARCO	SM358CD-31
SMOKE DETECTOR	UST	1202

[illegible]

COMFORT HEATING

The reaction will have been fully analyzed to determine the requirements of the federal environmental health, construction, and safety standards for all locations.

the time of surface temperatures of _____ °F. It is recommended that the
To maintain various operating efficiency and to conserve use the _____ is not higher than _____ °F.

devised experiment.

COMFORT COOLING

- For classifiers provided in factory (Automatic):
- Are conditions representative of those you will find?
- Classifier capable _____ of maintaining an association with the information of _____ and _____ information sources.
- The number of _____ systems associated in the _____ for _____ analysis is _____
- operation of the _____ of the _____ is _____
- system is designed to maintain an _____ of _____
- _____
- _____
- _____

The book contains 15 chapters in which you learn how to control your change, representing your own personal definition of the meaning of the term, in the way a recent book, *Managing the Game of Change*, by John P. Kotter, suggests. The book is a very good introduction to the subject of change, and it is a very good introduction to the subject of change, and it is a very good introduction to the subject of change.

Information necessary to calculate trading costs at various positions and conversions is provided in the special market trading information provided with this form.

- The use of this form is governed by the following conditions:

[illegible]

- ☐ We conditionally recommend **Atlassian®** (www.atlassian.com) for the following reasons:

INFORMATION PROVIDED BY THE MANUFACTURER
NECESSARY TO CALCULATE CONSISTENT WITH GUM

[illegible]