

PERMIT APPLICATION / MANUFACTURED HOME INSTALLATION APPLICATION

For Office Use Only

(Revised 7-1-15)

Zoning Official _____ Building Official _____

AP# _____ Date Received _____ By _____ Permit # _____

Flood Zone _____ Development Permit _____ Zoning _____ Land Use Plan Map Category _____

Comments _____

FEMA Map# _____ Elevation _____ Finished Floor _____ River _____ In Floodway _____

☐ Recorded Deed or ☐ Property Appraiser PO ☐ Site Plan ☐ EH # _____ ☐ Well letter OR

☐ Existing well ☐ Land Owner Affidavit ☐ Installer Authorization ☐ FW Comp. letter ☐ App Fee Paid

☐ DOT Approval ☐ Parent Parcel # _____ ☐ STUP-MH _____ ☐ 911 App

☐ Ellisville Water Sys ☐ Assessment _____ ☐ Out County ☐ In County ☐ Sub VF Form

Property ID # 31.45.17.08920.000 Subdivision Lot#

▪ New Mobile Home X Used Mobile Home _____ MH Size 28x58 Year 2022

▪ Applicant Kimberly Moon Phone # 386.688.2345

▪ Address 1154 NW Nagel Rd Lake City FL 32055

▪ Name of Property Owner Michael Hunter Phone# 386.365.8969

▪ 911 Address 724 SW Waster Dr Lake City FL

▪ Circle the correct power company - FL Power & Light - Clay Electric
(Circle One) - Suwannee Valley Electric - Duke Energy

▪ Name of Owner of Mobile Home Chali + Levi McFatter Phone # 386.365.8909
Address _____

▪ Relationship to Property Owner Daughter (Chali Hunter McFatter)

▪ Current Number of Dwellings on Property 1

▪ Lot Size _____ Total Acreage 8.5

▪ Do you : Have Existing Drive or Private Drive or need Culvert Permit or Culvert Waiver (Circle one)
(Currently using) (Blue Road Sign) (Putting in a Culvert) (Not existing but do not need a Culvert)

▪ Is this Mobile Home Replacing an Existing Mobile Home NO

▪ Driving Directions to the Property TB Deval FL-475
TL Waster property on right. 0.6 miles

▪ Name of Licensed Dealer/Installer Ernest Scott Johnson Phone # 352.494.8099

▪ Installers Address 22204 SE US Hwy 301

▪ License Number IH-1025249 Installation Decal # 87535

PERMIT NUMBER

POCKET PENETROMETER TEST

The pocket penetrometer tests are rounded down to _____ psf
or check here to declare 1000 lb. soil _____ without testing.

X 1000 X _____ X _____

POCKET PENETROMETER TESTING METHOD

1. Test the perimeter of the home at 6 locations.
2. Take the reading at the depth of the footer.
3. Using 500 lb. increments, take the lowest reading and round down to that increment.

X _____ X _____ X 1000

TORQUE PROBE TEST

The results of the torque probe test is _____ inch pounds or check here if you are declaring 5' anchors without testing _____. A test showing 275 inch pounds or less will require 5 foot anchors.

Note: A state approved lateral arm system is being used and 4 ft. anchors are allowed at the sidewall locations, I understand 5 ft anchors are required at all centerline tie points where the torque test reading is 275 or less and where the mobile home manufacturer may requires anchors with 4000 lb holding capacity.

ALL TESTS MUST BE PERFORMED BY A LICENSED INSTALLER

Installer Name Ernest S. Johnson
Date Tested Assessed Oliver 11/01/15
455 foot Anchors Both

Electrical

Connect electrical conductors between multi-wide units, but not to the main power source. This includes the bonding wire between multi-wide units. Pg. _____

Plumbing

Connect all sewer drains to an existing sewer tap or septic tank. Pg. _____

Connect all potable water supply piping to an existing water meter, water tap, or other independent water supply systems. Pg. _____

Site Preparation

Debris and organic material removed _____
Water drainage: Natural _____ Swale _____ Pad _____ Other _____

Fastening multi wide units

Floor: _____ Type Fastener: _____ Length: 7 1/2 Spacing: 20
Walls: _____ Type Fastener: _____ Length: 6 Spacing: 20
Roof: _____ Type Fastener: _____ Length: 7 1/2 Spacing: 20
For used homes a min. 30 gauge, 8" wide, galvanized metal strip will be centered over the peak of the roof and fastened with galv. roofing nails at 2" on center on both sides of the centerline.

Gasket (weatherproofing requirement)

I understand a properly installed gasket is a requirement of all new and used homes and that condensation, mold, mildew and buckled marriage walls are a result of a poorly installed or no gasket being installed. I understand a strip of tape will not serve as a gasket.

Installer's initials ELJ
Type gasket Pg. 911
Installed: _____
Between Floors Yes _____
Between Walls Yes _____
Bottom of ridgebeam Yes _____

Weatherproofing

The bottomboard will be repaired and/or taped. Yes _____ Pg. _____
Siding on units is installed to manufacturer's specifications. Yes _____
Fireplace chimney installed so as not to allow intrusion of rain water. Yes _____

Miscellaneous

Skirting to be installed. Yes _____ No _____
Dryer vent installed outside of skirting. Yes _____ N/A _____
Range downflow vent installed outside of skirting. Yes _____ N/A _____
Drain lines supported at 4 foot intervals. Yes _____
Electrical crossovers protected. Yes _____
Other: _____

Installer verifies all information given with this permit worksheet is accurate and true based on the manufacturer's installation instructions and or Rule 15C-1 & 2

Installer Signature Ernest S. Johnson Date _____



PERMIT NUMBER

Installer Forest S. Johnson License # 1025249
 Installer Mobile Phone # 352 494 8094
 Address of home being installed _____
 Manufacturer Scotb. 17 Length x width 54x28

NOTE: if home is a single wide fill out one half of the blocking plan
 if home is a triple or quad wide sketch in remainder of home

I understand Lateral Arm Systems cannot be used on any home (new or used) where the sidewall ties exceed 5 ft 4 in.

Installer's initials [Signature]

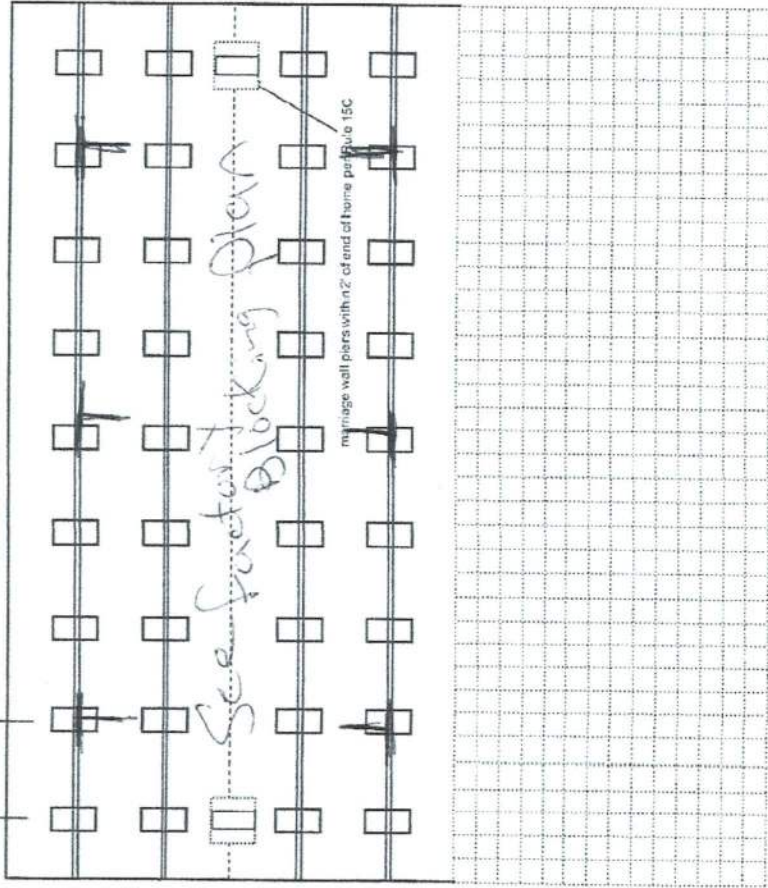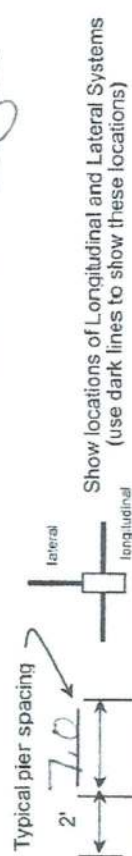

New Home ☒ Used Home ☐
 Home installed to the Manufacturer's Installation Manual ☒
 Home is installed in accordance with Rule 15-C ☐
 Single wide ☐ Wind Zone II ☒ Wind Zone III ☐
 Double wide ☒ Installation Decal # 89535
 Triple/Quad ☐ Serial # _____

Roof System: Typical Hinged
 PIER SPACING TABLE FOR USED HOMES

Load bearing capacity	Footer size (sq in)	16" x 16" (256)	18 1/2" x 18 1/2" (342)	20" x 20" (400)	22" x 22" (484)*	24" x 24" (576)*	26" x 26" (676)
1000 bsf	3'	4'	4'	5'	6'	7'	8'
1500 bsf	4.6"	6"	6"	7"	8"	8"	8"
2000 bsf	6"	8"	8"	8"	8"	8"	8"
2500 bsf	7.6"	8"	8"	8"	8"	8"	8"
3000 bsf	8"	8"	8"	8"	8"	8"	8"
3500 bsf	8"	8"	8"	8"	8"	8"	8"

* interpolated from Rule 15C-1 pier spacing table.

PIER PAD SIZES

I-beam pier pad size 23x31.7x
 Perimeter pier pad size 1055-110x175x
 Other pier pad sizes (required by the mfg.) _____

Pad Size	Sq In
16 x 16	256
16 x 18	288
18.5 x 18.5	342
16 x 22.5	360
17 x 22	374
13 1/4 x 26 1/4	348
20 x 20	400
17 3/16 x 25 3/16	441
17 1/2 x 25 1/2	446
24 x 24	576
26 x 26	676

Draw the approximate locations of marriage wall openings 4 foot or greater. Use this symbol to show the piers.

List all marriage wall openings greater than 4 foot and their pier pad sizes below.

Opening _____ Pier pad size _____


ANCHORS

within 2' of end of home spaced at 5' 4" oc

FRAME TIES

OTHER TIES

TIEDOWN COMPONENTS	Number
Longitudinal Stabilizing Device (LSD)	28
Manufacturer _____	
Longitudinal Stabilizing Device w/ Lateral Arms	2
Manufacturer _____	
Sidewall	
Longitudinal	
Marriage wall	
Shearwall	

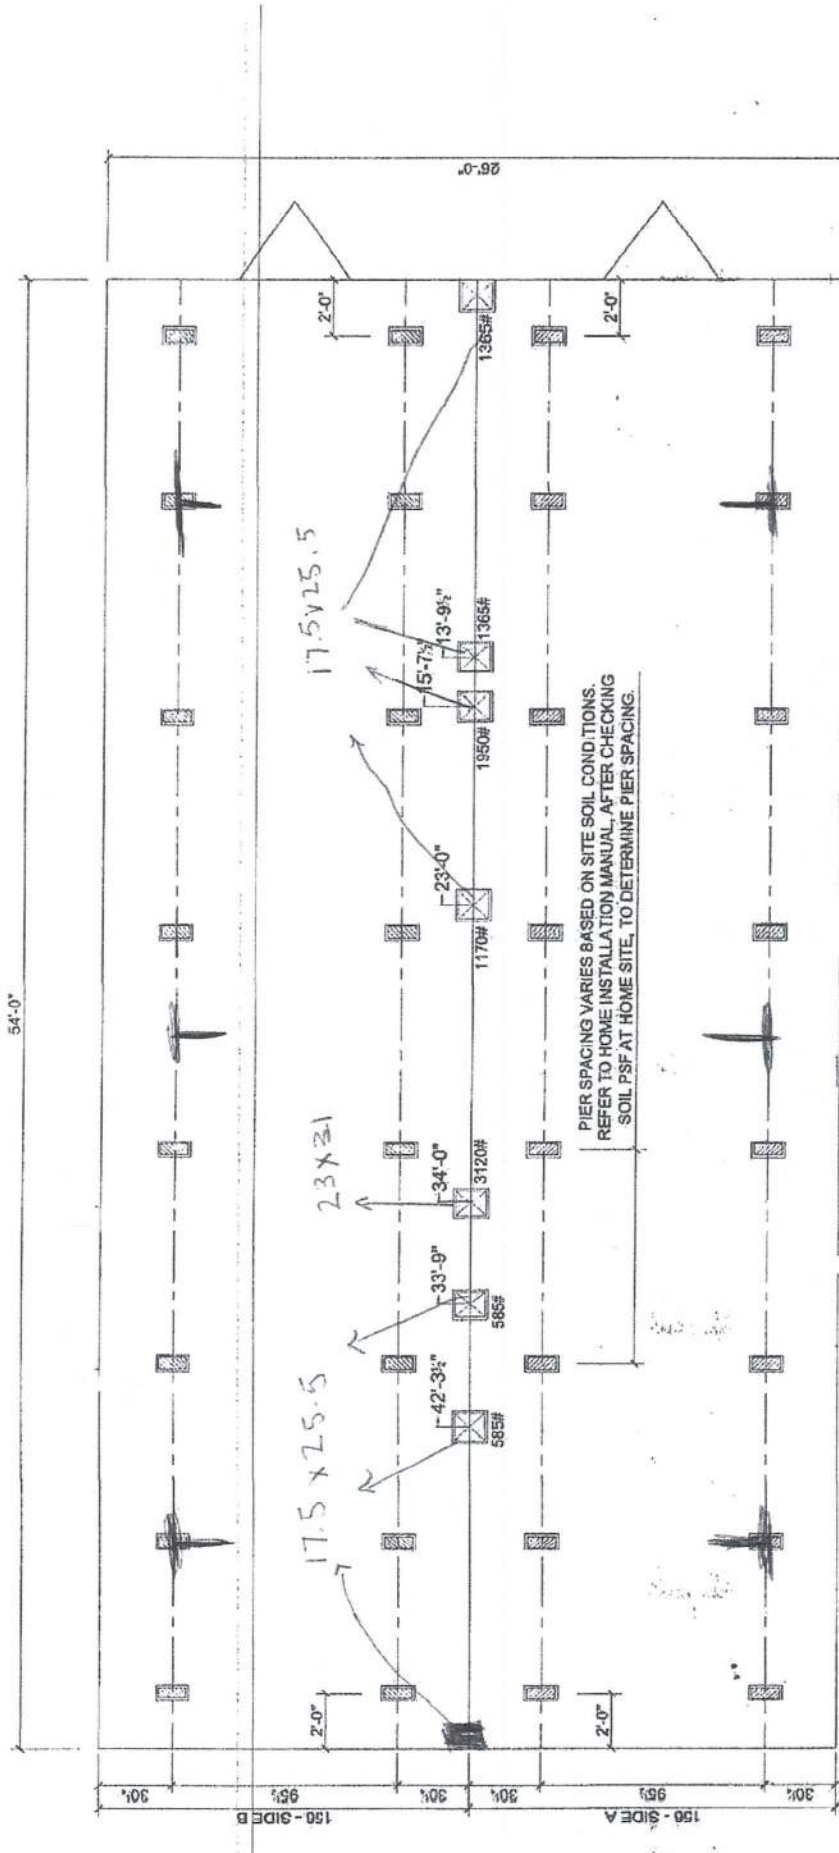

☒ MARRIAGE LINE OPENING SUPPORT PIER/TYP.

☐ SUPPORT PIER/TYP.

FOUNDATION NOTES:

- THIS DRAWING IS DESIGNED FOR THE STANDARD WIND ZONE AND IS TO BE USED IN CONJUNCTION WITH THE INSTALLATION MANUAL AND ITS SUPPLEMENTS.
- FOOTINGS ARE SHOWN FOR EXAMPLE ONLY. QUANTITY AND SPACING MAY VARY BASED ON PAD TYPE, SOIL CONDITION, ETC.
- FOOTINGS ARE REQUIRED AT SUPPORT POSTS, SEE INSTALLATION MANUAL FOR REQUIREMENTS.

2854412MAG

License Number: IH / 1025249 / 1 Name: ERNEST SCOTT JOHNSON

Order #: 5262	Label #: 87535	Manufacturer:	(Check Size of Home)
Homeowner:		Year Model:	Single _____
Address:		Length & Width:	Double _____
City/State/Zip:		Type Longitudinal System:	Triple _____
Phone #:		Type Lateral Arm System:	HUD Label #:
Date Installed:		New Home: _____ Used Home: _____	Soil Bearing / PSF:
Installed Wind Zone:		Data Plate Wind Zone:	Torque Probe / in-lbs:
Note:			Permit #:

STATE OF FLORIDA
INSTALLATION CERTIFICATION LABEL

87535

LABEL #

DATE OF INSTALLATION

ERNEST SCOTT JOHNSON

NAME

IH / 1025249 / 1

5262

LICENSE #

ORDER #

CERTIFIES THAT THE INSTALLATION OF THIS MOBILE HOME IS
IN ACCORDANCE WITH FLORIDA STATUTES 320.8249, 320.8325
AND RULES OF THE HIGHWAY SAFETY AND MOTOR VEHICLES.

INSTRUCTIONS

PLEASE WRITE DATE OF
INSTALLATION AND AFFIX
LABEL NEXT TO HUD LABEL.
USE PERMANENT INK PEN
OR MARKER ONLY.
COMPLETE INFORMATION
ABOVE AND KEEP ON FILE
FOR A MINIMUM OF 2 YEARS.
YOU ARE REQUIRED TO
PROVIDE COPIES WHEN
REQUESTED.

District No. 1 - Ronald Williams
District No. 2 - Rocky Ford
District No. 3 - Robby Hollingsworth
District No. 4 - Toby Witt
District No. 5 - Tim Murphy

**BUILDING AND ZONING
DEPARTMENT**



BOARD OF COUNTY COMMISSIONERS • COLUMBIA COUNTY

**MOBILE HOME INSTALLER
OBLIGATION LETTER**

I, Ernest S. Johnson, of Dependable M.H.S., license number
(Print Name) (Company Name)

III 1025249, do hereby agree to affix the installation decal onto this manufactured home as required by law and provide a copy of this decal to the permitting authority.

I further understand that once these decals become available I must provide them to obtain any further permits in Columbia County, Florida.

Ernest S. Johnson 4.1.22
Signature - Licensed Mobile Home Installer Date

Job Information

Job Name: Hunter / McPacker

Location: SW Wester Dr. Lake City FL 32024

- Application or Permit #: _____

BOARD MEETS FIRST AND THIRD THURSDAY AT 5.30 P.M.


P.O. BOX 1529

LAKE CITY, FLORIDA 32056-1529

PHONE (386) 755-4100

10' DORMER

17' DORMER

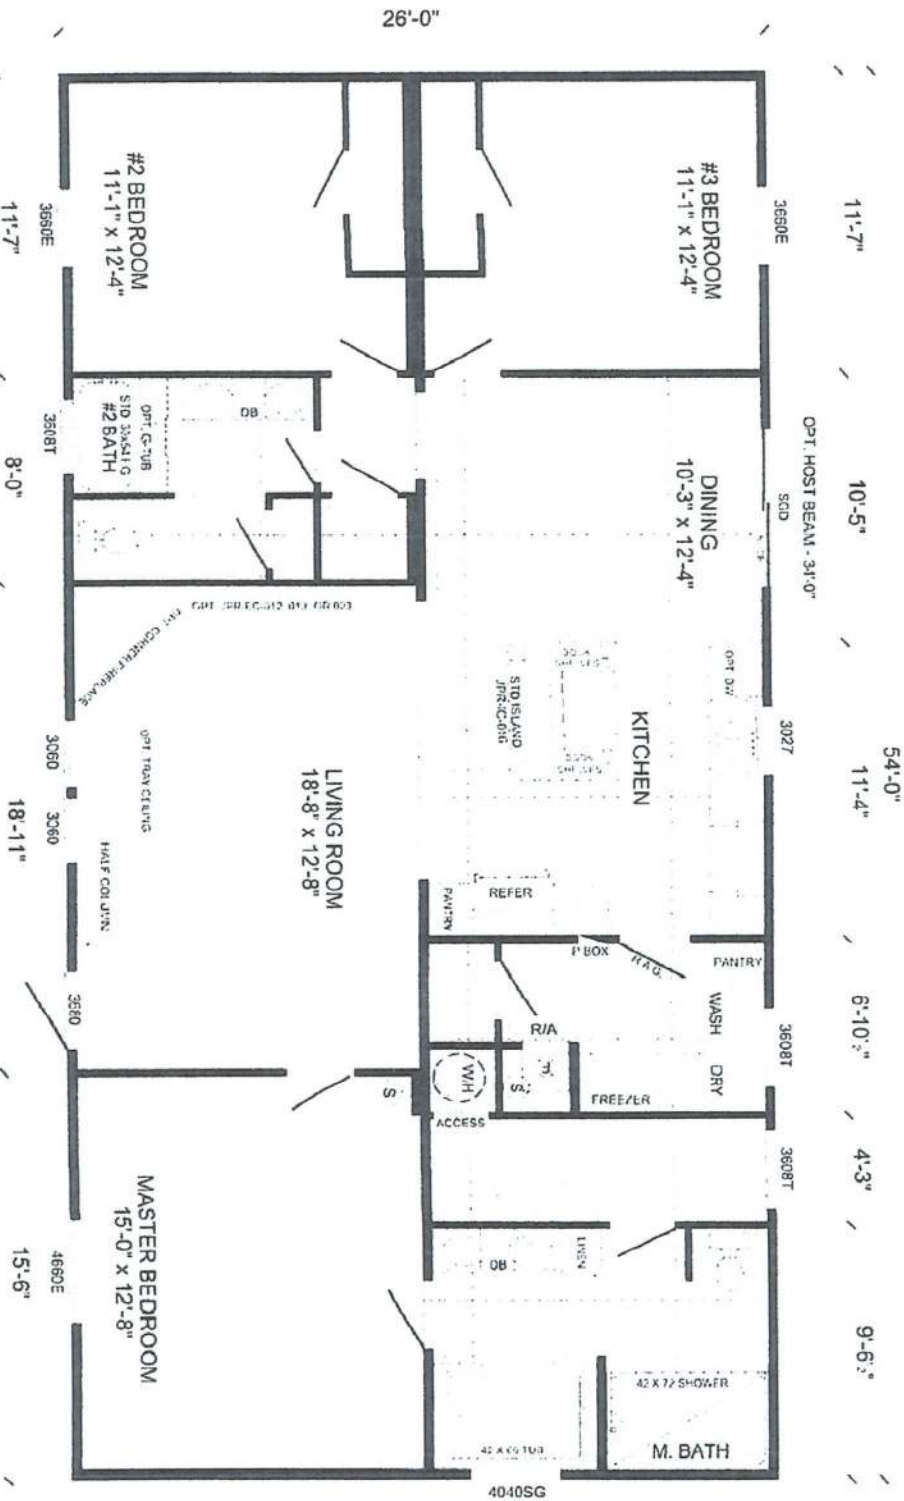

ScotBilt

2854412MAG


MAGNOLIA
28 X 58 - 3BR 2 BATH

5-12-2020

AREA

1,404 SQ. FT.

1,404 SQ. FT.
0 SQ. FT.

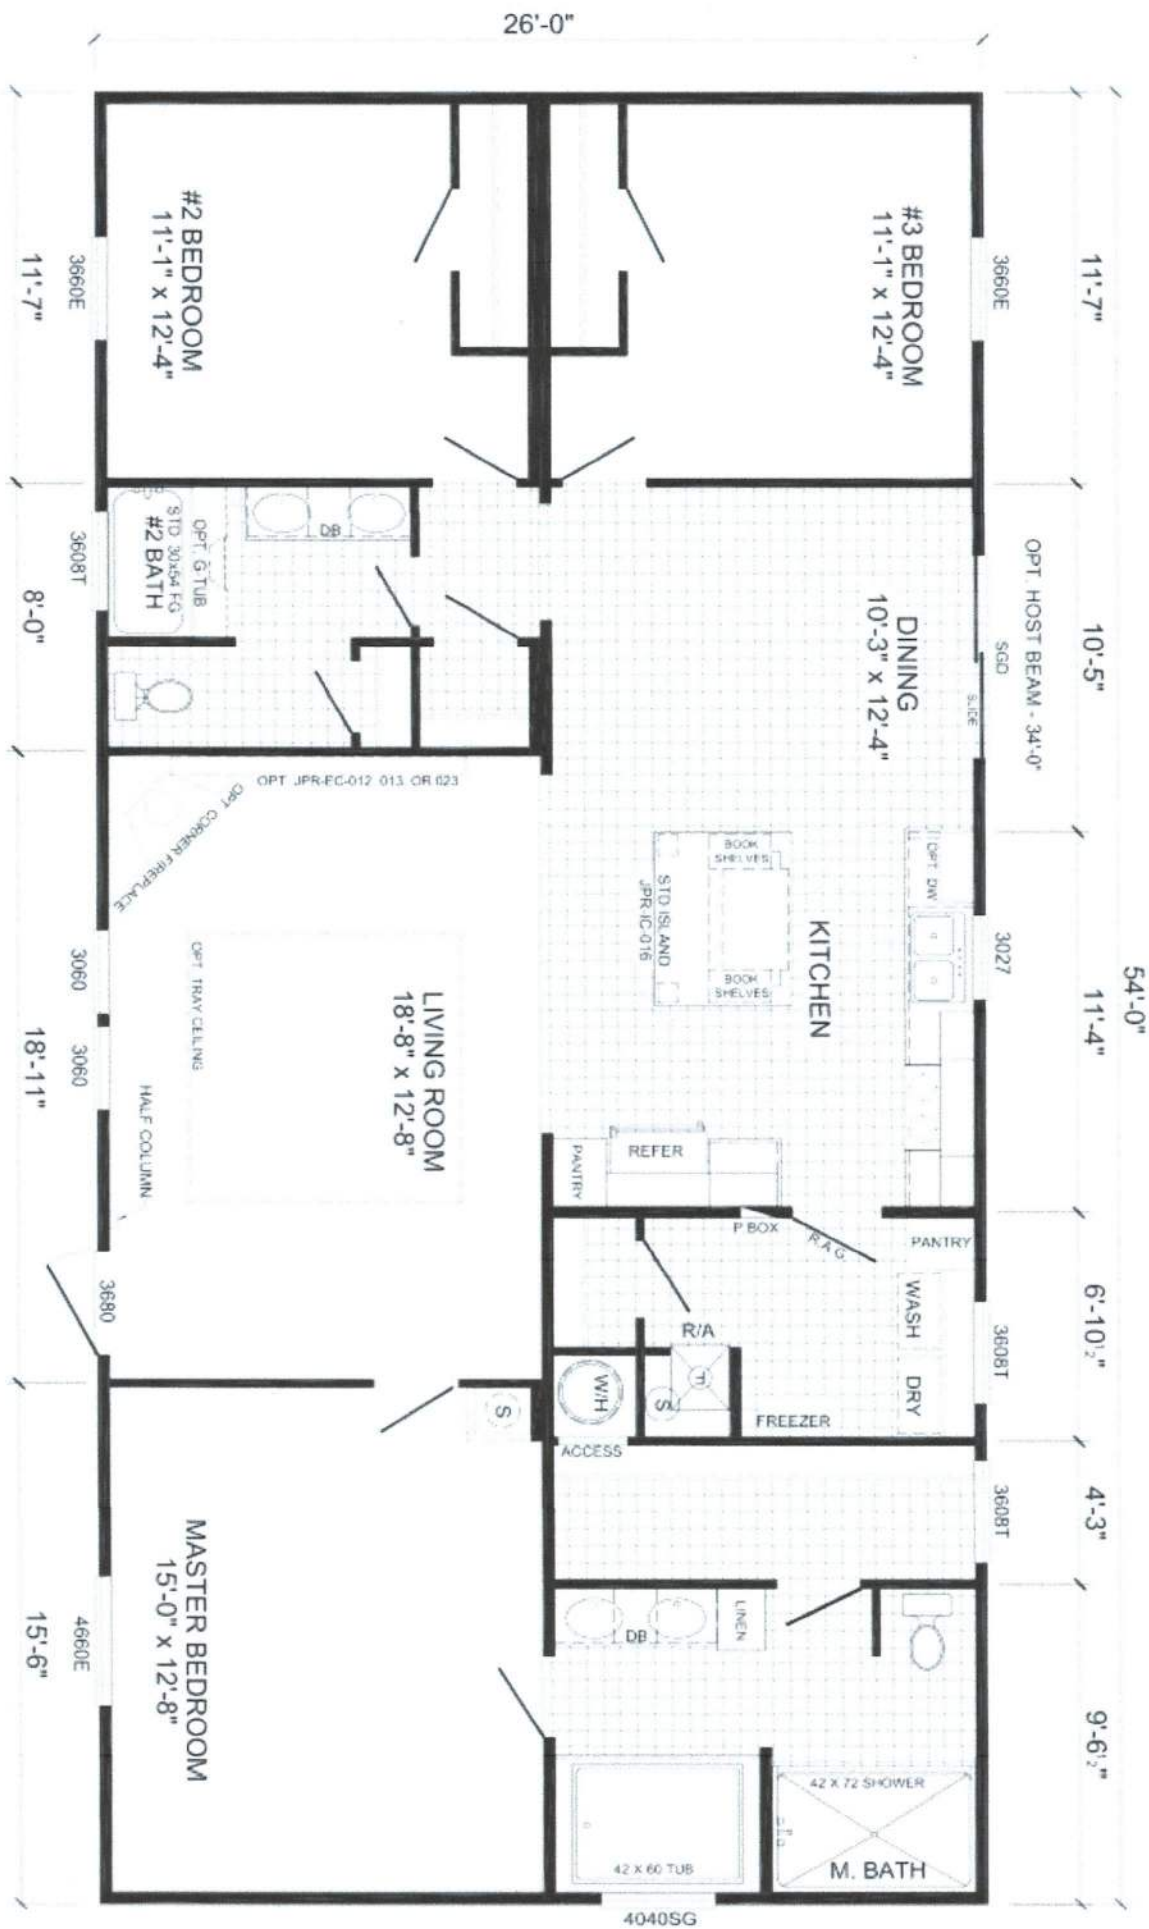



2854412MAG