

COLUMBIA COUNTY PERMIT WORKSHEET

page 1 of 2

These worksheets must be completed and signed by the installer.
Submit the originals with the packet.

Installer Dave Houston License # JH1028142


911 Address where home is being installed _____

Manufacturer Electroweld Length x width 56X14

NOTE: If home is a single wide fill out one half of the blocking plan. If home is a triple or quad wide sketch in remainder of home.

I understand Lateral Arm Systems cannot be used on any home (new or used) where the sidewall ties exceed 5 ft. 4 in.

Installer's initials DH

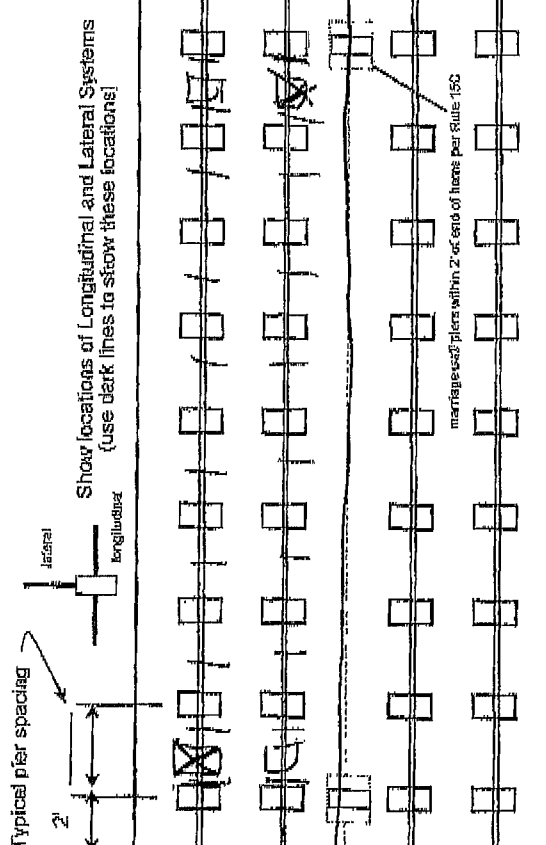

14X52-1000 post 17X25
Pier 11 ft x 14 in. 5' 0" x 14
Anchor 10 ft x 14 in. 5' 14" x 14
2- Longitudinal System

New Home ☐ Used Home ☒

Home installed to the Manufacturer's Installation Manual ☐

Home is installed in accordance with Rule 15-C ☐

Single wide ☒ Wind Zone II ☒ Wind Zone III ☐

Double wide ☐ Installation Detail # 18716

Triple/Quad ☐ Serial # 64PL175403788 WE

PIER SPACING TABLE FOR USED HOMES

Lead bearing capacity	Footer size (sq in)	16" x 16" (256)	18 1/2" x 18 1/2" (342)	20" x 20" (400)	22" x 22" (484)	24" x 24" (576)	26" x 26" (676)
1000 Dsf	3'	4'	5'	6'	7'	8'	8'
1500 Dsf	4'	5'	6'	7'	8'	9'	9'
2000 Dsf	5'	6'	7'	8'	9'	10'	10'
2500 Dsf	6'	7'	8'	9'	10'	11'	11'
3000 Dsf	7'	8'	9'	10'	11'	12'	12'
3500 Dsf	8'	9'	10'	11'	12'	13'	13'

* Interpolated from Rule 15-C-1 pier spacing table.

PIER PAD SIZES

I-beam pier pad size 17X28

Perimeter pier pad size 14X16

Other pier pad sizes (required by the mfg.) _____

Draw the approximate locations of marriage wall openings 4 foot or greater. Use this symbol to show tie piers.

List all marriage wall openings greater than 4 foot and their pier pad sizes below.

Opening _____ Pier pad size _____

ANCHORS 4 ft 5 ft

FRAME TIES

within 2' of end of home spaced at 5' 4" oc

TIEDOWN COMPONENTS

Longitudinal Stabilizing Device (LSD) Manufacturer Electroweld

Longitudinal Stabilizing Device w/ Lateral Arms Manufacturer _____

OTHER TIES

Number _____

Side wall _____

Longitudinal _____

Marriage wall _____

Shear wall _____

COLUMBIA COUNTY PERMIT WORKSHEET

page 2 of 2

POCKET PENETROMETER TEST

The pocket penetrometer tests are rounded down to 200 psi without testing. psi

X X X

POCKET PENETROMETER TESTING METHOD

1. Test the perimeter of the home at 6 locations.
2. Take the reading at the depth of the footer.
3. Using 500 lb. increments, take the lowest reading and round down to that increment.

X X X

TORQUE PROBE TEST

The results of the torque probe test is 200 inch pounds or check here if you are declaring 5' anchors without testing. A test showing 275 inch pounds or less will require 5 foot anchors

Note: A state approved lateral arm system is being used and 4 ft anchors are allowed at the sidewall locations. I understand 5 ft anchors are required at all centerline tie points where the torque test reading is 275 or less and where the mobile home manufacturer may require anchors with 4000 lb. holding capacity.

DA Installer's initials

ALL TESTS MUST BE PERFORMED BY A LICENSED INSTALLER

Installer Name Date Houston

Date Tested 3-6-14

Electrical

Connect electrical conductors between multi-wide units, but not to the main power source. This includes the bonding wire between multi-wide units. Pg. N/A

Plumbing

Connect all sewer drains to an existing sewer tap or septic tank. Pg. N/A

Connect all potable water supply piping to an existing water meter, water tap, or other independent water supply systems. Pg. N/A

Site Preparation

Debris and organic material removed

Water drainage: Natural Swale Pad Other

Fastening multi-wide units

Floor	Type Fastener	Length	Spacing
Walls	Type Fastener	Length	Spacing
Roof	Type Fastener	Length	Spacing

For used homes a min. 30 gauge, 8" wide, galvanized metal strip will be centered over the peak of the roof and fastened with galv. roofing nails at 2" on center on both sides of the centerline

Gasket (weatherstripping requirement)

I understand a properly installed gasket is a requirement of all new and used homes and that condensation, mold, mildew and buckled marriage walls are a result of a poorly installed or no gasket being installed. I understand a strip of tape will not serve as a gasket.

N/A Installer's initials

Type gasket

Pg Installed.

Between Floors Yes No

Between Walls Yes No

Bottom of ridgebeam Yes No

Weatherproofing

The bottomboard will be repaired and/or taped Yes No

Siding on units is installed to manufacturer's specifications. Yes No

Fireplace chimney installed so as not to allow intrusion of rain water. Yes No

Miscellaneous

Skirting to be installed Yes No

Dryer vent installed outside of skirting. Yes No

Range downflow vent installed outside of skirting. Yes No

Drain lines supported at 4 foot intervals Yes No

Electrical crossovers protected. Yes No

Other:

Installer verifies all information given with this permit worksheet is accurate and true based on the

Installer Signature Date Houston Date 3-6-14