


Mobile Home Permit Worksheet

Installer: Rudolph Kwoles License # ILH1033219
 Address of home being installed: SW Cain Ln
 Manufacturer: LLM DMC Length x width: 32x76


NOTE: if home is a single wide fill out one half of the blocking plan
 if home is a triple or quad wide sketch in remainder of home
 I understand Lateral Arm Systems cannot be used on any home (new or used)
 where the sidewall ties exceed 5 ft 4 in.

Installer's initials: RK

Typical pier spacing

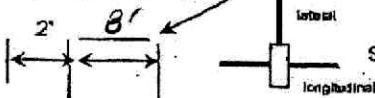

Show locations of Longitudinal and Lateral Systems
 (use dark lines to show these locations)

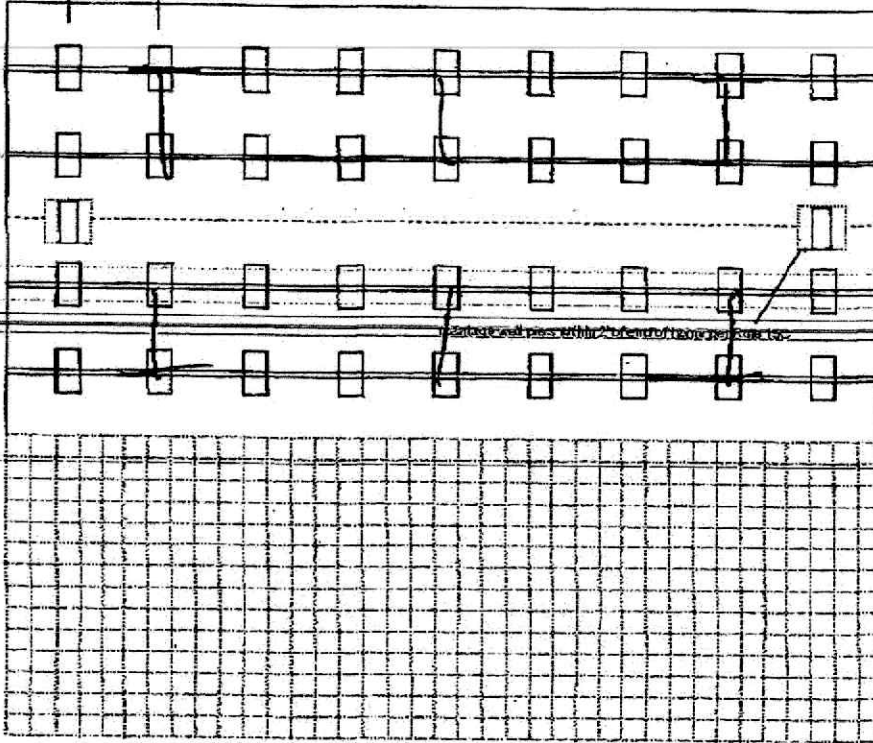

Application Number: _____ Date: _____

New Home ☒ Used Home ☐
 Home installed to the Manufacturer's Installation Manual
 Home is installed in accordance with Rule 15-C ☒
 Single wide ☐ Wind Zone II ☐ Wind Zone III ☐
 Double wide ☒ Installation Decal # 108456
 Triple/Quad ☐ Serial # 000000

PIER SPACING TABLE FOR USED HOMES

Load bearing capacity	Footer size (sq in)	16" x 16" (256)	18 1/2" x 18 1/2" (342)	20" x 20" (400)	22" x 22" (484)	24" x 24" (576)	26" x 26" (676)
1000 psf	3'	4'	5'	6'	7'	8'	8'
1500 psf	4' 6"	6'	7'	8'	9'	10'	10'
2000 psf	6'	8'	9'	10'	11'	12'	12'
2500 psf	7' 6"	9'	10'	11'	12'	13'	13'
3000 psf	8'	10'	11'	12'	13'	14'	14'
3500 psf	8'	10'	11'	12'	13'	14'	14'

* Interpolated from Rule 15C-1 pier spacing table.

PIER PAD SIZES

I-beam pier pad size: 12x12x5
 Perimeter pier pad size: 12x12
 Other pier pad sizes (required by the mfg.): 12x12

Draw the approximate locations of marriage wall openings 4 foot or greater. Use this symbol to show the piers.

List all marriage wall openings greater than 4 foot and their pier pad sizes below.

Opening: 10' Pier pad size: 24x24

TIEDOWN COMPONENTS

Longitudinal Stabilizing Device (LSD)
 Manufacturer: _____
 Longitudinal Stabilizing Device w/ Lateral Arms
 Manufacturer: Ofur Tech

POPULAR PAD SIZES

Pad Size	Sq In
16 x 16	256
16 x 18	288
18.5 x 18.5	342
16 x 22.5	360
17 x 22	374
13 1/4 x 26 1/4	348
20 x 20	400
17 3/16 x 25 3/16	441
17 1/2 x 25 1/2	446
24 x 24	576
26 x 26	676

ANCHORS

4 ft ☒ 5 ft ☒

FRAME TIES

within 2' of end of home
 spaced at 5' 4" oc ☒

OTHER TIES

Number: _____
 Sidewall: 28
 Longitudinal: 0
 Marriage wall: 2
 Shearwall: 2

Mobile Home Permit Worksheet

Application Number: _____ Date: _____

POCKET PENETROMETER TEST

The pocket penetrometer tests are rounded down to 1,000 psf or check here to declare 1000 lb. soil without testing.

X 1 X X

POCKET PENETROMETER TESTING METHOD

1. Test the perimeter of the home at 6 locations.
2. Take the reading at the depth of the footer.
3. Using 500 lb. increments, take the lowest reading and round down to that increment.

X X X

TORQUE PROBE TEST

The results of the torque probe test is 1100 inch pounds or check here if you are declaring 5' anchors without testing. A test showing 275 inch pounds or less will require 5 foot anchors.

Note: A state approved lateral arm system is being used and 4 ft. anchors are allowed at the sidewall locations. I understand 5 ft. anchors are required at all centerline tie points where the torque test reading is 275 or less and where the mobile home manufacturer may require anchors with 4000 lb. holding capacity.

Installer's initials: ML

ALL TESTS MUST BE PERFORMED BY A LICENSED INSTALLER

Installer Name Jim Dyer to Kneale

Date Tested 1-19-24

Electrical

Connect electrical conductors between multi-wide units, but not to the main power source. This includes the bonding wire between multi-wide units. Pg. 1501

Plumbing

Connect all sewer drains to an existing sewer tap or septic tank. Pg. 1521

Connect all potable water supply piping to an existing water meter, water tap, or other independent water supply systems. Pg. 1501

Site Preparation

Debris and organic material removed ☒ Pad ☒ Other _____
Water drainage: Natural _____ Swale _____

Fastening multi wide units

Floor: Type Fastener: lugs Length: 6" Spacing: 20"
Walls: Type Fastener: lugs Length: 9" Spacing: 24"
Roof: Type Fastener: lugs Length: 1 1/2" Spacing: 48"
For used homes a min. 30 gauge, 8" wide, galvanized metal strip will be centered over the peak of the roof and fastened with galv. roofing nails at 2' on center on both sides of the centerline.

Gasket (weatherproofing requirement)

I understand a properly installed gasket is a requirement of all new and used homes and that condensation, mold, mildew and buckled marriage walls are a result of a poorly installed or no gasket being installed. I understand a strip of tape will not serve as a gasket.

Installer's initials JDK

Type gasket lugs Installed:
Pg. 1501 Between Floors Yes ☒
Between Walls Yes ☒
Bottom of ridgebeam Yes ☒

Weatherproofing


The bottomboard will be repaired and/or taped. Yes ☒ Pg. 1521
Siding on units is installed to manufacturer's specifications. Yes ☒
Fireplace chimney installed so as not to allow intrusion of rain water. Yes ☒

Miscellaneous

Skirting to be installed. Yes ☒ No ☒
Dryer vent installed outside of skirting. Yes ☒ N/A ☒
Range downflow vent installed outside of skirting. Yes ☒ N/A ☒
Drain lines supported at 4 foot intervals. Yes ☒
Electrical crossovers protected. Yes ☒
Other: _____

Installer verifies all information given with this permit worksheet is accurate and true based on the manufacturer's installation instructions and or Rule 15C-1 & 2

Installer Signature [Signature] Date 1-19-24

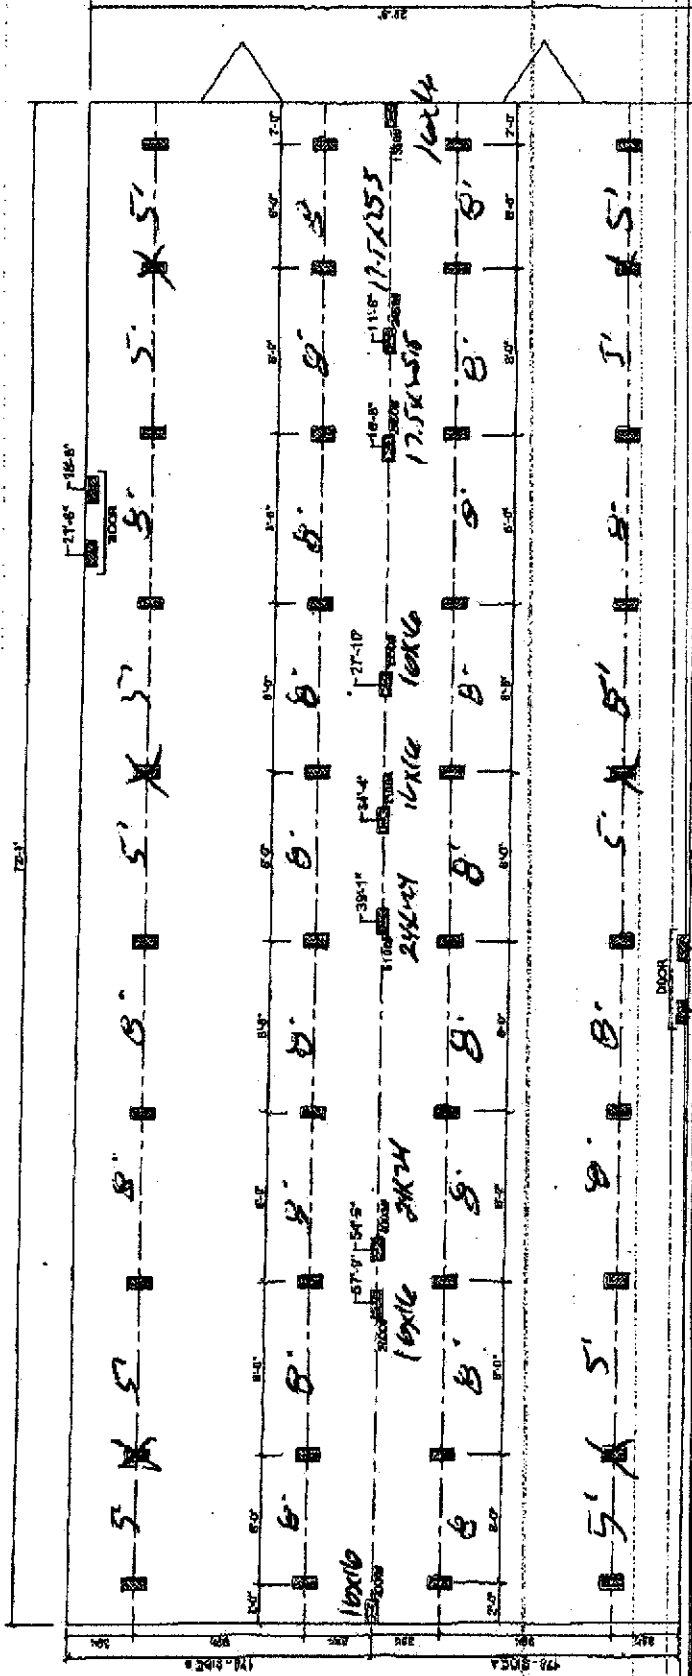

150 MARRIAGE LINE OPENING SUPPORT POINT
200 SUPPORT POINT
FOUNDER NOTES

- THIS DRAWING IS DESIGNED FOR THE STANDARD WIND ZONE AND IS TO BE USED IN CONJUNCTION WITH THE INSTALLATION MANUAL AND ITS SUPPLEMENTS.
- DIMENSIONS ARE SHOWN FOR EXAMPLE ONLY. QUANTITIES AND SPACING MAY VARY BASED ON PART TYPE, SOIL CONDITIONS, ETC.
- FOUNDINGS ARE REQUIRED AT SUPPORT POINTS. SEE INSTALLATION MANUAL FOR REQUIREMENTS.

Live Oak Homes
MODEL: V-3725B-ELITE - 32 X 72 (BOX)
S-BEDROOM / 3-BATH

(99-1/2" I-BEAM SPACING)
V-3725B-ELITE

License Number: IH / 1038219 / 1 Name: RUSTYL KNOWLES		
Order #: 6147	Label #: 108456	Manufacturer:
Homeowner:	Year Model:	(Check Size of Home) Single _____ Double _____ Triple _____
Address:	Length & Width:	HUD Label #:
City/State/Zip:	Type Longitudinal System:	Soil Bearing / PSF:
Phone #:	Type Lateral Arm System:	Torque Probe / in-lbs:
Date Installed:	New Home _____ Used Home: _____	Permit #:
Installed Wind Zone:	Data Plate Wind Zone:	
Note:		

STATE OF FLORIDA
INSTALLATION CERTIFICATION LABEL

108456	
LABEL #	DATE OF INSTALLATION
RUSTYL KNOWLES	
NAME	
IH / 1038219 / 1	6147
LICENSE #	ORDER #
CERTIFIES THAT THE INSTALLATION OF THIS MOBILE HOME IS IN ACCORDANCE WITH FLORIDA STATUTES 320.8249, 320.8325 AND RULES OF THE HIGHWAY SAFETY AND MOTOR VEHICLES.	

INSTRUCTIONS

PLEASE WRITE DATE OF
INSTALLATION AND AFFIX
LABEL NEXT TO HUD LABEL.
USE PERMANENT INK PEN
OR MARKER ONLY.
COMPLETE INFORMATION
ABOVE AND KEEP ON FILE
FOR A MINIMUM OF 2 YEARS.
YOU ARE REQUIRED TO
PROVIDE COPIES WHEN
REQUESTED.