

CK# 4218

PERMIT APPLICATION / MANUFACTURED HOME INSTALLATION APPLICATION

For Office Use Only (Revised 10-22-07) Zoning Official OK 12/4/07 Building Official OK 12/4/07

AP# 0712-01 Date Received 12-3-07 By G Permit # 26576

Flood Zone X Development Permit — Zoning A-3 Land Use Plan Map Category A-3

Comments Pre-Inspection approved per GP, MH will be fixed before power

FEMA Map# _____ Elevation _____ Finished Floor _____ River _____ In Floodway _____

☒ Site Plan with Setbacks Shown ☒ EH Signed Site Plan ☐ EH Release ☐ Well letter ☒ Existing well shared

☒ Copy of Recorded Deed or Affidavit from land owner ☐ Letter of Authorization from installer

☐ State Road Access ☐ Parent Parcel # _____ ☐ STUP-MH _____

☐ Unincorporated area ☐ Incorporated area ☐ Town of Fort White ☐ Town of Fort White Compliance letter

Lot 60, Unit 18
Three Rivers Est.

Property ID # 00-00-00-0072-000 Subdivision Three Rivers Est.

▪ New Mobile Home _____ Used Mobile Home ☒ Year 1989

▪ Applicant Robert Sheppard Phone # _____

▪ Address 6355 SE CR 245, Lake City FL 32055

▪ Name of Property Owner Oralee Skinner / Donnie Skinner Phone # _____

▪ 911 Address 435 SW Boston Terr, Ft. White, FL 32038

▪ Circle the correct power company - FL Power & Light - Clay Electric
(Circle One) - Suwannee Valley Electric - Progress Energy

▪ Name of Owner of Mobile Home Frank Roberts III Phone # 344-9940
Address 1466 SE Putnam St. Lake City, FL 32025

▪ Relationship to Property Owner friend

▪ Current Number of Dwellings on Property 0

▪ Lot Size _____ Total Acreage .918

▪ Do you : Have Existing Drive or Private Drive or need Culvert Permit or Culvert Waiver (Circle one)
(Currently using) (Blue Road Sign) (Putting in a Culvert) (ad a Culvert)

▪ Is this Mobile Home Replacing an Existing Mobile Home No (lowes)

▪ Driving Directions to the Property 475 TR on 27 TL Riverside Ave,
TL Utah TR Washington, TL Boston Terr.
11th on left

▪ Name of Licensed Dealer/Installer Robert Sheppard Phone # 386-623-2203

▪ Installers Address 6355 SE CR 245 Lake City FL 32055

▪ License Number TH0000833 Installation Decal # 278547

Spoke to Robert 12/4/07 G

PERMIT WORKSHEET

PERMIT NUMBER

Installer Robert Sheppard License # IA0000835



Address of home being installed _____

Manufacturer Flectwood Length x width 14x70

NOTE: if home is a single wide fill out one half of the blocking plan
if home is a triple or quad wide sketch in remainder of home

I understand Lateral Arm Systems cannot be used on any home (new or used) where the sidewall ties exceed 5 ft 4 in.

Installer's initials YLB

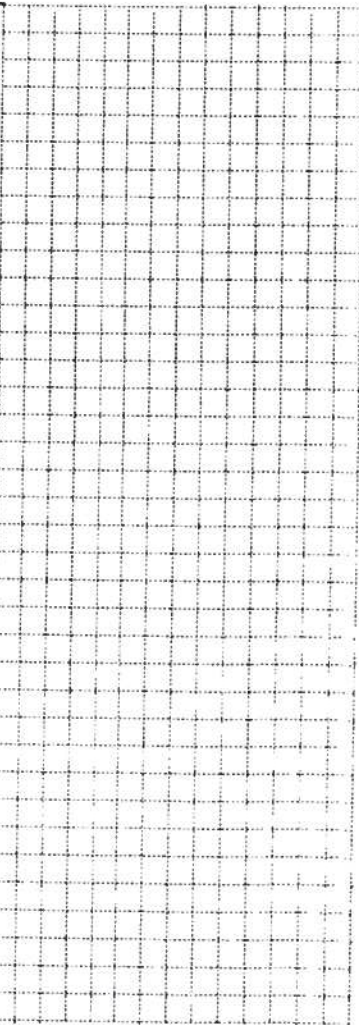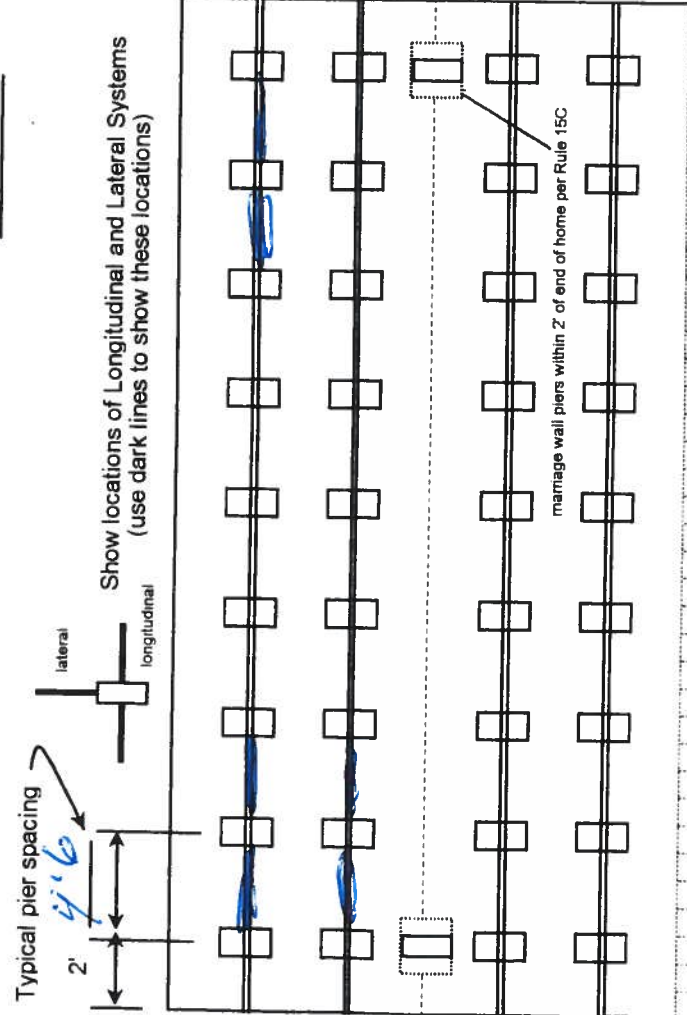

New Home ☐ Used Home ☒

Home installed to the Manufacturer's Installation Manual ☒

Home is installed in accordance with Rule 15-C ☐

Single wide ☒ Wind Zone II ☒ Wind Zone III ☐

Double wide ☐ Installation Decal # 278457

Triple/Quad ☐ Serial # _____

PIER SPACING TABLE FOR USED HOMES

Load bearing capacity	Footer size (sq in)	16" x 16" (256)	18 1/2" x 18 1/2" (342)	20" x 20" (400)	22" x 22" (484)*	24" x 24" (576)*	26" x 26" (676)
1000 psf	3'	4'	4'	5'	6'	7'	8'
1500 psf	4' 6"	6'	6'	7'	8'	8'	8'
2000 psf	6'	8'	8'	8'	8'	8'	8'
2500 psf	7' 6"	8'	8'	8'	8'	8'	8'
3000 psf	8'	8'	8'	8'	8'	8'	8'
3500 psf	8'	8'	8'	8'	8'	8'	8'

* interpolated from Rule 15C-1 pier spacing table.

PIER PAD SIZES

I-beam pier pad size 17x22
Perimeter pier pad size 17x22
Other pier pad sizes (required by the mfg.) 17x22

Draw the approximate locations of marriage wall openings 4 foot or greater. Use this symbol to show the piers.



List all marriage wall openings greater than 4 foot and their pier pad sizes below.

Opening _____ Pier pad size _____

ANCHORS

4 ft ☒ 5 ft ☒

FRAME TIES

within 2' of end of home spaced at 5' 4" oc ☒

TIEDOWN COMPONENTS

Longitudinal Stabilizing Device (LSD)

Manufacturer _____

Longitudinal Stabilizing Device w/ Lateral Arms

Manufacturer o liver

OTHER TIES

Sidewall _____

Longitudinal _____

Marriage wall _____

Shearwall _____

Number 22

3

4

POCKET PENETROMETER TEST

The pocket penetrometer tests are rounded down to 1500 psf or check here to declare 1000 lb. soil without testing.

X 1700 X 1700 X 1700

POCKET PENETROMETER TESTING METHOD

1. Test the perimeter of the home at 6 locations.
2. Take the reading at the depth of the footer.
3. Using 500 lb. increments, take the lowest reading and round down to that increment.

X 1700 X 1700 X 1700

TORQUE PROBE TEST

The results of the torque probe test is 295 inch pounds or check here if you are declaring 5' anchors without testing. A test showing 275 inch pounds or less will require 5 foot anchors.

Note: A state approved lateral arm system is being used and 4 ft. anchors are allowed at the sidewall locations. I understand 5 ft anchors are required at all centerline tie points where the torque test reading is 275 or less and where the mobile home manufacturer may requires anchors with 4000 lb holding capacity.

Installer's initials

ALL TESTS MUST BE PERFORMED BY A LICENSED INSTALLER

Installer Name

Date Tested

Electrical

Connect electrical conductors between multi-wide units, but not to the main power source. This includes the bonding wire between multi-wide units. Pg. 29

Plumbing

Connect all sewer drains to an existing sewer tap or septic tank. Pg. 29

Connect all potable water supply piping to an existing water meter, water tap, or other independent water supply systems. Pg. 28

Site Preparation

Debris and organic material removed ☒
Water drainage: Natural ☒ Swale ☐ Pad ☐ Other ☐

Fastening multi wide units

Floor: Type Fastener: Length: Spacing:
Walls: Type Fastener: Length: Spacing:
Roof: Type Fastener: Length: Spacing:
For used homes a min. 30 gauge, 8" wide, galvanized metal strip will be centered over the peak of the roof and fastened with galv. roofing nails at 2" on center on both sides of the centerline.

Gasket (weatherproofing requirement)

I understand a properly installed gasket is a requirement of all new and used homes and that condensation, mold, mildew and buckled marriage walls are a result of a poorly installed or no gasket being installed. I understand a strip of tape will not serve as a gasket.

Installer's initials

Type gasket Pg.

Installed:
Between Floors Yes
Between Walls Yes
Bottom of ridgebeam Yes

Weatherproofing

The bottomboard will be repaired and/or taped. Yes ☒ Pg.
Siding on units is installed to manufacturer's specifications. Yes ☒
Fireplace chimney installed so as not to allow intrusion of rain water. Yes ☒


Miscellaneous

Skirting to be installed. Yes ☒ No ☐
Dryer vent installed outside of skirting. Yes ☒ N/A ☐
Range downflow vent installed outside of skirting. Yes ☒
Drain lines supported at 4 foot intervals. Yes ☒ N/A ☐
Electrical crossovers protected. Yes ☒
Other :

Installer verifies all information given with this permit worksheet is accurate and true based on the manufacturer's installation instructions and or Rule 15C-1 & 2

Installer Signature

Date

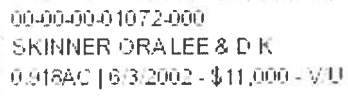

J. David Jones, CFA, Lake City, Florida 386-758-1082

A horizontal number line with tick marks at 0, 0.1, 0.2, and 0.3. The unit is miles (mi).

LandVal	\$18,750.00
---------	-------------

BldgVal	\$0.00
---------	--------

ApprVal	\$18,750.00
---------	-------------

Assd	\$18,750.00
------	-------------

Exmpt	\$0.00
-------	--------

Taxable	\$18,750.00
---------	-------------



http://columbia.floridapa.com/GIS/Print_Map.asp?pjboiibchhjbnligafceelbjemnolkjmg... 11/30/2007

AFFIDAVIT

**STATE OF FLORIDA
COUNTY OF COLUMBIA**

This is to certify that I, (We), (D.K.) DONNIE K. SKINNER -
owner of the below described property: ORA LEE SKINNER
Donnie K. Skinner

Tax Parcel No. 01022-000

Subdivision (name, lot, block, phase) _____


Give my permission to FRANK ROBERTS, III to place a
mobile home/travel trailer/single family home (circle one) on the above mentioned
property.

I (We) understand that this could result in an assessment for solid waste and fire
protection services levied on this property.


(D.K.) Donnie K. Skinner Oral Lee Skinner
Owner Owner

SWORN AND SUBSCRIBED before me this 30th day of November,
2007. This (these) person(s) are personally known to me or produced
ID _____


Wanda C. Greene
Notary Signature

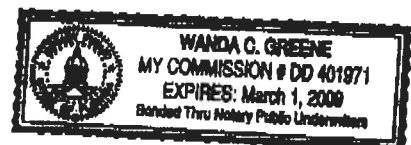

SITE PLAN EXAMPLE / WORKSHEET I

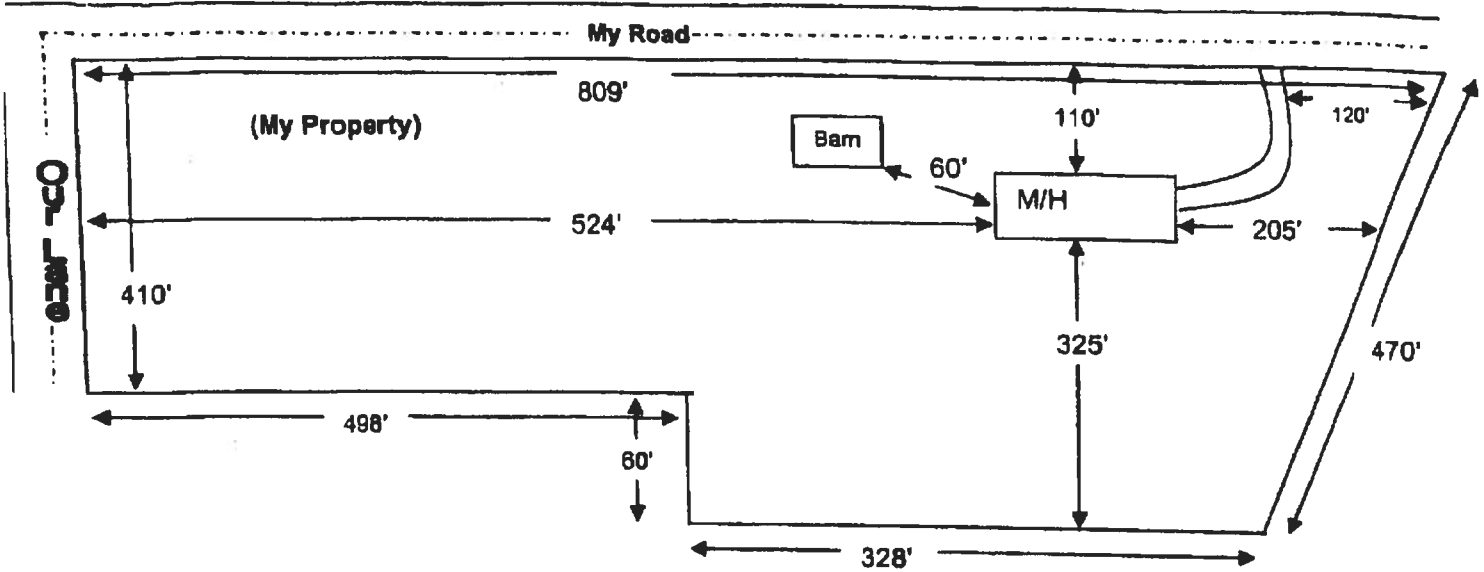

Use this example to draw your own site plan. Show all existing buildings and any other homes on this property and show the distances between them. Also show where the roads or roads are around the property. This site plan can also be used for the 911 Addressing department if you include the distance from the driveway to the nearest property line.

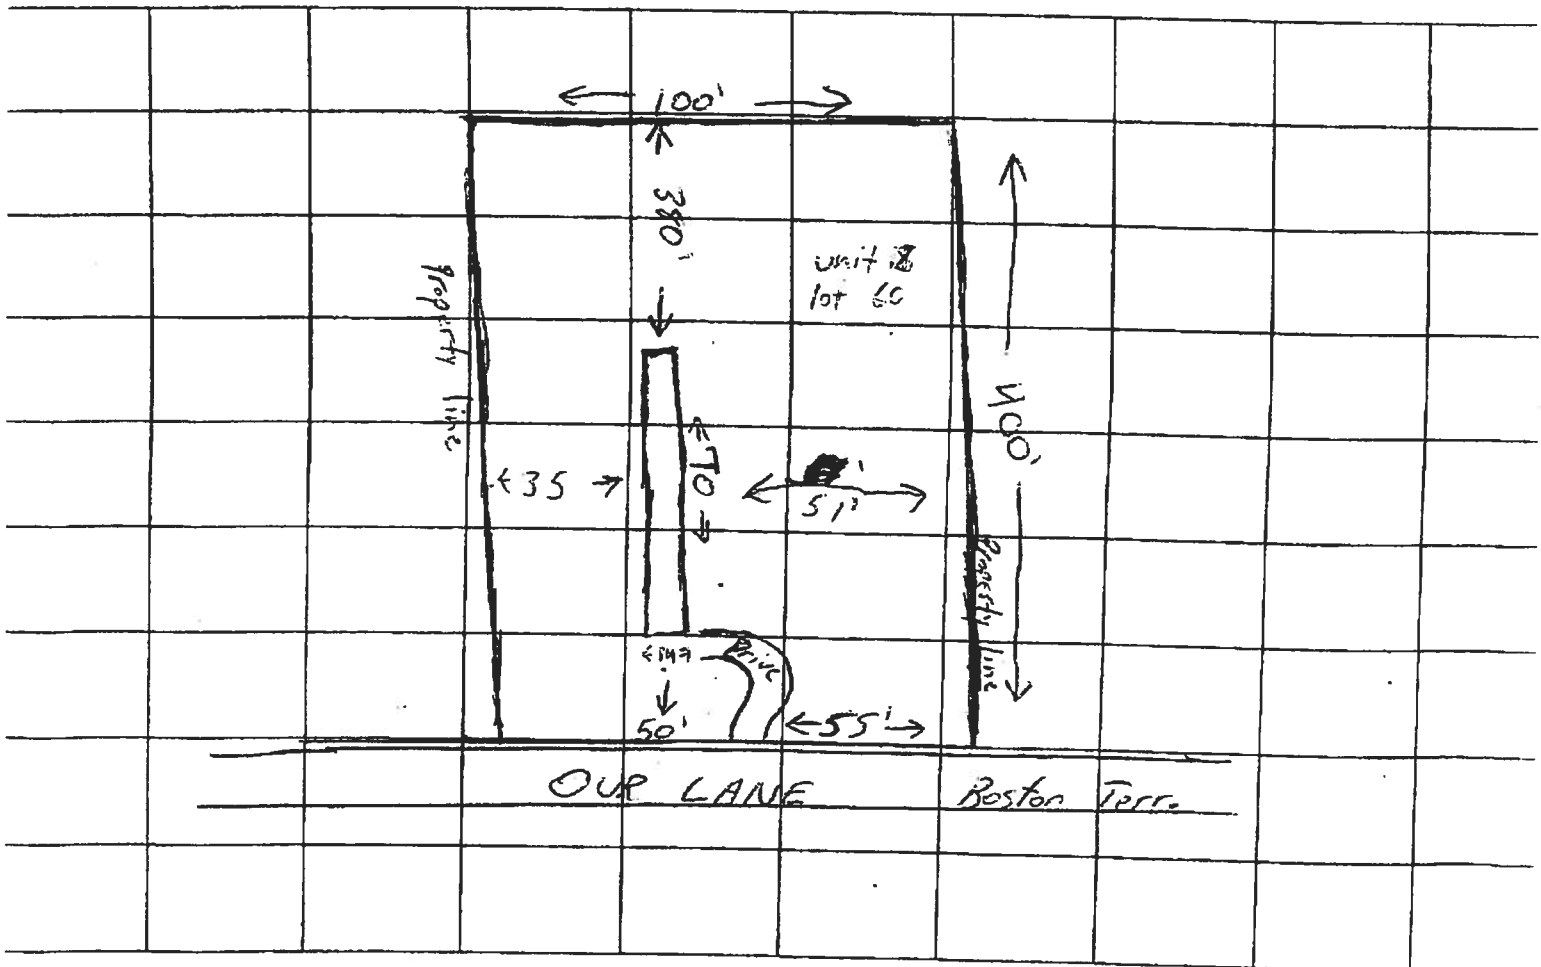




STATE OF FLORIDA
DEPARTMENT OF HEALTH

APPLICATION FOR ONSITE SEWAGE DISPOSAL SYSTEM CONSTRUCTION PERMIT

Permit Application Number 07-0951E

PART II - SITE PLAN

Scale: Each block represents 5 feet and 1 inch = 50 feet.

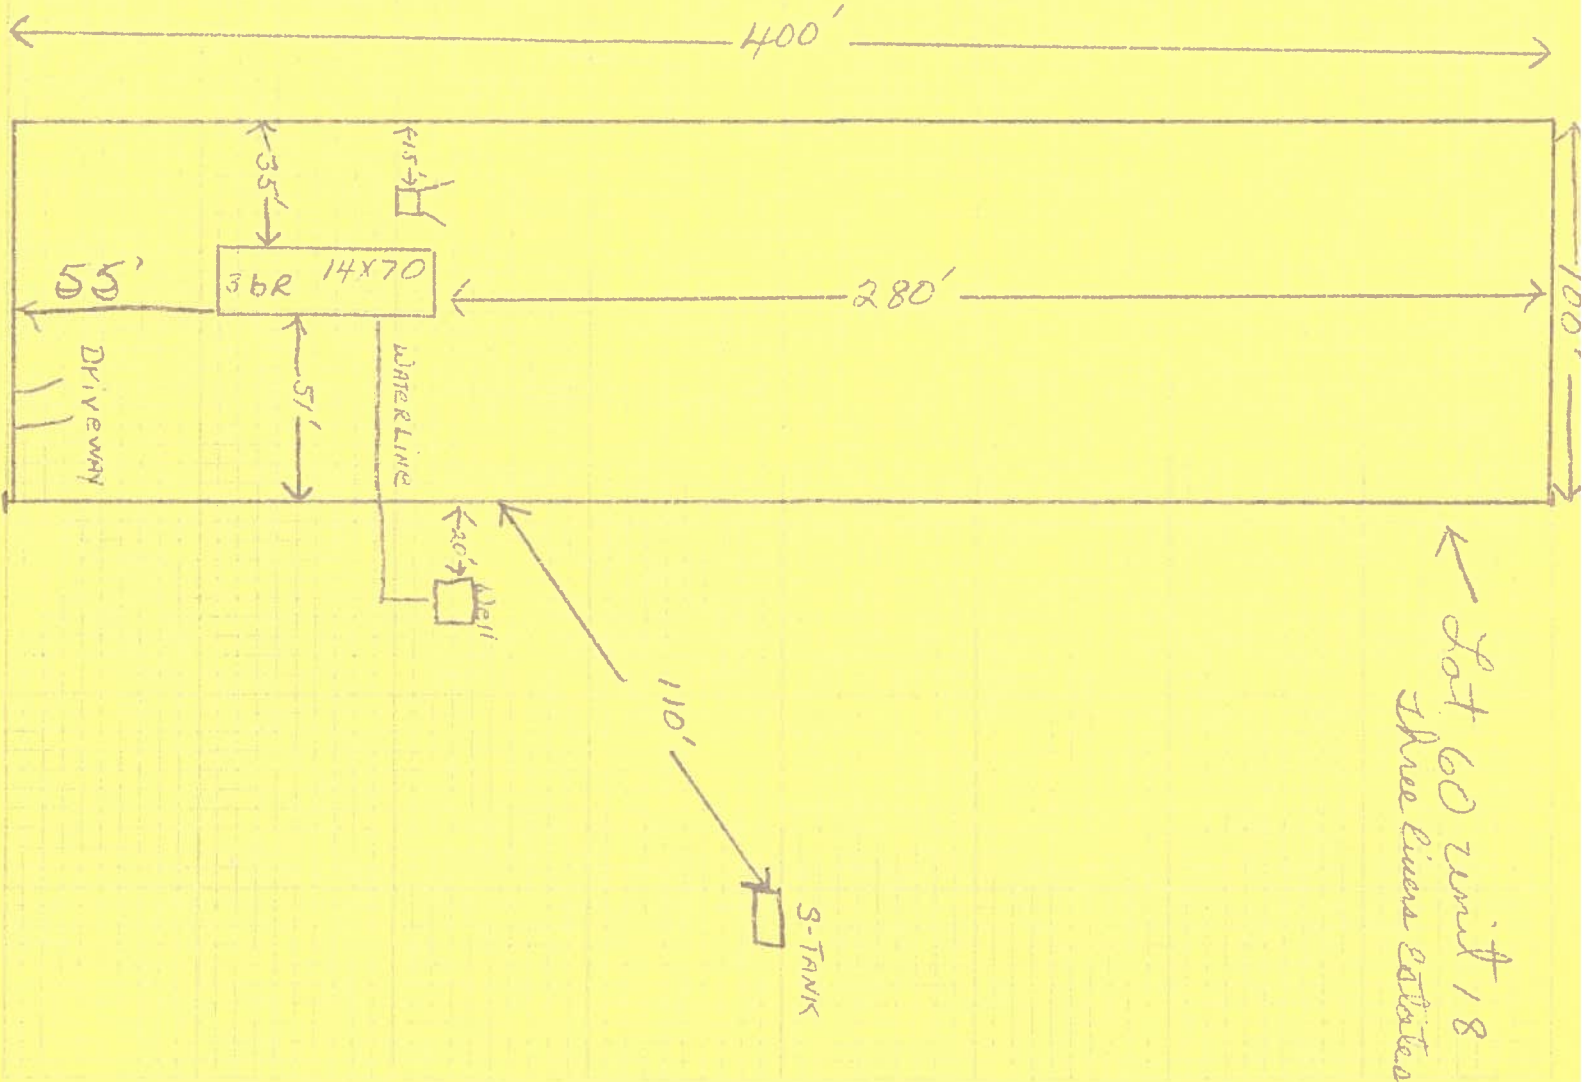

Notes: _____

Site Plan submitted by: Frank R. [Signature] _____ Title _____

Plan Approved _____ Not Approved _____ Date 12-7-07

By _____ County Health Department

ALL CHANGES MUST BE APPROVED BY THE COUNTY HEALTH DEPARTMENT




STATE OF FLORIDA
DEPARTMENT OF HEALTH

APPLICATION FOR ONSITE SEWAGE DISPOSAL SYSTEM CONSTRUCTION PERMIT

Permit Application Number 07-0951E

PART II - SITE PLAN

Scale: Each block represents 5 feet and 1 inch = 50 feet.

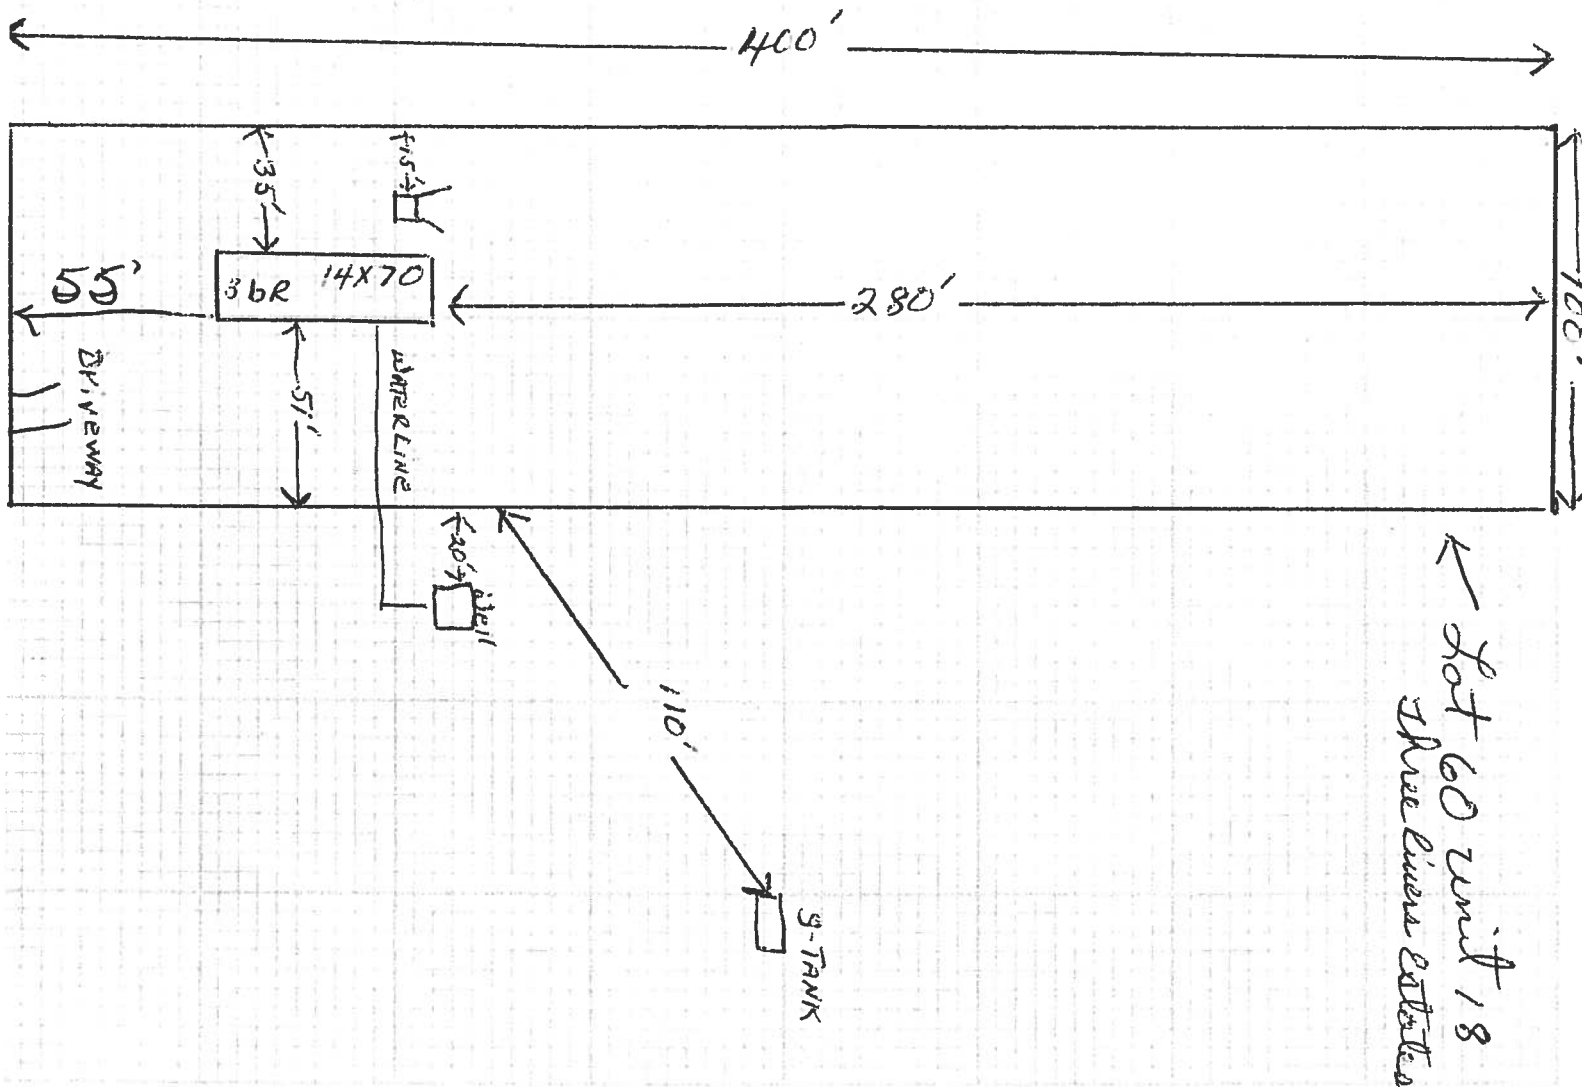

Notes:

12/10 - 930 - CALLED MR. ROBERTS (AGENT, FUTURE OWNER) : SAID TANK IS REPRESENTATIVE OF ACTUAL LOCATION BUT DID NOT USE TAPE MEASURE. CCHD RECORDS INDICATE 40' FROM P/L WITH TANK.

Site Plan submitted by: Frank Roberts III

Signature

Agent

Title

Plan Approved X

APPROVED

Not Approved

Date 12-7-07

By [Signature]

Columbia CHD

County Health Department

ALL CHANGES MUST BE APPROVED BY THE COUNTY HEALTH DEPARTMENT

**CODE ENFORCEMENT
PRELIMINARY MOBILE HOME INSPECTION REPORT**

DATE RECEIVED 12/18/07 BY 6 IS THE M/H ON THE PROPERTY WHERE THE PERMIT WILL BE ISSUED? Yes

OWNER'S NAME Frank Roberts PHONE _____ CELL _____

ADDRESS 435 S.W. Boston Terr. Ft. White FL

MOBILE HOME PARK SUBDIVISION

DRIVING DIRECTIONS TO MOBILE HOME. 475, TR on 27, TL Riverdale Ave,
TL 11th, TR Washington, TL Boston 144, 11th on 144

MOBILE HOME INSTALLER Robert Sheppard PHONE 1023-2203 TEL. 1023-2203

MCCL E HOME INFORMATION

MAKE LEE WOODY YEAR 1997 SIZE 14 x 70 COLOR BEAC & Bin Trim

REF ID: A67012

WIND ZONE II Must be wind zone II or higher NO WIND ZONE ALLOWED

INSPECTION STANDARDS

NOTICE

PASS PASS

SMOKE DETECTOR () OPERATIONAL () MISSING

FLOORS	()	SCLD	()	WEAK	()	HOLES	DAMAGED	LOCATION
1								
2								
COOKS 1, CFERABLE ~~4~~ DAMAGED

WALLS (1 SOLID ~~X~~ STRUCTURALLY UNSOUND Living Room wall under window rotten.

WINDOWS (; OPERABLE ;) INOPERABLE

PLUMBING FIXTURES () OPERABLE () INOPERABLE () MISSING

CEILING () SOLID () HOLES () LEAKS APPARENT

ELECTRICAL (FIXTURES/OUTLETS): () OPERABLE ☒ EXPOSED WIRING () OUTLET COVER MISSING () LIGHT
FIXTURES MISSING

247 ERON.

WALLS / SIDING () LOOSE SIDING (X) STRUCTURALLY UNSOUND () NOT WEATHERTIGHT () NEEDS CLEANING

WINDOWS () CRACKED, BROKEN GLASS () SCREENS MISSING () WEATHER TIGHT

ROOF :) APPEARS SOLID () DAMAGED

STAFF:

APPROVED _____ WITH CONDITIONS

NOT APPROVED ☒ NEED RE-INSPECTION FOR FOLLOWING CONDITIONS Doors will not close.

Siding damaged beside front door. Interior wall rotten in living room.

SIGNATURE At S. Ford ID NUMBER 403 DATE 12-19-07