

Peterson In Lane. Lake City, Florida 32055


© WM DESIGN &
ASSOCIATES, INC.
426 SW COMMERCE DR., STE 130
LAKE CITY, FL 32025



JOB NUMBER
20230327
DATE:
March 28, 2023

SHEET NUMBER

A.1

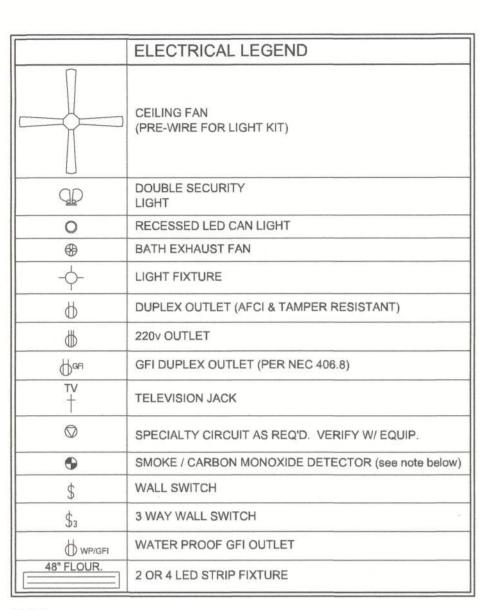

ALL INTERIOR RECEPTACLES SHALL BE AFCI (ARC FAULT CIRCUIT INTERRUPT) PER NEC 210.12 & TAMPER RESISTANT PER

ALL INTERIOR & EXTERIOR LIGHTING SHALL MEET OR EXCEED THE MIN. 75% HIGH-EFFICIENCY LIGHTING PER FBC-ENERGY CONSERVATION R404.

ALL SMOKE DETECTORS BE A COMBO SMOKE & CARBON MONOXIDE DETECTOR AND SHALL HAVE BATTERY BACKUP POWER AND ALL WIRED TOGETHER SO IF ANY ONE UNIT IS ACTUATED THEY

THE ELECTRICAL SERVICE OVERCURRENT PROTECTION DEVICE SHALL BE INSTALLED ON THE EXTERIOR OF STRUCTURES TO SERVE AS A DISCONNECT MEANS. CONDUCTORS USED FROM THE EXTERIOR DISCONNECTING MEANS TO A PANEL OR SUB PANEL SHALL HAVE FOUR-WIRE CONDUCTORS, OF WHICH ONE CONDUCTOR SHALL BE USED AS AN EQUIPMENT GROUND.


IT IS THE LICENSED ELECTRICAL CONTRACTORS RESPONSIBILITY TO INSURE THAT ALL WORK PERFORMED AND EQUIPMENT INSTALLED MEETS OR EXCEEDS THE 2017 (NFPA-70) NATIONAL ELECTRIC CODE AND ALL OTHER LOCAL CODES AND ORDINANCES.

NOTE: A FLORIDA LICENSED ELECTRICAL CONTRACTOR SHALL DETERMINE IF THE EXISTING ELECTRICAL PANEL HAS THE CAPACITY FOR THE ADDITION'S ADDED CIRCUITS OR IF A ELECTRICAL SUB PANEL SHALL BE INSTALLED.


WOOD STRUCTURAL NOTES

TEMPORARY BRACING OF THE STRUCTURE DURING ERECTION, REQUIRED FOR SAFE AND STABLE CONSTRUCTION, SHALL BE THE SOLE RESPON-SIBILITY OF THE CONTRACTOR SO ENGAGED. TEMPORARY & PERMANENT BRACING OF ROOF TRUSSES SHALL BE AS PER THE STANDARD GUIDE-LINES OF THE "TRUSS PLATE INSTITUTE".

- ALL TRUSSES SHALL BE DESIGNED BY A LICENSED PROFESSIONAL ENGINEER & SHALL BE SIGNED AND SEALED BY SAME, TRUSS DESIGN SHALL INCLUDE PLACEMENT PLANS, TRUSS DETAILS, TRUSS TO TRUSS CONNECTIONS & THE STANDARD SPECIFICATIONS & RECOMMENDATIONS OF INSTALLATION OF THE "TRUSS PLATE INSTITUTE".
- 3. WOOD STUDS IN EXTERIOR WALLS & INTERIOR BEARING WALLS SHALL BE NOT LESS THAN Nr.2 HEM-FIR OR BETTER.
- 4. CONNECTORS FOR WOOD FRAMING SHALL BE GALYANIZED METAL OR BLACK METAL AS MANUFACTURED OR AS CALLED FOR IN THE PLANS AND BE OF A DESIGN SUITABLE FOR THE LOADS AND USE INTENDED. REFER TO THE JOINT REINFORCEMENT SCHEDULE FOR PRINCIPLE CON-

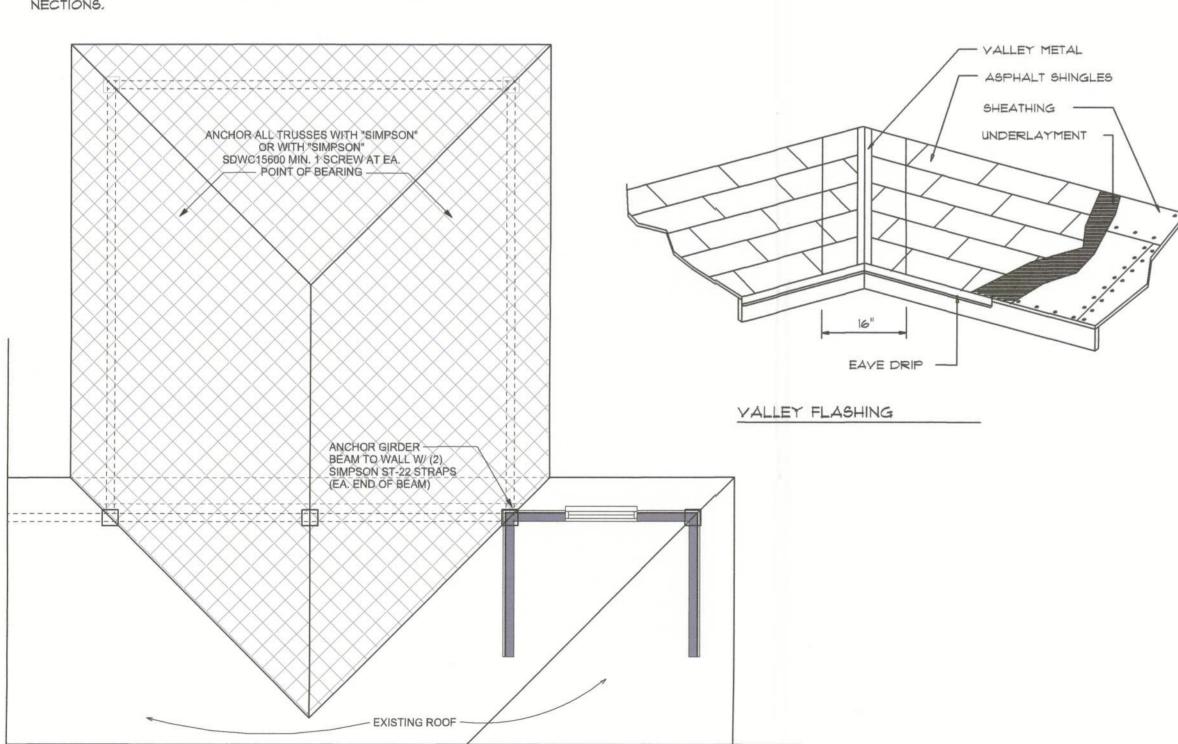


4" CONCRETE SLAB REINFORCED TO 3,000 PSI W/ 10/10 W.W.M. SLOPE PORCH SLAB TO DRAIN WITH 6" LAPS SEALED TERMITE TREATED (1) #5 CONTINUOUS

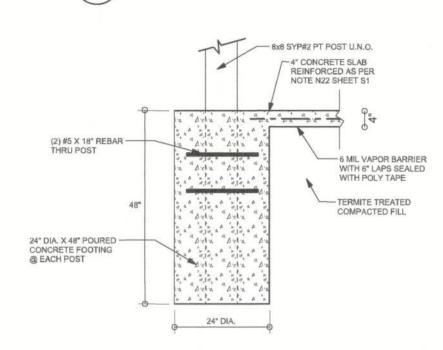


EMBEDDED POST DETAIL

AREA		VENT .	NET FREE AREA OF NTAKE	
1600	SF 20 L	F .	410 SQ.IN.	
1900	SF 24 L	F .	490 SQ.IN.	
2200	SF 28 L	.F F	STO SQ.IN.	
2500	SF 32 L	F (650 SQ.IN.	
2800	SF 36 L	F -	130 SQ.IN.	
3100	SF 40	LF 8	820 SQ.IN.	
3600	SF 44 L	F G	900 SQ.IN.	

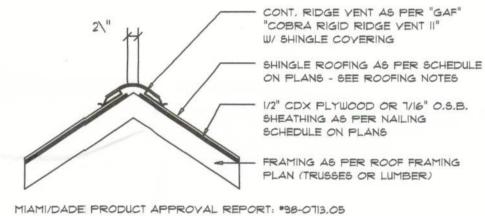



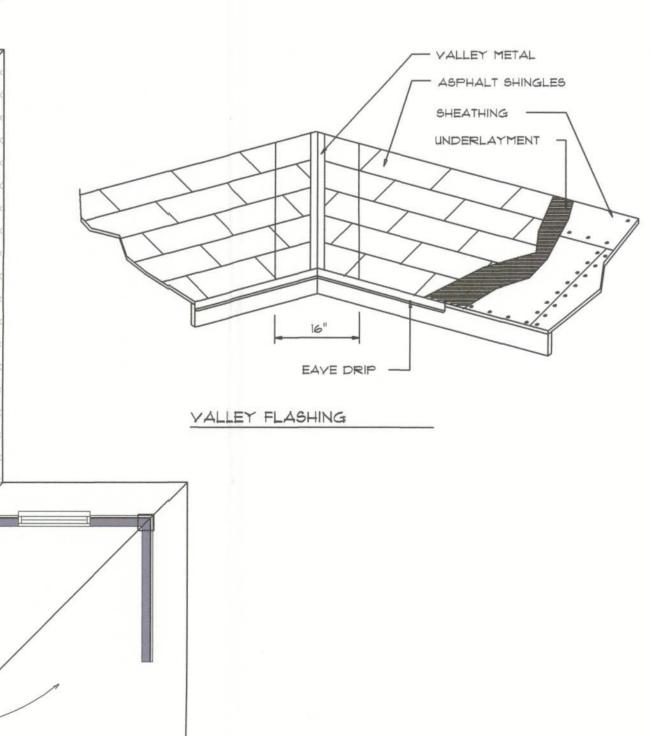


THE DESIGN WIND SPEED FOR THIS PROJECT IS 130 MPH PER 2020 FBC (7TH EDITION) AND LOCAL JURISDICTION REQUIREMENTS

ADDED FILL SHALL BE APPLIED IN 8" LIFTS -EA. LIFT SHALL BE CONPACTED TO 98% DRY COMPACTION PER THE "MODIFIED PROCTOR" METHOD.

PLUMBING CONTRACTOR SHALL PREPARE "AS-BUILT" SHOP DRAWINGS INDICATING ALL PLUMBING WORK, INCLUDING ALL PLUMBING LINE LOCATIONS AND RISER DIAGRAM - CONT'R SHALL PROVIDE 1 COPY OF AS-BUILT DWGS TO OWNER AND 1 COPY TO THE PERMIT ISSUING AUTHORITY.

H.V.A.C. CONTRACTOR SHALL PREPARE "AS-BUILT" SHOP DRAWINGS INDICATING ALL H.V.A.C. WORK, INCLUDING ALL DUCTWORK LOC., SIZES, LINES, EQUIPMENT SCH. & BALANCING REPORT - CONT'R SHALL PROVIDE 1 COPY OF AS-BUILT DWGS TO OWNER & 1 COPY TO THE PERMIT ISSUING AUTHORITY.

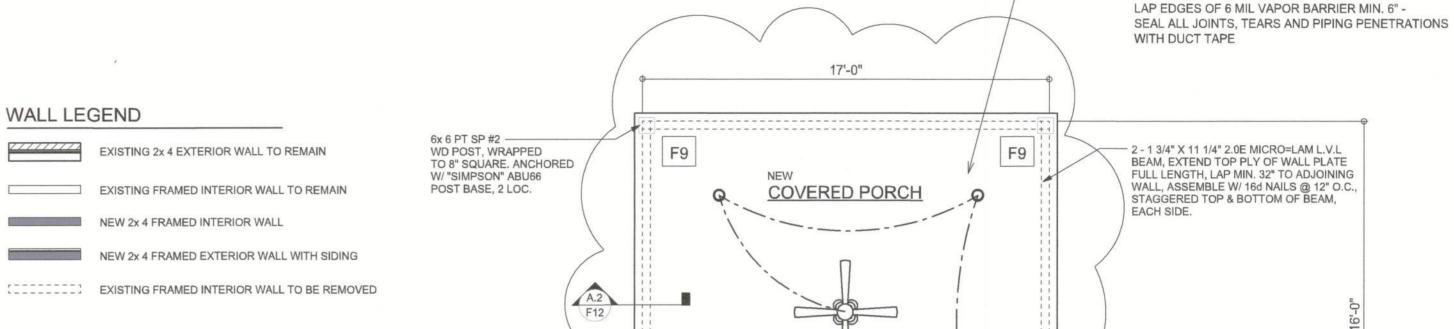

4" SMOOTH STEELED TROWLLED CONC. SLAB,

POLY VAPOR BARRIER

SAND FILL, TERMITE TREATED

W/ 6x6/10:10 WWM ON CHAIRS @ 36" O.C., OVER 6 MIL

eter

JOINT VENTURED WITH

3 NDICED MV/ ©

ASSOCIATES, INC.

126 SW COMMERCE DR., STE 13

LAKE CITY, FL 32025 (386) 758-8406 will@willmyers.net

JOB NUMBER


20230327

DATE:


SHEET NUMBER

March 28, 2023

PLASTIC SHEETING, ON CLEAN, WELL COMPACTED

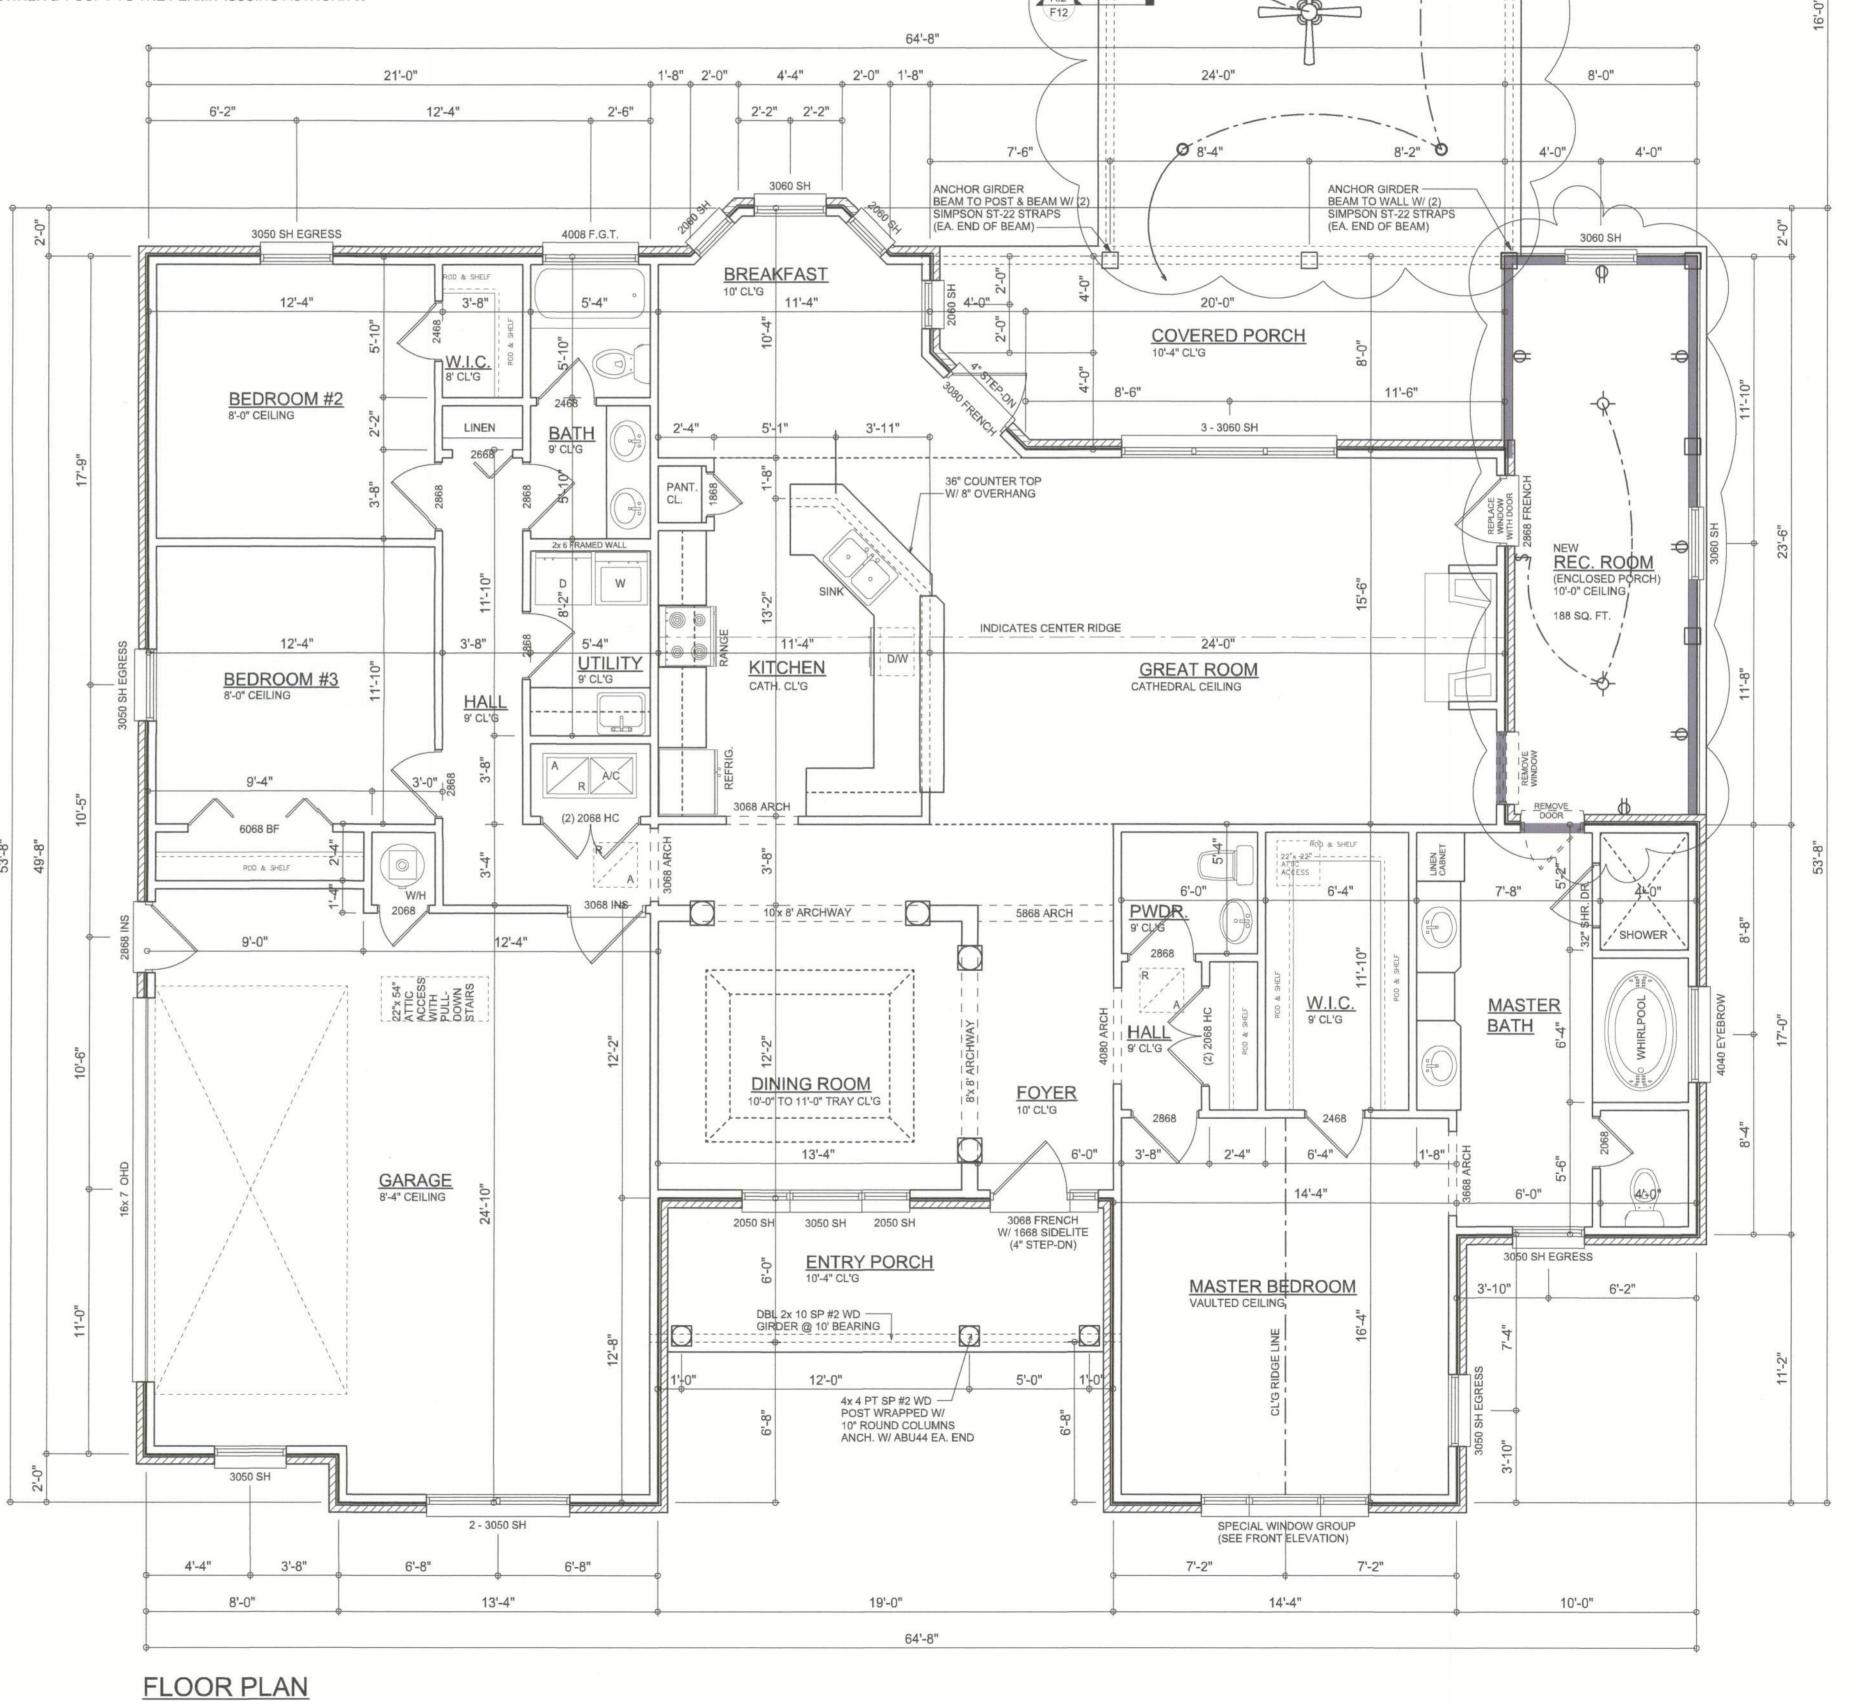

ROOF PLAN - PARTIAL

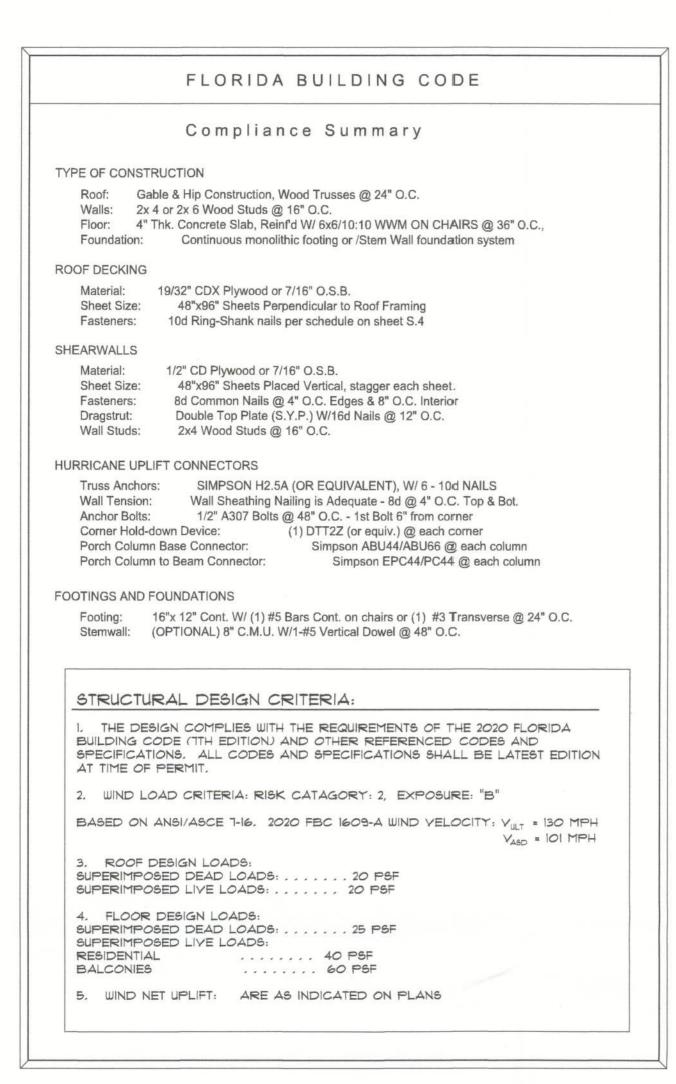

TERMITE PROTECTION NOTES:

SOIL CHEMICAL BARRIER METHOD:

1. A PERMANENT SIGN WHICH IDENTIFIES THE TERMITE TREATMENT PROVIDER AND NEED FOR REINSPECTION AND TREATMENT CONTRACT RENEWAL SHALL BE PROVIDED. THE SIGN SHALL BE POSTED NEAR THE WATER HEATER OR ELECTRIC PANEL. FBC 104.2.6 2. CONDENSATE AND ROOF DOWNSPOUTS SHALL DISCHARGE AT LEAST 1'-0"

AWAY FROM BUILDING SIDE WALLS. FBC 1503.4.4

3. IRRIGATION/SPRINKLER SYSTEMS INCLUDING ALL RISERS AND SPRAY HEADS SHALL NOT BE INSTALLED WITHIN 1'-0" FROM BUILDING SIDIE WALLS.

FBC 1503.4.4 4. TO PROVIDE FOR INSPECTION FOR TERMITE INFESTATION, BETWEEN WALL

COVERINGS AND FINAL EARTH GRADE SHALL NOT BE LESS THAN 6". EXCEPTION: PAINT AND DECORATIVE CEMENTIOUS FINISH LESS THAN 5/8"

THICK ADHERED DIRECTLY TO THE FOUNDATION WALL. FBC 1403.1.6 5. INITIAL TREATMENT SHALL BE DONE AFTER ALL EXCAVATION AND BACKFILL IS COMPLETE. FBC 1816.1.1

6. SOIL DISTURBED AFTER THE INITIAL TREATMENT SHALL BE RETREATED INCLUDING SPACES BOXED OR FORMED. FBC 1816.1.2

7. BOXED AREAS IN CONCRETE FLOOR FOR SUBSEQUENT INSTALLATION OF TRAPS, ETC., SHALL BE MADE WITH PERMANENT METAL OR PLASTIC FORMS. PERMANENT FORMS MUST BE OF A SIZE AND DEPTH THAT WILL ELIMINATE THE DISTURBANCE OF SOIL AFTER THE INITIAL TREATMENT. FBC 1816.1.3

8. MINIMUM 6 MIL VAPOR RETARDER MUST BE INSTALLED TO PROTECT AGAINST RAINFALL DILUTION. IF RAINFALL OCCURS BEFORE VAPOR RET-ARDER PLACEMENT, RETREATMENT IS REQUIRED. FBC 1816.1.4

9. CONCRETE OVERPOUR AND MORTAR ALONG THE FOUNDATION PERIMETER MUST BE REMOVED BEFORE EXTERIOR SOIL TREATMENT. FBC 1816.1.5 10. SOIL TREATMENT MUST BE APPLIED UNDER ALL EXTERIOR CONCRETE OR GRADE WITHIN 1'-0" OF THE STRUCTURE SIDEWALLS. FBC 1816.1.6

11. AN EXTERIOR VERTICAL CHEMICAL BARRIER MUST BE INSTALLED AFTER CONSTRUCTION IS COMPLETE INCLUDING LANDSCAPING AND IRRIGATION. ANY SOIL DISTURBED AFTER THE VERTICAL BARRIER IS APPLIED, SHALL BE RETREATED. FBC 1816.1.6

12. ALL BUILDINGS ARE REQUIRED TO HAVE PER-CONSTRUCTION TREATMENT.

13. A CERTIFICATE OF COMPLIANCE MUST BE ISSUED TO THE BUILDING DEPART-MENT BY # LICENSED PEST CONTROL COMPANY BEFORE A CERTIFICATE OF OCCUPANCY WILL BE ISSUED. THE CERTIFICATE OF COMPLIANCE SHALL STATE: "THE BUILDING HAS RECEIVED A COMPLETE TREATMENT FOR THE PREVENTION OF SUBTERRANEAN TERMITES. THE TREATMENT IS IN ACCORDANCE WITH THE RULES AND LAWS OF THE FLORIDA DEPARTMENT OF AGRICULTURE AND CONS-UMER SERVICES". FBC 1816.1.7

14. AFTER ALL WORK IS COMPLETED, LOOSE WOOD AND FILL MUST BE REMOVED FROM BELOW AND WITHIN 1'-0" OF THE BUILDING. THIS INCLUDES ALL GRADE STAKES, TUB TRAP BOXES, FORMS, SHORING OR OTHER CELLULOSE CONTAINING MATERIAL. FBC 2303.1.3

15. NO WOOD, VEGETATION, STUMPS, CARDBOARD, TRASH, ETC., SHALL BE BURIED WITHIN 15'-0" OF ANY BUILDING OR PROPOSED BUILDING. FBC 2303.1.4

FRAMING ANCHOR SCHEDULE

APPLICATION MANUF'R/MODEL TRUSS TO WALL: SIMPSON H2.5A (OR EQUIVALENT), W/ 6 - 10d NAILS 960# GIRDER TRUSS TO POST/HEADER: SIMPSON LGT, W/ 28 - 16d NAILS 1785# HEADER TO KING STUD(S): SIMPSON ST22 1370# PLATE TO STUD: SIMPSON SP2 1065# STUD TO SILL: SIMPSON SP1 585# PORCH BEAM TO POST: 1700# SIMPSON PC44/EPC44 PORCH POST TO FND .: 2200# SIMPSON ABU44 SIMPSON A34 MISC. JOINTS 315#/240#

ALL ANCHORS SHALL BE SECURED W/ NAILS AS PRESCRIBED BY THE MANUFACTURER FOR MAXIMUM JOINT STRENGTH, UNLESS NOTED OTHERWISE.


REFER TO THE INCLUDED STRUCTURAL DETAILS FOR ADDITIONAL ANCHORS/ JOINT REINFORCEMENT AND FASTENERS.

ALL UNLISTED JOINTS IN THE LOAD PATH SHALL BE REINFORCED WITH SIMPSON A34 FRAMING ANCHORS, TYPICAL T.O. NOTE:

"SEMCO" PRODUCT APPROVAL: MIAMI/DADE COUNTY REPORT #95-0818.15

"SIMPSON" PRODUCT APPROVALS:

MIAMI/DADE COUNTY REPORT #97-0107.05, #96-1126.11, #99-0623.04 SBCC1 NER-443, NER-393

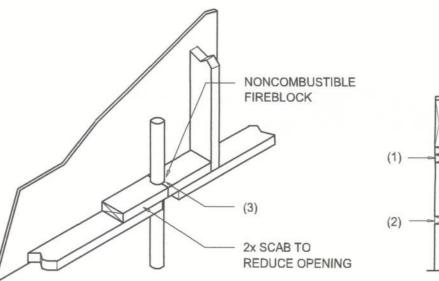

- ADD 2x FIREBLOCK **CUT BETWEEN STUDS**

PENETRATIONS

SOFFIT/DROPPED CLG.

FIREBLOCKING NOTES


FIREBLOCKING SHALL BE INSTALLED IN WOOD FRAME CONSTRUCTION IN THE FOLLOWING LOCATIONS:

- 1. IN CONCEALED SPACES OF STUD WALLS AND PARTITIONS INCLUDING FURRED SPACES AT CEILING AND FLOOR LEVELS.
- 2. AT ALL INTERCONNECTIONS BETWEEN CONCEALED VERTICAL AND HORIZONTAL SPACES SUCH AS OCCUR AT SOFFITS, DROP CEILINGS, COVE CEILINGS, ETC.
- 3. AT OPENINGS AROUND VENTS, PIPES, DUCTS, CHIMNEYS AND FIREPLACES AT CEILING AND FLOOR LEVELS WITH "PYROPANEL MULTIFLEX SEALANT"
- 4. AT ALL INTERCONNECTIONS BETWEEN CONCEALED VERTICAL STUD WALL OR PARTITION SPACES AND CONCEALED SPACES CREATED BY AN ASSEMBLY OF FLOOR JOISTS, FIREBLOCKING SHALL BE PROVIDED FOR THE FULL DEPTH OF THE JOISTS AT THE ENDS AND OVER THE SUPPORTS.


Fire Stopping DETAILS

SCALE: NONE



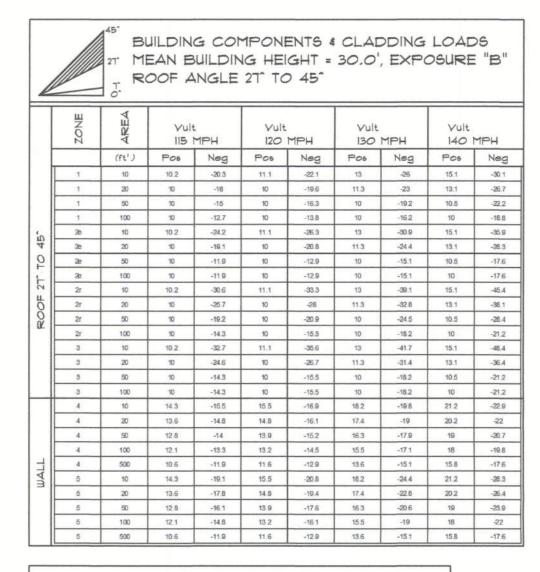

	21100 00111 01	NENTS & CLAD	DING
BLDG HEIGHT (ft)	EXPOSURE "B"	EXPOSURE "C"	EXPOSURE
15	.82	1,21	1.47
20	.89	1.29	1.55
25	.94	1.35	1.61
30	1.00	1.40	1.66

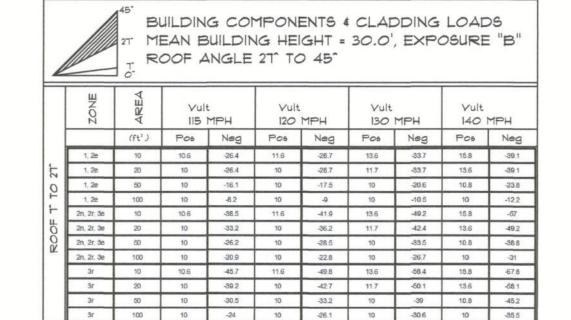

General Roofing NOTES:

DECK REQUIREMENTS:

ASPHALT SHINGLES SHALL BE FASTENED TO SOLIDLY SHEATHED DECKS.

ASPHALT SHINGLES SHALL BE USED ONLY ON ROOF SLOPES OF 2:12 OR GREATER. PER R905, DOUBLE UNDERLAYMENT IS REQUIRED ON ROOF

UNDERLAYMENT: UNLESS OTHERWISE NOTED, UNDERLAYMENT SHALL CONFORM W/ ASTM D 226,

SELF ADHERING POLYMER MODIFIED BITUMEN SHALL COMPLY W/ ASTM D 1970.

ASPHALT SHINGLES SHALL HAVE SELF SEAL STRIPS OR BE INTERLOCKING, AND COMPLY WITH ASTM D 225 OR ASTM D 3462.

FASTENERS:

FASTENERS FOR ASPHALT SHINGLES SHALL BE GALVANIZED, STAINLESS STEEL, ALUMINUM OR COPPER ROOFING NAILS, MINIMUM 12 GAUGE SHANK WITH A MINIMUM 3/8 INCH DIAMETER HEAD, OF A LENGTH TO PENETRATE THROUGH THE ROOFING MATERIAL AND A MINIMUM 3/4" INTO THE ROOF SHEATHING. WHERE THE SHEATHING IS LESS THAN 3/4" THICK, THE NAILS SHALL PENETRATE THROUGH THE SHEATHING.

ASPHALT SHINGLES SHALL BE SECURED TO THE ROOF WITH NOT LESS THAN FOUR FASTENERS PER STRIP SHINGLE OR TWO FASTENERS PER INDIVIDUAL OTHERWISE NOTED, ATTACHMENT OF ASPHALT SHINGLES SHALL CONFORM

FOR ROOF SLOPES FROM 2:12 TO 4:12 AND GREATER, UNDERLAYMENT SHALL BE A MINIMUM OF TWO LAYERS APPLIED AS FOLLOWS:

APPLIED PARALLEL WITH THE EAVE AND FASTENED SUFFICIENTLY TO STAY IN PLACE.

2. STARTING AT THE EAVE, 36 INCH WIDE STRIPS OF UNDERLAYMENT FELT SHALL BE APPLIED OVERLAPPING SUCCESSIVE SHEETS 19 INCHES AND FASTENED SUFFICIENTLY TO STAY IN PLACE.

BASE AND CAP FLASHINGS:

BASE AND CAP FLASHING SHALL BE INSTALLED IN ACCORDANCE W/ MFGR'S INSTALLATION INSTRUCTIONS. BASE FLASHING SHALL BE OF EITHER CORROSION RESISTANT METAL OF MINIMUM NOMINAL THICKNESS 0.019 INCH OR MINERAL SURFACE ROLL ROOFING WEIGHING A MINIMUM OF 77 LBS PER 100 SQUARE FEET. CAP FLASHING SHALL BE CORROSION RESISTANT METAL OF MINIMUM NOMINAL THICKNESS OF 0.019 INCH.

VALLEYS:

VALLEY LININGS SHALL BE INSTALLED IN ACCORDANCE W/ MANUFACTURER'S INSTALLATION INSTRUCTIONS BEFORE APPLYING ASPHALT SHINGLES. VALLEY LININGS OF THE FOLLOWING TYPES SHALL BE PERMITTED.

AT LEAST 16" WIDE AND OF ANY OF THE CORROSION RESISTANT METALS IN FBC TABLE 1507.3.9.2. 2. FOR OPEN VALLEYS, VALLEY LINING OF TWO PLIES OF MINERAL SURFACE ROLL ROOFING SHALL BE PERMITTED. THE BOTTOM LAYER SHALL BE 18

1. BOTH TYPES 1 AND 2 ABOVE, COMBINED. 2. ONE PLY OF SMOOTH ROLL ROOFING AT LEAST 36 INCHES WIDE AND COMPLYING WITH ASTM D 224.

3. SPECIALTY UNDERLAYMENT AT LEAST 36 INCHES WIDE AND COMPLYING WITH ASTM D 1970.

NOTE!!! ROOFSHINGLES SHALL BE AS MANUFACTURED BY "TAMKO ROOFING PRODUCTS" OF THE FOLLOWING MODELS:

> GLASS-SEAL AR ELITE GLASS-SEAL AR HERITAGE 30 AR HERITAGE 40 AR HERITAGE 50 AR

THESE SHINGLES MEET THE REQUIREMENTS OF ASTM D-3161 TYPE 1 MODIFIED TO 110 MPH WINDS & FBC TAS 100, USING 4 NAILS/SHINGLE

SOPES GREATER THAN 4/12.

TYPE 1, OR ASTM D 4869, TYPE 1.

SELF-ADHERING POLYMER MODIFIED BITUMEN SHEET:

ASPHALT SHINGLES:

SHINGLE. WHERE ROOFS LOCATED IN BASIC WIND SPEED OF 110 MPH OR GREATER, SPECIAL METHODS OF FASTENING ARE REQUIRED. UNLESS WITH ASTM D 3161 OR M-DC PA 107-95.

UNDERLAYMENT APPLICATION:

1. STARTING AT THE EAVE, A 19 INCH STRIP OF UNDERLAYMENT SHALL BE

FOR ROOF SLOPED 4:12 AND GREATER, UNDERLAYMENT SHALL BE A MINIMUM OF TWO LAYERS OF UNDERLAYMENT FELT APPLIED AS FOLLOWS: STARTING AT THE EAVE, UNDERLAYMENT SHALL BE APPLIED SHINGLE FASHION PARALLEL TO THE EAVE, LAPPED 2 INCHES, AND FASTENED SUFFICIENTLY TO STAY IN PLACE.

1. FOR OPEN VALLEYS LINED WITH METAL, THE VALLEY LINING SHALL BE

INCHES AND THE TOP LAYER A MINIMUM OF 36 INCHES WIDE. 3. FOR CLOSED VALLEYS VALLEY LINING SHALL BE ONE OF THE FOLLOWING:

© WM DEJGN & ASSOCIATES, INC. 26 SW COMMERCE DR., STE 130 LAKE CITY, FL 32025 (386) 758-8406 will@willmyers.net

JOINT VENTURED WITH

TRUCTION

O

ZMA

I

Ö

 $\bar{\sigma}$




JOB NUMBER 20230327

SHEET NUMBER


March 28, 2023

NOTE: ALL DRAWINGS NOT TO BE SCALED, WRITTEN DIMENSIONS TAKE PRECEDENCE OVER SCALED DIMENSIONS

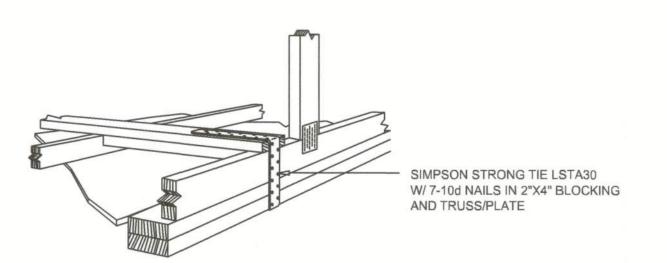

GABLE END GYPSUM DIAPHRAGM HOLDOWN CONNECTOR

SCALE: NONE

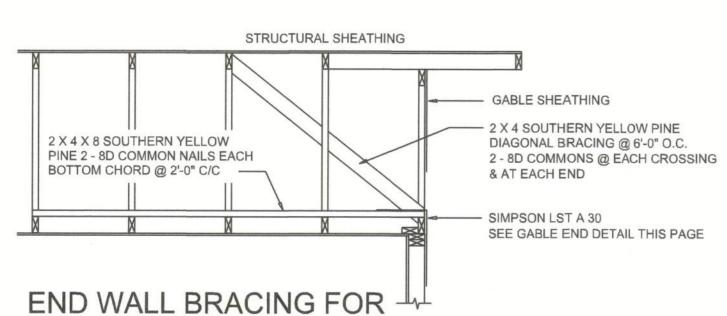

CEILING DIAPHRAGM


(ALTERNATIVE TO BALLOON FRAMING)

NOTE: ALL WOOD TO BE NUMBER 2 GRADE SOUTHERN YELLOW PINE

L		1		BUILDIN		GHT =	30.0	, EXP	OSURE	"B'
	ZONE	AREA	Yul- II5	t MPH	Vult 120	MPH	Vult 130	МРН	Vult 140	MPH
		(ft°)	Pos	Neg	Pos	Neg	Pos	Neg	Pos	Nec
IT	1	10	10.2	-20.3	11.1	-22.1	13	-26	15.1	-30.1
1	1	20	10	-18	10	-19.6	11.3	-23	13.1	-26.7
	1	50	10	-15	10	-16.3	10	-19.2	10.5	-22.2
	1	100	10	-12.7	10	-13.8	10	-16.2	10	-18.8
ال	2e	10	10.2	-24.2	11.1	-26.3	13	-30.9	15.1	-36.9
5	2e	20	10	-19.1	10	-20.8	11.3	-24.4	13.1	-28.3
2	2e	50	10	-11.9	10	-12.9	10	-15.1	10.5	-17.6
. 11	2e	100	10	-11.9	10	-12.9	10	-15.1	10	-17.6
12	2r	10	10.2	-30.6	11.1	-33.3	13	-39.1	15.1	-45.4
ROOF	2r	20	10	-25.7	10	-28	11.3	-32.8	13.1	-38.1
% I[2r	50	10	-19.2	10	-20.9	10	-24.5	10.5	-28.4
L [[2r	100	10	-14.3	10	-15.5	10	-18.2	10	-21.2
1	3	10	10.2	-32.7	11.1	-35.6	13	-41.7	15.1	-48.4
	3	20	10	-24.6	10	-26.7	11.3	-31.4	13.1	-36.4
	3	50	10	-14.3	10	-15.5	10	-18.2	10.5	-21.2
	3	100	10	-14.3	10	-15.5	10	-18.2	10	-21.2
	4	10	14.3	-15.5	15.5	-16.9	18.2	-19.8	21.2	-22.9
	4	20	13.6	-14.8	14.8	-16.1	17.4	-19	20.2	-22
	4	50	12.8	-14	13.9	-15.2	16.3	-17.9	19	-20.7
	4	100	12.1	-13.3	13.2	-14.5	15.5	-17.1	18	-19.8
d [4	500	10.6	-11.9	11.6	-12.9	13.6	-15.1	15.8	-17.6
MAL	5	10	14.3	-19.1	15.5	-20.8	18.2	-24.4	21.2	-28.3
- [5	20	13.6	-17.8	14.8	-19.4	17.4	-22.8	20.2	-26,4
	5	50	12.8	-16.1	13.9	-17.6	16.3	-20.6	19	-23.9
	5	100	12.1	-14.8	13.2	-16.1	15.5	-19	18	-22
	5	500	10.6	-11.9	11.6	-12.9	13.6	-15.1	15.8	-17.6

F	ROOF SHEATH	HING FASTE	NINGS
NAILING ZONE	SHEATHING TYPE	FASTENER	SPACING
1			6 in. o.c. EDGE 6 in. o.c. FIELD
2	7/16 " O.S.B. OR 19/32 CDX	10d RING	4 in. o.c. EDGE 6 in. o.c. FIELD
3	PLYWOOD	SHANK	4 in. o.c. @ GABLE ENDWALL OR GABLE TRUSS 6 in. o.c. EDGE 6 in. o.c. FIELD


FOR BUILD	DING COMPO	NENTS & CLAD	DING
BLDG HEIGHT (ft)	EXPOSURE "B"	EXPOSURE "C"	EXPOSURE
15	.82	1.21	1.47
20	.89	1,29	1.55
25	.94	1.35	1.61
30	1.00	1.40	1.66

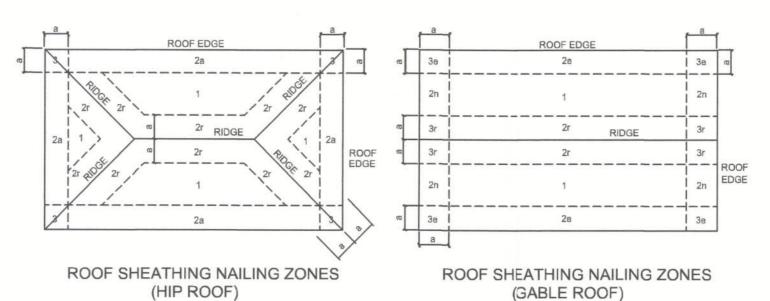

Roof Nail Pattern DET.


SCALE: NONE

			В	UILDING V	G WIDTH (FT)		
HEADERS	HEADER	20'		28'		36'	
SUPPORTING:	SIZE	SPAN	# JACKS	SPAN	# JACKS	SPAN	# JACKS
	2-2x4	3'-6"	1	3'-2"	1	2'-10"	1
ROOF, CEILING	2-2x6	5'-5"	1	4'-8"	1	4'-2"	1
	2-2x8	6'-10"	1	5'-11"	2	5'-4"	1
	2-2x10	8'-5"	2	7'-3"	2	6'-6"	2
	2-2x12	9'-9"	2	8'-5"	2	7'-6"	2
	3-2×8	8'-4"	1	7'-5"	1	6'-8"	1
	3-2x10	10'-6"	1	9'-1"	2	8'-2"	1
	3-2x12	12'-2"	2	10'-7"	2	9'-5"	2
	4-2x8	9'-2"	1	8'-4"	1	9'-2"	1
	4-2x10	11'-8"	1	10'-6"	1	9'-5"	1
	4-2x12	14'-1"	1	12'-2"	2	10'-11"	1

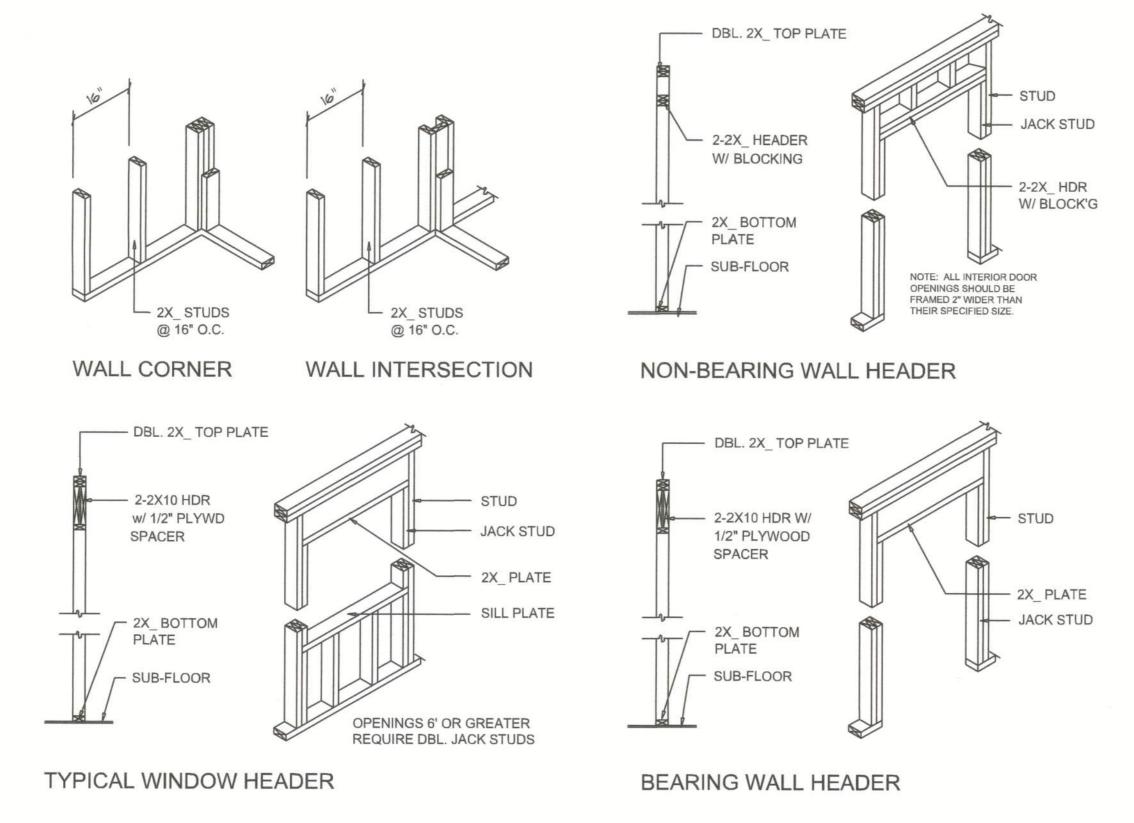

Wall Framing/Header DETAILS

SCALE: NONE

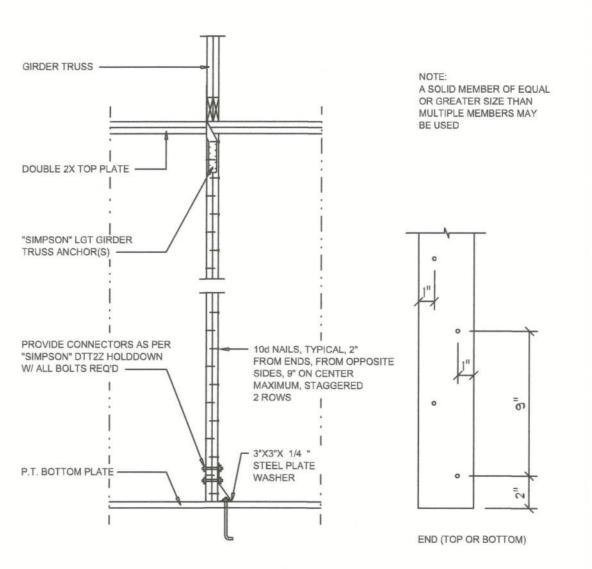


"WindSTORM" ALT. SHEATHING METHOD: ALTERNATIVE METHOD FOR ANCHORING THE TOP WALL PLATE TO THE FOUNDATION IN LIEU OF THE SP1/SP2 OR SP4 STRAPS INDICATED IN THE CONSTRUCTION DOCUMENTS FOR THIS PROJECT SHALL ALLOWED AS FOLLOWS:

APPLY VERTICALLY, "WindSTORM" 7/16" OSB 48" X 97", 109", 121" OR 145" SHEATHING. FASTEN TO THE TOP PLATE AND THE SILL PLATE WITH EITHER 6d COMMONS @ 3" O.C. OR 8d COMMONS @ 4" O.C., FASTEN TO EACH STUD WITH EITHER 6d COMMONS @ 6" O.C. OR 8d COMMONS @ 8" O.C.

Alternate 'Titan' bolt concrete anchor system EANCHOR SILL PLATE WITH 5/8" TITAN ANCHOR BOLT, PLACED AT 40" O.C. AROUND PERIMETER OF SLAB AND ALL INTERIOR BEARING WALLS. (MIN. 4" EMBED)

Girder Truss Column DET.


SCALE: 1/2" = 1'-0"

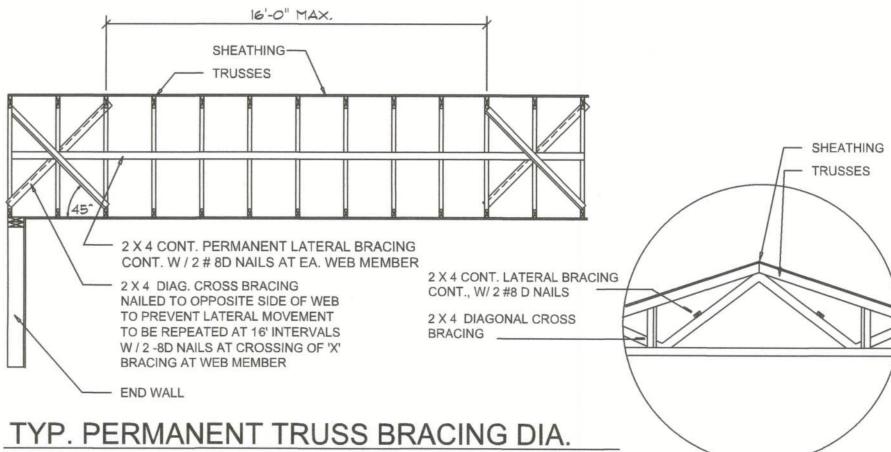

NOTE: ALL WOOD TO BE NUMBER 2 GRADE SOUTHERN YELLOW PINE

Truss Bracing DETAILS

SCALE: AS NOTED

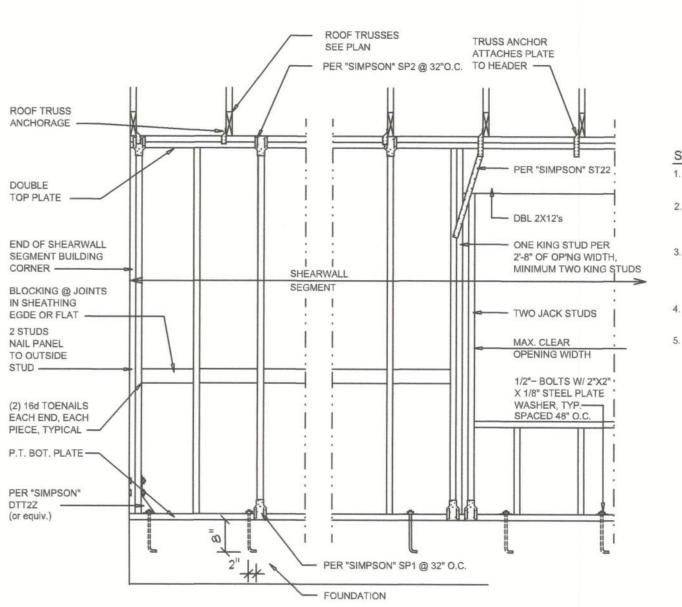

- . ALL SHEARWALLS SHALL BE TYPE 2 SHEARWALLS AS DEFINED BY STD 10-97 SBBCI 305.4.3.
- THE WALL SHALL BE ENTIRELY SHEATHED WITH 7/16 " O.S.B. INCLUDING AREAS ABOVE AND BELOW
- 3. ALL SHEATHING SHALL BE ATTACHED TO FRAMING ALONG ALL FOUR EDGES WITH JOINTS FOR ADJACENT PANELS OCCURING OVER COMMON FRAMING MEMBERS
- . NAIL SPACING SHALL BE 4" O.C. EDGES AND 8" O.C. IN THE FIELD.
- TYPE 2 SHEARWALLS ARE DESIGNED FOR THE OPENING IT CONTAINS. MAXIMUM HEIGHT OF OPENING SHALL BE 5/6 TIMES THE WALL HEIGHT. THE MINIMUM DISTANCE BETWEEN OPENINGS SHALL BE THE WALL HEIGHT/3.5 FOR 8'-0" WALLS (2'-3").

OPENING WIDTH	SILL PLATES	16d TOE NAILS EACH END
UP TO 6'-0"	(1) 2x4 OR (1) 2x6	1
> 6' TO 9'-0"	(3) 2x4 OR (1) 2x6	2
> 9' TO 12'-0"	(5) 2x4 OR (2) 2x6	3

Shear Wall DETAILS

SCALE: NONE

SOFTPIAN

eterson HEIT

JOINT VENTURED WITH

B NDEJEN ® A550CIATE 5. NC. 426 SW COMMERCE DR., STE 13 LAKE CITY, FL 32025 (386) 758-8406 will@willmyers.net



JOB NUMBER 20230327

March 28, 2023 SHEET NUMBER

S.2