

Mobile Home Permit Worksheet

Application Number: _____

Date: _____

POCKET PENETROMETER TEST

The pocket penetrometer tests are rounded down to 150 psf or check here to declare 1000 lb. soil without testing.

x 150

x 150

x 150

POCKET PENETROMETER TESTING METHOD

1. Test the perimeter of the home at 6 locations.
2. Take the reading at the depth of the footer.
3. Using 500 lb. increments, take the lowest reading and round down to that increment.

x 150

x 150

x 150

TORQUE PROBE TEST

The results of the torque probe test is 275 inch pounds or check here if you are declaring 5' anchors without testing. A test showing 275 inch pounds or less will require 5 foot anchors.

Note: A state approved lateral arm system is being used and 4 ft. anchors are allowed at the sidewall locations. I understand 5 ft. anchors are required at all centerline tie points where the torque test reading is 275 or less and where the mobile home manufacturer may require anchors with 4000 lb. holding capacity.

WHP Installer's initials

ALL TESTS MUST BE PERFORMED BY A LICENSED INSTALLER

Installer Name

William Price

Date Tested

4/21/23

Electrical

Connect electrical conductors between multi-wide units, but not to the main power source. This includes the bonding wire between multi-wide units. Pg. 1

Plumbing

Connect all sewer drains to an existing sewer tap or septic tank. Pg. 1

Connect all potable water supply piping to an existing water meter, water tap, or other independent water supply systems. Pg. 1

Site Preparation

Debris and organic material removed

Water drainage: Natural

Swale

Pad XX Other

Fastening multi wide units

Floor:

Type Fastener

Length

Spacing:

Walls:

Type Fastener

Length

Spacing:

Roof:

Type Fastener

Length

Spacing:

For used homes a min. 30 gauge, 8" wide, galvanized metal strip will be centered over the peak of the roof and fastened with galv. roofing nails at 2' on center on both sides of the centerline.

Gasket (weatherproofing requirement)

I understand a properly installed gasket is a requirement of all new and used homes and that condensation, mold, mildew and buckled marriage walls are a result of a poorly installed or no gasket being installed. I understand a strip of tape will not serve as a gasket.

WHP Installer's initials

Type gasket

Pg.

Installed

Between Floors Yes

Between Walls Yes

Bottom of ridgebeam Yes

Weatherproofing

The bottomboard will be repaired and/or taped. Yes

Pg.

Siding on units is installed to manufacturer's specifications. Yes

Fireplace chimney installed so as not to allow intrusion of rain water. Yes

Miscellaneous

Skirting to be installed. Yes

No

Dryer vent installed outside of skirting. Yes

N/A

Range downflow vent installed outside of skirting. Yes

N/A

Drain lines supported at 4 foot intervals. Yes

Electrical crossovers protected. Yes

Other:

Installer verifies all information given with this permit worksheet is accurate and true based on the manufacturer's installation instructions and or Rule 15C-1 & 2

Installer Signature

WHP

Date


4/21/23

Mobile Home Permit Worksheet

Installer: William Price License # 1H-1041936
 Address of home being installed: 798 NW Oak Glen
Lake City, FL 32053
 Manufacturer: LOH Length x width: 80x16

NOTE: If home is a single wide fill out one half of the blocking plan
 If home is a triple or quad wide sketch in remainder of home
 I understand Lateral Arm Systems cannot be used on any home (new or used)
 where the sidewall ties exceed 5 ft 4 in.

Installer's initials: WPA

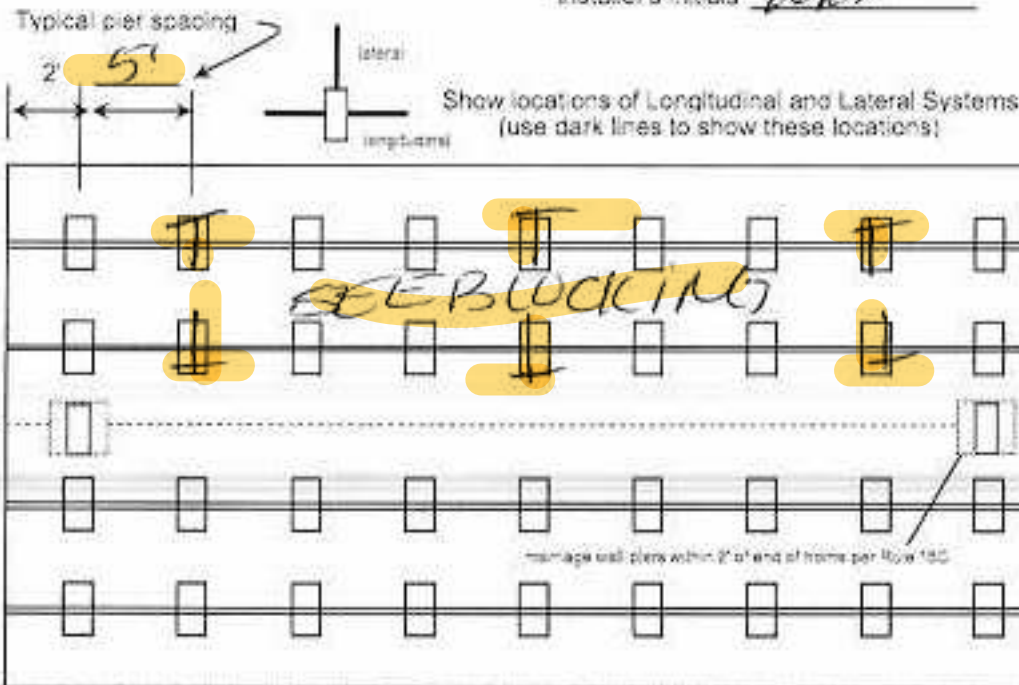

Application Number: _____

Date: _____

New Home ☒

Used Home ☐

Home installed to the Manufacturer's Installation Manual
 Home is installed in accordance with Rule 15-C

Single wide ☒

Wind Zone II ☒

Wind Zone III ☐

Double wide ☐

Installation Decal # 91534

Triple/Quad ☐

Serial # LOH6A

PIER SPACING TABLE FOR USED HOMES

Load bearing capacity	Footer size (sq in)	16' x 16' (256)	18 1/2' x 18 1/2' (342)	20' x 20' (400)	22' x 22' (484)	24' x 24' (576)	26' x 26' (676)
1000 psf		3'	4'	5'	6'	7'	8'
1500 psf		4'	6'	7'	8'	8'	8'
2000 psf		6'	8'	8'	8'	8'	8'
2500 psf		7'	8'	8'	8'	8'	8'
3000 psf		8'	8'	8'	8'	8'	8'
3500 psf		8'	8'	8'	8'	8'	8'

* Interpolated from Rule 15C-1 pier spacing table.

PIER PAD SIZES

I-beam pier pad size 17x25

Perimeter pier pad size 14x16

Other pier pad sizes (required by the mfg.) _____

Draw the approximate locations of marriage wall openings 4 foot or greater. Use this symbol to show the piers.

List all marriage wall openings greater than 4 foot and their pier pad sizes below.

Opening Large

Pier pad size 23x31

POPULAR PAD SIZES

Pad Size	Sq In
16 x 16	256
16 x 18	288
18.5 x 18.5	342
18 x 22.5	360
17 x 22	374
13 1/4 x 26 1/4	348
20 x 20	400
17 3/16 x 25 3/16	441
17 1/2 x 25 1/2	448
24 x 24	576
26 x 26	676

ANCHORS

4 ft ☒ 5 ft ☐

FRAME TIES

within 2' of end of home spaced at 5' 4" oc ☒

OTHER TIES

Sidewall
 Longitudinal
 Marriage wall
 Shearwall

Number 14

TIEDOWN COMPONENTS


Longitudinal Stabilizing Device (LSD)

Manufacturer _____

Longitudinal Stabilizing Device w/ Lateral Arms

Manufacturer Invertech



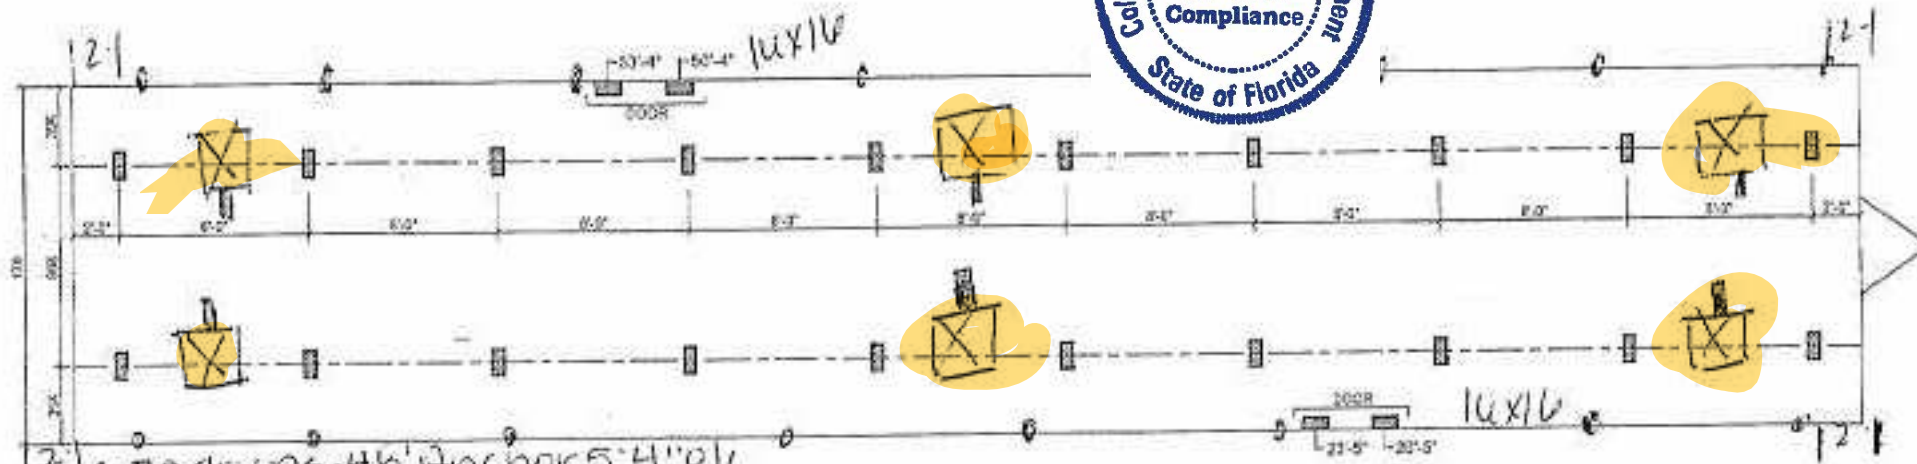


*All per the 1st doors 16x14
Live Oak Homes
MODEL: L-5763H-CLASSIC-SVS - 16 X 80
3-BEDROOM / 2-BATH

The top diagram shows a continuous beam with three spans. The spans are labeled 6.3, 8.0, and 7.0. The total length is 21.3. The bottom diagram shows the same beam with a 3000mm scale bar and dimensions of 6.3 and 10.0.

(99.5" J-BEAM SPACING)
L-5763H-CLASSIC


ACE

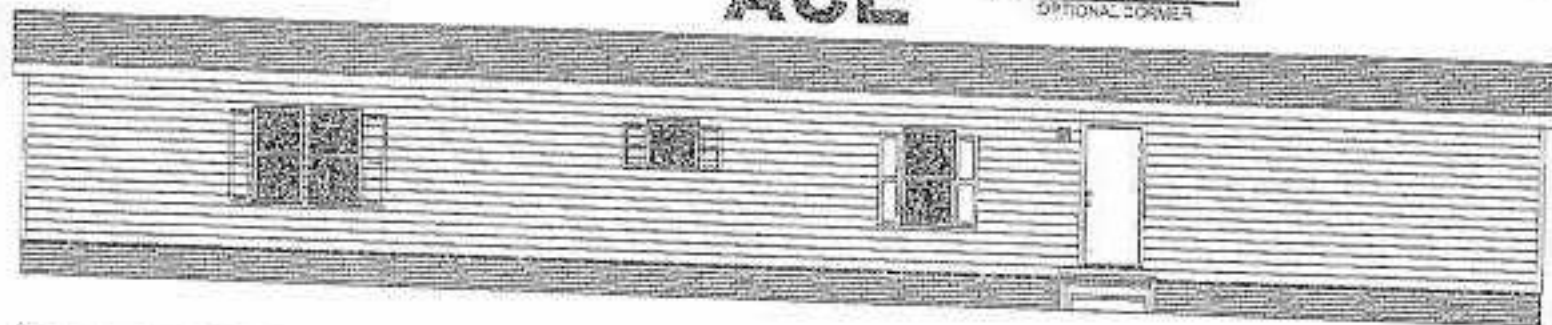

OPT. HITCH END



OPT. SHAKE ACCENT

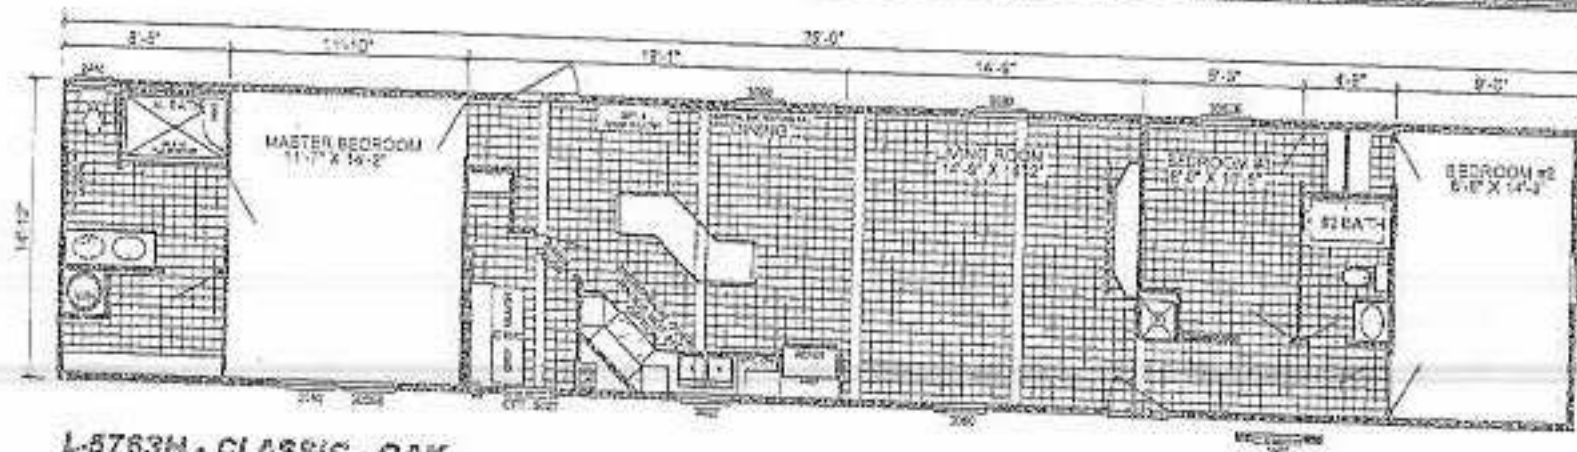


L-5763H - CLASSIC - OAK
3-BEDROOM / 2-BATH
16' X 80' - Approx. 1130 Sq. Ft.

DAW 1807102

- * All non-fabric items, including chairs, are shown for layout purposes only.
- * Kitchen windows are available in optional 8'0" slide-in models only.
- * The DAW Group reserves the right to modify product offerings at any time.

** W2.3 w/ 108" SIDEWALLS NOT AVAILABLE **
 ** NO DRAWER BANK IF ISLAND IS OMITTED **

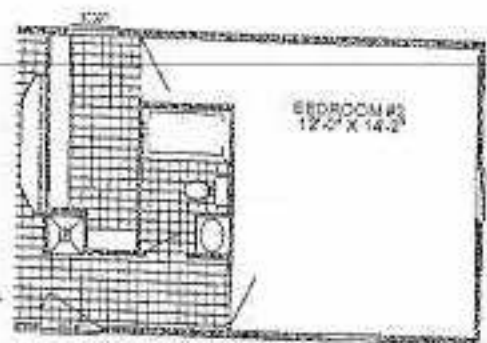

OPT. 2 BEDROOM

Byrdon

16480

Columbia
WFFHAC

License Number: IH / 1041936 / 1 Name: WILLIAM R PRICE

Order #: 5453

Label #: 91534

Manufacturer

(Check Size of Home)

Homeowner:

Year Model

Single

Address:

Length & Width:

Double

City/State/Zip:

Type Longitudinal System:

Triple

Phone #:

Type Lateral Arm System:

HUD Label #:

Date Installed:

New Home: _____ Used Home: _____

Soil Bearing / PSF:

Installed Wind Zone:

Data Plate Wind Zone:

Torque Probe / in-lbs:

Note:

Permit #:

STATE OF FLORIDA
INSTALLATION CERTIFICATION LABEL

91534

LABEL #

DATE OF INSTALLATION

WILLIAM R PRICE

NAME

IH / 1041936 / 1

5453

LICENSE #

ORDER #

CERTIFIES THAT THE INSTALLATION OF THIS MOBILE HOME IS
IN ACCORDANCE WITH FLORIDA STATUTES 320.8249, 320.8325
AND RULES OF THE HIGHWAY SAFETY AND MOTOR VEHICLES.

PLEASE WRITE DATE OF
INSTALLATION AND AFFIX
NEXT TO HUD LABEL.
PERMANENT INK PEN
MARKER ONLY.
COMPLETE INFORMATION
DATE AND KEEP ON FILE
A MINIMUM OF 2 YEARS.
REQUIRED TO
WHEN