

Mobile Home Permit Worksheet

Application Number: TBD Date: 06/24/2024

POCKET PENETROMETER TEST

The pocket penetrometer tests are rounded down to 3000 psf or check here to declare 1000 lb. soil _____ without testing.

X 3000

X 3100

X 3100

POCKET PENETROMETER TESTING METHOD

1. Test the perimeter of the home at 6 locations.
2. Take the reading at the depth of the footer.
3. Using 500 lb. increments, take the lowest reading and round down to that increment.

X 3100

X 3100

X 3200

TORQUE PROBE TEST

The results of the torque probe test is 310 inch pounds or check here if you are declaring 5' anchors without testing _____. A test showing 275 inch pounds or less will require 5 foot anchors.

Note: A state approved lateral arm system is being used and 4 ft anchors are allowed at the sidewall locations. I understand 5 ft anchors are required at all centerline tie points where the torque test reading is 275 or less and where the mobile home manufacturer may requires anchors with 4000 lb holding capacity.
_____ CB _____ Installer's initials

ALL TESTS MUST BE PERFORMED BY A LICENSED INSTALLER

Installer Name Christopher L Bible
Date Tested 06/18/2024

Electrical

Connect electrical conductors between multi-wide units, but not to the main power source. This includes the bonding wire between multi-wide units. Pg. N/A

Plumbing

Connect all sewer drains to an existing sewer tap or septic tank. Pg. 57

Connect all potable water supply piping to an existing water meter, water tap, or other independent water supply systems. Pg. 56

Site Preparation

Debris and organic material removed Yes _____
Water drainage: Natural _____ Swale _____ Pad Xxxxx Other _____

Fastening multi wide units

Floor:	Type Fastener: <u>N/A</u>	Length: <u>N/A</u>	Spacing: <u>N/A</u>
Walls:	Type Fastener: <u>N/A</u>	Length: <u>N/A</u>	Spacing: <u>N/A</u>
Roof:	Type Fastener: <u>N/A</u>	Length: <u>N/A</u>	Spacing: <u>N/A</u>

For used homes a min. 30 gauge, 8" wide, galvanized metal strip will be centered over the peak of the roof and fastened with galv. roofing nails at 2" on center on both sides of the centerline.

Gasket (weatherproofing requirement)

I understand a properly installed gasket is a requirement of all new and used homes and that condensation, mold, mildew and buckled marriage walls are a result of a poorly installed or no gasket being installed. I understand a strip of tape will not serve as a gasket.

Installer's initials _____

Type gasket N/A
Pg. N/A

Installed:
Between Floors Yes N/A
Between Walls Yes N/A
Bottom of ridgebeam Yes N/A

Weatherproofing

The bottomboard will be repaired and/or taped. Yes X Pg. 91
Siding on units is installed to manufacturer's specifications. Yes X
Fireplace chimney installed so as not to allow intrusion of rain water. Yes N/A

Miscellaneous


Skirting to be installed. Yes X No _____
Dryer vent installed outside of skirting. Yes X N/A _____
Range downflow vent installed outside of skirting. Yes X N/A _____
Drain lines supported at 4 foot intervals. Yes X
Electrical crossovers protected. Yes N/A
Other: _____

Installer verifies all information given with this permit worksheet is accurate and true based on the manufacturer's installation instructions and or Rule 15C-1 & 2

Installer Signature _____



Date 06/24/2024

Mobile Home Permit Worksheet

 Christopher L Bible License # IH1128362
 Address of home being installed 1143 SW Newark Dr, Ft White FL 32038
 Parcel ID 00-00-00-01412-039 (45980)
 Manufacturer Champion Length x width 13.4'x56'

NOTE: if home is a single wide fill out one half of the blocking plan
 if home is a triple or quad wide sketch in remainder of home
 I understand Lateral Arm Systems cannot be used on any home (new or used)
 where the sidewall ties exceed 5 ft 4 in.

Installer's initials CB

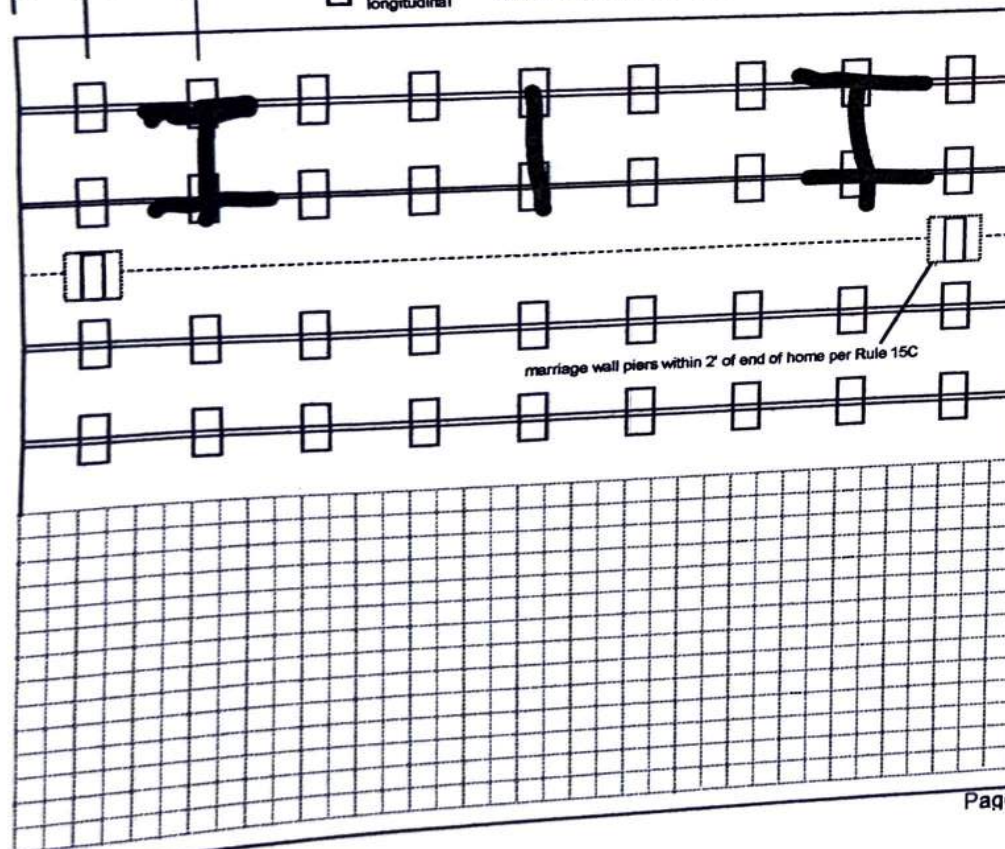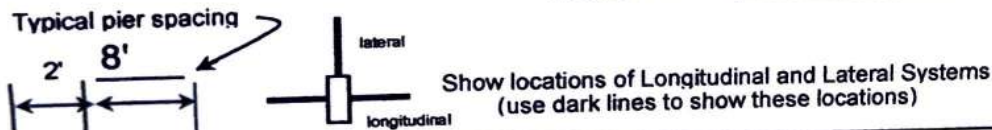

Application Number: _____ Date: 06/24/2024
 New Home ☒ Used Home ☐
 Home installed to the Manufacturer's Installation Manual ☒
 Home is installed in accordance with Rule 15-C ☐
 Single wide ☒ Wind Zone II ☒ Wind Zone III ☐
 Double wide ☐ Installation Decal # TBD
 Triple/Quad ☐ Serial # TBD


PIER SPACING TABLE FOR USED HOMES

Load bearing capacity	Footer size (sq in)	16" x 16" (256)	18 1/2" x 18 1/2" (342)	20" x 20" (400)	22" x 22" (484)*	24" X 24" (576)*	26" x 26" (676)
1000 psf		3'	4'	5'	6'	7'	8'
1500 psf		4' 6"	6'	7'	8'	8'	8'
2000 psf		6'	8'	8'	8'	8'	8'
2500 psf		7' 6"	8'	8'	8'	8'	8'
3000 psf		8'	8'	8'	8'	8'	8'
3500 psf		8'	8'	8'	8'	8'	8'

* interpolated from Rule 15C-1 pier spacing table.

PIER PAD SIZES

I-beam pier pad size 17 1/2 X 25 1/2
 Perimeter pier pad size 13 1/4 X 26 1/4
 Other pier pad sizes _____
 (required by the mfg.)

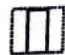 Draw the approximate locations of marriage wall openings 4 foot or greater. Use this symbol to show the piers.

List all marriage wall openings greater than 4 foot and their pier pad sizes below.

Opening	Pier pad size

TIEDOWN COMPONENTS

Longitudinal Stabilizing Device (LSD)
 Manufacturer Minute man
Longitudinal Stabilizing Device w/ Lateral Arms
 Manufacturer Minute man

POPULAR PAD SIZES

Pad Size	Sq In
16 x 16	256
16 x 18	288
18.5 x 18.5	342
16 x 22.5	360
17 x 22	374
13 1/4 x 26 1/4	348
20 x 20	400
17 3/16 x 25 3/16	441
17 1/2 x 25 1/2	446
24 x 24	576
26 x 26	676

ANCHORS

4 ft Yes 5 ft

FRAME TIES

within 2' of end of home spaced at 5' 4" oc Yes

OTHER TIES

	Number
Sidewall	22
Longitudinal	6
Marriage wall	N/A
Shearwall	N/A