

DATE 01/23/2007

Columbia County Building Permit

PERMIT

This Permit Expires One Year From the Date of Issue

000025449

APPLICANT JEFF MARTIN PHONE 352 732-8600
ADDRESS 1720 NW 4TH AVE Ocala FL 34475
OWNER JACQUELINE SULEK PHONE 497-4185
ADDRESS 209 SW PAISLEY COURT FT. WHITE FL 32038
CONTRACTOR FAIRBANKS CONSTRUCTION PHONE 352 732-8600
LOCATION OF PROPERTY 47-S, TL ON 27, TL ON PAISLEY COURT, 4TH LOT ON RIGHT

TYPE DEVELOPMENT SUNROOM ESTIMATED COST OF CONSTRUCTION 23394.00
HEATED FLOOR AREA TOTAL AREA HEIGHT STORIES 1
FOUNDATION CONC WALLS FRAMED ROOF PITCH FLOOR
LAND USE & ZONING FT WHITE MAX. HEIGHT
Minimum Set Back Requirments: STREET-FRONT REAR SIDE
NO. EX.D.U. FLOOD ZONE FW DEVELOPMENT PERMIT NO.

PARCEL ID 34-6S-16-04060-125 SUBDIVISION FORT WHITE PARK
LOT 25 BLOCK PHASE UNIT 0 TOTAL ACRES

CRC030504
Culvert Permit No. Culvert Waiver Contractor's License Number Applicant/Owner/Contractor
EXISTING 070039-E JH N
Driveway Connection Septic Tank Number LU & Zoning checked by Approved for Issuance New Resident

COMMENTS: NOC ON FILE
FT WHITE LETTER ON FILE

Check # or Cash 3252

FOR BUILDING & ZONING DEPARTMENT ONLY

(footer/Slab)

Temporary Power date/app. by Foundation date/app. by Monolithic date/app. by
Under slab rough-in plumbing date/app. by Slab date/app. by Sheathing/Nailing date/app. by
Framing date/app. by Rough-in plumbing above slab and below wood floor date/app. by
Electrical rough-in date/app. by Heat & Air Duct date/app. by Peri. beam (Lintel) date/app. by
Permanent power date/app. by C.O. Final date/app. by Culvert date/app. by
M/H tie downs, blocking, electricity and plumbing date/app. by Pool date/app. by
Reconnection date/app. by Pump pole date/app. by Utility Pole date/app. by
M/H Pole date/app. by Travel Trailer date/app. by Re-roof date/app. by

BUILDING PERMIT FEE \$ 120.00 CERTIFICATION FEE \$ 0.00 SURCHARGE FEE \$ 0.00
MISC. FEES \$ 0.00 ZONING CERT. FEE \$ FIRE FEE \$ 0.00 WASTE FEE \$
FLOOD DEVELOPMENT FEE \$ FLOOD ZONE FEE \$ CULVERT FEE \$ TOTAL FEE 120.00

INSPECTORS OFFICE CLERKS OFFICE

NOTICE: IN ADDITION TO THE REQUIREMENTS OF THIS PERMIT, THERE MAY BE ADDITIONAL RESTRICTIONS APPLICABLE TO THIS PROPERTY THAT MAY BE FOUND IN THE PUBLIC RECORDS OF THIS COUNTY. AND THERE MAY BE ADDITIONAL PERMITS REQUIRED FROM OTHER GOVERNMENTAL ENTITIES SUCH AS WATER MANAGEMENT DISTRICTS, STATE AGENCIES, OR FEDERAL AGENCIES.

"WARNING TO OWNER: YOUR FAILURE TO RECORD A NOTICE OF COMMENCEMENT MAY RESULT IN YOUR PAYING TWICE FOR IMPROVEMENTS TO YOUR PROPERTY. IF YOU INTEND TO OBTAIN FINANCING, CONSULT WITH YOUR LENDER OR AN ATTORNEY BEFORE RECORDING YOUR NOTICE OF COMMENCEMENT."

This Permit Must Be Prominently Posted on Premises During Construction


PLEASE NOTIFY THE COLUMBIA COUNTY BUILDING DEPARTMENT AT LEAST 24 HOURS IN ADVANCE OF EACH INSPECTION, IN ORDER THAT IT MAY BE MADE WITHOUT DELAY OR INCONVIENCE, PHONE 758-1008. THIS PERMIT IS NOT VALID UNLESS THE WORK AUTHORIZED BY IT IS COMMENCED WITHIN 6 MONTHS AFTER ISSUANCE.

The Issuance of this Permit Does Not Waive Compliance by Permittee with Deed Restrictions.

BOUNDARY SURVEY IN SECTION 34, T1
RANGE 16 EAST, COLUMBIA C

- SURVEYOR'S NOTES:
1. BOUNDARY BASED ON MONUMENTATION FOUND IN ACCORDANCE WITH THE RETRACEMENT OF THE ORIGINAL SURVEY FOR SAID PLAT OF RECORD.
 2. BEARINGS ARE BASED ON SAID PLAT OF RECORD.
 3. THIS PARCEL IS IN ZONE 'X' AND IS DETERMINED TO BE OUTSIDE THE 500 YEAR FLOODED PLAIN AS PER FLOODED RATE MAP, DATED 6 JANUARY, 1988 COMMUNITY PANEL NUMBER 120070 8260 B. HOWEVER, THE FLOODED INSURANCE RATE MAPS ARE SUBJECT TO CHANGE.
 4. THE IMPROVEMENTS, IF ANY, INDICATED ON THIS SURVEY DRAWING ARE AS LOCATED ON DATE OF FIELD SURVEY AS SHOWN HEREON.
 5. IF THEY EXIST, NO UNDERGROUND ENCROACHMENTS AND/OR UTILITIES WERE LOCATED FOR THIS SURVEY EXCEPT AS SHOWN HEREON.
 6. THIS SURVEY WAS COMPLETED WITHOUT THE BENEFIT OF A TITLE COMMITMENT OR A TITLE POLICY.

Parcel # 34-6S-16-04060-125 HX
JACQUELINE A. SULEK
209 SW PAISLEY CT.
FT. WHITE, FL 32038
386-497-4185

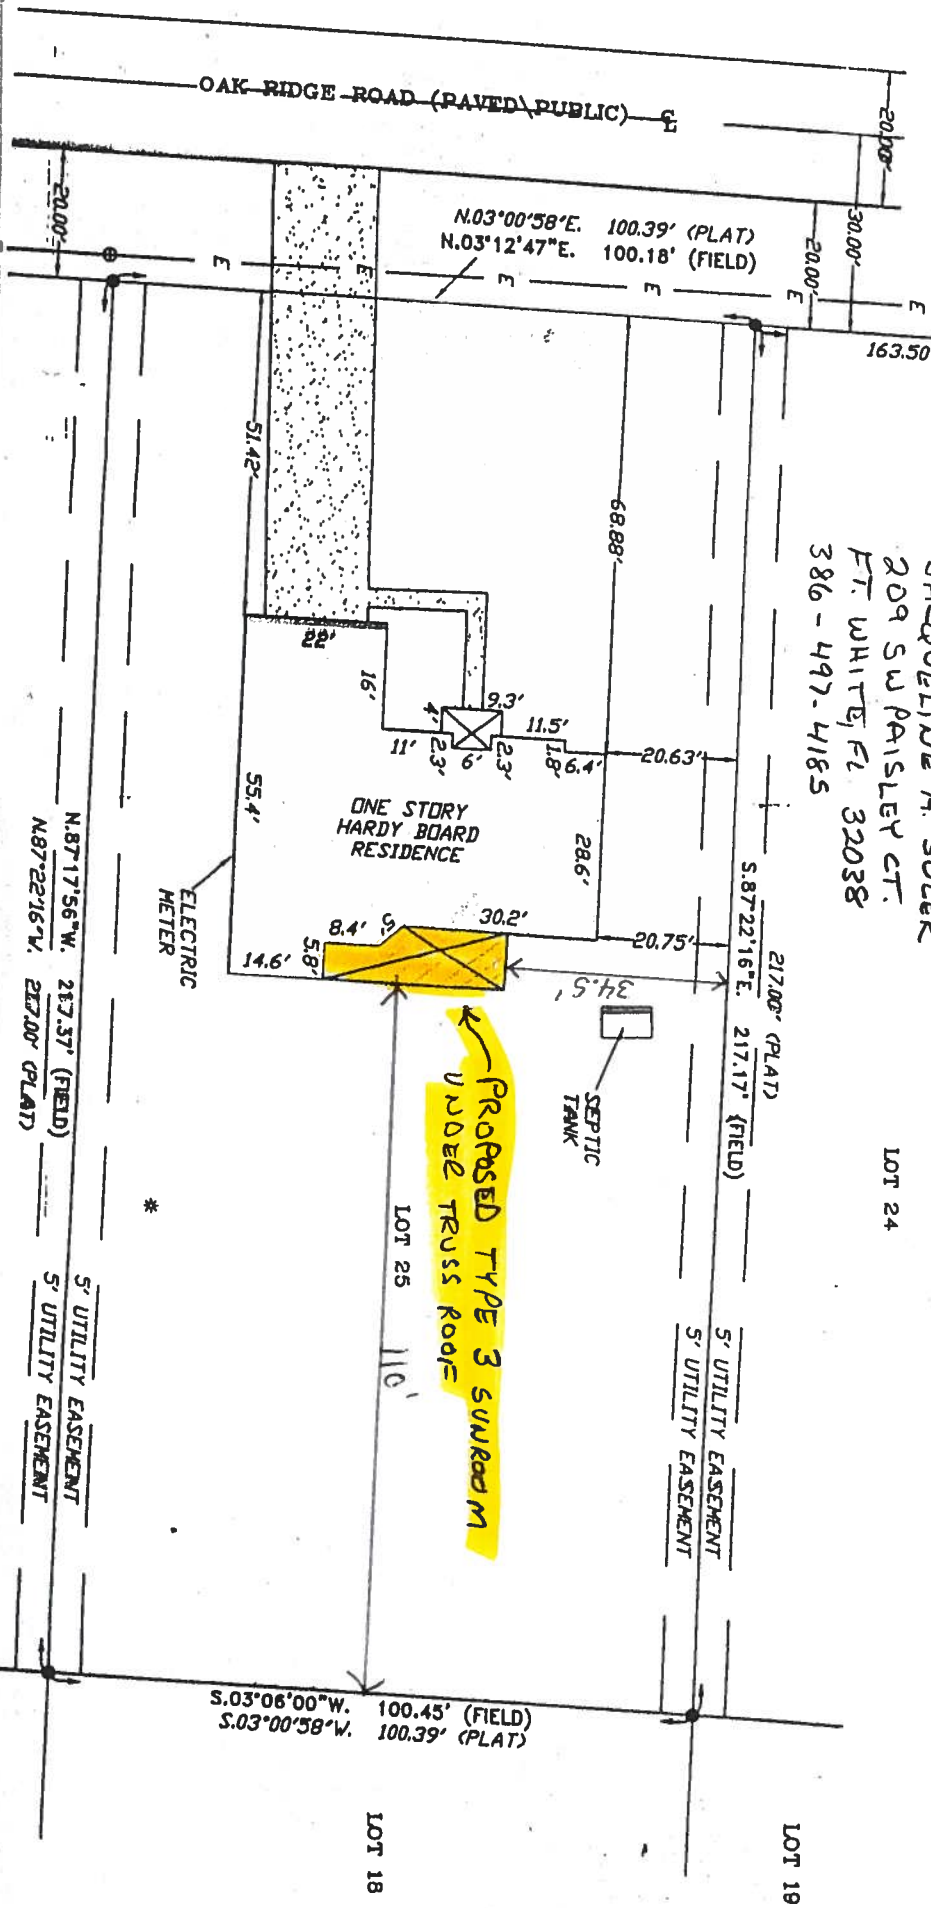

SCALE: 1" = 30'



- SYMBOLS
- 4"x4" CONCRE
 - 4"x4" CONCRE
 - IRON PIPE FD
 - IRON PIN AND
 - ⊙ POWER POLE
 - ▲ WATER METER
 - ⊕ CENTERLINE
 - * WELL
 - ⊙ SATELLITE DIS
 - ⊙ TELEPHONE BU
 - ELECTRIC LINE
 - X- WIRE FENCE
 - CHAIN LINK FE
 - WOODEN FENCE

209 SW Pais
Ft. White, FL

DESCRIPTION
LOT 25 OF 'FORT WHITE PARK' AS PER PLAT 1
IN PLAT BOOK 6, PAGES 3 & 3A OF THE PUBLI
COLUMBIA COUNTY, FLORIDA

NOTE: ALL PROPERTY CORNERS LOCATED ARE ID
BAILEY, BISHOP & LANE, L.B. 6685.

BOUNDARY SURVEY IN SECTION - 34,
RANGE 16 EAST,
COLUMBIA


1-10-07
[Signature]

- SURVEYOR'S NOTES:**
1. BOUNDARY BASED ON MONUMENTATION FOUND IN ACCORDANCE WITH THE RETRACEMENT OF THE ORIGINAL SURVEY FOR SAID PLAT OF RECORD.
 2. BEARINGS ARE BASED ON SAID PLAT OF RECORD.
 3. THIS PARCEL IS IN ZONE "X" AND IS DETERMINED TO BE OUTSIDE THE 500 YEAR FLOOD PLAIN AS PER FLOOD RATE MAP, DATED 6 JANUARY, 1988 COMMUNITY PANEL NUMBER 120070 DE58 B. HOWEVER, THE FLOOD INSURANCE RATE MAPS ARE SUBJECT TO CHANGE.
 4. THE IMPROVEMENTS, IF ANY, INDICATED ON THIS SURVEY DRAWING ARE AS LOCATED ON DATE OF FIELD SURVEY AS SHOWN HEREON.
 5. IF THEY EXIST, NO UNDERGROUND ENCROACHMENTS AND/OR UTILITIES WERE LOCATED FOR THIS SURVEY EXCEPT AS SHOWN HEREON.
 6. THIS SURVEY WAS COMPLETED WITHOUT THE BENEFIT OF A TITLE COMMITMENT OR A TITLE POLICE.


SCALE: 1" = 30'

SYMBOLS

■	4"x4" CONC
●	4"x4" CONC
○	IRON PIPE 1"
○	IRON PIN 1"
○	POWER POLE
▲	WATER METER
△	CENTERLINE
*	WELL
⊙	SATELLITE D
⊙	TELEPHONE 1"
—E—	ELECTRIC LID
—X—	WIRE FENCE
—O—	CHAIN LINK F
—□—	WOODEN FENCE

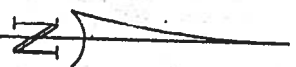


Parcel # 34-6S-16-04060-125 HX
JACQUELINE A. SULEK
209 S W PAISLEY CT.
FT. WHITE FL. 32038
386-497-4185

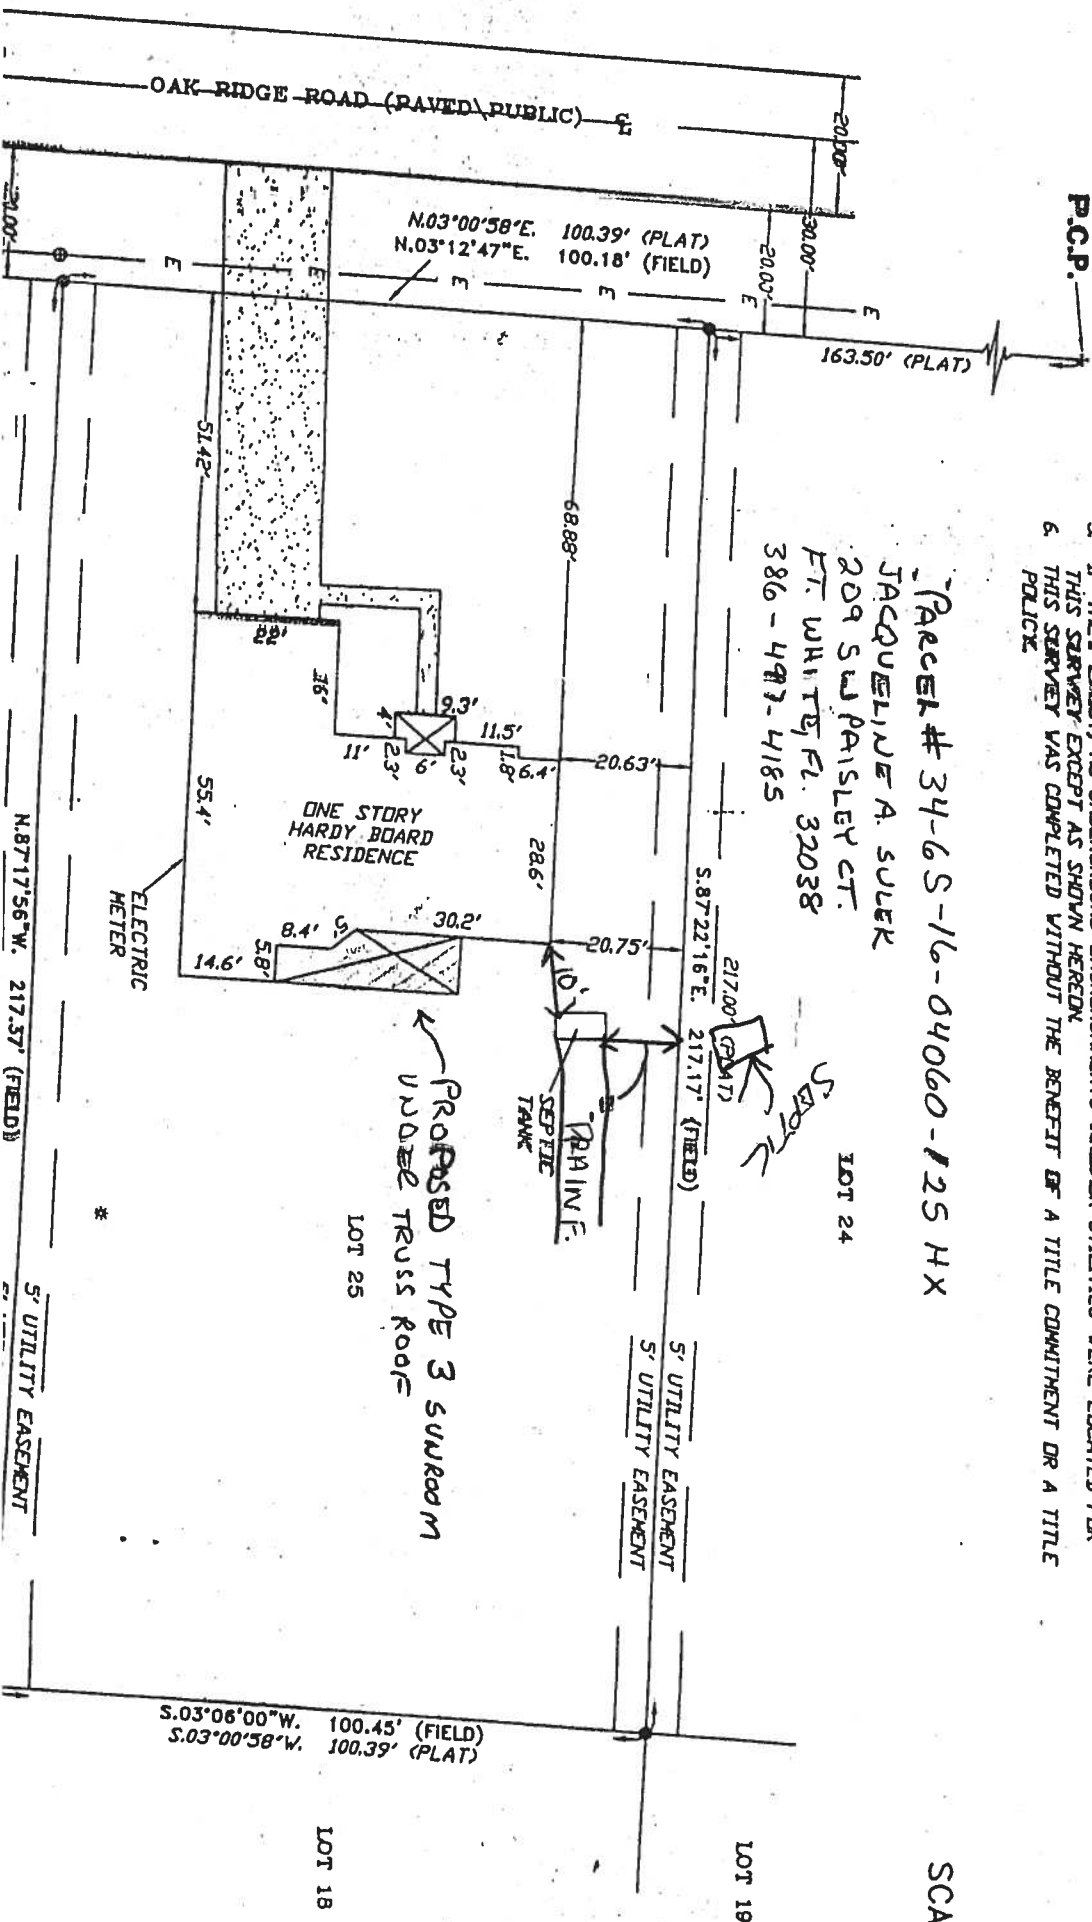


DESCRIPTION:
LOT 25 OF "FORT WHITE PARK" AS PER PLAT IN PLAT BOOK 6, PAGES 3 & 34 OF THE PUBLIC COLUMBIA COUNTY, FLORIDA

NOTE: ALL PROPERTY CORNERS LOCATED ARE BAILEY, BISHOP & LANE, L.B. 6685.


209 S W Paisley
FT. White, FL

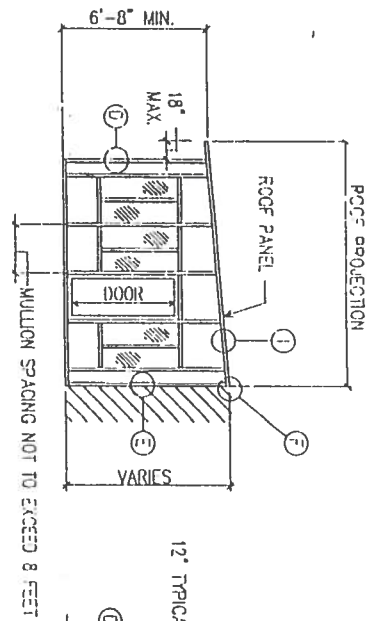


PATIO COVER END WALL ELEVATION

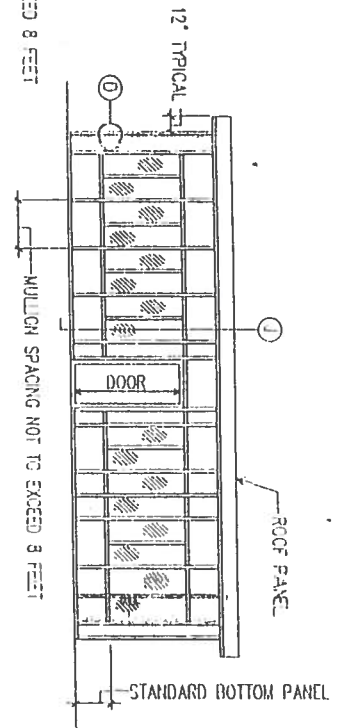


PATIO COVER FRONT WALL ELEVATION

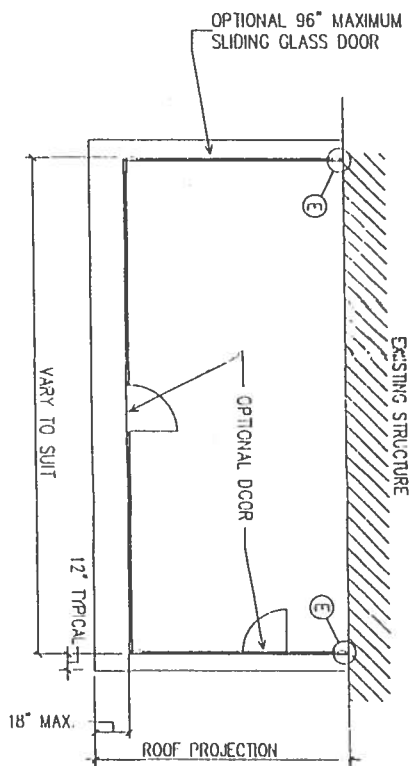


TYPICAL STUDIO ROOF PATIO COVER PLAN

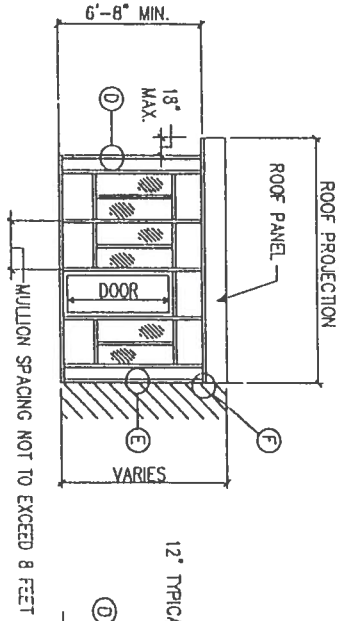

PATIO COVER END WALL ELEVATION

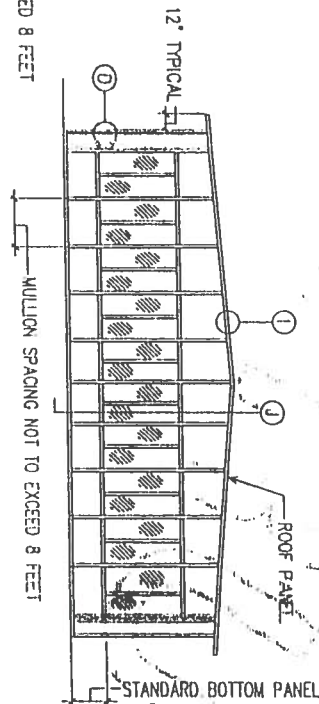

PATIO COVER FRONT WALL ELEVATION

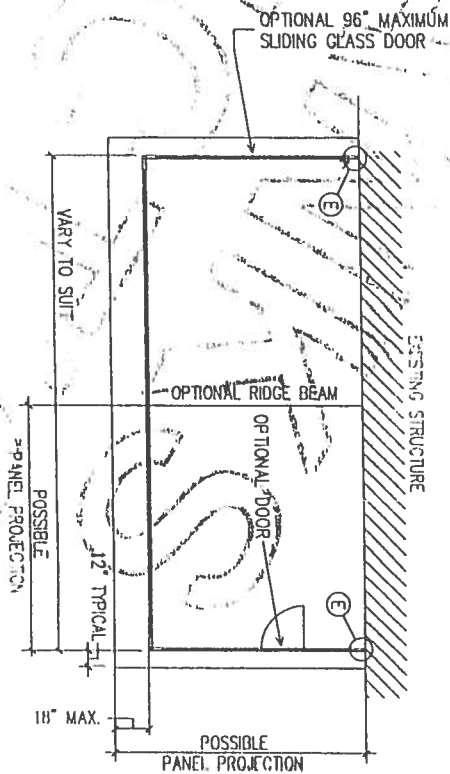

TYPICAL GABLE ROOF PATIO COVER PLAN

NOTE:
ALL SECTIONS & DETAILS REFERENCED
HERE ARE SHOWN ON SHEET 4ITEM04.

\\temoed\p\proj\11417-2008\4ITEM012008

Robert A. Wall, PE
SEAL AND SIGNATURE
ON 05/15/2008

FLOOR PLAN
ELEVATIONS &
ROOF PLAN

Temo inc.


20400 HALL ROAD • CLINTON TOWNSHIP • MICHIGAN 48038
586-286-0410 1-800-344-8366 FAX 586-226-1703

WHERE REQUIRED THESE PLANS HAVE BEEN
SIGNED AND SEALED BY A PROFESSIONAL
ENGINEER. ONLY AN ORIGINAL SIGNATURE,
WITH A RED WET SEAL OR AN EMBOSSED
SEAL INDICATE THE VALIDITY OF THAT
SIGNATURE.


TEMO, INC. MAINTAINS THE REPORTS
LISTED ACROSS THE TOP OF THE
COVER SHEET. PLEASE REFER TO
THE NOTES ON PAGE 41152 FOR
ANY ADDITIONAL INFORMATION
CONCERNING THESE REPORTS.

VOID IF SUBMITTED
DECEMBER 31


4ITEM01

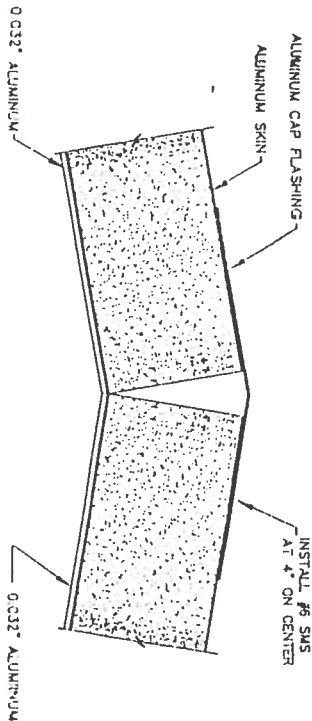


ROOF PANEL AT CATHEDRAL
PEAK WITHOUT BEAM DETAIL

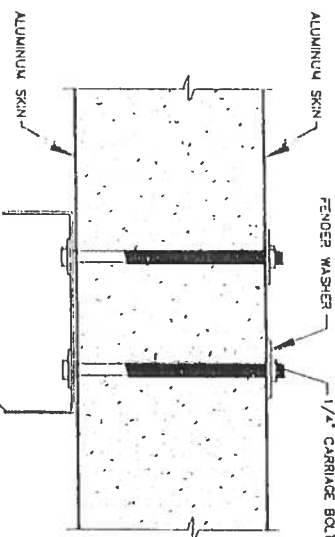


CEILING FAN MOUNTING DETAIL

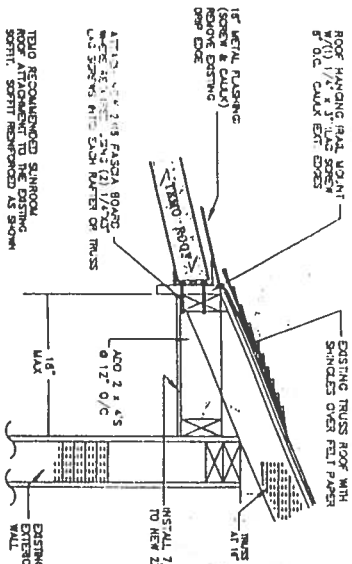


REINFORCING AND ATTACHMENT DETAIL

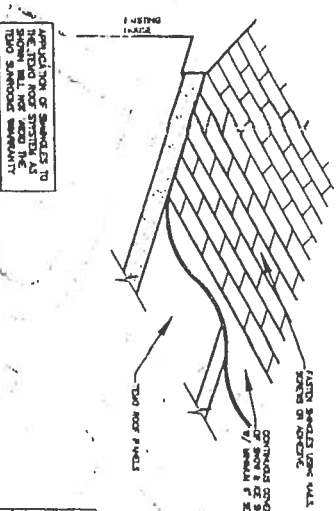

SHINGLES TO ROOF PANEL
ATTACHMENT DETAIL

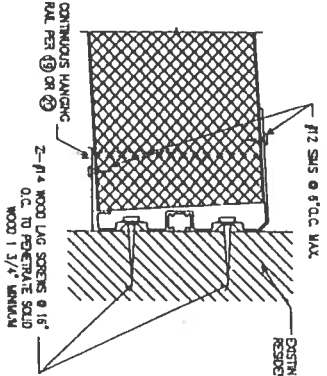

ROOF PANEL/WALL ATTACHMENT

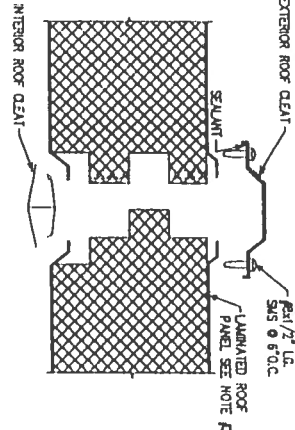

ROOF PANEL SPLICE

1. SHOWN ON DRAWING NO. 42524 OR UNDER A CODE-APPROVED EXISTING ROOF.
2. DESIGN LOADS: SEE TABLES FOR DESIGN LOADS AS SPECIFIED PER THE 2004 FLORIDA BUILDING CODE AND THE 2004 FLORIDA RESIDENTIAL CODE.
3. FASTENERS: FASTENERS SHALL BE 3/16\"/>

TABLE "C": MAXIMUM ROOF
PANEL SPANS*

DESIGN LOAD	1'-3'-2'-32	T-4-25-2-32	T-6-2-32
10 PSF LIVE LOAD	18'-4"	23'-3"	24'-0"
130 MPH WIND	13'-0"	15'-3"	18'-6"
30 PSF LIVE LOAD			
130 MPH WIND			

* MAXIMUM PANEL OVERHANG IS 1'-6"
MINIMUM ROOF PANEL SLOPE IS 2%

DATE: MAY 15, 2006
PROJECT: A WALL FOR 2000 HALL ROAD, CLINTON TWP., MI
DESIGNER: Temo, Inc.
SIGNED AND SEALED: 05/15/06
4TEM02





3.625" SUNROOM
SYSTEM ROOF DETAILS
AND NOTES

Temo Inc.
20400 HALL ROAD • CLINTON TOWNSHIP • MICHIGAN 48038
586-288-0410 1-800-344-8366 FAX 586-226-1703

WHERE REQUIRED THESE PLANS HAVE BEEN
SIGNED AND SEALED BY A PROFESSIONAL
ENGINEER. ONLY AN ORIGINAL SIGNATURE
WITH A BLUE INK STAMP OR AN EMBOSSED
SEAL INDICATE THE VALIDITY OF THAT
SIGNATURE.

TEMO, INC. MAINTAINS THE REPORTS
LISTED ABOVE ON TOP OF THE
COVER SHEET. PLEASE REFER TO
THE NOTES ON PAGE 41152 FOR
ANY ADDITIONAL INFORMATION
CONCERNING THESE REPORTS.

VOID IF SIGNED
DECEMBER 31,

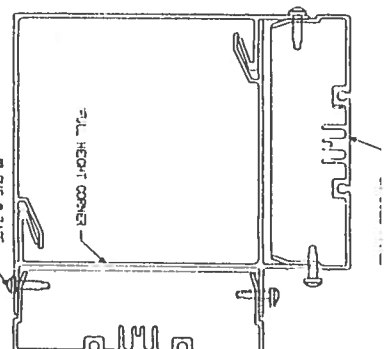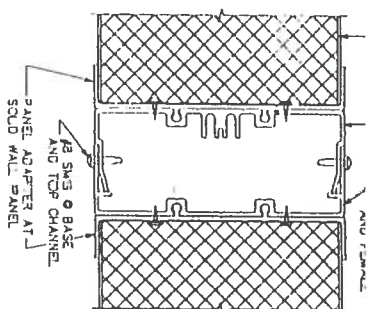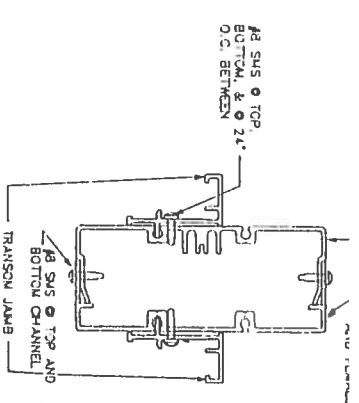
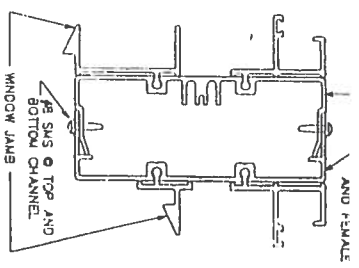


MALE / FEMALE WALL UNITS


(A)

CORNER


(D)

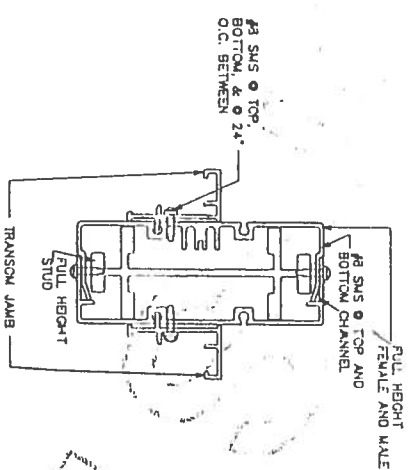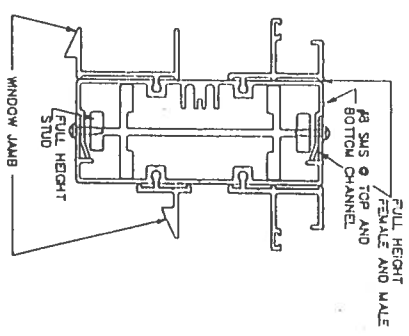


1/2\"/>

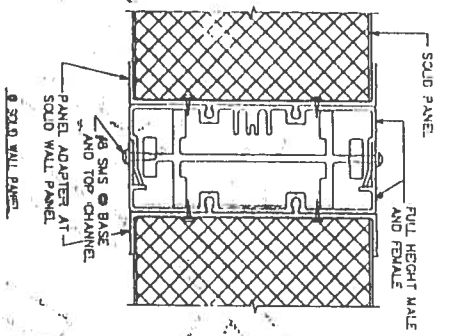


1/2\"/>

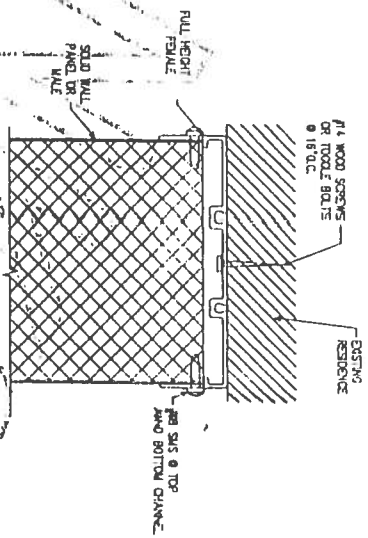


FEMALE/WALL STUD/MALE

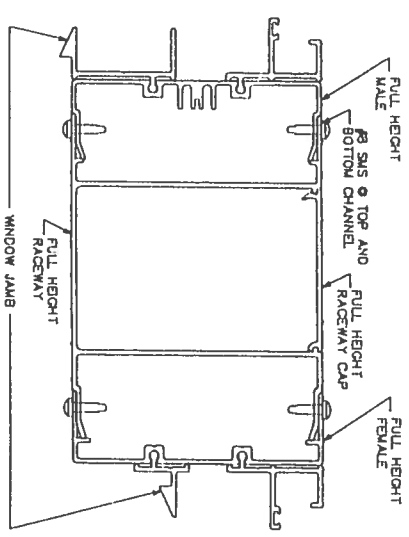

1/2\"/>

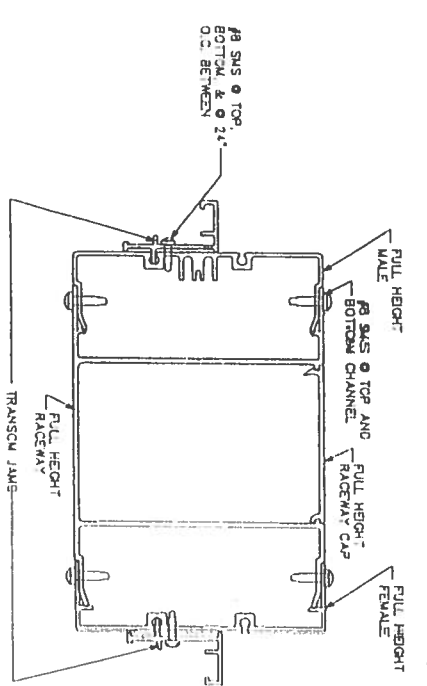

1/2\"/>

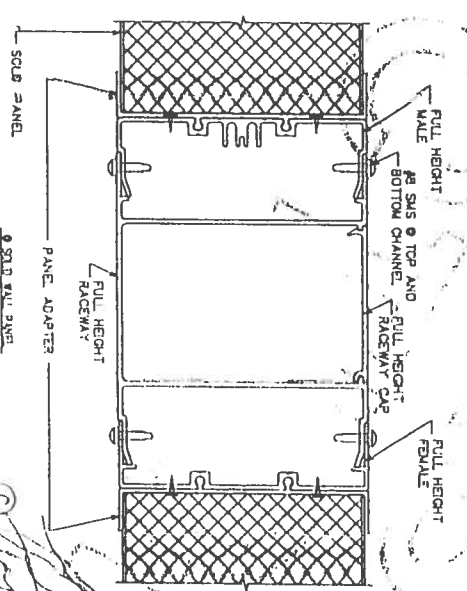

1/2\"/>

CONNECTION TO HOUSE

(E)

MALE/RACEWAY/FEMALE WALL UNITS

1/2\"/>

3.625" SUNROOM
SYSTEM WALL
DETAILS

Temo Inc.

20400 HALL ROAD • CLINTON TOWNSHIP • MICHIGAN 48038
586-286-0410 1-800-344-8368 FAX 586-226-1703

WHERE REQUIRED THESE PLANS HAVE BEEN
SIGNED AND SEALED BY A PROFESSIONAL
ENGINEER. ONLY AN ORIGINAL SIGNATURE
WITH A RED WET STAMP OR AN EMBOSSED
SEAL INDICATE THE VALIDITY OF THAT
SIGNATURE.

TEMO, INC. MAINTAINS THE REPORTS
LISTED ACROSS THE TOP OF THE
COVER SHEET. PLEASE REFER TO
THE NOTES ON PAGE 4TES2 FOR
ANY ADDITIONAL INFORMATION
CONCERNING THESE REPORTS.

VOID IF SUBMITTED
DECEMBER 31,

DATE
MAY 13, 2008
ROBERT A. WALL, P.E.
CLINTON TWP., MI
LICENSE P.E.-004456

4TEM03
3/3/5

#12x4" SMS W/3/4" O.D. ALUMINUM WASHER & NEOPRENE INSERT SPACED @ 6" O.C.

#3 TEK SCREENS EACH SIDE OF MULLION @ 130 MPH WIND SPEEDS

CONTINUOUS PANEL GUTTER W/#8 SMS @ 12" O.C. TOP & BOTTOM TO ROOF PANEL

BASE/WALL CAP

TOP EXPANDER SHALL BEAR FIRMLY ON MULLION SECTION PRIOR TO INSTALLATION OF FASTENERS

1/4" EXPANSION ANCHORS @ 130 MPH WIND SPEEDS LOCATE 1-ANCHOR 2 1/4" EACH SIDE OF MULLION AND AT 16" O.C. BETWEEN EACH MULLION.

BASE/WALL CAP SAME AS BEARING EXPANDER TO MULLION

BASE/WALL CAP SPICE TO BE 8" MINIMUM FROM VERTICAL MULLION EXIST. OR NEW CONCRETE SLAB IN GOOD CONDITION

PIERS OR FOOTINGS PER LOCAL CODE.

1" MIN. @ 1/4" ANCHORS

1 1/2" MIN.
3 1/2" MIN.

18" TYPICAL LOWER SECTION

4'-4" MINIMUM OPENING

UPPER TRANSOM

HEIGHT VARIES SEE CALCULATIONS ON DRAWING NO. 4TCS5

BEARING WALL SECTION

J

@ 130 MPH WIND SPEEDS LOCATE 1-ANCHOR 2 1/4" EACH SIDE OF MULLION AND AT 16" O.C. BETWEEN EACH MULLION.

BASE/WALL CAP SAME AS BEARING EXPANDER TO MULLION

BASE/WALL CAP SPICE TO BE 8" MINIMUM FROM VERTICAL MULLION ISOLATED STRUCTURAL CEILING PANELS ALUM. FLASHING

PIERS WITH THE DOWNS PER LOCAL CODE

BEARING WALL SECTION ON TENO NEER APPROVED DECK PANELS

J1

1/4" x 3" LONG LAG BOLTS @ 130 MPH WIND SPEEDS LOCATE 1-ANCHOR 2 1/4" EACH SIDE OF MULLION AND AT 16" O.C. BETWEEN EACH MULLION.

BASE/WALL CAP SAME AS BEARING EXPANDER TO MULLION

BASE/WALL CAP SPICE TO BE 8" MINIMUM FROM VERTICAL MULLION EXIST. OR NEW WOOD CEILING IN GOOD CONDITION ALUM. FLASHING

PIERS WITH THE DOWNS PER LOCAL CODE

BEARING WALL SECTION ON WOOD DECK

J2

1/4" EXPANSION ANCHORS @ 130 MPH WIND SPEEDS LOCATE 1-ANCHOR 2 1/4" EACH SIDE OF MULLION AND AT 16" O.C. BETWEEN EACH MULLION.

BASE/WALL CAP SAME AS BEARING EXPANDER TO MULLION

BASE/WALL CAP SPICE TO BE 8" MINIMUM FROM VERTICAL MULLION EXIST. OR NEW CONCRETE SLAB IN GOOD CONDITION

PIERS OR FOOTINGS PER LOCAL CODE

1-1/2" MIN.
3 1/2" MIN.

BEARING WALL SECTION ON CONCRETE SLAB

J3

1-1/2" MIN.
3 1/2" MIN.

[Signature]
SEAL
05/15/06

3.625" SUNROOM CROSS SECTION AND ATTACHMENT DETAILS

Temo Inc.

29100 HALL ROAD • PLINTON TOWNSHIP • HUNTSVILLE 47104
586-286-0410 1-800-344-8368 FAX 586-226-1703

WHERE REQUIRED THESE PLANS HAVE BEEN SIGNED AND SEALED BY A PROFESSIONAL ENGINEER. ONLY AN ORIGINAL SIGNATURE WITH A RED INK STAMP OR AN EMBOSSED SEAL INDICATE THE VALIDITY OF THAT SIGNATURE.

TEMO, INC. MAINTAINS THE REPORTS LISTED ACROSS THE TOP OF THE COVER SHEET. PLEASE REFER TO THE NOTES ON PAGE 4TCS2 FOR ANY ADDITIONAL INFORMATION CONCERNING THESE REPORTS.

VOID IF SUBMITTED DECEMBER 31,

DATE MAY 15, 2006
ROBERT A. WALL, P.E.
PROF. WALL, INC.
DESIGNER
4TCS2
4TCS2

Wind Speed (80,90,100,110,120,130,140,150)
Exposure (B,C,D)
Calculated Wind Pressure


Male-Female Mullion



Male-Stud-Female Mullion



Male-Raceway-Female Multillion

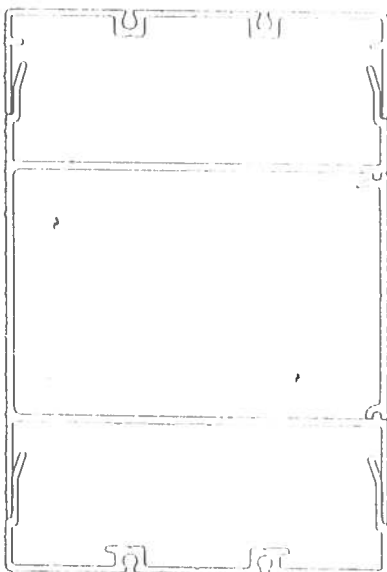

Maximum Mullion Height (ft)

8

Centroid (in)	1.8282
Moment of Inertia (in ⁴)	1.3283
Section Modulus (in ³)	0.7266
Calculated Moment (lb*in)	12960
Allowable Fb (psi)	21000
Calculated fb	17837

Maximum Mullion Height (ft)

二

Centroid (in)	1.8264
Moment of Inertia (in ⁴)	2.4763
Section IModulus (in ³)	1.3558
Calculated Moment (lb*in)	24502.5
Allowable Fb (psi)	21000
Calculated fb	18072

Maximum Mullion Height (ft)

14

Centroid (in)	1.8502
Moment of Inertia (in ⁴)	3.7152
Section Modulus (in ³)	2.0080
Calculated Moment (lb*in)	39690
Allowable Fb (psi)	21000
Calculated fb	19766

Section OK

Section OK

Section OK

[Signature]

\\temocad\e-root\11x17-2006\4TMD0520C613GMPHWIND

TEMO, INC. MAINTAINS THE REPORTS
LISTED ACTIVITY ON TOP OF THE
COVER SHEET. PLEASE REFER TO
THE NOTES ON PAGE 47LS2 FOR
ANY ADDITIONAL INFORMATION
CONCERNING THESE REPORTS.

WHERE REQUIRED THESE PLANS HAVE BEEN
SIGNED AND SEALED BY A PROFESSIONAL
ENGINEER OR AN ORIGINAL SIGNATURE
WITH A RED HOT STAMP OR AN EMBOSSED
SEAL INDICATE THE VALIDITY OF THAT
SIGNATURE.

Temo Inc.

20400 HALL ROAD • CLINTON TOWNSHIP • MICHIGAN 48038
586-286-0410 1-800-344-8366 FAX 586-228-1703

3.675" SUNROOM WIND CALCULATIONS

DATE: MAY 21, 2004
ROBERT A. WALZ, PE
23404 HALL ROAD
CLINTON TWP., MI
48035-9000
Phone: 313-484-4566

4T1EMOS