

COLUMBIA COUNTY PERMIT WORKSHEET

page 1 of 2


These worksheets must be completed and signed by the installer.
Submit the originals with the packet.

Installer F. Wholesale Homes License # DH1016037
911 Address where home is being installed HIS SW Newton Cir
Manufacturer Will Length x width 24x56

NOTE: if home is a single wide fill out one half of the blocking plan
if home is a triple or quad wide sketch in remainder of home

I understand Lateral Arm Systems cannot be used on any home (new or used)
where the sidewall ties exceed 5 ft 4 in.

Installer's initials SPR

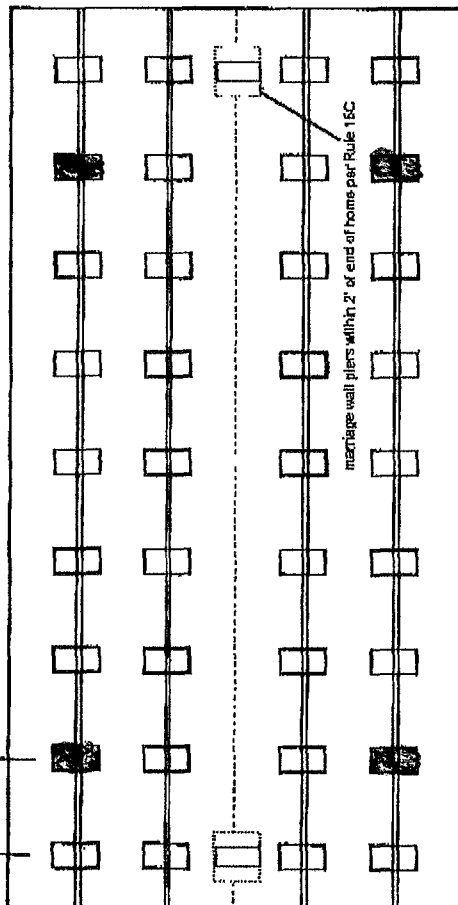

New Home ☐ Used Home ☒
Home installed to the Manufacturer's Installation Manual ☐
Home is installed in accordance with Rule 15-C ☒
Single wide ☐ Wind Zone II ☒ Wind Zone III ☐
Double wide ☒ Installation Decal # 12296
Triple/Quad ☐ Serial # 6256A5A011594A43
N 166 49 A 4 B 713

PIER SPACING TABLE FOR USED HOMES

Load bearing capacity	Footer size (sq in)	16" x 16" (256)	18 1/2" x 18 1/2" (342)	20" x 20" (400)	22" x 22" (484)	24" x 24" (576)
1000 psf	3'	4'	5'	6'	7'	8'
1500 psf	4'	5'	6'	7'	8'	9'
2000 psf	5'	6'	7'	8'	9'	10'
2500 psf	6'	7'	8'	9'	10'	11'
3000 psf	7'	8'	9'	10'	11'	12'
3500 psf	8'	9'	10'	11'	12'	13'

* Interpolated from Rule 15C-1 pier spacing table.

PIER PAD SIZES

I-beam pier pad size 23x31

Perimeter pier pad size 26x20

Other pier pad sizes (required by the mfg.) NA

Draw the approximate locations of marriage wall openings 4 foot or greater. Use this symbol to show the piers.

List all marriage wall openings greater than 4 foot and their pier pad sizes below

Opening 8' Pier pad size 23x31

POPULAR PAD SIZES

Pad Size	Sq In
16 x 16	256
16 x 18	288
18.5 x 18.5	342
16 x 22.5	360
17 x 22	374
13 1/4 x 26 1/4	348
20 x 20	400
17 3/16 x 25 3/16	441
17 1/2 x 25 1/2	446
24 x 24	576
26 x 26	676

ANCHORS

4 ft 5 ft

FRAME TIES

within 2' of end of home spaced at 5' 4" oc

TIEDOWN COMPONENTS

OTHER TIES

Longitudinal Stabilizing Device (LSD)
Manufacturer OLIVER TRUCKS
Longitudinal Stabilizing Device w/ Lateral Arms
Manufacturer
Sidewall Longitudinal Marriage wall Shearwall
Number 4 3

COLUMBIA COUNTY PERMIT WORKSHEET

page 2 of 2

POCKET PENETROMETER TEST

The pocket penetrometer tests are rounded down to _____ psf or check here to declare 1000 lb. soil ☒ without testing.

X _____ X _____ X _____

POCKET PENETROMETER TESTING METHOD

- 1 Test the perimeter of the home at 6 locations
- 2 Take the reading at the depth of the footer
3. Using 500 lb. increments, take the lowest reading and round down to that increment.

X _____ X _____ X _____

TORQUE PROBE TEST

The results of the torque probe test is _____ inch pounds or check here if you are declaring 5' anchors without testing _____. A test showing 275 inch pounds or less will require 5 foot anchors

Note: A state approved lateral arm system is being used and 4 ft anchors are allowed at the sidewall locations. I understand 5 ft anchors are required at all centerline tie points where the torque test reading is 275 or less and where the mobile home manufacturer may require anchors with 4000 lb. holding capacity.

Installer's initials

ALL TESTS MUST BE PERFORMED BY A LICENSED INSTALLER

Installer Name

Jack R. Flowers

Date Tested

Electrical

Connect electrical conductors between multi-wide units, but not to the major power source. This includes the bonding wire between multi-wide units. Pg ☒

Plumbing

Connect all sewer drains to an existing sewer tap or septic tank. Pg _____

Connect all potable water supply piping to an existing water meter, water tap, or other independent water supply systems. Pg ☒

Site Preparation

Debris and organic material removed yes
Water drainage Natural _____ Swale _____ Pad ☒ Other _____

Fastering multi wide units

Floor Type Fastener lags Length: 6" Spacing: 24"
Walls Type Fastener lags Length: 6" Spacing: 24"
Roof Type Fastener lags Length: 8" Spacing: 24"
For used homes a min 30 gauge, 8" wide, galvanized metal strip will be centered over the peak of the roof and fastened with galv roofing nails at 2" on center on both sides of the centerline.

Gasket (weatherproofing requirement)

I understand a properly installed gasket is a requirement of all new and used homes and that condensation, mold, mildew and buckled marriage walls are a result of a poorly installed or no gasket being installed. I understand a strip of tape will not serve as a gasket.

Installer's Initials

GRJ

Type gasket foam

Installed

Between Floors Yes ☒

Between Walls Yes ☒

Bottom of ridgebeam Yes ☒

Weatherproofing

The bottomboard will be repaired and/or taped. Yes ☒ Pg _____
Siding on units is installed to manufacturer's specifications. Yes ☒ Pg _____
Fireplace chimney installed so as not to allow intrusion of rain water Yes ☒

Miscellaneous

Skirting to be installed. Yes ☒ No _____
Dryer vent installed outside of skirting Yes ☒ N/A _____
Range downflow vent installed outside of skirting. Yes ☒ N/A _____
Drain lines supported at 4 foot intervals. Yes ☒ _____
Electrical crossovers protected. Yes ☒ _____
Other: _____

Installer verifies all information given with this permit worksheet is accurate and true based on the

Installer Signature

Jack R. Flowers Date 3-05-14