

# COLUMBIA COUNTY PERMIT WORKSHEET

page 1 of 2

These worksheets must be completed and signed by the Installer.  
Submit the originals with the packet.

Installer Andy Hall License # TH102505

911 Address where home is being installed  
511 NEW RIVERS Lane  
Lake City, FL 32055

Manufacturer

Live Oak


Length x width 28 x 68

NOTE:

*If home is a single wide fill out one half of the blocking plan  
If home is a triple or quad wide's sketch in remainder of home*

I understand Lateral Arm Systems cannot be used on any home (new or used) where the sidewall ties exceed 5 ft 4 in.

Installer's initials AH

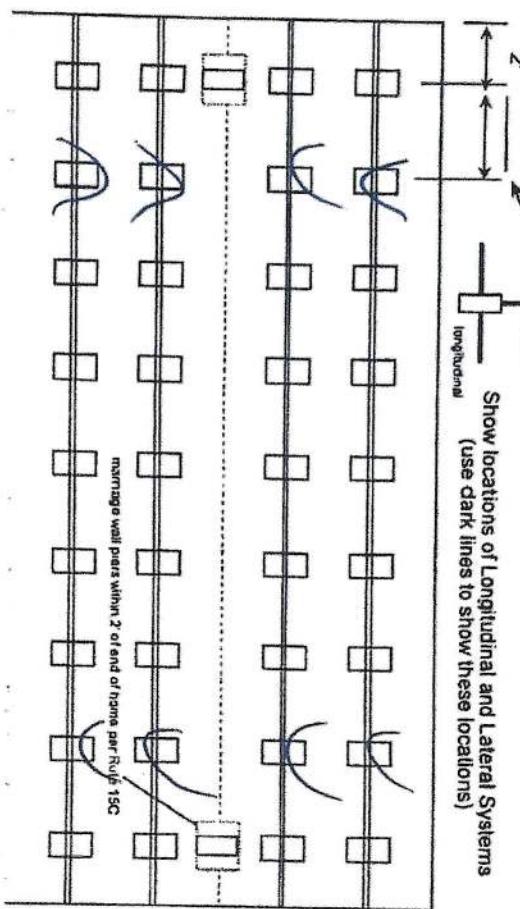

PIER SPACING TABLE FOR USED HOMES						
Load bearing capacity	Footer size (sq in)	16" x 16"	18 1/2" x 18	20" x 20"	22" x 22"	24" x 24"
1000 psf	3'	4'	5'	6'	7'	8'
1500 psf	4' 6"	6'	7'	8'	9'	8'
2000 psf	5'	8'	8'	8'	8'	8'
2500 psf	7 5/8"	8'	8'	8'	8'	8'
3000 psf	8'	8'	8'	8'	8'	8'
3500 psf	8'	8'	8'	8'	8'	8'

\* Interpolated from Rule 15C-1 pier spacing table.

## PIER PAD SIZES

I-beam pier pad size 24 x 24

Perimeter pier pad size 24 x 24

Other pier pad sizes (required by the mfg.)

Draw the approximate locations of marriage wall openings 4 foot or greater. Use this symbol to show the piers.

List all marriage wall openings greater than 4 foot and their pier pad sizes below.

Opening

Pier pad size

4 ft

5 ft

## FRAME TIES

Within 2' of end of home Spaced at 5 1/4" oc

## TIEDOWN COMPONENTS

Longitudinal Stabilizing Device (LSD)  
Manufacturer Live Oak

Longitudinal/ Stabilizing Device w/ Lateral Arms  
Manufacturer Live Oak

Sidewall

Longitudinal

Marriage wall

## OTHER TIES

Number

Shearwall

New Home  Used Home   
Home installed to the Manufacturer's Installation Manual   
Home is installed in accordance with Rule 15-C

Single wide  Wind Zone II  Wind Zone III

Double wide  Installation Decal # FLTHLCT282176-4827AB  
Triple/Quad  Serial # FLTHLCT282176-4827AB

# COLUMBIA COUNTY PERMIT WORKSHEET

page 2 of 2

## POCKET PENETROMETER TEST

The pocket penetrometer tests are rounded down to \_\_\_\_\_ psf  
or check here to declare 1000 lb. soil \_\_\_\_\_ without testing.

1500

1500

1500

### POCKET PENETROMETER TESTING METHOD

1. Test the perimeter of the home at 6 locations.
2. Take the reading at the depth of the footer.
3. Using 500 lb. increments, take the lowest reading and round down to that increment.

1500

1500

1500

## TORQUE PROBE TEST

The results of the torque probe test is 375 inch pounds or check here if you are declaring 5 anchors without testing \_\_\_\_\_. A test showing 275 inch pounds or less will require 5 foot anchors.

Note: A state approved lateral arm system is being used and 4 ft. anchors are allowed at the sidewall locations. I understand 5 ft anchors are required at all centerline tie points where the torque test reading is 275 or less and where the mobile home manufacturer may require anchors with 400 lb holding capacity.

AH Installer's initials

## ALL TESTS MUST BE PERFORMED BY A LICENSED INSTALLER

Installer Name \_\_\_\_\_

Date Tested \_\_\_\_\_

Electrical

Connect electrical conductors between multi-wide units, but not to the main power source. This includes the bonding wire between multi-wide units. Pg. \_\_\_\_\_

Plumbing

Connect all sewer drains to an existing sewer tap or septic tank. Pg. \_\_\_\_\_

Connect all potable water supply piping to an existing water meter, water tap, or other independent water supply systems. Pg. \_\_\_\_\_

## Site Preparation

Debris and organic material removed \_\_\_\_\_  
Water drainage: Natural \_\_\_\_\_ Swale \_\_\_\_\_ Pad  Other \_\_\_\_\_

Fastening multi-wide units  
Floor: Type Fastener: Lag Length: 6" Spacing: 12" on  
Walls: Type Fastener: Lag Length: 6" Spacing: 12" on  
Roof: Type Fastener: Lag Length: 6" Spacing: 12" on  
For used homes a min. 30 gauge, 8" wide, galvanized metal strip will be centered over the peak of the roof and fastened with galv. roofing nails at 2" on center on both sides of the centerline.

## Gasket (weatherproofing requirement)

I understand a properly installed gasket is a requirement of all new and used homes and that condensation, mold, mildew and buckled marriage walls are a result of a poorly installed or no gasket being installed. I understand a strip of tape will not serve as a gasket.

Installer's initials AH

Type gasket: Form Pg. 03

Installed:  
Between Floors Yes \_\_\_\_\_  
Between Walls Yes \_\_\_\_\_ Pg. \_\_\_\_\_  
Bottom of ridgebeam Yes \_\_\_\_\_

## Weatherproofing

The bottomboard will be repaired and/or taped. Yes  Pg. \_\_\_\_\_  
Siding on units is installed to manufacturer's specifications. Yes  Pg. \_\_\_\_\_  
Fireplace chimney installed so as not to allow intrusion of rain water. Yes AH

## Miscellaneous


Skirting to be installed. Yes \_\_\_\_\_ No \_\_\_\_\_  
Dryer vent installed outside of skirting. Yes \_\_\_\_\_ N/A \_\_\_\_\_  
Range downflow vent installed outside of skirting. Yes \_\_\_\_\_ N/A \_\_\_\_\_  
Drain lines supported at 4 foot intervals. Yes \_\_\_\_\_ N/A \_\_\_\_\_  
Electrical crossovers protected. Yes \_\_\_\_\_  
Other: \_\_\_\_\_

Installer verifies all information given with this permit worksheet  
is accurate and true based on the

Installer Signature John Hall Date 10-8-25



51 50 49 48 47 46 45 44 43 42 41 40 39 38 37 36 35 34 33 32 31 30 29 28 27 26 25 24 23 22 21 20 19 18 17 16 15 14 13 12 11 10 9 8 7 6 5 4 3 2 1 24" O.C.

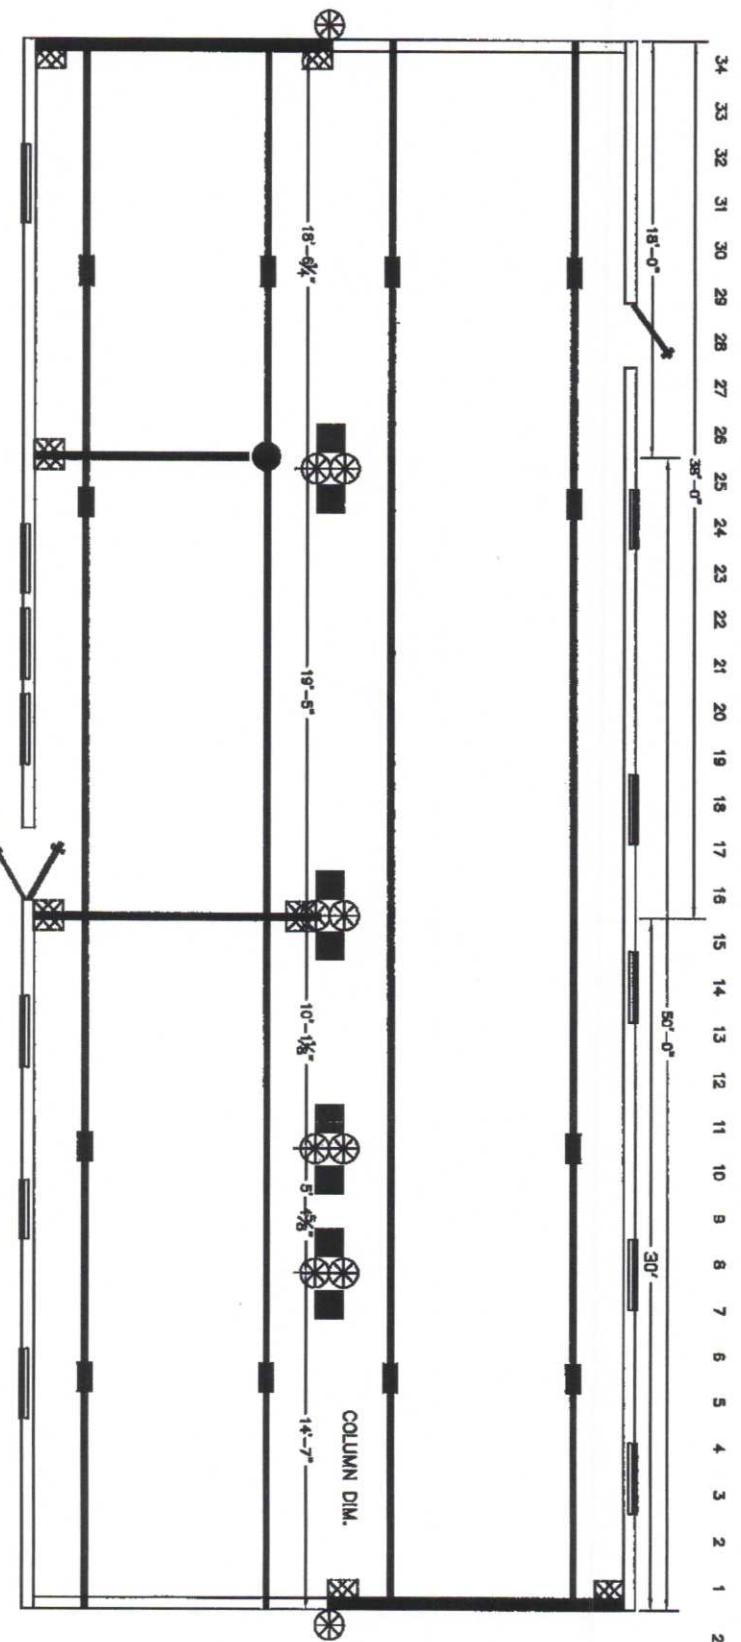

TownHomes  
P.O. Box 1059  
LAKE CITY, FLORIDA  
32056

WALLS - FLOORING - ROOFING - EXTERIOR FINISHES

Date:	Revisions	Code#:
8-12-24		28217-A
Dr'n:	DC	
Parent:	NEW	
Code:	T (24)	
Zone:	2	Model: 28217-679
		Print: FLORIDA BLOCKING PLAN

	I-BEAM BLOCKING
	SEE SOIL BEARING CAPACITY CHARTS FOR SPACING
	COLUMN BLOCKING
	SEE SOIL BEARING CAPACITY CHARTS FOR PAD SIZE
	SHEARWALL FRAME TIE
	CENTER LINE TIES
	VERTICAL TIE
	MAX. SPACING 5'-4" CENTER TO CENTER
	LONGITUDINAL TIES