

COLUMBIA COUNTY PERMIT WORKSHEET

page 1 of 2

These worksheets must be completed and signed by the installer.
Submit the originals with the packet.Installer Dale Houston License # IK1826142

311 Address where

home is being installed. SW Piedmont RoadLake City FL 32024

Manufacturer

Liberty

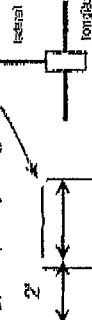
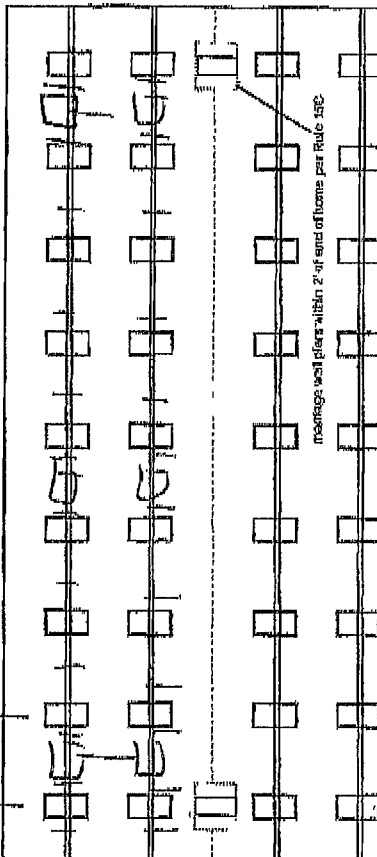
Length x width

60X12NOTE: If home is a single wide fill out one half of the blocking plan
If home is a triple or quad wide sketch in remainder of homeI understand Lateral Arm Systems cannot be used on any home (new or used)
where the sidewall lies exceed 5 ft 4 in.

Installer's Initials

DH

Typical pier spacing

Show locations of Longitudinal and Lateral Systems
(use dark lines to show these locations)

Markings wall piers within 2' of end of home per Rule 15C

12X60 = 1000000 17X15
Pier 2x4x5ft alc
Anchor 12x4 5/401c
2 Longitudinal Syst

New Home ☐ Used Home ☒Home installed to the Manufacturer's Installation Manual ☐Home is installed in accordance with Rule 15-C ☒Single wide ☒Wind Zone II ☒Wind Zone III ☐Double wide ☐Installation Decal # 18904Triple/Quad ☐Serial # 10617741

PIER SPACING TABLE FOR USED HOMES

Load bearing capacity	Footer size (sq ft)	16" x 16" (256)	18 1/2" x 18 1/2" (342)	20 1/2" x 20 1/2" (420)	22" x 22" (484)	24" x 24" (576)	26" x 26" (676)
1000 psf	3'	3'	3'	3'	3'	3'	3'
1500 psf	4' 6"	4' 6"	4' 6"	4' 6"	4' 6"	4' 6"	4' 6"
2000 psf	6'	6'	6'	6'	6'	6'	6'
2500 psf	7' 6"	7' 6"	7' 6"	7' 6"	7' 6"	7' 6"	7' 6"
3000 psf	8'	8'	8'	8'	8'	8'	8'
3500 psf	8'	8'	8'	8'	8'	8'	8'

* Interpolated from Rule 15C-1 pier spacing table.

PIER PAD SIZES

I-beam pier pad size 17x25Perimeter pier pad size 16X16

Other pier pad sizes required by the mfg. _____

Draw the approximate locations of marriage wall openings 4 foot or greater. Use this symbol to show the piers.

List all marriage wall openings greater than 4 foot and their pier pad sizes below

Opening

Pier pad size

4 ft 5 ft

FRAME TIES

within 2' of end of home spaced at 5' 4" on center

OTHER TIES

Number 24

Sidewall 2

Longitudinal 2

Marriage wall 2

Shearwall 2

TIEDOWN COMPONENTS

☒ Longitudinal Stabilizing Device (LSD)

Manufacturer OLDS

Longitudinal Stabilizing Device w/ Lateral Arms

Manufacturer _____

COLUMBIA COUNTY PERMIT WORKSHEET

page 2 of 2

POCKET PENETROMETER TEST

The pocket penetrometer tests are rounded down to _____ psf
or check here to declare 1000 lb. soil _____ without testing.

X

X

10000

POCKET PENETROMETER TESTING METHOD

1. Test the penetrometer of the home at 6 locations.
2. Take the reading at the depth of the footer.
3. Using 500 lb. increments, take the lowest reading and round down to that increment.

X

X

X

TORQUE PROBE TEST

The results of the torque probe test is 280 inch pounds or check here if you are declaring 5' anchors without testing. A test showing 275 inch pounds or less will require 5 foot anchors.

Note: A state approved lateral arm system is being used and 4 ft. anchors are allowed at the sidewall locations. I understand 5 ft anchors are required at all centerline tie points where the torque test reading is 275 or less and where the mobile home manufacturer may require anchors with 4000 lb. holding capacity.

8 ft

installer's initials

ALL TESTS MUST BE PERFORMED BY A LICENSED INSTALLER

Installer Name

Dale Houston

Date Tested

1-21-14

Electrical

Connect electrical conduits between multi-wide units, but not to the main power source. This includes the bonding wire between multi-wide units. Pg. N/A

Plumbing

Connect all sewer drains to an existing sewer tap or septic tank. Pg. N/A

Connect all potable water supply piping to an existing water meter, water tap, or other independent water supply systems. Pg. N/A

Site Preparation

Debris and organic material removed ☒
Water drainage: Natural ☒ Swale ☐ Pad ☐ Other ☐

Fastening multi-wide units

Floor: Type Fastener: _____ Length: _____ Sealing: _____
Walls: Type Fastener: _____ Length: _____ Sealing: _____
Roof: Type Fastener: _____ Length: _____ Sealing: _____
For used homes a min. 30 gauge, 8" wide, galvanized metal strip will be centered over the peak of the roof and fastened with gable roofing nails at 2" on center on both sides of the centerline.

Gasket (see manufacturer's requirements)

I understand a properly installed gasket is a requirement of all new and used homes and that condensation, mold, mildew and buckled marriage walls are a result of a poorly installed or no gasket being installed. I understand a strip of tape will not serve as a gasket.

Installer's initials

N/A

Type gasket

Pg. N/A

Installed

Between Floors Yes

N/A

Between Walls Yes

N/A

Bottom of ridgebeam Yes

N/A

Weatherproofing

The bottomboard will be repaired and/or taped Yes ☒
Siding on units is installed to manufacturer's specifications. Yes ☒
Fireplace chimney installed so as not to allow intrusion of rain water. Yes ☒

Miscellaneous

Skirting to be installed. Yes ☒ No ☐
Dryer vent installed outside of skirting. Yes ☒ N/A ☐
Range downflow vent installed outside of skirting. Yes ☒ N/A ☐
Drain lines supported at 4 foot intervals. Yes ☒
Electrical crossovers protected. Yes ☒
Other ☐

Installer verifies all information given with this permit worksheet
is accurate and true based on the

Installer Signature Dale Houston Date