

PERMIT WORKSHEET

page 1 of 2

PERMIT NUMBER

Installer Ernest S Johnson License # 14-1025249


Address of home being installed 139 SE SEAWOLF WAY

Manufacturer Nobility Length x width 76' X 28'

NOTE: if home is a single wide fill out one half of the blocking plan
if home is a triple or quad wide sketch in remainder of home

I understand Lateral Arm Systems cannot be used on any home (new or used)
where the sidewall ties exceed 5 ft 4 in

Installer's initials eg

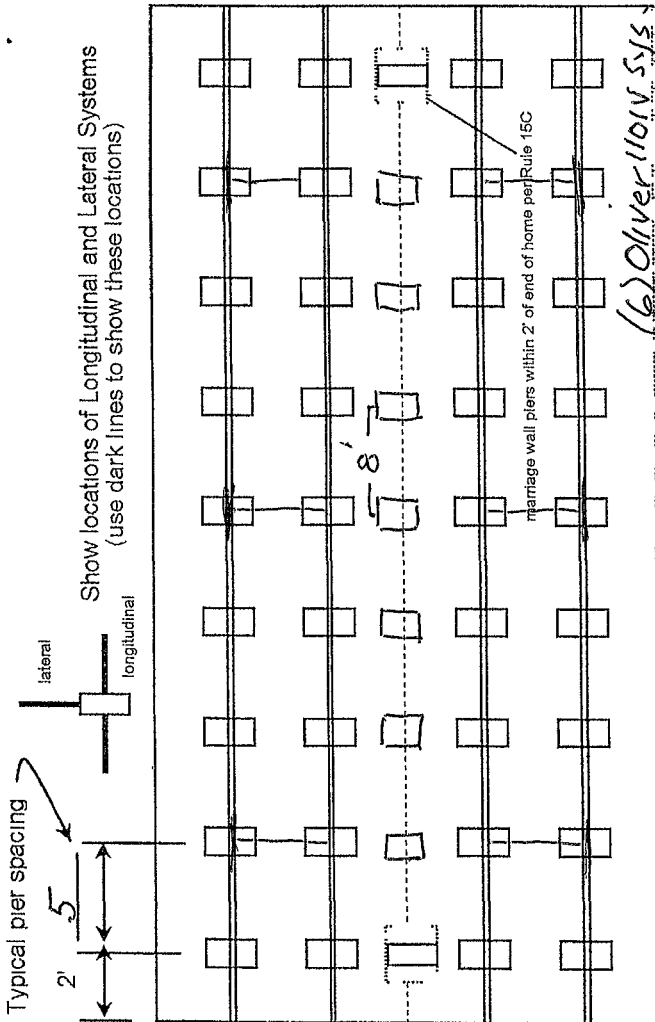

ALL PIER SIZES: 17 1/2 X 25 1/2

New Home ☐ Used Home ☒
Home installed to the Manufacturer's Installation Manual ☐
Home is installed in accordance with Rule 15-C ☒
Single wide ☐ Wind Zone II ☒ Wind Zone III ☐
Double wide ☒ Installation Decal # 20395
Triple/Quad ☐ Serial # 6086234 608624

PIER SPACING TABLE FOR USED HOMES

Load bearing capacity	Footer size (sq in)	16" x 16" (256)	18 1/2" x 18 1/2" (342)	20" x 20" (400)	22" x 22" (484)*	24" x 24" (576)*	26" x 26" (676)
1000 psf	3'	3'	4'	5'	6'	7'	8'
1500 psf	4' 6"	4' 6"	6'	7'	8'	8'	8'
2000 psf	6'	6'	8'	8'	8'	8'	8'
2500 psf	7' 6"	7' 6"	8'	8'	8'	8'	8'
3000 psf	8'	8'	8'	8'	8'	8'	8'
3500 psf	8'	8'	8'	8'	8'	8'	8'

* interpolated from Rule 15C-1 pier spacing table.

PIER PAD SIZES

I-beam pier pad size 17 1/2 X 25 1/2

Perimeter pier pad size —

Other pier pad sizes (required by the mfg) —

Draw the approximate locations of marriage wall openings 4 foot or greater Use this symbol to show the piers

List all marriage wall openings greater than 4 foot and their pier pad sizes below

Opening 8' c/c Pier pad size 17 1/2 X 25 1/2 X 2

ANCHORS

4 ft ☒ 5 ft ☒

FRAME TIES

within 2' of end of home spaced at 5' 4" oc

TIEDOWN COMPONENTS

Longitudinal Stabilizing Device (LSD)

Manufacturer

Longitudinal Stabilizing Device w/ Lateral Arms

Manufacturer Driver Technologies

OTHER TIES

Number

Sidewall

Longitudinal

Marriage wall

Shearwall

28

6

3-5

2

PERMIT NUMBER

POCKET PENETROMETER TEST

The pocket penetrometer tests are rounded down to psf or check here to declare 1000 lb soil without testing

X X X

POCKET PENETROMETER TESTING METHOD

- 1 Test the perimeter of the home at 6 locations
- 2 Take the reading at the depth of the footer
- 3 Using 500 lb. increments, take the lowest reading and round down to that increment

Assume 1000 lb

X X X

TORQUE PROBE TEST

The results of the torque probe test is inch pounds or check here if you are declaring 5' anchors without testing. A test showing 275 inch pounds or less will require 4 foot anchors.

Note: A state approved lateral arm system is being used and 4 ft anchors are allowed at the sidewall locations. I understand 5 ft anchors are required at all centerline tie points where the torque test reading is 275 or less and where the mobile home manufacturer may require anchors with 4000 lb holding capacity.

Assume 2000 lb

eg Installer's initials

ALL TESTS MUST BE PERFORMED BY A LICENSED INSTALLER

Installer Name

Date Tested

Electrical

connect electrical conductors between multi-wide units, but not to the main power source This includes the bonding wire between multi-wide units Pg 15

Plumbing

connect all sewer drains to an existing sewer tap or septic tank Pg 15

connect all potable water supply piping to an existing water meter, water tap, or other dependent water supply systems. Pg. 15

Site Preparation

Debris and organic material removed
Water drainage Natural ☒ Swale ☐ Pad ☒ Other ☐

Fastening multi wide units

Floor: Type Fastener L29 Length 5" Spacing 2"
Walls: Type Fastener " Length " Spacing "
Roof: Type Fastener " Length " Spacing "
For used homes a min 30 gauge, 8" wide, galvanized metal strip will be centered over the peak of the roof and fastened with galy roofing nails at 2" on center on both sides of the centerline

Gasket (weatherproofing requirement)

I understand a properly installed gasket is a requirement of all new and used homes and that condensation, mold, mildew and buckled marriage walls are a result of a poorly installed or no gasket being installed I understand a strip of tape will not serve as a gasket

Installer's initials eg

Type gasket Foam R-13
Pg 14

Installed.

Between Floors ☒
Between Walls ☒
Bottom of ridgebeam ☒

Weatherproofing

The bottomboard will be repaired and/or taped. ☒
Siding on units is installed to manufacturer's specifications ☒
Fireplace chimney installed so as not to allow intrusion of rain water ☒

Pg 19

Miscellaneous

Skirting to be installed. Yes ☒ No ☐
Dryer vent installed outside of skirting Yes ☒ N/A ☐
Range downflow vent installed outside of skirting Yes ☐
Drain lines supported at 4 foot intervals ☒
Electrical crossovers protected ☒
Other ☐

Installer verifies all information given with this permit worksheet is accurate and true based on the

Installer Signature Ernest L. Johnson Date 1-10-14