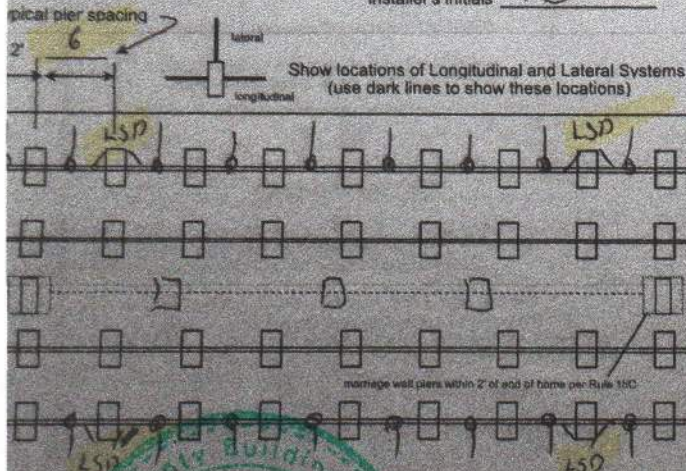


#63449

Mobile Home Permit Worksheet

Installer: Danipus Wilks License # IA1128217
 Address of home being installed: 246 NW McCALL
LAKE CITY FL 32055
 Manufacturer: Redman Length x width: 28 x 52

NOTE: if home is a single wide fill out one half of the blocking plan
 if home is a triple or quad wide sketch in remainder of home
 I understand Lateral Arm Systems cannot be used on any home (new or used)
 where the sidewall ties exceed 5 ft 4 in.

Installer's initials: R

Application Number: _____

Date: _____

New Home ☐ Used Home ☒Home installed to the Manufacturer's Installation Manual
 Home is installed in accordance with Rule 15-C ☒Single wide ☐ Wind Zone II ☒ Wind Zone III ☐Double wide ☐ Installation Decal # 96574Triple/Quad ☐ Serial # GBICS 92364A13

PIER SPACING TABLE FOR USED HOMES

Load bearing capacity	Footer size (sq in)	16' x 16" (256)	18 1/2" x 18 1/2" (342)	20' x 20" (400)	22' x 22" (484)*	24' x 24" (576)*	26' x 26" (676)
1000 psf	3'	3'	4'	5'	6'	7'	8'
1500 psf	4' 6"	4' 6"	6'	7'	8'	9'	10'
2000 psf	6'	6'	8'	9'	10'	11'	12'
2500 psf	7' 6"	7' 6"	9'	10'	11'	12'	13'
3000 psf	8'	8'	10'	11'	12'	13'	14'
3500 psf	8'	8'	10'	11'	12'	13'	14'

* Interpolated from Rule 15C-1 pier spacing table.

PIER PAD SIZES

I-beam pier pad size: 12x25Perimeter pier pad size: 14x16

Other pier pad sizes (required by the mfg.): _____

Draw the approximate locations of marriage wall openings 4 foot or greater. Use this symbol to show the piers.

List all marriage wall openings greater than 4 foot and their pier pad sizes below.

Opening: _____ Pier pad size: _____

Opening: _____ Pier pad size: _____

POPULAR PAD SIZES

Pad Size	Sq In
16 x 16	256
18 x 18	324
18.5 x 18.5	342
16 x 22.5	360
17 x 22	374
13 1/4 x 26 1/4	348
20 x 20	400
17 3/16 x 25 3/16	441
17 1/2 x 25 1/2	446
24 x 24	576
26 x 26	676

ANCHORS

4 ft 5 ft

FRAME TIES

within 2' of end of home spaced at 5' 4" oc

OTHER TIES

Number

Sidewall: _____
 Longitudinal: 20
 Marriage wall: _____
 Shearwall: _____

TIEDOWN COMPONENTS

Longitudinal Stabilizing Device (LSD)
 Manufacturer: _____
 Longitudinal Stabilizing Device w/ Lateral Arms
 Manufacturer: _____

Mobile Home Permit Worksheet

Application Number _____

Date _____

POCKET PENETROMETER TEST

The pocket penetrometer tests are rounded down to 1500 psf or check here to declare 1000 lb. soil without testing.

X 1500

X 1500

X 1500

POCKET PENETROMETER TESTING METHOD

1. Test the perimeter of the home at 6 locations.
2. Take the reading at the depth of the footer.
3. Using 500 lb. increments, take the lowest reading and round down to that increment.

X 1500

X 1500

X 1500

TORQUE PROBE TEST

The results of the torque probe test is 2500 inch pounds or check here if you are declaring 0" anchors without testing. A test showing 275 inch pounds or less will require 5 foot anchors.

Note: A state approved lateral arm system is being used and 4 ft. anchors are allowed at the sidewall locations. I understand 5 ft. anchors are required at all centerline tie points where the torque test reading is 275 or less and where the mobile home manufacturer may require anchors with 4000 lb. holding capacity.

Installer's initials _____

ALL TESTS MUST BE PERFORMED BY A LICENSED INSTALLER

Installer Name _____

Date Tested 11/15/23

Electrical

Connect electrical conductors between multi-wire units, but not to the main power source. This includes the bonding wire between multi-wire units. Pg. _____

Plumbing

Connect all sewer drains to an existing sewer tap or septic tank. Pg. _____

Connect all potable water supply piping to an existing water meter, water tap, or other independent water supply system. Pg. _____

Site Preparation

Debris and organic material removed Yes
Water drainage: Natural Swale Yes Yes Other

Fastening multi-wide units

For Type Fastener 1/2" Length 4" Spacing 24"
Weld Type Fastener 1/2" Length 4" Spacing 24"
Roof Type Fastener 1/2" Length 4" Spacing 24"
For used homes a min. 30 gauge, 8" wide, galvanized metal strip will be centered over the peak of the roof and fastened with self tapping nails at 2" on center on both sides of the centerline.

Gasket weatherstripping equipment

I understand a properly installed gasket is a requirement of all new and used homes and that condensation, mold, mildew and buckled marriage walls are a result of a poorly installed or no gasket being installed. I understand a strip of tape will not serve as a gasket.

Installer's initials _____

Installed:
Between Floors Yes Yes
Between Walls Yes Yes
Bottom of insulation Yes Yes

Weatherstripping

The bottomboard will be repaired and/or replaced. Yes Yes
Siding on units is installed to manufacturer's specifications. Yes
Fireplace chimney installed so as not to allow intrusion of rain water. Yes

Miscellaneous

Skirting to be installed. Yes Yes
Dryer vent installed outside of skirting. Yes Yes
Range downflow vent installed outside of skirting. Yes Yes
Drain lines supported at 4 foot intervals. Yes Yes
Electrical conduits protected. Yes Yes
Other _____

Installer verifies all information given with this permit worksheet is accurate and true based on the manufacturer's installation instructions and or Rule 15C-1 & 2

Installer Signature _____

Date 11/15/23