

# Cool and Cobb Engineering Company

---

Date: 11/21/2025 Project: 25-1414  
Job: Christy McDaniel  
Location: 4743 N US Hwy 441, Lake City, FL 32055

Re: Final "As Built" Certification

Permit Number: # 000054475

As of this date I have inspected the site records and approve the Installation on the above noted project. Cool and Cobb has not visited the site. The licensed foundation contractor has provided design compliance records including installation logs and digital visual records of the complete installation. I hereby approve the installation as being in accordance with the Florida Building Code 2023 8th Edition, and with the design completed and certified by Cool and Cobb Engineering Company for this project. This certification does not address any possible sinkhole activity as defined in Florida Statute § 627.706.

Sincerely,

11/21/2025

Kenneth F. Wheeler, P.E.  
State of Florida  
Professional Engineer No. 60417

This item has been digitally signed and sealed by Kenneth F. Wheeler, P.E. on the date adjacent to the seal.

Printed copies of this document are not considered signed and sealed and the signature must be verified on any electronic copies.

203 W. Main St.  
Avon Park, FL 33825  
Office: (863) 657-2323  
Fax: (863) 657-2324  
Email: Ken@coolandcobb.com

Contractor: **Solid Foundations**

As-Built

Permit #000054475

**Solid Foundations**  
1910 SW Main Blvd  
Lake City, FL 32025  
855-227-0300  
[www.solidfoundations.com](http://www.solidfoundations.com)



SF Representative: Jimbo Willis

Cell: 386-288-3240

Email: [Jimmie@solidfoundations.com](mailto:Jimmie@solidfoundations.com)

CONTRACT DATE: 10/6/2025

EMAIL: [mcrr.office@gmail.com](mailto:mcrr.office@gmail.com)


SUBMITTED TO: Christy

Phone: 386-361-0723

ADDRESS: 4743 N. US HWY 441

Lake City, FL 32055

**SISTER UPTO 10 2X8X12 FLOOR JOIST AS NEEDED**

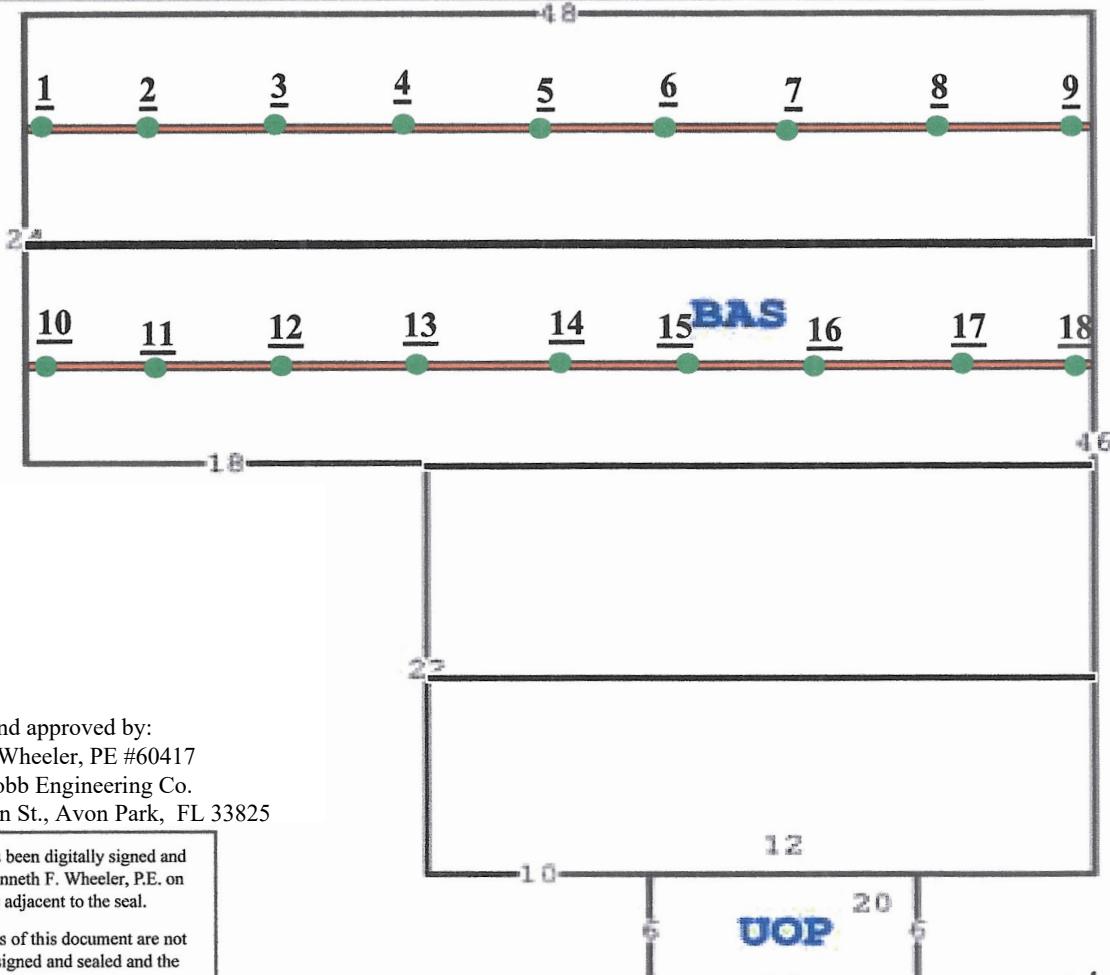

11/21/2025

Reviewed and approved by:  
Kenneth F. Wheeler, PE #60417  
Cool and Cobb Engineering Co.  
203 W. Main St., Avon Park, FL 33825

This item has been digitally signed and sealed by Kenneth F. Wheeler, P.E. on the date adjacent to the seal.

Printed copies of this document are not considered signed and sealed and the signature must be verified on any electronic copies.

I hereby certify that all work is true and correct in accordance with the design. *[Signature]* CEC # 25-1414

Push Pier Model 300:

Interior Pier:

NCFI-24-120

Push Pier Model 250:

Low Profile Bracket:

NCFI-24-010

Helical Pier:

Porch Bracket:

Existing Beams

Crawl Space Pier:

4x6 Wood Beam:

Floor Joist: