
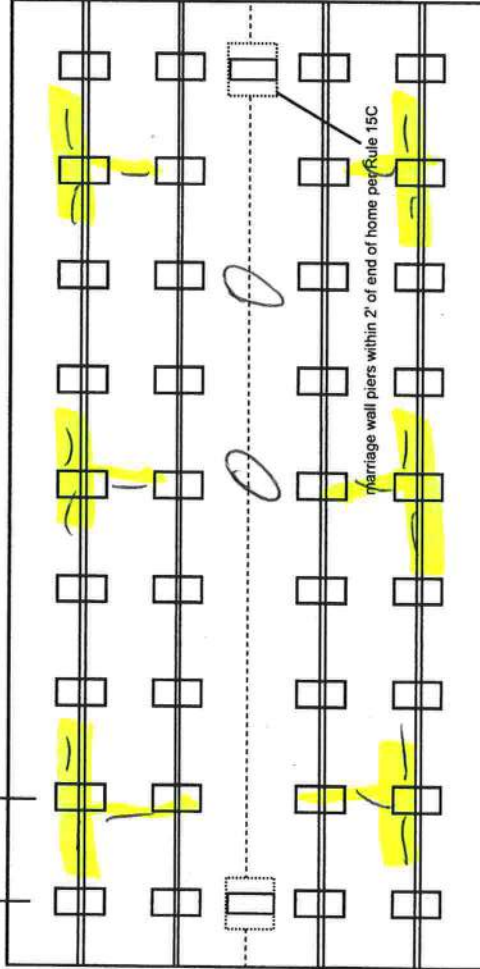


Mobile Home Permit Worksheet

Installer: SUSAN LaRica License # 1H1127039
 Address of home being installed: 1270 Drend Feagle Ave Ft White, FL
 Manufacturer: JACOBSSEN Length x width: 28x56

NOTE: if home is a single wide fill out one half of the blocking plan if home is a triple or quad wide sketch in remainder of home I understand Lateral Arm Systems cannot be used on any home (new or used) where the sidewall ties exceed 5 ft 4 in.

Installer's initials SL

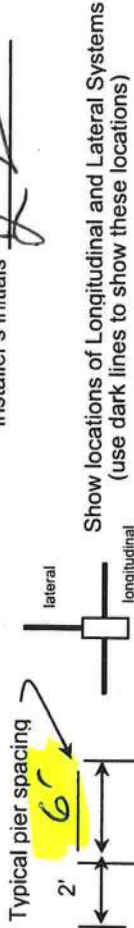

Application Number: _____

Date: _____

New Home ☒ Used Home ☐

Home installed to the Manufacturer's Installation Manual
 Home is installed in accordance with Rule 15-C

Single wide ☐ Wind Zone II ☐ Wind Zone III ☐

Double wide ☒ Installation Decal # 73113

Triple/Quad ☐ Serial # _____

PIER SPACING TABLE FOR USED HOMES

Load bearing capacity	Footer size (sq in)	16" x 16" (256)	18 1/2" x 18 1/2" (342)	20" x 20" (400)	22" x 22" (484)*	24" x 24" (576)*	26" x 26" (676)
1000 psf	3'	4'	5'	6'	7'	8'	8'
1500 psf	4'	5'	6'	7'	8'	8'	8'
2000 psf	6'	8'	8'	8'	8'	8'	8'
2500 psf	7'	8'	8'	8'	8'	8'	8'
3000 psf	8'	8'	8'	8'	8'	8'	8'
3500 psf	8'	8'	8'	8'	8'	8'	8'

* interpolated from Rule 15C-1 pier spacing table.

PIER PAD SIZES

I-beam pier pad size 24x24

Perimeter pier pad size _____

Other pier pad sizes (required by the mfg.) _____

Draw the approximate locations of marriage wall openings 4 foot or greater. Use this symbol to show the piers.

List all marriage wall openings greater than 4 foot and their pier pad sizes below.

Opening 1

Pier pad size 24x24

4 ft ☒ 5 ft

FRAME TIES

within 2' of end of home spaced at 5' 4" oc

TIEDOWN COMPONENTS

Longitudinal Stabilizing Device (LSD)

Manufacturer _____

Longitudinal Stabilizing Device w/ Lateral Arms

Manufacturer Oliver

OTHER TIES

Number _____

Sidewall _____

Longitudinal _____

Marriage wall _____

Shearwall _____

Mobile Home Permit Worksheet

Application Number: _____

Date: _____

POCKET PENETROMETER TEST

The pocket penetrometer tests are rounded down to _____ psf or check here to declare 1000 lb. soil _____ without testing.

X _____ X _____ X _____

POCKET PENETROMETER TESTING METHOD

1. Test the perimeter of the home at 6 locations.
2. Take the reading at the depth of the footer.
3. Using 500 lb. increments, take the lowest reading and round down to that increment.

X _____ X _____ X _____

TORQUE PROBE TEST

The results of the torque probe test is 295 inch pounds or check here if you are declaring 5' anchors without testing. A test showing 275 inch pounds or less will require 5 foot anchors.

Note: A state approved lateral arm system is being used and 4 ft. anchors are allowed at the sidewall locations. I understand 5 ft anchors are required at all centerline tie points where the torque test reading is 275 or less and where the mobile home manufacturer may require anchors with 4000 lb holding capacity.

Installer's initials

ALL TESTS MUST BE PERFORMED BY A LICENSED INSTALLER

Installer Name

Date Tested

Electrical

Connect electrical conductors between multi-wide units, but not to the main power source. This includes the bonding wire between multi-wide units. Pg.

Plumbing

Connect all sewer drains to an existing sewer tap or septic tank. Pg.

Connect all potable water supply piping to an existing water meter, water tap, or other independent water supply systems. Pg.

Site Preparation

Debris and organic material removed _____
Water drainage: Natural _____ Swale _____ Pad ☒ Other _____

Fastening multi wide units

Floor: Type Fastener: Lags Length: 6in Spacing: 12in
Walls: Type Fastener: screws Length: 6in Spacing: 12in
Roof: Type Fastener: Lags Length: 6in Spacing: 12in
For used homes a min. 30 gauge, 8" wide, galvanized metal strip will be centered over the peak of the roof and fastened with galv. roofing nails at 2" on center on both sides of the centerline.

Gasket (weatherproofing requirement)

I understand a properly installed gasket is a requirement of all new and used homes and that condensation, mold, mildew and buckled marriage walls are a result of a poorly installed or no gasket being installed. I understand a strip of tape will not serve as a gasket.

Installer's initials

Type gasket Manufacturer Installed:
Pg. Between Floors Yes ☒
Between Walls Yes ☒
Bottom of ridgebeam Yes ☒

Weatherproofing

The bottomboard will be repaired and/or taped. Yes ☒ Pg.
Siding on units is installed to manufacturer's specifications. Yes ☒
Fireplace chimney installed so as not to allow intrusion of rain water. Yes ☒

Miscellaneous

Skirting to be installed. Yes _____ No _____
Dryer vent installed outside of skirting. Yes _____ N/A
Range downflow vent installed outside of skirting. Yes _____ N/A
Drain lines supported at 4 foot intervals. Yes _____
Electrical crossovers protected. Yes _____
Other: _____


Installer verifies all information given with this permit worksheet is accurate and true based on the manufacturer's installation instructions and or Rule 15C-1 & 2

Installer Signature

Date


Jac LC "MALONE" Build As Shown E006351

X *Ronda Hall*
X *James Hester*

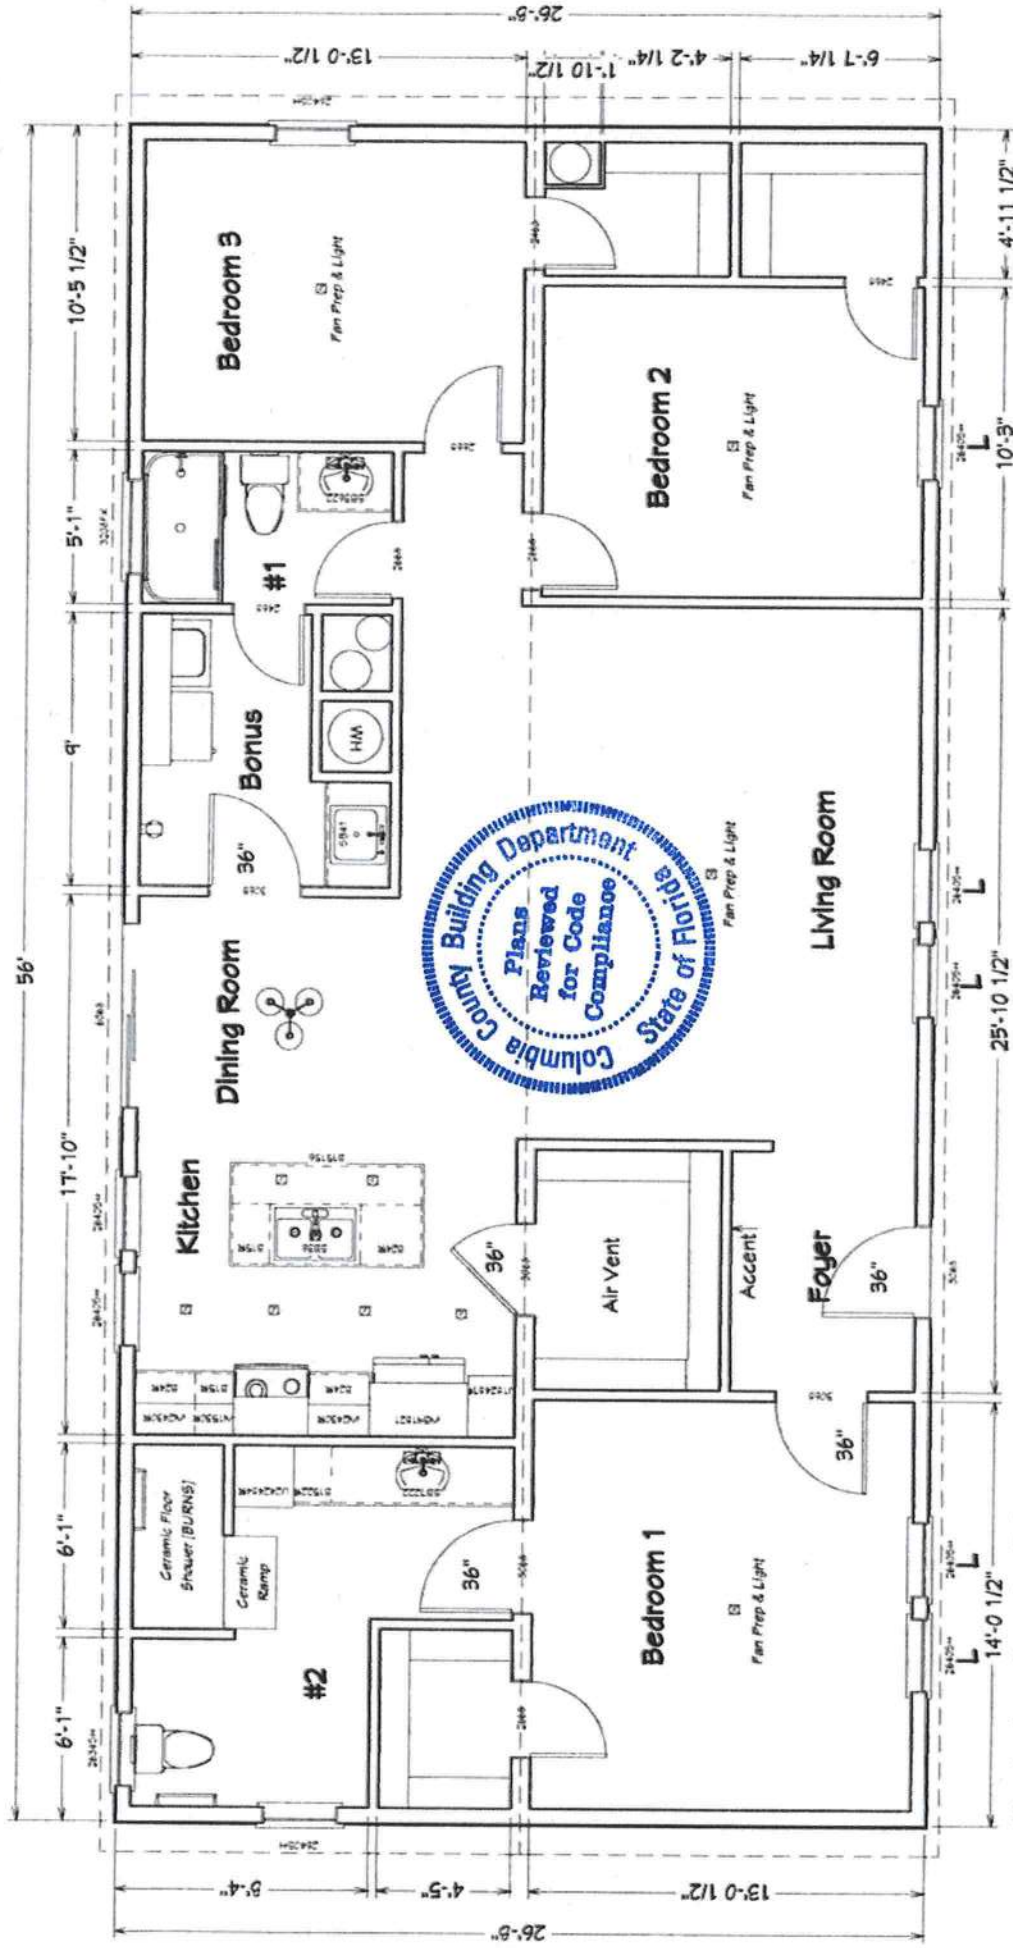

Drawing is render only, all sizes approximate and subject to engineer review and change. Final Jacobsen print must be signed by dealer and customer prior to construct.

56'-0"

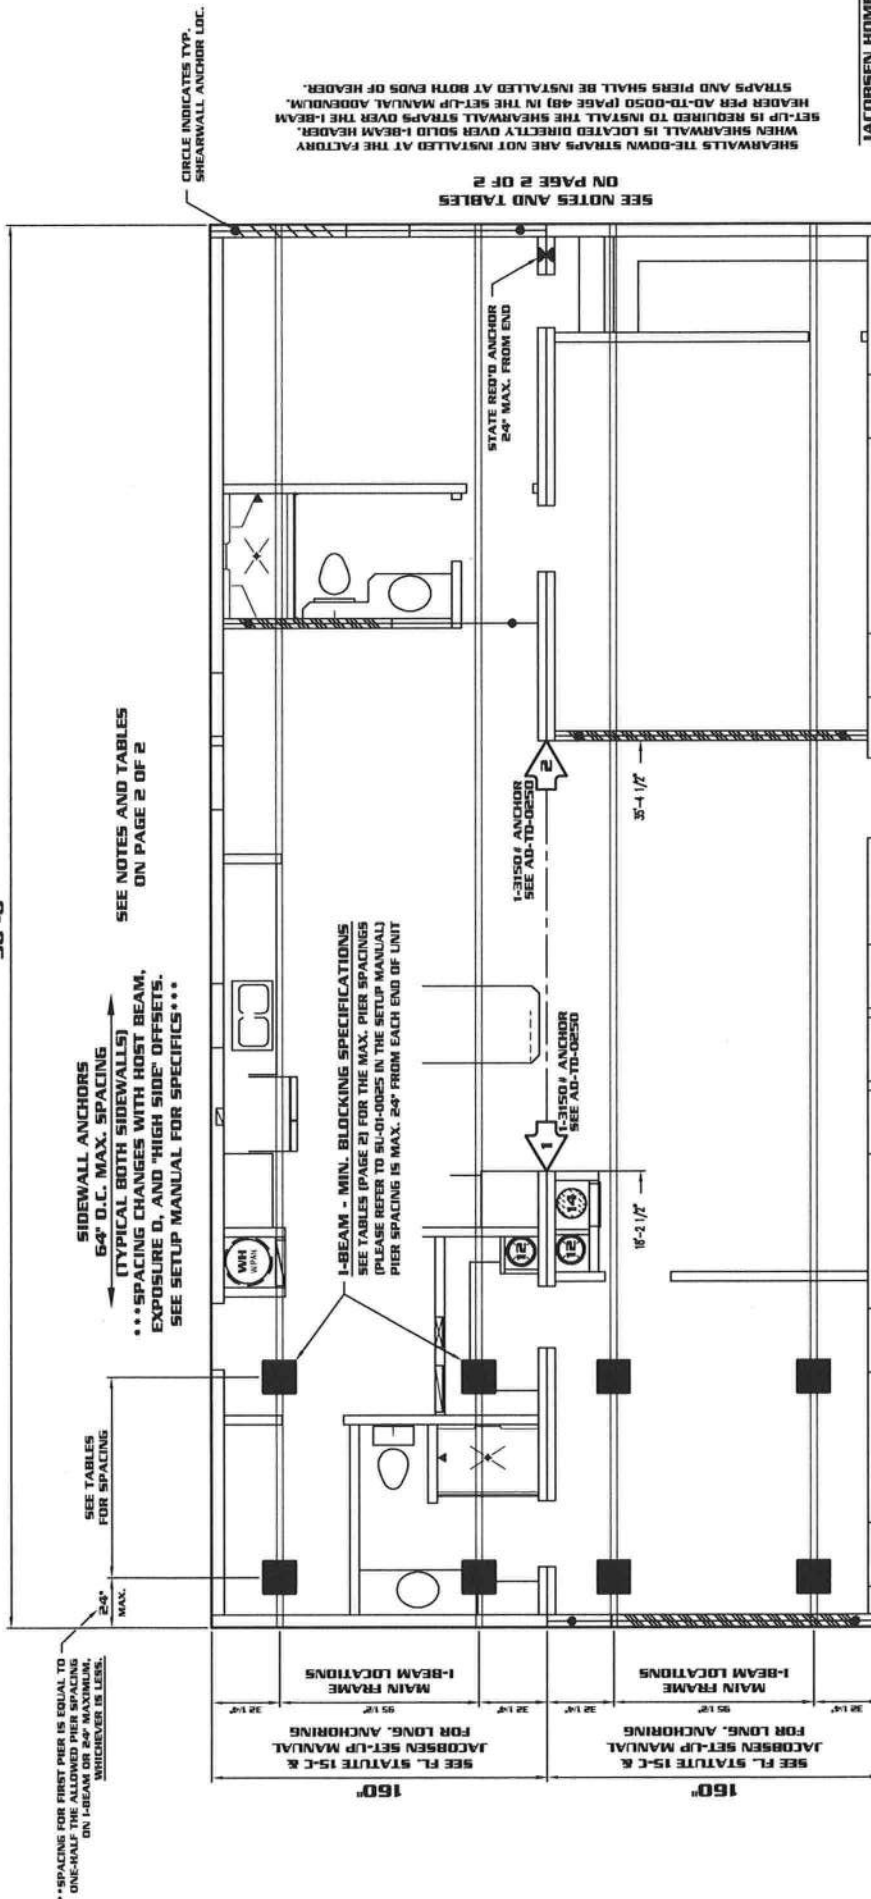

JACOBSEN HOMES
IMP-36,551

REVISIONS
2/24
2/24
1/19

MODEL # IMP-456168-551

REFER TO SU-01-0005 FOR
ADD'L PIER REQUIREMENTS

REFER TO THE JACOBSEN HOMES SETUP MANUAL AND
ADDENDUM FOR COMPLETE INSTALLATION INSTRUCTIONS

JACOBSEN HOMES
PO BOX 368, 600 PACKARD CT.
SAFETY HARBOR, FLORIDA 34695

(727) 726-1138


www.jachomes.com

HUD WIND ZONE - 2
HUD WIND EXPOSURE CATEGORY - C
36551 - PAGE 1 OF 2

THIS BLOCKING DIAGRAM IS PROVIDED AS A COURTESY ONLY. THE LICENSED SET-UP CONTRACTOR SHALL REVIEW THE DETAIL AND VERIFY COMPLIANCE. THE LICENSED SET-UP CONTRACTOR IS RESPONSIBLE AND LIABLE FOR ALL INSTALLATION.

REFER TO SU-01-0020, SU-01-0021, AND OTHER DETAILS IN THE SET-UP MANUAL FOR MAXIMUM HEIGHT (THIS IS NOT DESIGNED, NOR INTENDED, TO BE A STILT FOUNDATION)



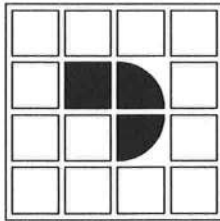

JACOBSEN HOMES
PO BOX 368, 600 PACKARD CT.
SAFETY HARBOR, FLORIDA 34695

(727) 726-1138

www.jachomes.com

COLUMN INFO. TABLE			COLUMN PAD - MIN. SIZES (sq. in.)						
COL. NUM.	SPAN	LOAD (IN POUNDS)	1000 per SOIL	1500 per SOIL	2000 per SOIL	2500 per SOIL	3000 per SOIL	3500 per SOIL	
1	17'-3"	4575	659	439	329	264	264	264	
2	17'-3"	4575	659	439	329	264	264	264	
3	0"	0	0	0	0	0	0	0	
4	0"	0	0	0	0	0	0	0	
5	0"	0	0	0	0	0	0	0	
6	0"	0	0	0	0	0	0	0	
7	0"	0	0	0	0	0	0	0	
8	0"	0	0	0	0	0	0	0	
9	0"	0	0	0	0	0	0	0	
10	0"	0	0	0	0	0	0	0	

REFER TO AD-TD-0254 FOR COLUMN ANCHOR SIZES.
REFER TO AD-TD-0250 THROUGH

MINIMUM PIER PAD SIZE (sq.in.)		I-BEAM PIER SPACING									
		1000 per sq. ft.	1500 per sq. ft.	2000 per sq. ft.	2500 per sq. ft.	3000 per sq. ft.	3500 per sq. ft.	1000 per sq. ft.	1500 per sq. ft.	2000 per sq. ft.	2500 per sq. ft.
A	256 sq. in.	30	48 1/2	66 1/2	85	103*	N10 N10	30	48 1/2	66 1/2	85
B	342.25 sq. in.	42	66 1/2	90 1/2	115*	N10 N10	N10 N10	42	66 1/2	90 1/2	115*
C	396 sq. in.	49	77 1/2	105 1/2*	N10 N10	N10 N10	N10 N10	49	77 1/2	105 1/2*	N10 N10
D	400 sq. in.	49 1/2	78 1/2	107 1/2*	N10 N10	N10 N10	N10 N10	49 1/2	78 1/2	107 1/2*	N10 N10
E	432.875 sq. in.	54	85	116*	N10 N10	N10 N10	N10 N10	54	85	116*	N10 N10
F	576 sq. in.	74	115*	N10 N10	N10 N10	N10 N10	N10 N10	74	115*	N10 N10	N10 N10
G	676 sq. in.	87 1/2	N10 N10	N10 N10	N10 N10	N10 N10	N10 N10	87 1/2	N10 N10	N10 N10	N10 N10

N10 = SEE NOTE 10.
REFER TO SL-01-0005 FOR
ADDITIONAL PIER REQUIREMENTS.

COPYRIGHT © 2013, JACOBSEN HOMES, SAFETY HARBOR, FLORIDA. ALL RIGHTS RESERVED.

WARNING:

INSTALLING A MANUFACTURED STRUCTURE/BUILDING IS AN EXTREMELY DANGEROUS TASK. ONLY QUALIFIED PERSONNEL SHOULD ATTEMPT TO INSTALL A MANUFACTURED STRUCTURE/BUILDING. IMPROPER PROCEDURES AND/OR TECHNIQUES COULD RESULT IN SERIOUS INJURY OR DEATH. IN ADDITION TO THE DANGER TO PERSONNEL, IMPROPER SETUP/INSTALLATION COULD RESULT IN EXTENSIVE/COSTLY DAMAGE TO THE BUILDING/STRUCTURE. NEVER ATTEMPT INSTALLATION IF YOU ARE NOT QUALIFIED AND/OR DO NOT HAVE THE PROPER TOOLS AND/OR EQUIPMENT.

CAUTION:

MANUFACTURED BUILDINGS/STRUCTURES CAN WEIGH SEVERAL TONS. IT IS VERY IMPORTANT THAT ALL PERSONNEL, ON THE JOB SITE, BE QUALIFIED AND PROPERLY/ADEQUATELY TRAINED. A STATE LICENSED SETUP CONTRACTOR IS REQUIRED TO BE RESPONSIBLE FOR ALL SAFETY INITIATIVES, PROGRAMS, POLICIES, AND/OR PROCEDURES THAT MAY BE MANDATED BY OSHA AND/OR ANY OTHER LOCAL, STATE, AND/OR FEDERAL CODES AND/OR REQUIREMENTS. THE CONTRACTOR SHALL INSURE/REQUIRE THAT SAFE AND PROPER TECHNIQUES ARE UTILIZED.

NOTES:

- REFER TO THE MODEL APPROVAL FOR PLAN SPECIFIC INFORMATION.
- REFER TO THE JACOBSEN HOMES SETUP MANUAL AND ADDENDUM FOR COMPLETE INSTALLATION INSTRUCTIONS. PIERS CAN BE RELOCATED AND/OR SPANS INCREASED PER THE SETUP MANUAL.
- REFER TO SL-01-0005 FOR ADDITIONAL PIER REQUIREMENTS.
- REFER TO AD-TD-100 FOR SHEARWALL APPLICATIONS AND TIE-DOWNS.
- REFER TO THE APPROVED FLOOR PLAN FOR SHEARWALL LOCATIONS AND LOADS.
- REFER TO THE APPROVED FLOOR PLAN FOR SPECIFIC COLUMN LOCATIONS. COLUMN PIERS SHALL BE LOCATED WITHIN 6" OF EITHER SIDE OF THE COLUMN. ADDITIONAL PIERS MAY BE REQUIRED ALONG THE MATING LINE. SEE THE SETUP MANUAL FOR SPECIFICS.
- ALL 184" WIDE FLOOR SYSTEMS REQUIRE PERIMETER AND MATING LINE BLOCKING.
- ALL 2X6 FLOOR SYSTEMS WIDER THAN 144" REQUIRE PERIMETER AND MATING LINE BLOCKING. ANY SIDEWALL AREA WITH A HOIST BEAM OR A STRUCTURAL ATTACHMENT SHALL HAVE PIERS AND ANCHORS SPACED NO FURTHER THAN 48" O.C. MAXIMUM. SOME WIND ZONE AREAS MAY REQUIRE CLOSER INSTALLATION. REFER TO THE JACOBSEN HOMES SETUP MANUAL FOR SPECIFICS (SEE SL-01-0005 AND SL-01-0008). WHEN THE ATTACHED STRUCTURE HAS FOURTH WALL CONSTRUCTION OR IS DESIGNED AND CONSTRUCTED TO BE SELF SUPPORTING, THESE ADDITIONAL PIERS AND ANCHORS ARE NOT REQUIRED.
- MAX. PIER SPACING ON 8" I-BEAM IS 96". MAX. PIER SPACING ON 10" OR 12" I-BEAM IS 120". SEE NOTE 4 ON PAGES SL-01-0003 THROUGH SL-01-0026.

MATING LINE PIER SPACING		PERIMETER PIER SPACING									
		1000 per sq. ft.	1500 per sq. ft.	2000 per sq. ft.	2500 per sq. ft.	3000 per sq. ft.	3500 per sq. ft.	1000 per sq. ft.	1500 per sq. ft.	2000 per sq. ft.	2500 per sq. ft.
A	84	84	84	84	84	84	84	84	84	84	84
B	84	84	84	84	84	84	84	84	84	84	84
C	84	84	84	84	84	84	84	84	84	84	84
D	84	84	84	84	84	84	84	84	84	84	84
E	84	84	84	84	84	84	84	84	84	84	84
F	84	84	84	84	84	84	84	84	84	84	84
G	84	84	84	84	84	84	84	84	84	84	84

HL0 WIND ZONE - 2
HUD WIND EXPOSURE CATEGORY - C

36551 - PAGE 2 OF 2

REFER TO SL-01-0020, SL-01-0021, AND OTHER DETAILS IN THE SETUP MANUAL FOR MAXIMUM HEIGHT (THIS IS NOT DESIGNED, NOR INTENDED, TO BE A STILL FOUNDATION)
THIS BLOCKING DIAGRAM IS PROVIDED AS A COURTESY ONLY. THE LICENSED SETUP CONTRACTOR SHALL REVIEW THIS DETAIL AND VERIFY COMPLIANCE. THE LICENSED SETUP CONTRACTOR IS RESPONSIBLE AND LIABLE FOR ALL INSTALLATION.