

Lee-Cl

DART L-4723A

page 1 of 2

These worksheets must be completed and signed by the installer.
Submit the originals with the packet.

Installer DAVID ALBRIGHT License # IH/ 1129420

911 Address where home is being installed. 1475w Jensen lane
Fort white FL, 32038

Manufacturer LIVE OAK HOMES Length x width 14 x 68/72

NOTE: If home is a single wide fill out one half of the blocking plan
if home is a triple or quad wide sketch in remainder of home

I understand Lateral Arm Systems cannot be used on any home (new or used)
where the sidewall ties exceed 5 ft 4 in.


Installer's initials DA

Typical pier spacing

2' 4'6"



Show locations of Longitudinal and Lateral Systems
(use dark lines to show these locations)

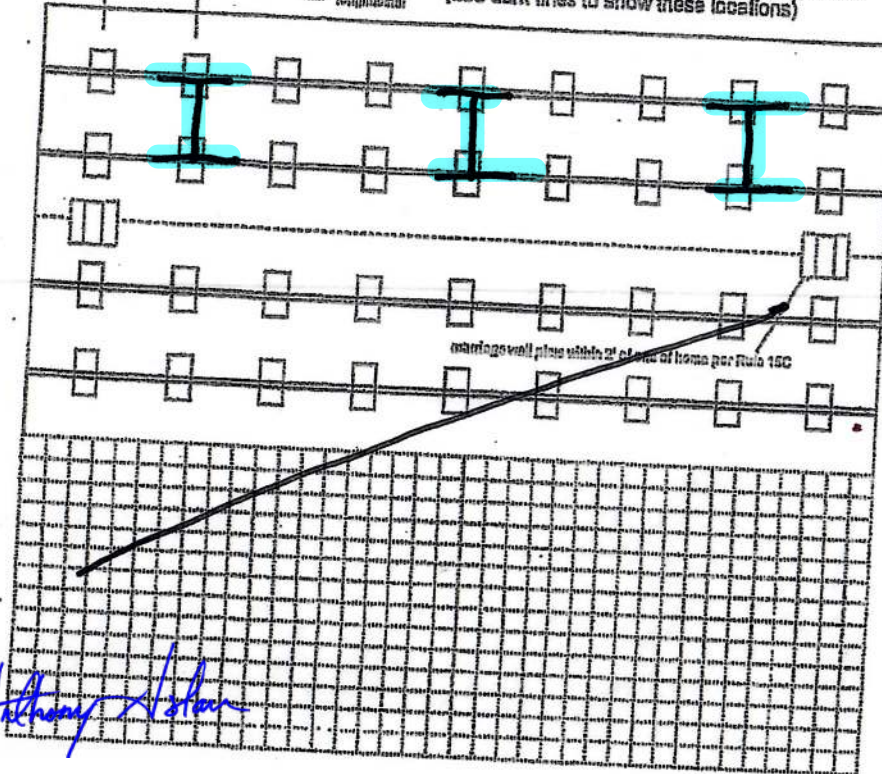

New Home ☒ Used Home ☐

Home installed to the Manufacturer's Installation Manual ☒

Home is installed in accordance with Rule 15-C ☐

Single wide ☒ Wind-Zone II ☒ Wind Zone III ☐

Double wide ☐ Installation Detail # 85944

Triple/Quad ☐ Serial # LOHGA 20037460

PIER SPACING TABLE FOR USED HOMES

Load bearing capacity	Footer size (sq in)	18" x 16" (288)	18 1/2" x 18 1/2" (342)	20" x 20" (400)	22" x 22" (484)	24" x 24" (576)	26" x 26" (676)
1000 psf	3'	3'	3'	3'	3'	3'	3'
1500 psf	4' 6"	4'	4'	4'	4'	4'	4'
2000 psf	6'	6'	6'	6'	6'	6'	6'
2500 psf	7' 6"	7'	7'	7'	7'	7'	7'
3000 psf	8'	8'	8'	8'	8'	8'	8'
3500 psf	8'	8'	8'	8'	8'	8'	8'

* Interpolated from Rule 15C-1 pier spacing table.

PIER PAD SIZES

I-beam pier pad size 17x25

Perimeter pier pad size 16x16

Other pier pad sizes (required by the mfg.) —

Draw the approximate locations of marriage wall openings 4 foot or greater. Use this symbol to show the piers.

List all marriage wall openings greater than 4 foot and their pier pad sizes below:

Opening Pier pad size

_____	_____
_____	_____
_____	_____

TIEDOWN COMPONENTS

Longitudinal Stabilizing Device (LSD) OTI
Manufacturer
Longitudinal Stabilizing Device w/ Lateral Arms
Manufacturer OTI

POPULAR PAD SIZES

Pad Size	Sq In
16 x 16	256
16 x 18	288
18.5 x 16.5	342
16 x 22.5	360
17 x 22	374
13 1/4 x 26 1/4	348
20 x 20	400
17 3/16 x 25 3/16	441
17 1/2 x 25 1/2	446
24 x 24	576
26 x 26	676

ANCHORS

4 ft ☒ 5 ft ☒ SHEARWALL

FRAME TIES

within 2' of end of home spaced at 5' 4" oc

OTHER TIES

Sidewall Number 16 PER SIDE
Longitudinal 6
Marriage wall 3
Shearwall 3



02-14-2022



POCKET PENETROMETER TEST

The pocket penetrometer tests are rounded down to _____ psf or check here to declare 1000 lb. soil X without testing.

X _____ X _____ X _____

POCKET PENETROMETER TESTING METHOD

1. Test the perimeter of the home at 6 locations.
2. Take the reading at the depth of the footer.
3. Using 500 lb. increments, take the lowest reading and round down to that increment.

X _____ X _____ X _____

TORQUE PROBE TEST

The results of the torque probe test is 245 inch pounds or check here if you are declaring 5' anchors without testing _____. A test showing 275 inch pounds or less will require 5 foot anchors.

Note: A state approved lateral arm system is being used and 4 ft. anchors are allowed at the sidewall locations. I understand 6 ft anchors are required at all centerline tie points where the torque test reading is 275 or less and where the mobile home manufacturer may require anchors with 4000 lb holding capacity.

N/A Installer's initials

ALL TESTS MUST BE PERFORMED BY A LICENSED INSTALLER

Installer Name DAVID RIBRIGHT

Date Tested _____

Electrical

Connect electrical conductors between multi-wide units, but not to the main power source. This includes the bonding wire between multi-wide units. Pg. _____

Plumbing

Connect all sewer drains to an existing sewer tap or septic tank. Pg. 19-80

Connect all potable water supply piping to an existing water meter, water tap, or other independent water supply systems. Pg. 24-110

Site Preparation

Debris and organic material removed X
Water drainage: Natural _____ Swale _____ Pad X Other _____

Fastening multi wide units

Floor: Type Fastener: _____ Length: _____ Spacing: _____
Walls: Type Fastener: _____ Length: _____ Spacing: _____
Roof: Type Fastener: _____ Length: _____ Spacing: _____
For used homes a min. 30 gauge, 8" wide, galvanized metal strip will be centered over the peak of the roof and fastened with galv. roofing nails at 2" on center on both sides of the centerline.

Gasket (weatherproofing requirement)

I understand a properly installed gasket is a requirement of all new and used homes and that condensation, mold, mildew and buckled marriage walls are a result of a poorly installed or no gasket being installed. I understand a strip of tape will not serve as a gasket.

Type gasket _____
Pg. _____

Installer's Initials _____

Installed:

Between Floors Yes _____
Between Walls Yes _____
Bottom of ridgebeam Yes _____

Weatherproofing

The bottomboard will be repaired and/or taped. Yes X Pg. 184
Siding on units is installed to manufacturer's specifications. Yes _____
Fireplace chimney installed so as not to allow intrusion of rain water. Yes _____



Miscellaneous

Skirting to be installed. Yes _____ No X
Dryer vent installed outside of skirting. Yes _____ N/A X
Range downflow vent installed outside of skirting. Yes _____ N/A X
Drain lines supported at 4 foot intervals. Yes X
Electrical crossovers protected. Yes _____
Other: _____

Installer verifies all information given with this permit worksheet is accurate and true based on the

Installer Signature David Ribright Date _____

DART

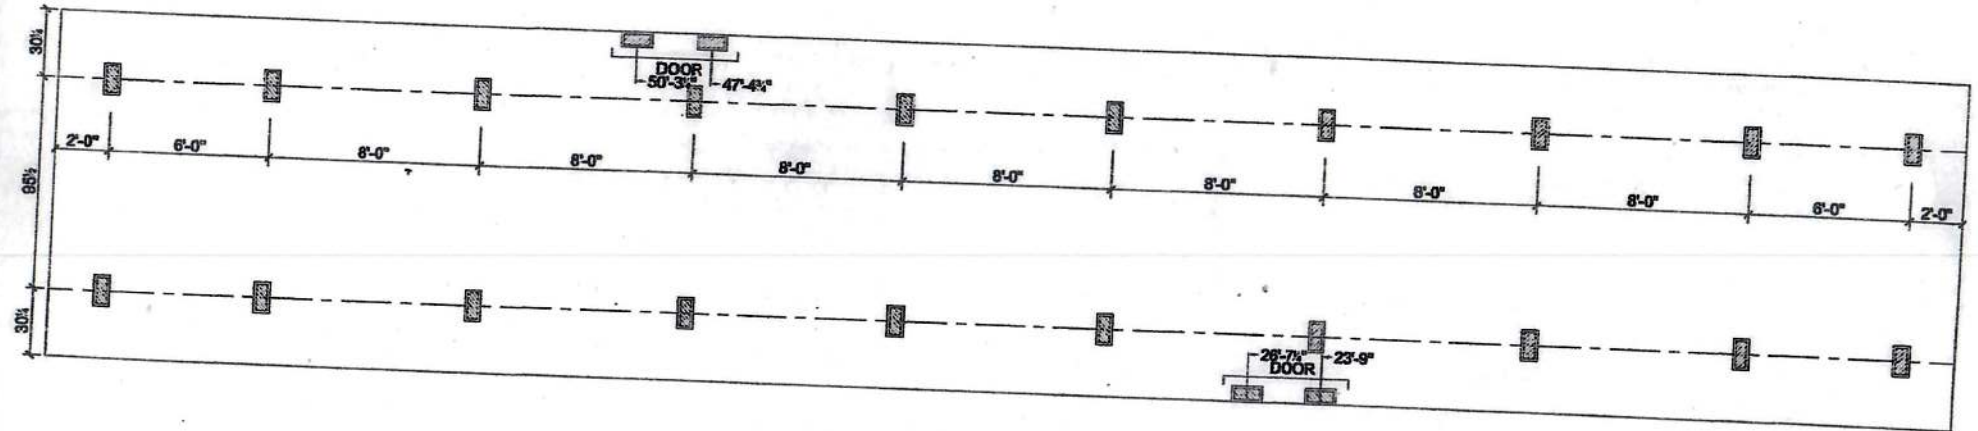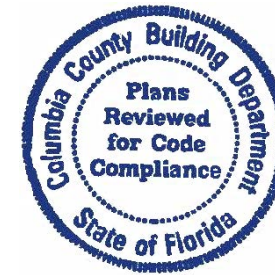

 SUPPORT PIER/TYP

FOUNDATION NOTES:

- THIS DRAWING IS DESIGNED FOR THE STANDARD WIND ZONE AND IS TO BE USED IN CONJUNCTION WITH THE INSTALLATION MANUAL AND ITS SUPPLEMENTS.
- FOOTINGS ARE SHOWN FOR EXAMPLE ONLY QUANTITY AND SPACING MAY VARY BASED ON PAD TYPE, SOIL CONDITION, ETC.

6-25-2015

Live Oak Homes
MODEL: L-4723A - 14 X72
3-BEDROOM / 1-BATH

L-4723A

License Number: IH / 1129420 / 1 Name: DAVID E ALBRIGHT

Order #: 5175	Label #: 85944	Manufacturer: <u>LIVE OAK</u>	(Check Size of Home)
Homeowner: <u>LEE</u>	Year Model: <u>2022</u>	Single <u>X</u>	
Address: <u>147 SW JENSEN LN</u>	Length & Width: <u>68/72 x 14</u>	Double _____	
City/State/Zip: <u>FORT WHITE FL 32038</u>	Type Longitudinal System: <u>6 OTI</u>	Triple _____	
Phone #:	Type Lateral Arm System: <u>6 OTI</u>	HUD Label #:	
Date Installed:	New Home: <u>X</u> Used Home: _____	Soil Bearing / PSF:	
Installed Wind Zone: <u>A</u>	Data Plate Wind Zone: <u>II</u>	Torque Probe / in-lbs:	
Note:		Permit #:	



STATE OF FLORIDA
INSTALLATION CERTIFICATION LABEL

85944

LABEL #

DATE OF INSTALLATION

DAVID E ALBRIGHT

NAME

IH / 1129420 / 1

5175

LICENSE #



ORDER #

CERTIFIES THAT THE INSTALLATION OF THIS MOBILE HOME IS
IN ACCORDANCE WITH FLORIDA STATUTES 320.8249, 320.8325
AND RULES OF THE HIGHWAY SAFETY AND MOTOR VEHICLES.

INSTRUCTIONS

PLEASE WRITE DATE OF
INSTALLATION AND AFFIX
LABEL NEXT TO HUD LABEL.
USE PERMANENT INK PEN
OR MARKER ONLY.
COMPLETE INFORMATION
ABOVE AND KEEP ON FILE
FOR A MINIMUM OF 2 YEARS.
YOU ARE REQUIRED TO
PROVIDE COPIES WHEN
REQUESTED.

DART

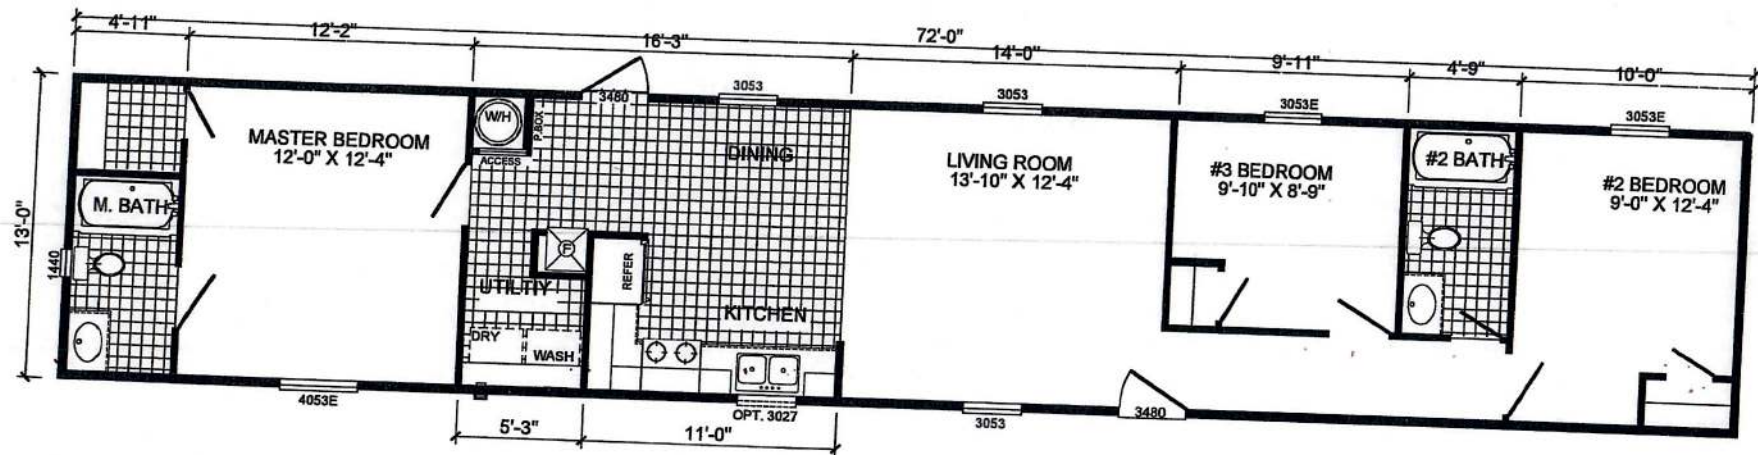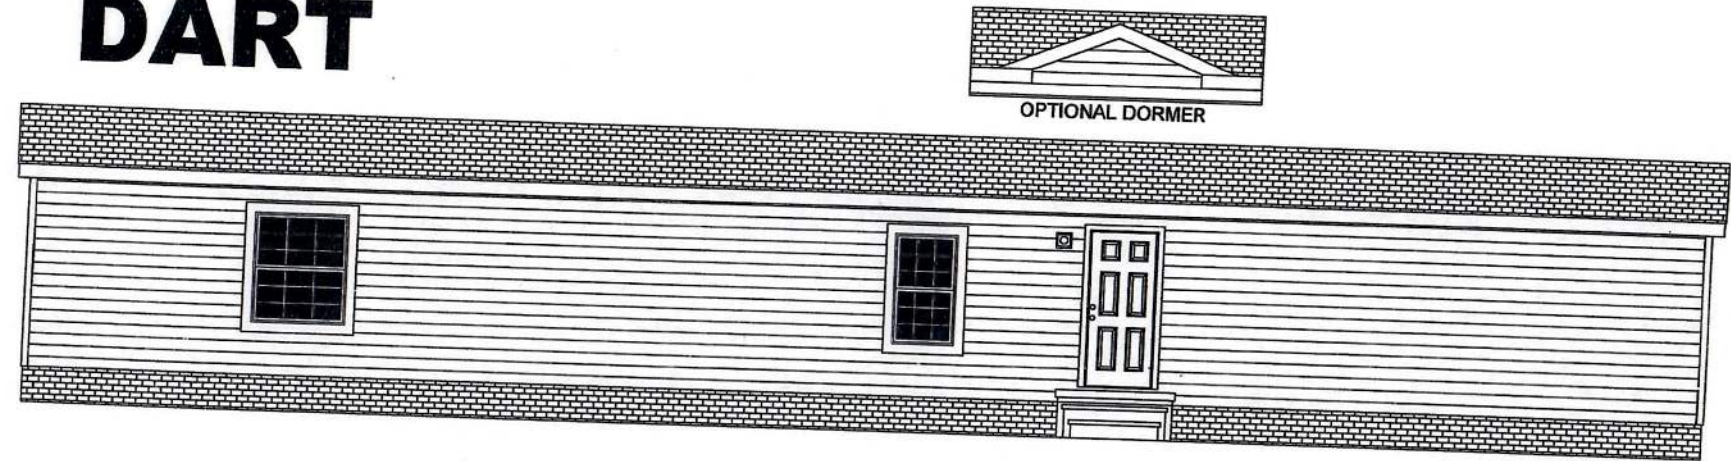

L-4723A RUNNER
3-BEDROOM / 2-BATH
14 X 72 - Approx. 936 Sq. Ft.

Date: 10-30-2014

* All room dimensions include closets and square footage figures are approximate.