

PERMIT APPLICATION / MANUFACTURED HOME INSTALLATION APPLICATION

For Office Use Only

(Revised 6-23-05)

Zoning Official

Building Official

API

6701-30

Date Received

1-9-07

By

Permit #

25431

Flood Zone

Development Permit

Zoning

Land Use Plan Map Category

Comments

14.9 family lot permit

existing MH to be removed

FEMA Map#

Elevation

Finished Floor

River

In Floodway

☒ Site Plan with Setbacks Shown
 ☒ EH Signed Site Plan
 ☒ EH Release
 ☒ Well letter
 ☒ Existing well

☒ Copy of Recorded Deed or Affidavit from land owner
 ☒ Letter of Authorization from installer

Property ID # 14-5515-00459-234 Must have a copy of the property deed

New Mobile Home Yes Used Mobile Home _____ Year 2007

Applicant Paula M. Womer Phone # 386-752-2341

Address 983 S.W. Mary Ter Lake City FL 32024

Name of Property Owner Craig M. Womer Jr. Phone # 386-752-2341

911 Address 983 S.W. Mary Ter Lake City FL 32024

Circle the correct power company - FL Power & Light - Clay Electric
(Circle One) - Suwannee Valley Electric - Progress Energy

Name of Owner of Mobile Home Craig M. Womer Jr & Paula Womer Phone # 386-752-2341

Address 983 S.W. Mary Ter Lake City FL 32024

Relationship to Property Owner Self

Current Number of Dwellings on Property 1

Lot Size _____ Total Acreage 5.1

Do you : Have an Existing Drive or need a Culvert Permit or a Culvert Waiver (Circle one)

Is this Mobile Home Replacing an Existing Mobile Home Yes

Driving Directions to the Property HWY 247 West to SR 240 Lt so approx- 1 mile Rt on S.W. Mary Terrace, about 600 Ft before Mary Terrace Ends drive on Lt, (Power line drive)

Name of Licensed Dealer/Installer TERRY L. THORNTON Phone # (386) 623-0115

Installers Address 448 NW Dye Hunter Dr Lake City FL 32053

License Number TH-0000036 Installation Decal # 274647

11 \$275.00

ASSESSMENTS charged for 2 units UNDER PARENT PARCELS

JW LEFT MESSAGE: 1.17.06 ON ANSWERING MACHINE

LIMITED POWER OF ATTORNEY


I, TERRY L. THRIFT, LICENSE #1H-0000036 EXPIRING 09-30-20____. DO HEREBY
AUTHORIZE Nicole Coleman TO BE MY REPRESENTATIVE
AND ACT ON MY BE HALF IN ALL ASPECTS OF APPLYING FOR A MOBILE HOME
MOVE ON PERMIT TO BE INSTALLED IN Columbia COUNTY,
FLORIDA.

Terry L. Thrift
TERRY L. THRIFT

1-05-07
DATE

SWORN TO AND SUBSCRIBED BEFORE ME THIS 05 DAY OF January
2007.

Nicole Coleman
NOTARY PUBLIC

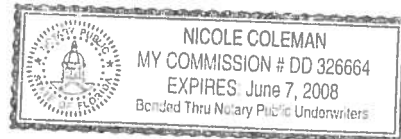


PERSONALLY KNOWN: X

PRODUCED ID: _____


YEAR 07

MAKE Homes of Merit SN# Special order



PROPERTY ID/LOCATION _____

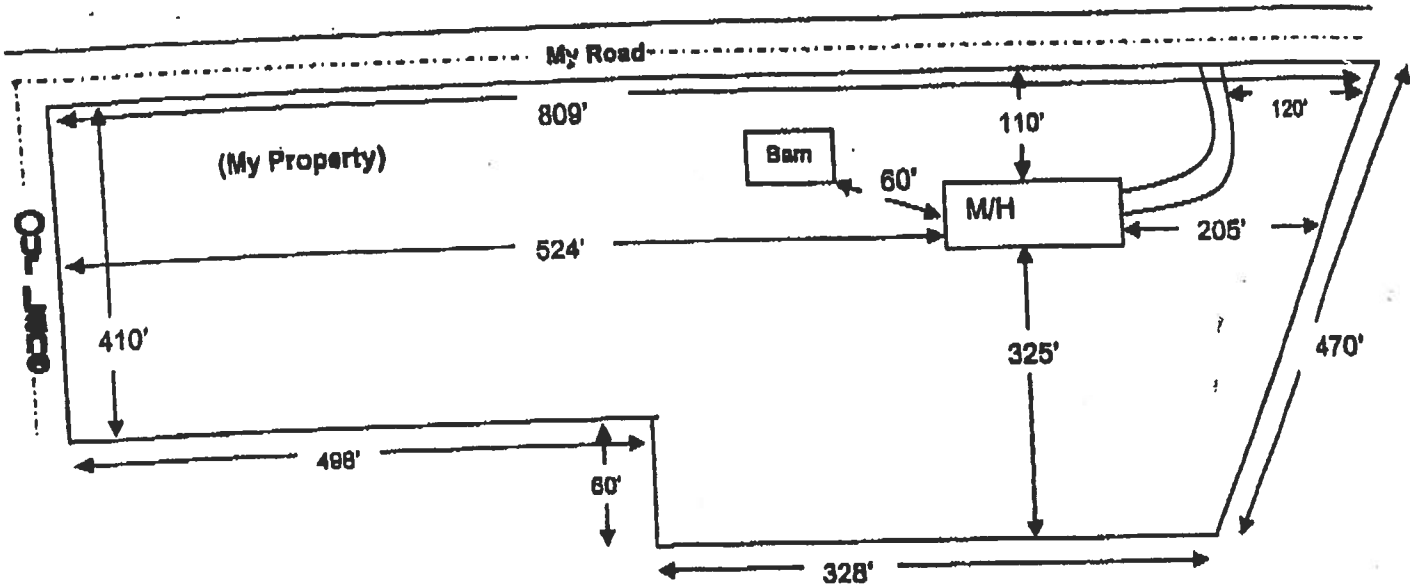SITE PLAN EXAMPLE / WORKSHEET

Use this example to draw your own site plan. Show all existing buildings and any other homes on this property and show the distances between them. Also show where the roads or roads are around the property. This site plan can also be used for the 911 Addressing department if you include the distance from the driveway to the nearest property line.

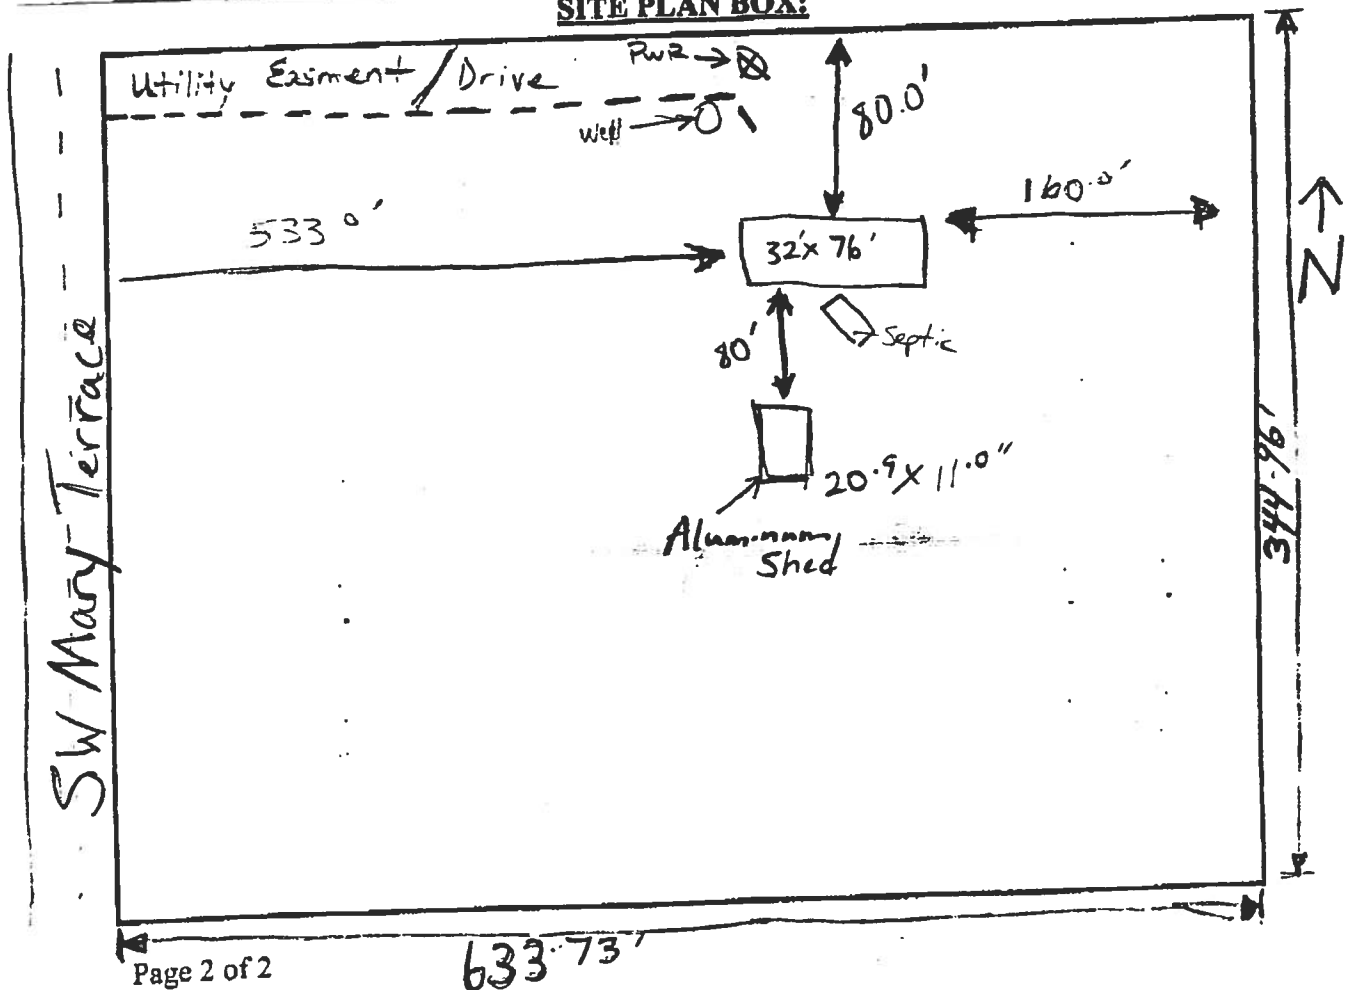SITE PLAN BOX:

1. A PLAT, PLAN, OR DRAWING SHOWING THE PROPERTY LINES OF THE PARCEL.
2. LOCATION OF PLANNED RESIDENT OR BUSINESS STRUCTURE ON THE PROPERTY WITH DISTANCES FROM AT LEAST TWO OF THE PROPERTY LINES TO THE STRUCTURE (SEE SAMPLE BELOW).
3. LOCATION OF THE ACCESS POINT (DRIVEWAY, ETC.) ON THE ROADWAY FROM WHICH LOCATION IS TO BE ADDRESSED WITH A DISTANCE FROM A PARALLEL PROPERTY LINE AND OR PROPERTY CORNER (SEE SAMPLE BELOW).
4. TRAVEL OF THE DRIVEWAY FROM THE ACCESS POINT TO THE STRUCTURE (SEE SAMPLE BELOW).

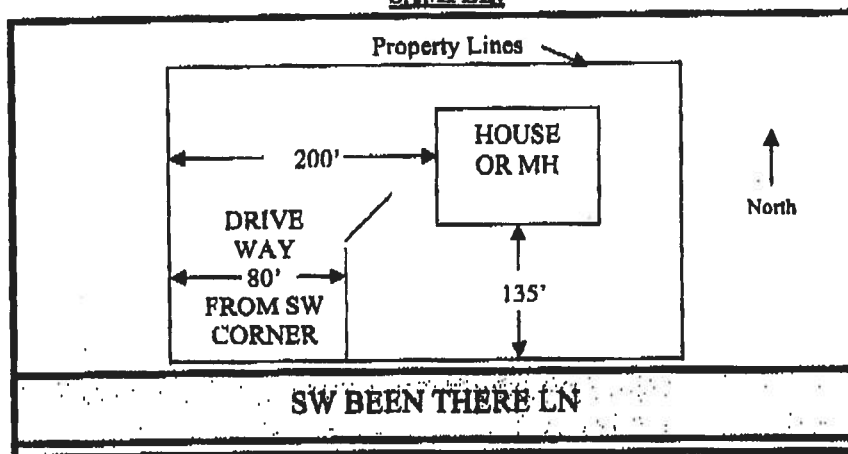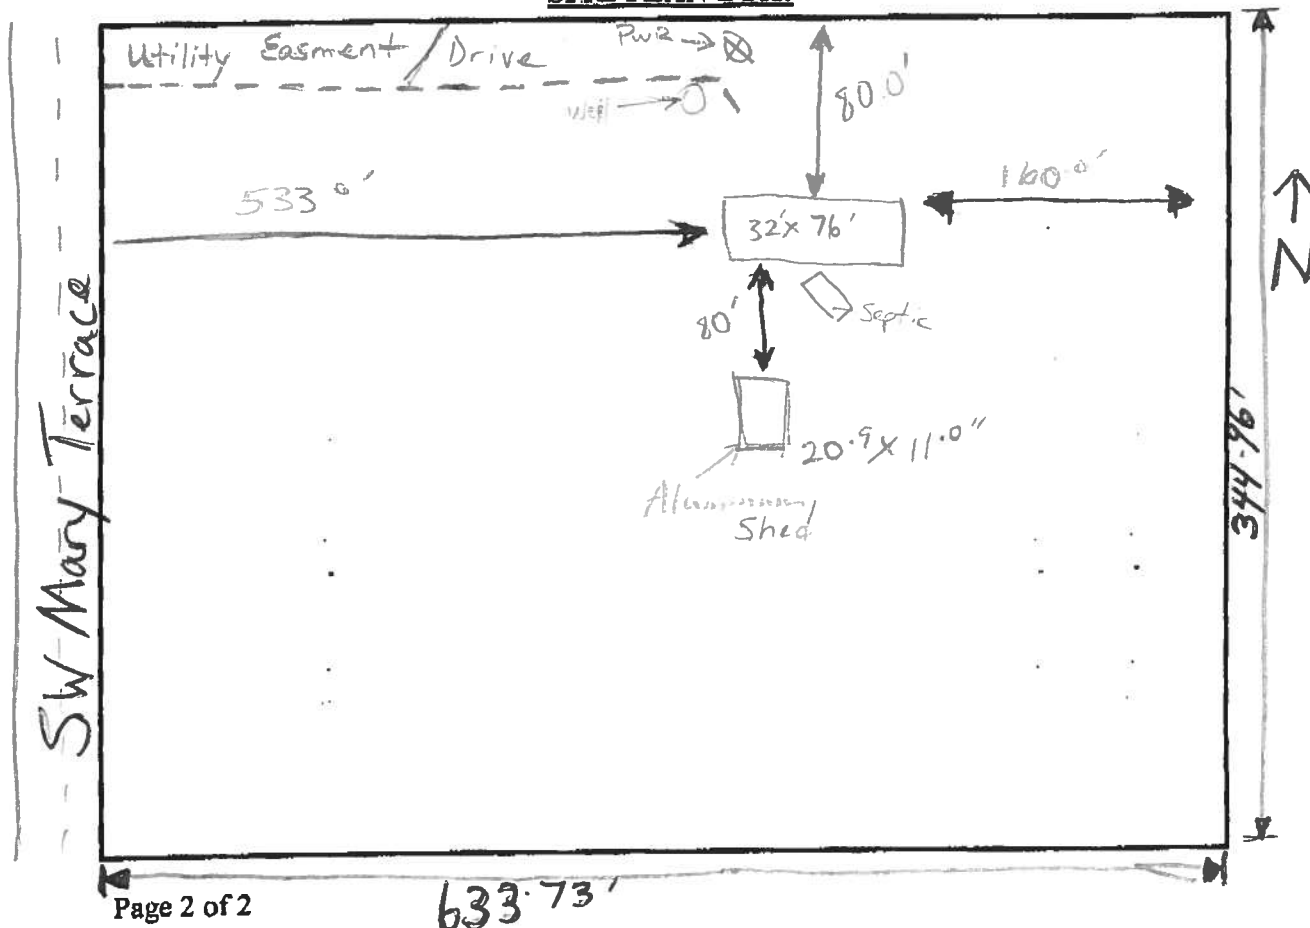SAMPLE:**SITE PLAN BOX:**

W-erit Blocking Plan

TYPICAL FOOTING SPACING DESIGN

- SIDEWALL AND CENTER LINE BLOCKING REQUIRED •

MAXIMUM FOOTING SPACING		
LOCATION	180" FLOOR DBL WIDE	184" FLOOR DBL WIDE
(A)	8'-0" ± 6"	8'-0" ± 8"
(B) (C) (E) (F)	9'-4" ± 6"	9'-4" ± 8"
(D)	8'-0" ± 6"	8'-5" ± 8"

DESIGNS BASED ON THE FOLLOWING


- ROOF LIVE LOAD.....20 psf
- ROOF DEAD LOAD.....10 psf
- FLOOR LIVE LOAD.....40 psf
- FLOOR DEAD LOAD.....10 psf
- WALL DEAD LOAD.....5 psf
- SOIL CAPACITY.....1000 psf
- MINIMUM FOOTING SIZE.....425 sq in.
- DESIGN BASED ON MAX 12" ENDWALL OVERHANG
- NO. PIER DEAD LOAD IS CONSIDERED IN MAXIMUM SPACING TABLE ABOVE. USE SPAN REDUCTION TABLE FOR WEIGHT OF MATERIAL TO ADJUST SPAN.

SPAN REDUCTION TABLE

16x16x4 SOLID CONCRETE FOOTING	80 lbs EACH 0.03"
24x24x4 SOLID CONCRETE FOOTING	126 lbs EACH 0.43"
ABS FOOTING	6 lbs EACH 0.38"
8x8x16 OPEN CELL BLOCK	36 lbs EACH 2.71"
4x8x16 SOLID CAP BLOCK	40 lbs EACH 3.02"
WOOD STUDS & SHIM STOCK	10 lbs TOTAL 0.75"

SPANS ARE TO BE REDUCED FOR EACH ITEM USED WITH PER ASSEMBLY.

NOTE
COLUMN BLOCKING AND SPECIAL BLOCKING CONDITIONS ARE NOT SHOWN ON THIS DETAIL. SEE MINIMUM WALL FOUNDATION PLAN AND SET UP MANUAL FOR FURTHER INFORMATION.


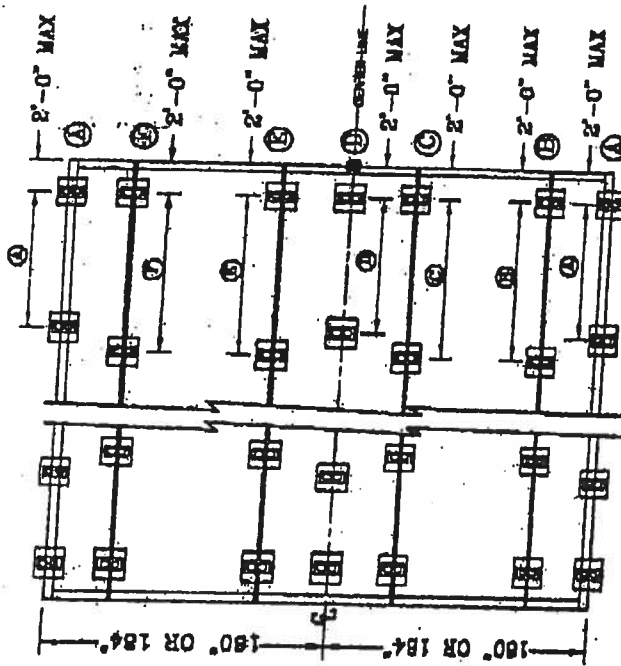


EXAMPLE OF SPAN REDUCTION METHOD

ITEM	REDUCTION FACTOR
1 - 16x16x4 FOOTING	3.64"
3 - 8x8x16 OPEN CELL BLOCK	4.77"
1 - 4x8x16 SOLID CAP BLOCK	1.77"
WOOD STUDS	0.44"
TOTAL SPAN REDUCTION FOR PIER MATERIAL 10.62"	
425 sq. in. FOOTING AT 1000 PSF FOR A 160" BORE	
PIER TABLE SPACING: 9'-4" ± 6"	
REDUCTION REQUIRED FOR PIER MATERIAL: 10.62"	
ALLOWED SPACING BETWEEN PIERS 101.38" ± 6"	
OR	
8'-5" ± 6"	


1 NOV 1 9 1962

REF. CALC # 1 NOV 12 2002

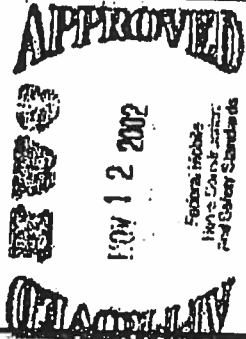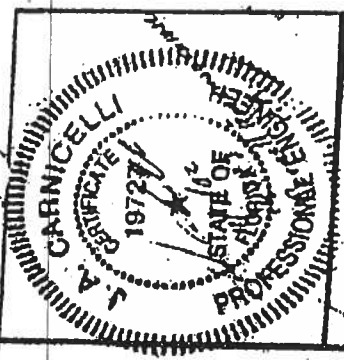

Homes of Mer
P.O. Box 1804
Bartow Air Base
Bartow, Florida 33801

Zone 1	Zone II (100 MPH)	Zone III (110 MPH)
Revisions		
Scale:	1:96	Drawn:
Date:	10/31/02	Approved:
Description:	ANC FOOTING S.P.C. W/SIDEWALL AND CENTER LINE BLOCKING	
Sheet #	AHC 45	

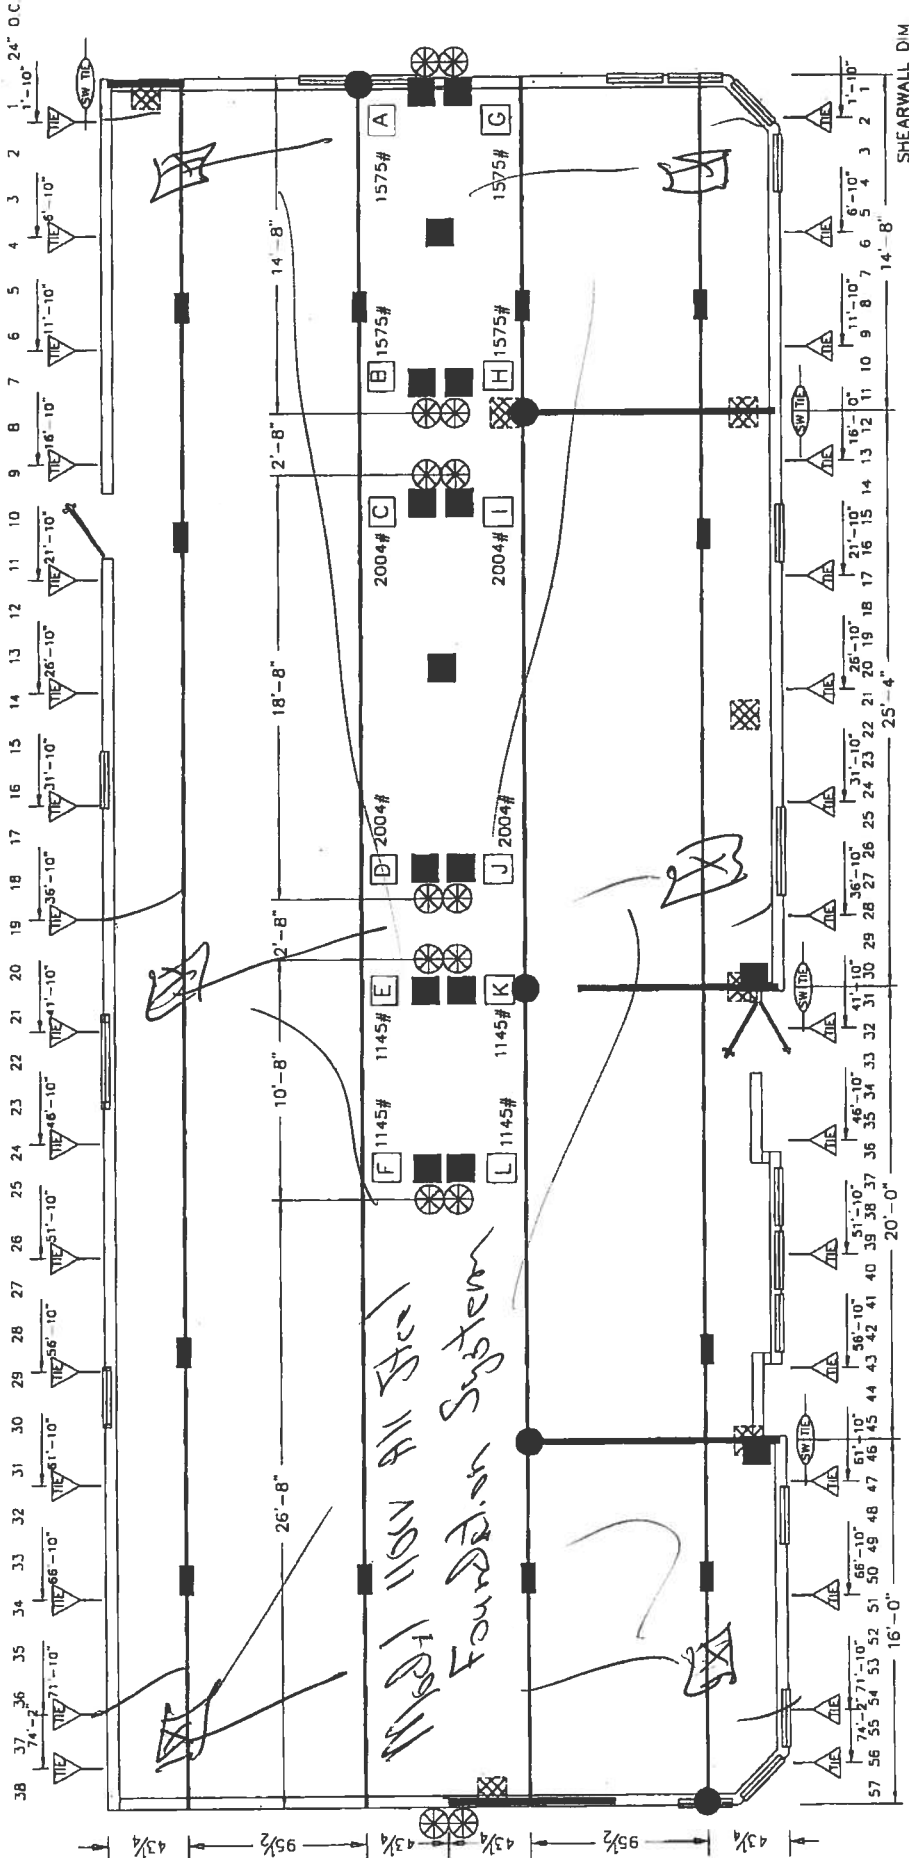

BLOCKING LEGEND:

- 1-BEAM BLOCKING
SEE SOIL BEARING CAPACITY CHARTS FOR SPACING
- COLUMN BLOCKING
SEE SOIL BEARING CAPACITY CHARTS FOR PAD SIZE
- SHEARWALL BLOCKING
- SHEARWALL FRAME TIE
- CENTER LINE TIES
- VERTICAL TIE
MAX. SPACING 5'-0" CENTER TO CENTER
- LONGITUDINAL TIES

- 1) ALL EXTERIOR DOORS, BAY WINDOWS, RECESSED SIDEWALLS AND EXTERIOR WALL OPENINGS 48" OR GREATER, WILL REQUIRE BLOCKING ON EACH SIDE.
- 2) HOMES OF MERIT IS REQUIRING PERIMETER BLOCKING AT 8'-0" ON CENTER



HOMES OF MERIT, INC.
P.O. BOX 2097
HWY 100 EAST
LAKE CITY, FLORIDA 32056

Date: 9-24-02	Revisions	Cad#: LC0023a
Dr'n: JIM	4/12/06 JB	
Parent: 1710		
Code: F (07)		
ZONE	Model:	Print
2	LC0023	BLOCKING PLAN
	80x32 4BR 2B FR	

PERMIT NUMBER

POCKET PENETROMETER TEST

The pocket penetrometer tests are rounded down to psf or check here to declare 1000 lb. soil without testing.

$$\begin{array}{r} 1800 \\ 2585 \end{array} \times \begin{array}{r} 1900 \\ 285 \end{array} = \begin{array}{r} 1530 \\ 580 \end{array}$$

POCKET PENETROMETER TESTING METHOD

1. Test the perimeter of the home at 8 locations.
2. Take the reading at the depth of the footer.
3. Using 500 lb. increments, take the lowest reading and round down to that increment.

$$\begin{array}{r} 1800 \\ 2585 \end{array} \times \begin{array}{r} 1820 \\ 285 \end{array} = \begin{array}{r} 1500 \\ 790 \end{array}$$

TORQUE PROBE TEST

The results of the torque probe test is 285 inch pounds or check here if you are declaring 5' anchors without testing. A test showing 275 inch pounds or less will require 4 foot anchors.

Note: A state approved lateral arm system is being used and 4 ft. anchors are allowed at the sidewall locations. I understand 5 ft anchors are required at all centerline tie points where the torque test reading is 275 or less and where the mobile home manufacturer may require anchors with 4000 lb. holding capacity.

Installer's initials

ALL TESTS MUST BE PERFORMED BY A LICENSED INSTALLER

Installer Name

Date Tested

Electrical

Connect electrical conductors between multi-wide units, but not to the main power source. This includes the bonding wire between multi-wide units. Pg.

Plumbing

Connect all sewer drains to an existing sewer tap or septic tank. Pg.

Connect all potable water supply piping to an existing water meter, water tap, or other independent water supply systems. Pg.

Site Preparation

Debris and organic material removed
Water drainage: Natural Swale Pad Other

Fastening multi-wide units

Floor: Type Fastener: 1/2" x 3" Spacing: 24" x 32" OC
Walls: Type Fastener: 1/2" x 3" Spacing: 24" x 32" OC
Roof: Type Fastener: 1/2" x 3" Spacing: 24" x 32" OC
For used homes a min. 30 gauge, 8" wide, galvanized metal strip will be centered over the peak of the roof and fastened with galv. roofing nails at 2" on center on both sides of the centerline.

Gasket (weatherproofing requirement)

I understand a properly installed gasket is a requirement of all new and used homes and that condensation, mold, mildew and buckled marriage walls are a result of a poorly installed or no gasket being installed. I understand a strip of tape will not serve as a gasket.

Installer's initials

Type gasket Pg. 11
Installed:
Between Floors Yes
Between Walls Yes
Bottom of ridgebeam Yes

Weatherproofing

The bottomboard will be repaired and/or taped. Yes Pg.
Siding on units is installed to manufacturer's specifications. Yes
Fireplace chimney installed so as not to allow intrusion of rain water. Yes

Miscellaneous

Skirting to be installed. Yes No
Dryer vent installed outside of skirting. Yes N/A
Range downflow vent installed outside of skirting. Yes N/A
Drain lines supported at 4 foot intervals. Yes
Electrical crossovers protected. Yes
Other:

Installer verifies all information given with this permit worksheet is accurate and true based on the manufacturer's installation instructions and of Rule 15C-1 & 2

Installer Signature

Date



PERMIT NUMBER

Installer Terry LaTher License # IT-0000836
 Address of home being installed 983 SW Mary Terrace
Lake City FL 32024
 Manufacturer Moritt Length x width 76' x 32'

NOTE: if home is a single wide fill out one half of the blocking plan
 if home is a triple or quad wide sketch in remainder of home

- I understand Lateral Arm Systems cannot be used on any home (new or used)
 where the sidewall ties exceed 5 ft 4 in.

Installer's initials LLI

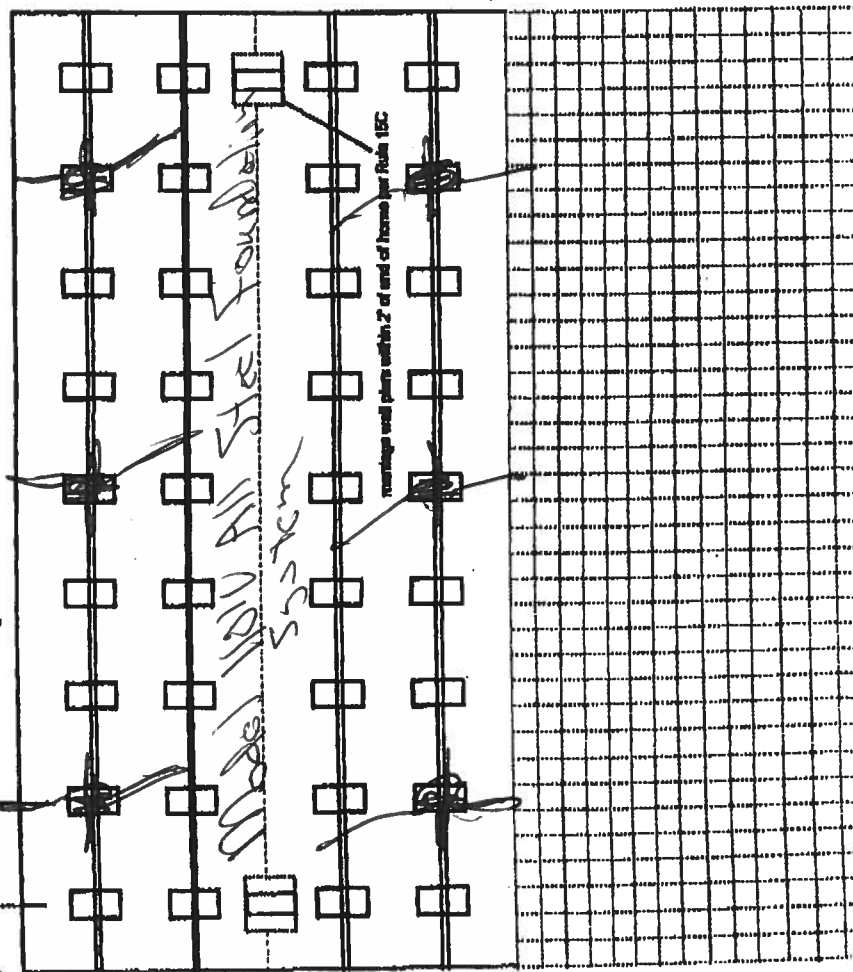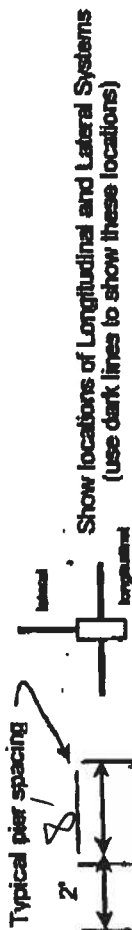

New Home ☒ Used Home ☐
 Home installed to the Manufacturer's Installation Manual ☒
 Home is installed in accordance with Rule 15-C ☐
 Single wide ☐ Wind Zone II ☐ Wind Zone III ☐
 Double wide ☒ Installation Detail # 274622
 Triple/Quad ☐ Serial # _____

PIER SPACING TABLE FOR USED HOMES

Load bearing capacity	Footer size (sq in)	16" x 16" (256)	18 1/2" x 16 1/2" (342)	20" x 20" (400)	22" x 22" (484)	24" x 24" (576)	28" x 28" (784)
1000 psf	3'	4'	4'	5'	6'	7'	8'
1500 psf	4'	6'	6'	7'	8'	8'	8'
2000 psf	6'	8'	8'	8'	8'	8'	8'
2500 psf	7'	8'	8'	8'	8'	8'	8'
3000 psf	8'	8'	8'	8'	8'	8'	8'
3500 psf	8'	8'	8'	8'	8'	8'	8'

* Interpolated from Rule 15C-1 pier spacing table.

PIER PAD SIZES

I-beam pier pad size 17' x 25"
 Perimeter pier pad size 17' x 25"
 Other pier pad sizes (required by the mfg.) _____

POPULAR PAD SIZES

Pad Size	Sq ft
16 x 16	256
16 x 18	288
18.5 x 18.5	342
18 x 22.5	380
17 x 22	374
13 1/4 x 25 1/4	343
20 x 20	400
17 3/8 x 25 3/8	441
17 1/2 x 25 1/2	448
24 x 24	576
26 x 26	676

Draw the approximate locations of marriage wall openings 4 foot or greater. Use this symbol to show the piers.

List all marriage wall openings greater than 4 foot and their pier pad sizes below.

Opening 10' 8" Pier pad size 17' x 25"
18' 8" 17' x 25"
14' 8" 17' x 25"


ANCHORS 4-ft 5 ft
 FRAME TIES within 2' of end of home spaced at 5' 4" oc

TIEDOWN COMPONENTS

Longitudinal Stabilizing Device (LSD)
 Manufacturer _____
 Longitudinal Stabilizing Device w/ Lateral Arms
 Manufacturer _____

OTHER TIES
 Number 3
 Sidelwall _____
 Longitudinal _____
 Marriage wall _____
 Shearwall _____

DIVOR Tech

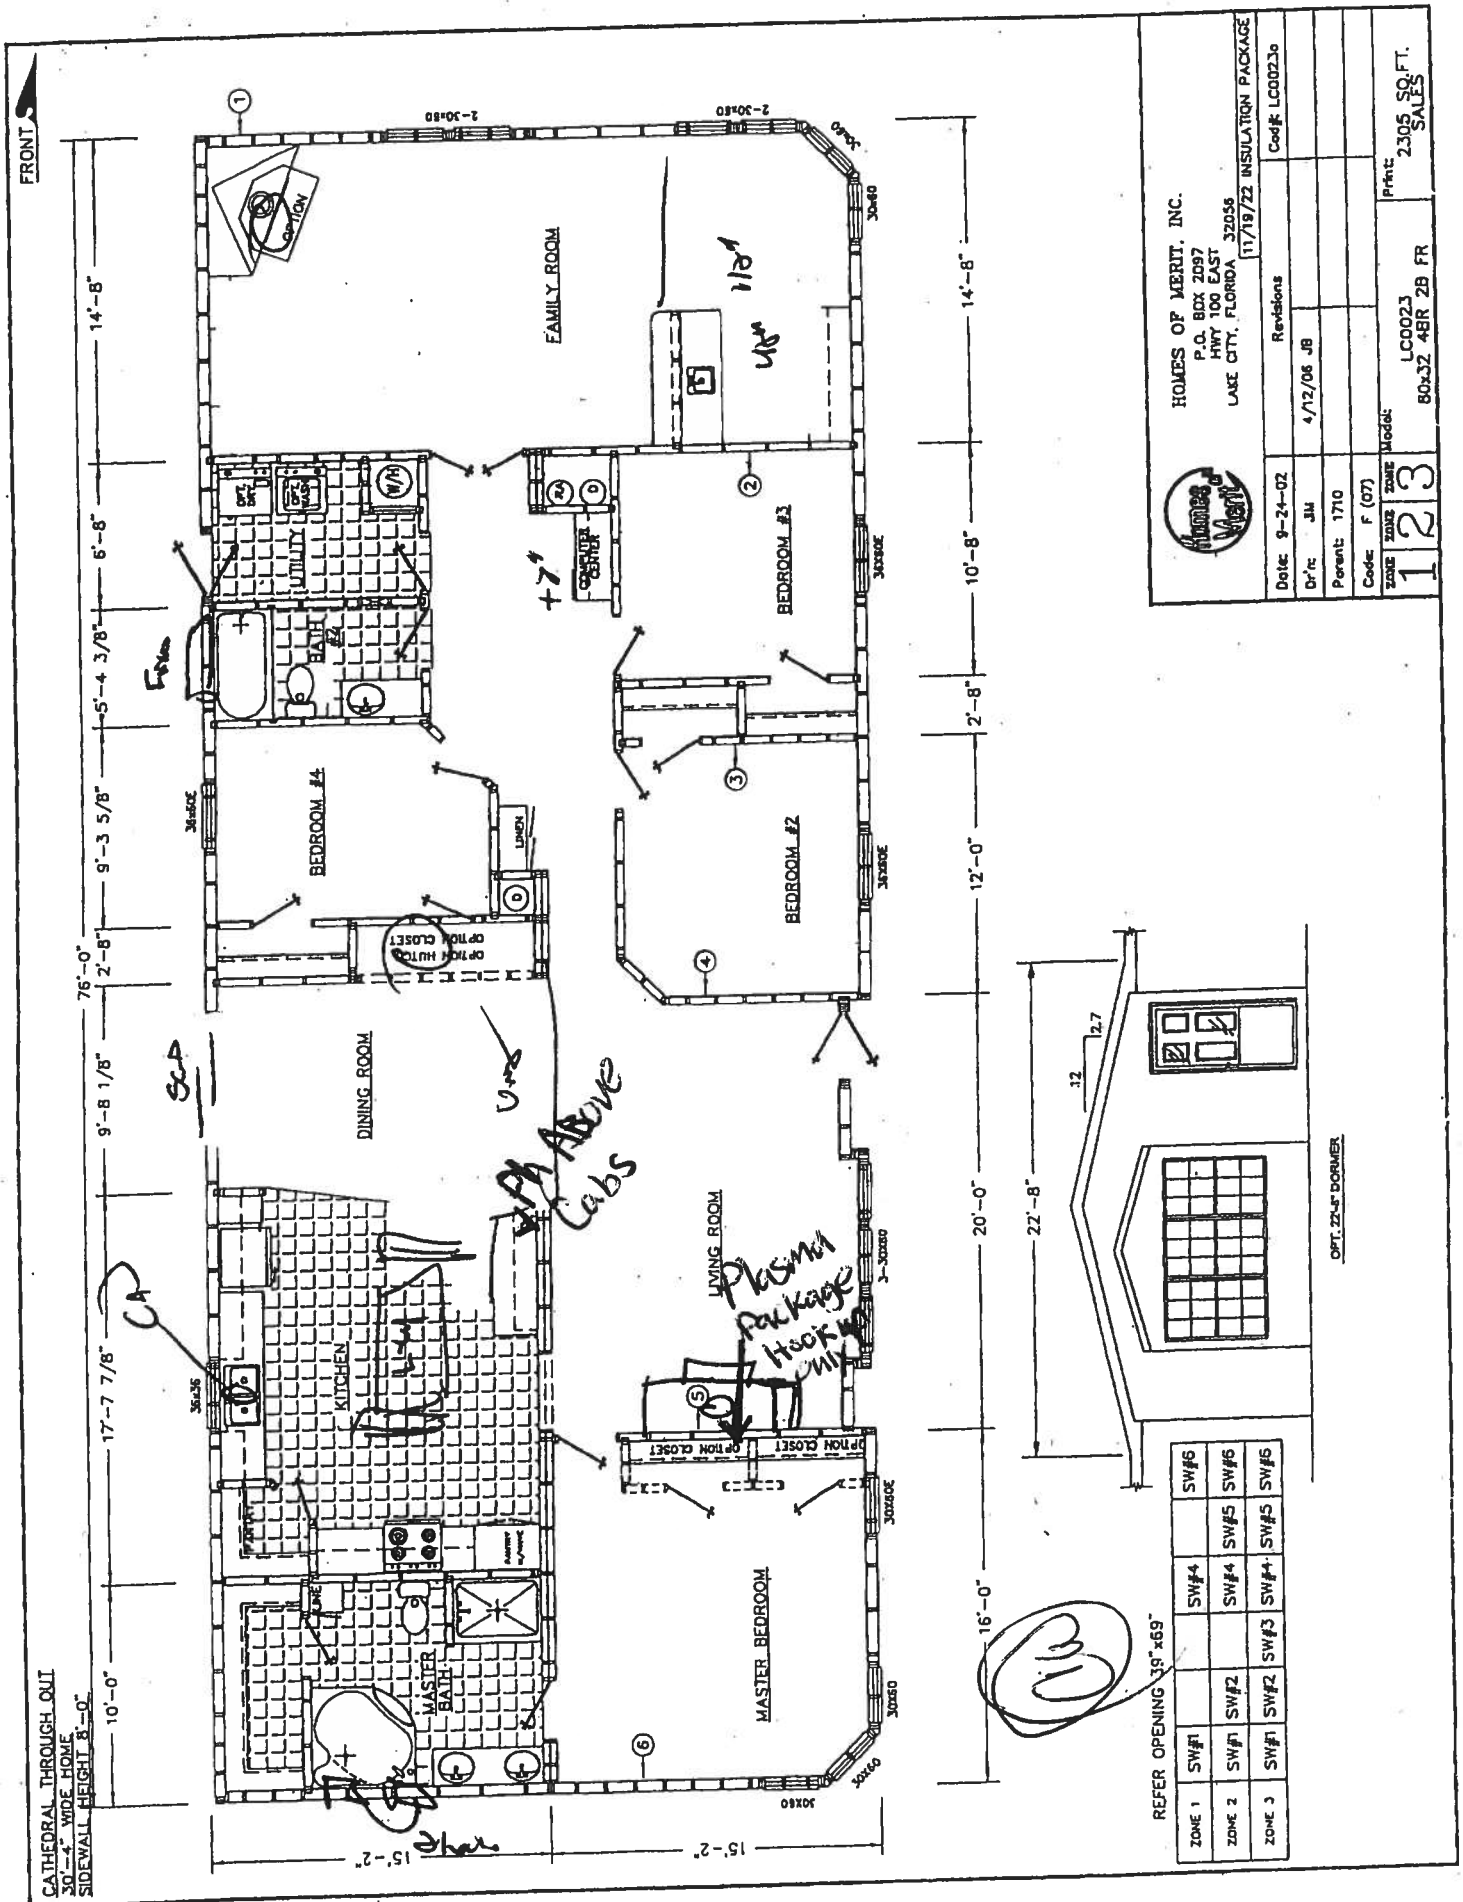

**COLUMBIA COUNTY
FLORIDA**

M/H OCCUPANCY

COLUMBIA COUNTY, FLORIDA

Department of Building and Zoning Inspection

This Certificate of Occupancy is issued to the below named permit holder for the building and premises at the below named location, and certifies that the work has been completed in accordance with the Columbia County Building Code.

Parcel Number 14-5S-15-00459-234

Building permit No. 000025431

Permit Holder TERRY THRIFT

Owner of Building CRAIG WOMER JR

Location: 938 SW MARY TERRACE



Date: 04/04/2007

Harvey Dicks

Building Inspector

**POST IN A CONSPICUOUS PLACE
(Business Places Only)**

