

2434

Building Official [Signature]

Comments _____

☐ Ellsville Water Sys ☒ Assessment Paid on Property ☐ Out County ☐ In County ☒ Sub VF Form

License Number 14-1041936 Installation Decal # 64519

831.76

Mobile Home Permit Worksheet

Application Number: _____

Date: _____



Installer: William E. Fox License # 14-1041434

Address of home being installed 398 Apache Trail
Fort Worth TX 76103

Manufacturer COH Length x width 32x56

NOTE: If home is a single wide fill out one half of the blocking plan
If home is a triple or quad wide sketch in remainder of home
I understand Lateral Arm Systems cannot be used on any home (new or used)
where the sidewall ties exceed 5 ft 4 in.

Installer's initials WEF

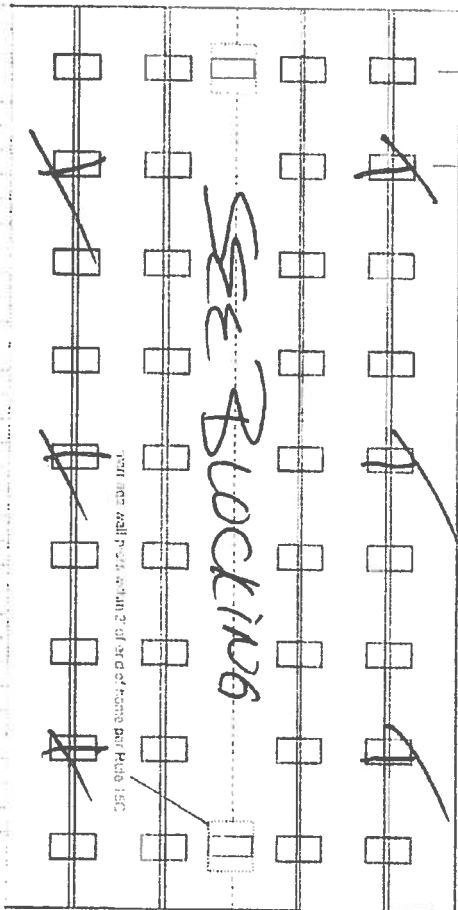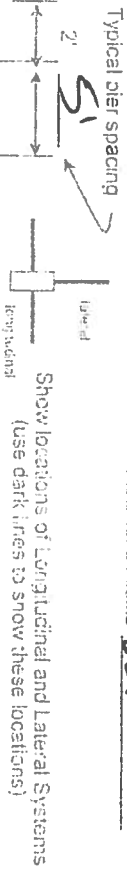

COH
Direct System

New Home ☒ Used Home ☐

Home installed to the Manufacturer's Installation Manual
Home is installed in accordance with Rule 15-C

Single wide ☐ Wind Zone II ☒ Wind Zone III ☐

Double wide ☒ Installation Decal # 14059

Triple/Quad ☐ Serial # 10H6411819750A13

PIER SPACING TABLE FOR USED HOMES

Load bearing capacity (sq in)	16" x 16" (256)	16 1/2" x 18 1/2" (342)	20" x 20" (400)	22" x 22" (484)	24" x 24" (576)	26" x 26" (676)
1000 psf	3'	4'	5'	5'	7'	8'
1500 psf	4' 6"	6'	7'	8'	8'	8'
2000 psf	6'	8'	8'	8'	8'	8'
2500 psf	7' 5"	8'	8'	8'	8'	8'
3000 psf	8'	8'	8'	8'	8'	8'
3500 psf	8'	8'	8'	8'	8'	8'

* Interpolated from Rule 15C-1 pier spacing table.

PIER PAD SIZES

I-beam pier pad size 17x25
Perimeter pier pad size 16x16
Other pier pad sizes (required by the mfg.) _____

Draw the approximate locations of marriage wall openings 4' foot or greater. Use this symbol to show the piers.

List all marriage wall openings greater than 4 foot and their pier pad sizes below.

Opening Large Pier pad size 23x31

TIEDOWN COMPONENTS

Longitudinal Stabilizing Device (LSD)
Manufacturer _____
Longitudinal Stabilizing Device w/ Lateral Arms
Manufacturer Direct Tech

OTHER TIES

Sidewall _____
Longitudinal _____
Marriage wall _____
Shearwall _____

FRAME TIES

within 2' of end of home spaced at 5' 4" oc _____

ANCHORS

Pad Size	Sq In
16 x 16	256
16 x 18	288
16.5 x 18.5	342
16 x 22.5	360
17 x 22	374
13 1/4 x 26 1/4	348
20 x 20	400
17 3/16 x 25 3/16	441
17 1/2 x 25 1/2	446
24 x 24	576
26 x 26	676

Mobile Home Permit Worksheet

POCKET PENETROMETER TEST

The pocket penetrometer tests are rounded down to 1500 psi or check here to declare 1000 lb. soil without testing.

x 1500 x 1500 x 1500

POCKET PENETROMETER TESTING METHOD

1. Test the perimeter of the home at 6 locations.
2. Take the reading at the depth of the footer.
3. Using 500 lb increments, take the lowest reading and round down to that increment.

x 1500 x 1500 x 1500

TORQUE PROBE TEST

The results of the torque probe test is 285 inch pounds or check here if you are declaring 5 anchors without testing. A test showing 275 inch pounds or less will require 5 foot anchors.

Note: A state approved lateral arm system is being used and 4 ft. anchors are allowed at the sidewall locations. I understand 5 ft anchors are required at all centerline tie points where the torque test reading is 275 or less and where the mobile home manufacturer may require anchors with 400 lb holding capacity.

Installer's initials

ALL TESTS MUST BE PERFORMED BY A LICENSED INSTALLER

Installer Name

William R. Price

Date Tested

11/20/19

Electrical

Connect electrical conductors between multi-wide units, but not to the main power source. This includes the bonding wire between multi-wide units. Pg. 1

Plumbing

Connect all sewer drains to an existing sewer tap or septic tank. Pg. 1

Connect all potable water supply piping to an existing water meter, water tap, or other independent water supply systems. Pg. 1

Application Number:

Date:

Site Preparation

Debris and organic material removed 90%

Water drainage: Natural Swale Pad Other

Fastening multi wide units

Floor: Type Fastener 1/4" x 3" screws Length: 18" Spacing: 18"
Walls: Type Fastener 1/4" x 3" screws Length: 18" Spacing: 18"
Roof: Type Fastener 1/4" x 3" screws Length: 18" Spacing: 18"

For used homes a min. 30 gauge, 6" wide, galvanized metal strip will be centered over the peak of the roof and fastened with galv. roofing nails at 2' on center on both sides of the centerline.

Gasket (weatherproofing requirement)

I understand a properly installed gasket is a requirement of all new and used homes and that condensation, mold, mildew, and buckled in-laid walls are a result of a poorly installed or no gasket being installed. I understand a strip of tape will not serve as a gasket.

Installer's initials

Type Gasket EPDM

Installed Between Floors Yes ✓
Between Walls Yes ✓
Bottom of ridgebeam Yes ✓

Weatherproofing

The bottomboard will be repaired and/or taped. Yes ✓ Pg. 1
Siding on units is installed to manufacturer's specifications. Yes ✓
Fireplace chimney installed so as not to allow intrusion of rain water. Yes ✓

Miscellaneous

Skirting to be installed. Yes ✓ No ✓
Dryer vent installed outside of skirting. Yes ✓ N/A ✓
Range downflow vent installed outside of skirting. Yes ✓ N/A ✓
Drain lines supported at 4 foot intervals. Yes ✓ N/A ✓
Electrical crossovers protected. Yes ✓
Other: ✓

Installer verifies all information given with this permit worksheet is accurate and true based on the manufacturer's installation instructions and or Rule 15C-1 & 2

Installer Signature


[Signature]

Date

11/20/19

12.1

Backhoe 12.1

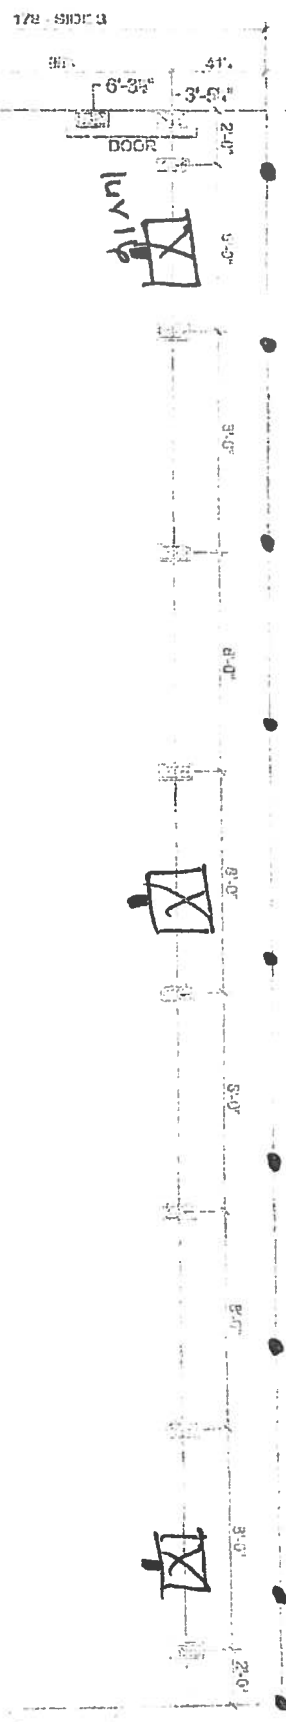

12.1

12.1

12.1

0-TTC down-48" Anchor 5'4" o/c
 0-MAPPLAGE LINE OPENING SUPPORT PIERCE - 17X25THBS OR 23X23
 0-SUPPORT PIERCE - 17X25THBS OR 23X23

FOUNDATION NOTES:

1. THIS DRAWING IS DESIGNED FOR THE STANDARD YARD LINE AND IS TO BE USED IN CONJUNCTION WITH THE INSTALLATION MANUAL AND THE SUPPLEMENTARY NOTES ARE SHOWN FOR EXAMPLE ONLY QUANTITY AND SPECIFICATIONS MAY VARY BASED ON PAD TYPE, SOIL CONDITION, ETC.

12.1

0-OLIVER SYSTEM

LIVE OAK HOMES

MODEL S-3583A-SVS - 32 X 56

3-BEDROOM / 2-BATH

0-Double Frame TTC-48" Anchor 5'4" o/c from end then 12' o/c

- (1) MAIN ELECTRICAL
- (2) ELECTRICAL CROSSOVER
- (3) WATER INLET
- (4) WATER CROSSOVER (IF ANY)
- (5) GAS INLET (IF ANY)
- (6) GAS CROSSOVER (IF ANY)
- (7) DUCT CROSSOVER
- (8) SEWER DROPS
- (9) RETURN AIR (W/DOPT. HEAT PUMP OR DUCT)
- (10) SUPPLY AIR (W/DOPT. HEAT PUMP OR DUCT)

S-3583A-SVS