



Mobile Home Permit Worksheet



Installer Dade Houston License # IH 1133271

Address of home being installed _____

Manufacturer CAVCO Length x width 28x60

NOTE: If home is a single wide fill out one half of the blocking plan
If home is a triple or quad wide sketch in remainder of home
I understand Lateral Arm Systems cannot be used on any home (new or used)
where the sidewall ties exceed 5 ft 4 in

Installer's initials DH

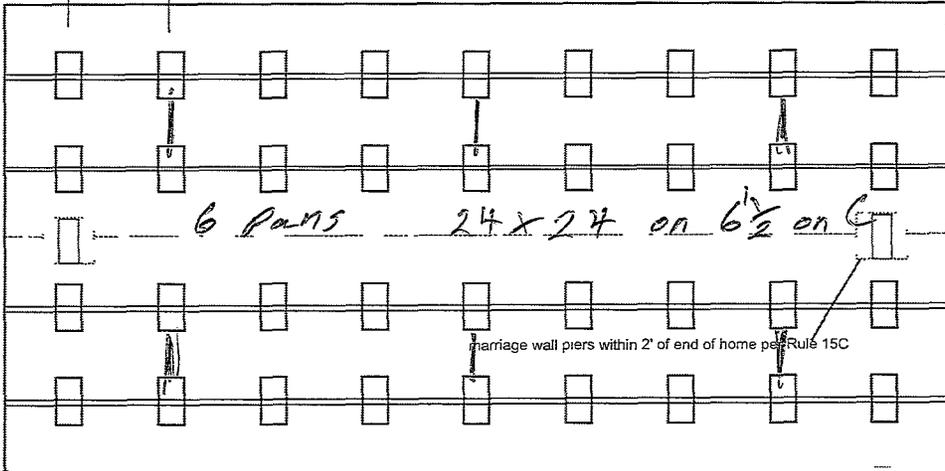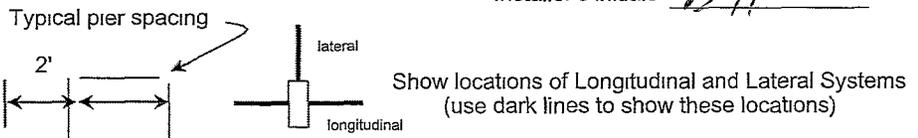

Permit Number: _____ Date: _____

New Home Used Home

Home installed to the Manufacturer's Installation Manual
Home is installed in accordance with Rule 15-C

Single wide Wind Zone II Wind Zone III

Double wide Installation Decal # 123576

Triple/Quad Serial # CAV340FL25-24404AB

PIER SPACING TABLE FOR USED HOMES

Load bearing capacity	Footer size (sq in)	16" x 16" (256)	18 1/2" x 18 1/2" (342)	20" x 20" (400)	22" x 22" (484)*	24" X 24" (576)*	26" x 26" (676)
1000 psf		3'	4'	5'	6'	7'	8'
1500 psf		4'6"	6'	7'	8'	8'	8'
2000 psf		6'	8'	8'	8'	8'	8'
2500 psf		7'6"	8'	8'	8'	8'	8'
3000 psf		8'	8'	8'	8'	8'	8'
3500 psf		8'	8'	8'	8'	8'	8'

*interpolated from Rule 15C-1 pier spacing table.

PIER PAD SIZES

I-beam pier pad size 24x24

Perimeter pier pad size 17x23

Other pier pad sizes (required by the mfg.) _____

Draw the approximate locations of marriage wall openings 4 foot or greater Use this symbol to show the piers.

List all marriage wall openings greater than 4 foot and their pier pad sizes below

Opening	Pier pad size
_____	<u>24x24</u>
_____	_____

POPULAR PAD SIZES

Pad Size	Sq In
16 x 16	256
16 x 18	288
18 5 x 18.5	342
16 x 22.5	360
17 x 22	374
13 1/4 x 26 1/4	348
20 x 20	400
17 3/16 x 25 3/16	441
17 1/2 x 25 1/2	446
24 x 24	576
26 x 26	676

4 ft 5 ft

ANCHORS

FRAME TIES

within 2' of end of home spaced at 5' 4" oc _____

TIEDOWN COMPONENTS

Longitudinal Stabilizing Device (LSD)
Manufacturer _____
Longitudinal Stabilizing Device w/ Lateral Arms
Manufacturer _____

OTHER TIES

	Number
Sidewall	<u>2</u>
Longitudinal	<u>6</u>
Marriage Wall	<u>2</u>
Shear Wall	<u>4</u>



Mobile Home Permit Worksheet

POCKET PENETROMETER TEST

The pocket penetrometer tests are rounded down to _____ psf or check here to declare 1000 lb. soil without testing.

X _____ X _____ X _____

POCKET PENETROMETER TESTING METHOD

1. Test the perimeter of the home at 6 locations.
2. Take the reading at the depth of the footer.
3. Using 500 lb increments, take the lowest reading and round down to that increment.

X _____ X _____ X _____

TORQUE PROBE TEST

The results of the torque probe test is 285 inch pounds or check here if you are declaring 5' anchors without testing _____. A test showing 275 inch pounds or less will require 5' anchors

Note: A state approved lateral arm system is being used and 4 ft. anchors are allowed at the sidewall locations. I understand 5' anchors are required at all centerline tie points where the torque test reading is 275 or less and where the mobile home manufacturer may require anchors with 4000 lb. holding capacity

Installer's initials DH

ALL TESTS MUST BE PERFORMED BY A LICENSED INSTALLER

Installer Name Dale Houston

Date Tested 12/7/25

ELECTRICAL

Connect electrical conductors between multi-wide units, but not to the main power source. This includes the bonding wire between multi-wide units. Pg. _____

PLUMBING

Connect all sewer drains to an existing sewer tap or septic tank Pg. _____

Connect all potable water supply piping to an existing water meter, water tap, or other independent water supply systems Pg. _____

Permit Number: _____

Date: _____

Site Preparation

Debris and organic material removed _____

Water drainage Natural _____ Swale _____ Pad _____ Other _____

Fastening multi wide units

Floor- Type Fastener: Nails Length 6" Spacing 18"

Walls- Type Fastener: 1" Length 1" Spacing 1"

Roof- Type Fastener: 1" Length: 1" Spacing: 1"

For used homes a min. 30 gauge, 8" wide, galvanized metal strip will be centered over the peak of the roof and fastened with galv roofing nails at 2" on center on both sides of the centerline.

Gasket (weatherproofing requirement)

I understand a properly installed gasket is a requirement of all new and used homes and that condensation, mold, mildew and buckled marriage walls are a result of a poorly installed or no gasket being installed I understand a strip of tape will not serve as a gasket.

Installer's initials DH

Type gasket Foam

Installed

Pg _____

Between Floors _____ Yes

Between Walls _____ Yes

Bottom of ridge beam _____ Yes

Weatherproofing

The bottom board will be repaired and/or taped. _____ Yes Pg. _____

Siding on units is installed to manufacturer's specifications. _____ Yes

Fireplace chimney installed so as not to allow intrusion of rain water _____ Yes

Miscellaneous

Skirting to be installed. _____ Yes _____ No _____ N/A _____

Dryer vent installed outside of skirting _____ Yes _____ No _____ N/A _____

Range downflow vent installed outside of skirting. _____ Yes _____ No _____ N/A _____

Drain lines supported at 4' intervals. _____ Yes _____ No _____ N/A _____

Electrical crossovers protected. _____ Yes _____ No _____ N/A _____


Other _____

Installer verifies all information given with this permit worksheet is accurate and true based on the manufacturer's installation instructions and or Rule 15C-1 & 2

Installer's Signature Dale Houston

Date _____

Lifestyle Series

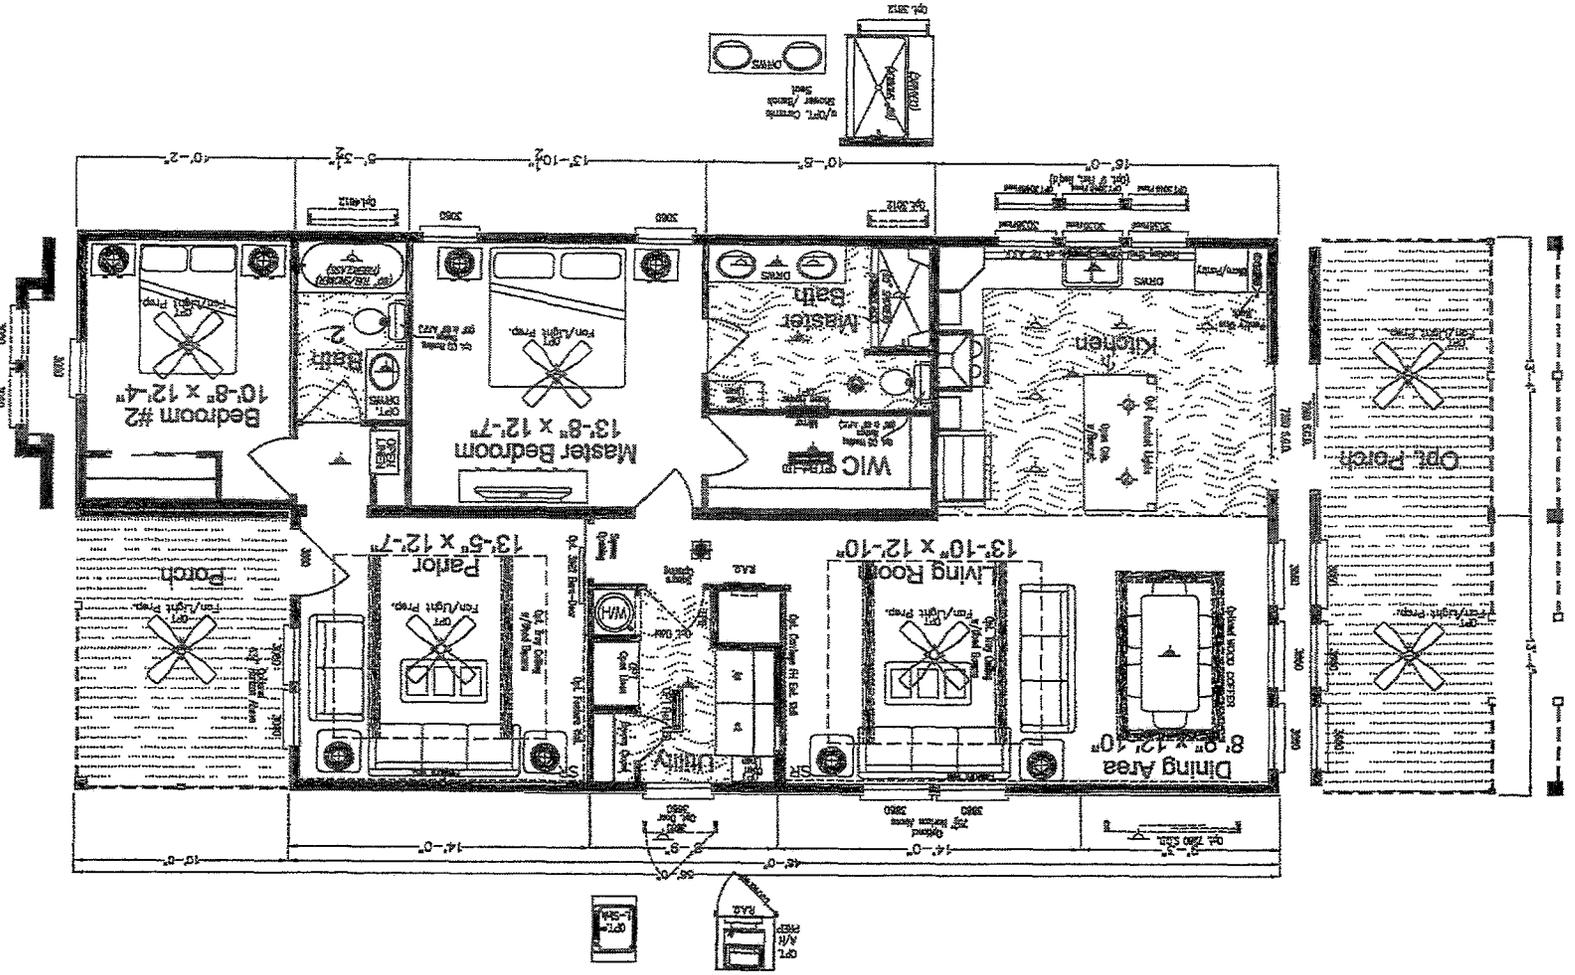

Lifestyle Series

Carriage Farmhouse
 Model 340LS2552K
 Approx 1,363 Sq Ft.

26' 8" - 56'
 Lifestyle Front Porch w/
 120 sq. feet of Outdoor
 Living Area
 Island Kitchen
 Triple Full View Windows in Kitchen


Bonus Utility Room
 Opt. Full Porch
 Large Master Suite w/
 Walk-in Closet
 Open Social Area



Copyright © Palm Harbor Homes, Inc. Because Palm Harbor Homes has a continuous product updating and improvement process, price, plans, dimensions, features, materials, specifications and availability are subject to change without notice or obligation. Please refer to working drawings for actual dimensions. Handings and floor plans are artist depictions only and may vary from the completed home. Square footages and room dimensions are approximate and subject to industry standards.

Rev 04/28/20

Lifestyle Series

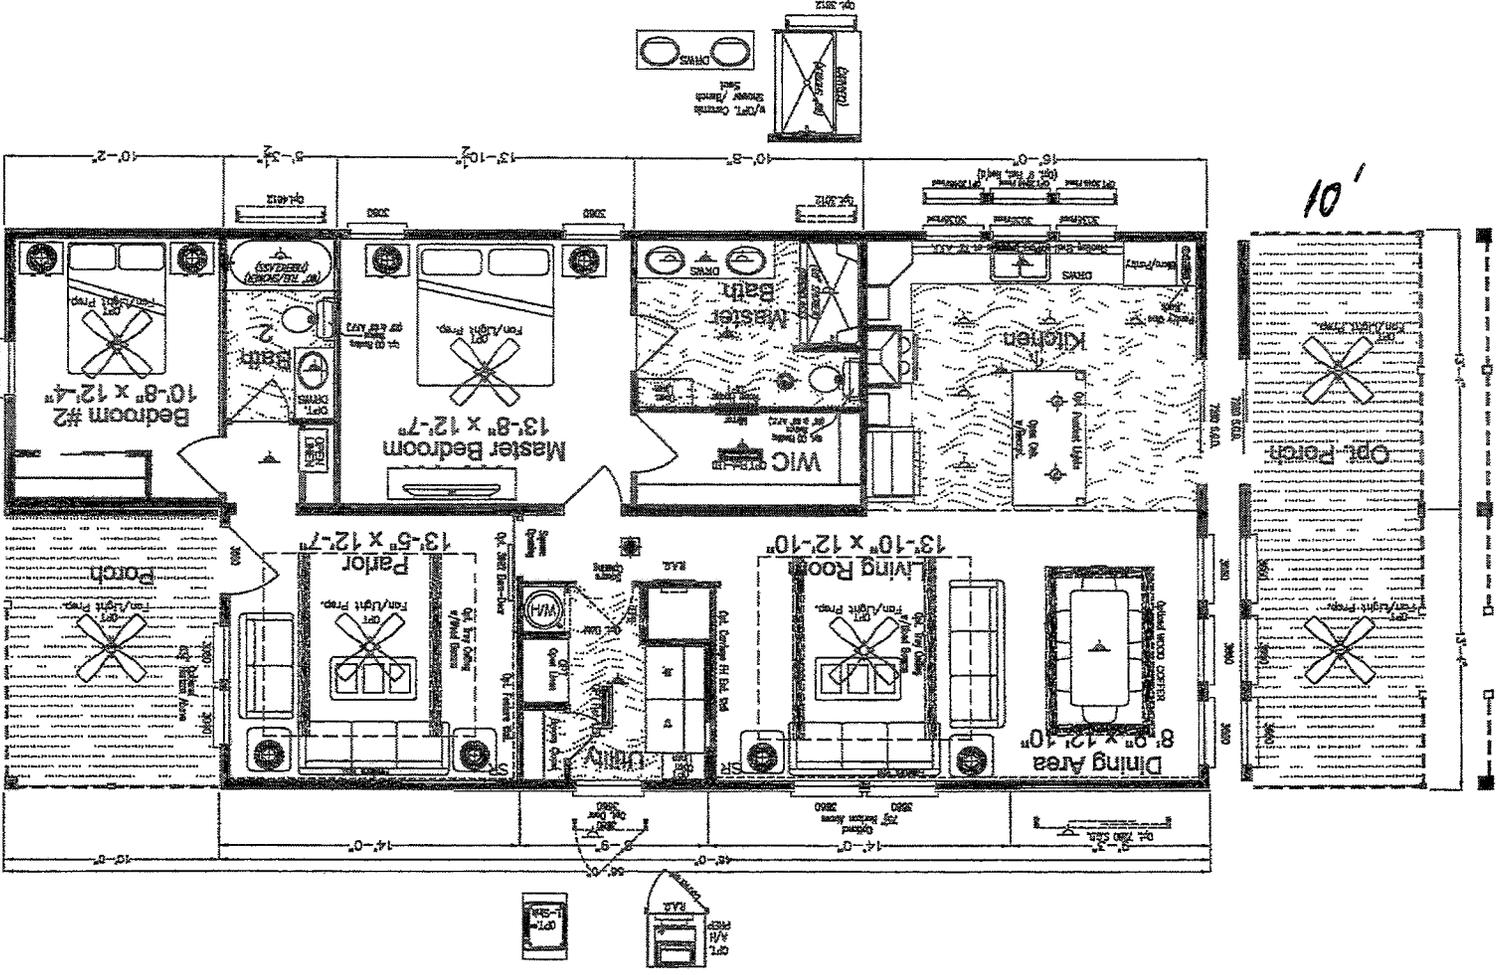

Carriage Farmhouse
 Model 340LS2552K
 Approx 1,363 Sq Ft

26.8' - 56'
 Lifestyle Front Porch w/
 120 sq. feet of Outdoor
 Living Area
 Island Kitchen
 Triple Full View Windows in Kitchen
 Bonus Utility Room
 Opt. Full Porch
 Large Master Suite w/
 Walk-In Closet
 Open Social Area

Copyright © Palm Harbor Homes, Inc. Because Palm Harbor Homes has a continuous product updating and improvement process, prices, plans, dimensions, features, materials, specifications and availability are subject to change without notice or obligation. Please refer to working drawings for actual dimensions. Renderings and floor plans are artist depictions only and may vary from the completed home. Square footage calculations and room dimensions are approximate and subject to industry standards.
 Rev 04/28/20

M g.

License Number: IH / 1133271 / 1 Name: DALE HOUSTON

Order #: 6743	Label #: 123576	Manufacturer:	(Check Size of Home)
Homeowner:		Year Model:	Single _____
Address:		Length & Width:	Double _____
City/State/Zip:		Type Longitudinal System:	Triple _____
Phone #:		Type Lateral Arm System:	HUD Label #:
Date Installed:		New Home: _____ Used Home: _____	Soil Bearing / PSF:
Installed Wind Zone:		Data Plate Wind Zone:	Torque Probe / In-lbs
Note:			Permit #

STATE OF FLORIDA
INSTALLATION CERTIFICATION LABEL

123576

LABEL #

DATE OF INSTALLATION

DALE HOUSTON

NAME

IH / 1133271 / 1

6743

LICENSE #

ORDER #

CERTIFIES THAT THE INSTALLATION OF THIS MOBILE HOME IS
IN ACCORDANCE WITH FLORIDA STATUTES 320.8249, 320.8325
AND RULES OF THE HIGHWAY SAFETY AND MOTOR VEHICLES.

INSTRUCTIONS

PLEASE WRITE DATE OF
INSTALLATION AND AFFIX
LABEL NEXT TO HUD LABEL.
USE PERMANENT INK PEN
OR MARKER ONLY.
COMPLETE INFORMATION
ABOVE AND KEEP ON FILE
FOR A MINIMUM OF 2 YEARS.
YOU ARE REQUIRED TO
PROVIDE COPIES WHEN
REQUESTED.



Chickadee Camp

Find address or place



NW McClellan Ln

Mobile Home

Roof Replacement or Repair

Remodel

280

298

282

77

Mobile Home

Mobile Home

Mobile Home

Storage Building

Electrical Service

NW Daughtry Ln

Mobile Home

290

Electrical

Remodel

Roof Replacement or Repair

Mobile Home

Mobile Home

NW Turnberry Dr

284

298

312

326

340

354

368

382

396

410

424

438

452

Mobile Home

Electrical Service

Electrical Service

Electrical Service

DISTRICT

NW Brown Rd

Mobile Home

Electrical Service

NW Winding Pl

Mobile Home

Electrical Service

Mobile Home

NW Willard Brook Ln

Electrical Service

Mobile Home

Mobile Home

310

324

338

352

366

380

394

408

422

436

450

464

Mobile Home

Remodel

Mobile Home

Electrical Service

276

Roof Replacement or Repair

Remodel

Remodel

-82.709 30 196 Degrees