

COUCH


PERM WORKSHEET

Page 1 of 2

PERMIT NUMBER

Installer DAVID ALBRIGHT License # 1H 1129420Address of home being installed 241 N.W. IAN CT.
LAKE CITY FL, 32055Manufacturer LIVE OAK Length x width 28X60/64NOTE: If home is a single wide fill out one half of the blocking plan
If home is a triple or quad wide sketch in remainder of homeI understand Lateral Arm Systems cannot be used on any home (new or used)
where the sidewall ties exceed 5 ft 4 in.Installer's initials DA

Typical pier spacing

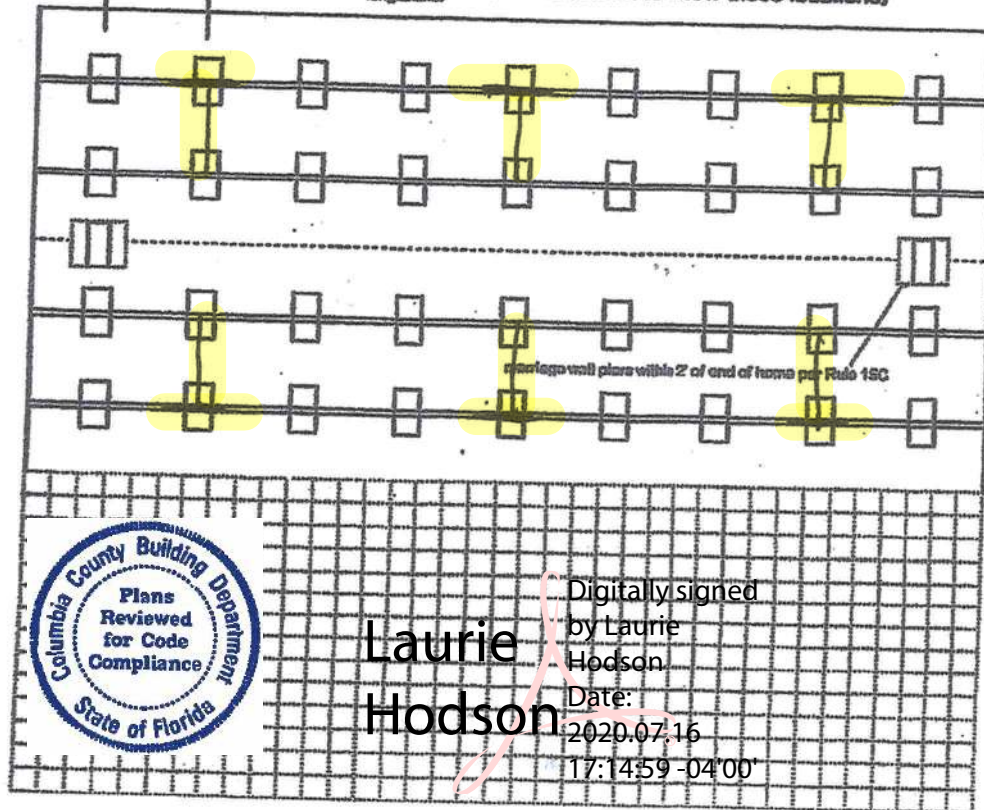Show locations of Longitudinal and Lateral Systems
(use dark lines to show these locations)

Digitally signed
by Laurie
Hodson
Date:
2020.07.16
17:14:59 -04'00'

New Home ☒ Used Home ☐Home installed to the Manufacturer's Installation Manual ☒Home is installed in accordance with Rule 15-C ☐Single wide ☐ Wind Zone II ☒ Wind Zone III ☐Double wide ☒ Installation Decal # 71608Triple/Quad ☐ Serial # 60H6A 32035647 A/B

PIER SPACING TABLE FOR USED HOMES

Load bearing capacity	Footer size (sq in)	16" x 16" (256)	18 1/2" x 18 1/2" (342)	20" x 20" (400)	22" x 22" (484)	24" x 24" (576)	26" x 26" (676)
1000 psf		3'	4'	5'	6'	7'	8'
1500 psf		4'	6'	7'	8'	9'	10'
2000 psf		6'	8'	9'	10'	11'	12'
2500 psf		7'	9'	10'	11'	12'	13'
3000 psf		8'	10'	11'	12'	13'	14'
3500 psf		8'	10'	11'	12'	13'	14'

* Interpolated from Rule 15C-1 pier spacing table.

PIER PAD SIZES

I-beam pier pad size 17x22Perimeter pier pad size 16x16Other pier pad sizes (required by the mfg.) 23x31

Draw the approximate locations of marriage wall openings 4 foot or greater. Use this symbol to show the piers.

List all marriage wall openings greater than 4 foot and their pier pad sizes below.

Opening Pier pad size

FACTORY DIAGRAM

TEDOWN COMPONENTS

Longitudinal Stabilizing Device (LSD)
Manufacturer
Longitudinal Stabilizing Device w/ Lateral Arms
Manufacturer

POPULAR PAD SIZES

Pad Size	Sq In
16 x 16	256
16 x 18	288
18.5 x 18.5	342
16 x 22.5	360
17 x 22	374
13 1/4 x 26 1/4	348
20 x 20	400
17 1/2 x 22 1/2	432
17 3/16 x 25 3/16	441
24 x 24	576
26 x 26	676

ANCHORS

GA

GB

FRAME TIES

within 2' of end of home
spaced at 5' 4" oc

OTHER TIES

Sidewall
Longitudinal
Marriage wall
Shearwall

Number
24
6
25' 5-4'
2

PERMIT WORKSHEET

page 2 of 2

PERMIT NUMBER _____

POCKET PENETROMETER TEST

The pocket penetrometer tests are rounded down to 1500 psf or check here to declare 1000 lb. soil _____ without testing.

X 1500

X 1500

X 1500

POCKET PENETROMETER TESTING METHOD

1. Test the perimeter of the home at 6 locations.
2. Take the reading at the depth of the footer.
3. Using 500 lb. increments, take the lowest reading and round down to that increment.

X 1500

X 1500

X 1500

TORQUE PROBE TEST

The results of the torque probe test is 285 inch pounds or check here if you are declaring 5' anchors without testing _____. A test showing 275 inch pounds or less will require 5 foot anchors.

Note: A state approved lateral arm system is being used and 4 ft. anchors are allowed at the sidewall locations. I understand 5 ft. anchors are required at all centerline tie points where the torque test reading is 275 or less and where the mobile home manufacturer may require anchors with 4000 lb. holding capacity.

NA Installer's initials

ALL TESTS MUST BE PERFORMED BY A LICENSED INSTALLER

Installer Name

DAVID AIBRIGHT

Date Tested

Electrical

Connect electrical conductors between multi-wide units, but not to the main power source. This includes the bonding wire between multi-wide units. Pg. 18-19

Plumbing

Connect all sewer drains to an existing sewer tap or septic tank. Pg. 19-20

Connect all potable water supply piping to an existing water meter, water tap, or other independent water supply systems. Pg. 18-19



Site Preparation

Debris and organic material removed ☒ Pad ☒ Other _____
Water drainage: Natural _____ Swale _____

Fastening multi-wide units

Floor: Type Fastener: LACS Length: 6" Spacing: 2'
Walls: Type Fastener: 3x6WS Length: 3" Spacing: 18"
Roof: Type Fastener: LACS Length: 6" Spacing: 2'
For used homes a min. 30 gauge, 8" wide, galvanized metal strip will be centered over the peak of the roof and fastened with galv. roofing nails at 2" on center on both sides of the centerline.

Gasket (weatherproofing requirement)

I understand a properly installed gasket is a requirement of all new and used homes and that condensation, mold, mildew and buckled marriage walls are a result of a poorly installed or no gasket being installed. I understand a strip of tape will not serve as a gasket.

Installer's Initials

HA

Type gasket FACTORY
Pg. 41

Installed:

Between Floors Yes ☒
Between Walls Yes ENDS ☒
Bottom of ridgebeam Yes ☒

Weatherproofing

The bottomboard will be repaired and/or taped. Yes _____ Pg. _____
Siding on units is installed to manufacturer's specifications. Yes _____
Fireplace chimney installed so as not to allow intrusion of rain water. Yes _____

Miscellaneous


Skirting to be installed. Yes No ☒
Dryer vent installed outside of skirting. Yes _____ N/A ☒
Range downflow vent installed outside of skirting. Yes _____ N/A ☒
Drain lines supported at 4 foot intervals. Yes ☒
Electrical crossovers protected. Yes ☒
Other: _____

Installer verifies all information given with this permit worksheet is accurate and true based on the

Installer Signature

David Aibright

Date

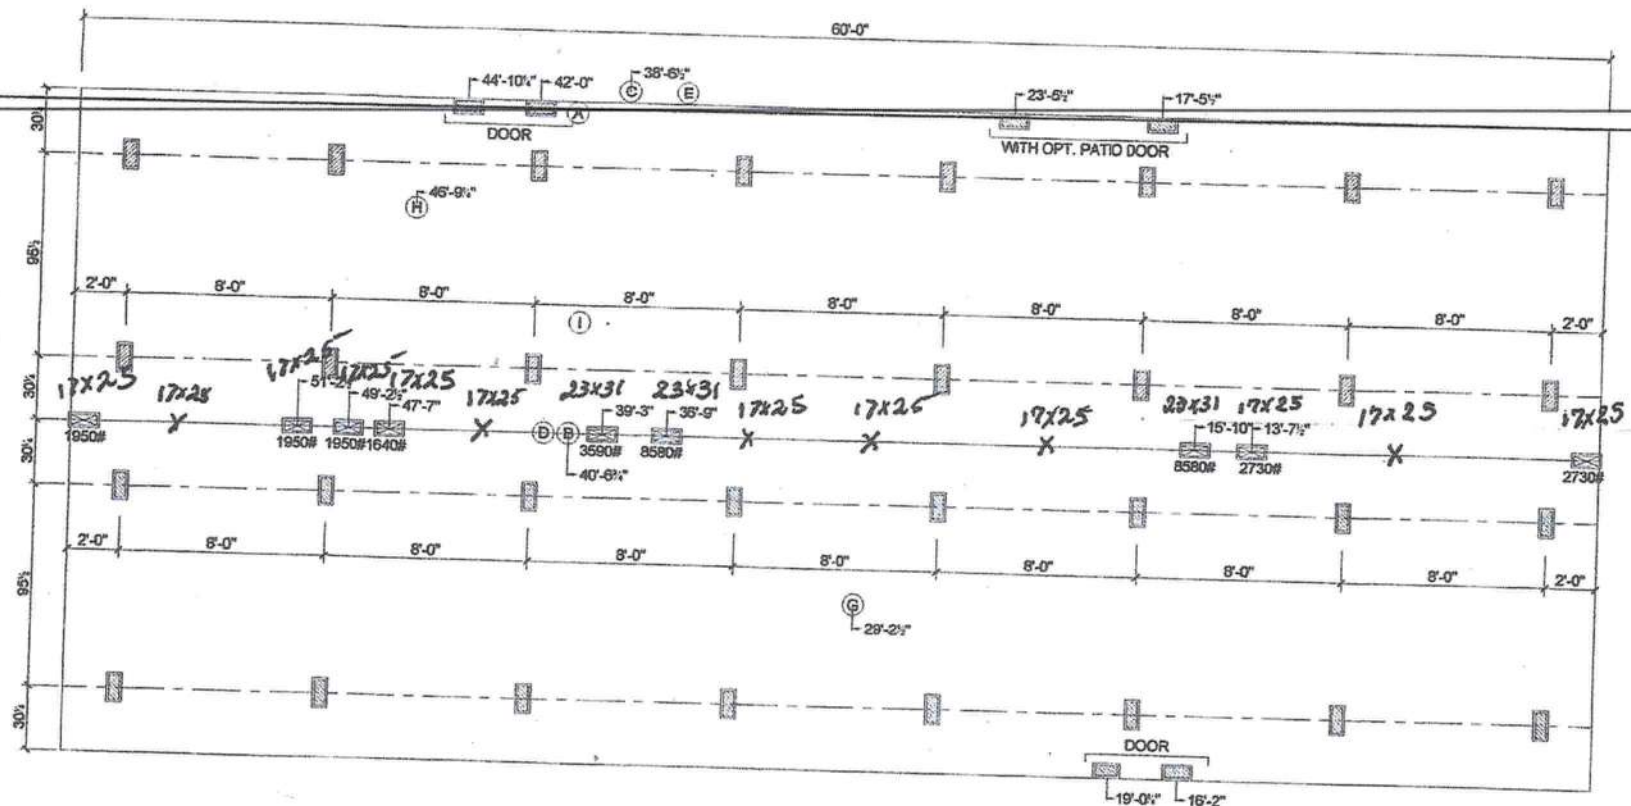

MARRIAGE LINE OPENING SUPPORT PIER/TYP.
 SUPPORT PIER/TYP.

FOUNDATION NOTES:

- THIS DRAWING IS DESIGNED FOR THE STANDARD WIND ZONE AND IS TO BE USED IN CONJUNCTION WITH THE INSTALLATION MANUAL AND ITS SUPPLEMENTS.
- FOOTINGS ARE SHOWN FOR EXAMPLE ONLY QUANTITY AND SPACING MAY VARY BASED ON PAD TYPE, SOIL CONDITION, ETC.
- FOOTINGS ARE REQUIRED AT SUPPORT POSTS, SEE INSTALLATION MANUAL FOR REQUIREMENTS.


Live Oak Homes
MODEL: L-2603G - 28 X 60
3-BEDROOM / 2-BATH

- | | |
|------------------------------|---|
| (A) MAIN ELECTRICAL | (G) DUCT CROSSOVER |
| (B) ELECTRICAL CROSSOVER | (H) SEWER DROPS |
| (C) WATER INLET | (I) RETURN AIR (W/OPT. HEAT PUMP OH DUCT) |
| (D) WATER CROSSOVER (IF ANY) | (J) SUPPLY AIR (W/OPT. HEAT PUMP OH DUCT) |
| (E) GAS INLET (IF ANY) | |
| (F) GAS CROSSOVER (IF ANY) | |



L-2603G

License Number: IH / 1129420 / 1 Name: DAVID E ALBRIGHT			
Order #: 4444	Label #: 71608	Manufacturer: LIVE OAK	(Check Size of Home)
Homeowner: COUCH	Year Model: 2020		Single _____
Address: 241 N.W. 1AN CT.	Length & Width: 60/64 x 28		Double ☒ _____
City/State/Zip: LAKE CITY FL 32055	Type Longitudinal System: OTI		Triple _____
Phone #:	Type Lateral Arm System: OTI		HUD Label #:
Date Installed:	New Home: ☒ Used Home: _____		Soil Bearing / PSF:
Installed Wind Zone: #	Data Plate Wind Zone: #		Torque Probe / in-lbs:
			Permit #:
Note:			


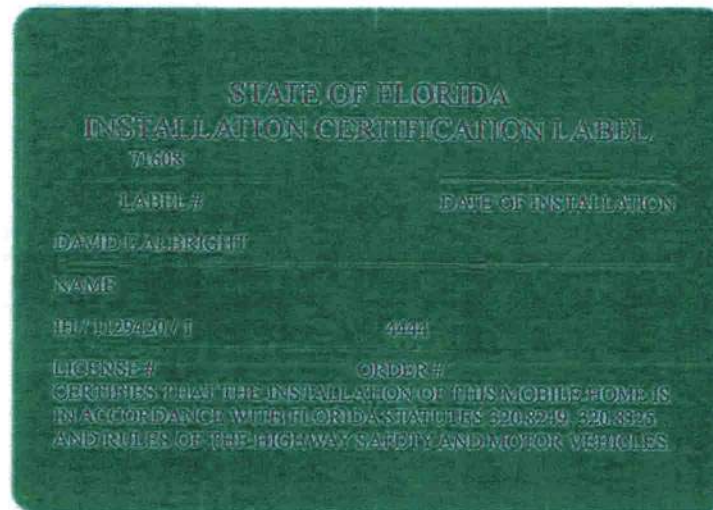


INSTRUCTIONS

PLEASE WRITE DATE OF INSTALLATION AND AFFIX LABEL NEXT TO HUD LABEL. USE PERMANENT INK PEN OR MARKER ONLY. COMPLETE INFORMATION ABOVE AND KEEP ON FILE FOR A MINIMUM OF 2 YEARS. YOU ARE REQUIRED TO PROVIDE COPIES WHEN REQUESTED.



GUNNER

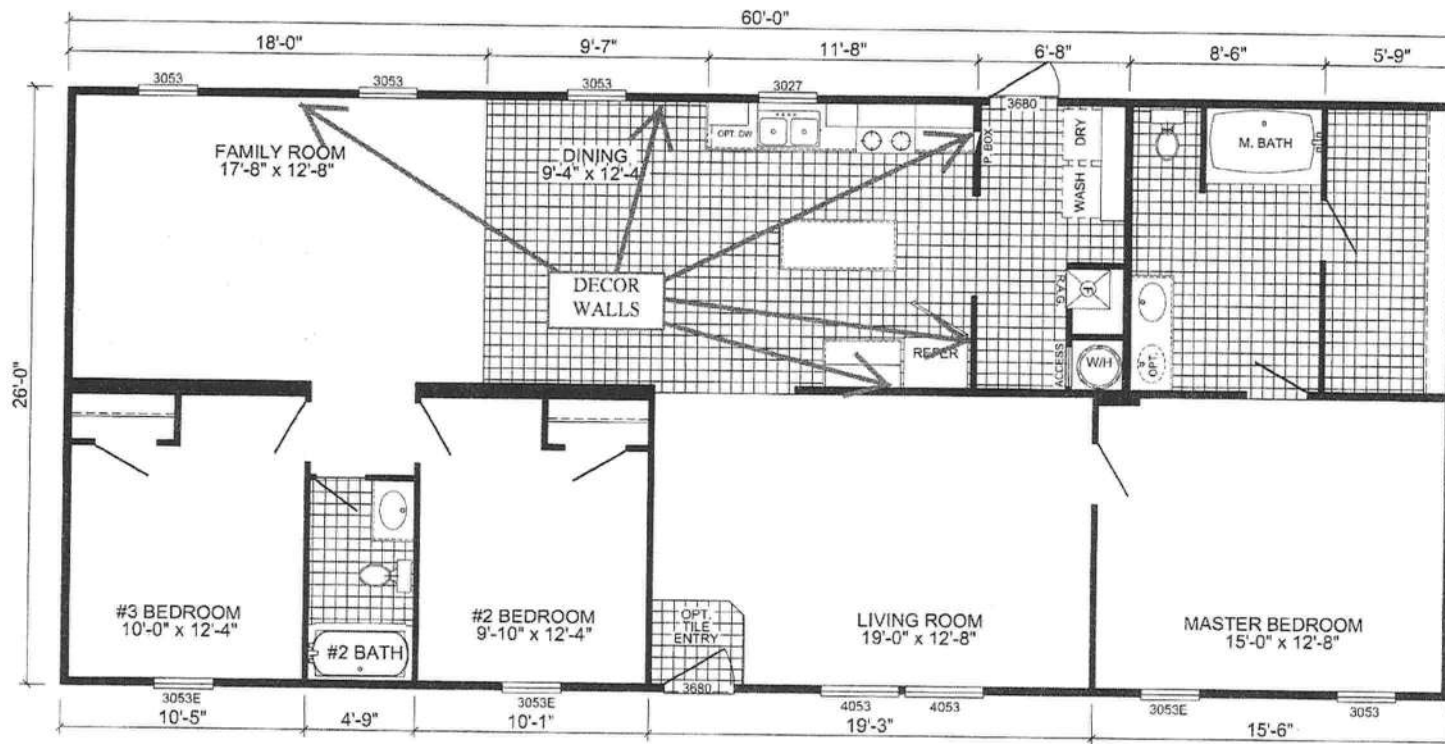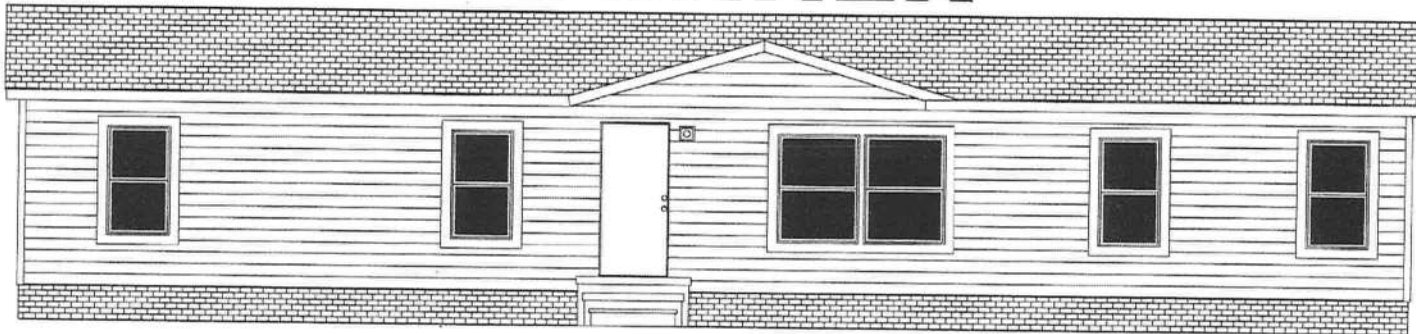

L-2603G-RUNNER

3-BEDROOM / 2-BATH

28 x 64 - Approx. 1560 Sq. Ft.

Date: 02/08/19

- * All room dimensions include closets and square footage figures are approximate.
- * Live Oak Homes reserves the right to change product offering at any time.

