


Lot 6 651
BRANDON

These worksheets must be completed and signed by the installer.
Submit the originals with the packet.

Installer **DAVID ALBRIGHT** License # **IH/1129420**
 911 Address where home is being installed, **160 N.W. CHITNEY GLN**
 Manufacturer **LIVE OAK HOMES** Length x width **32024 48x70/74**
 NOTE: If home is a single wide fill out one half of the blocking plan
 If home is a triple or quad write sketch in remainder of home
 I understand Lateral Arm Systems cannot be used on any home (new or used)
 where the sidewall ties exceed 5 ft 4 in.
 Installer's initials **DA**

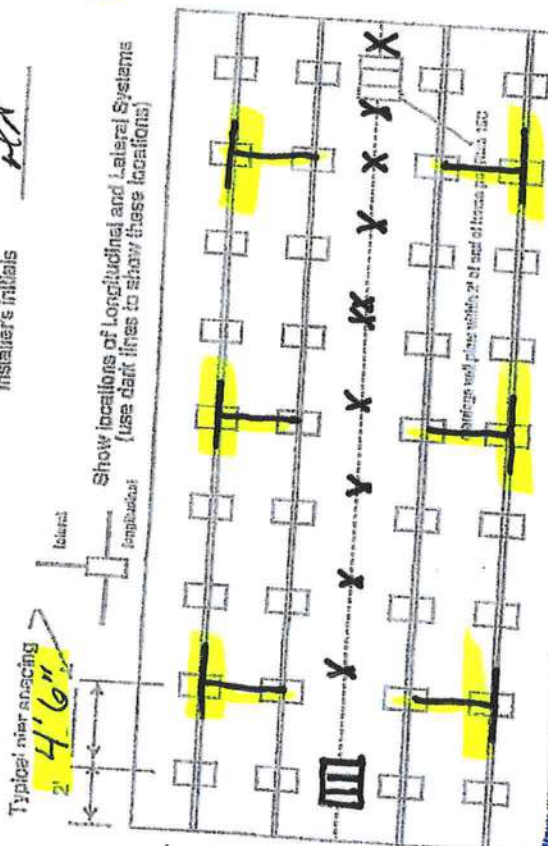

William X Stein
 04/07/2021

ROYAL V-2703A

48030

page 1 of 2

New Home ☒ Used Home ☐
 Home installed to the Manufacturer's Installation Manual ☒
 Home is installed in accordance with Rule 15-G ☐
 Single wide ☐ Wind-Zone II ☒ Wind Zone III ☐
 Double wide ☒ Installation Detail # **71613**
 Triple/Quad ☐ Serial # **LOHGA 220 35751 A/B**

PIER SPACING TABLE FOR USED HOMES

Load bearing capacity	12" x 16" (256)	18 1/2" x 18 1/2" (542)	20" x 20" (400)	22" x 22" (484)	24" x 24" (576)	26" x 26" (676)
1000 Df	3'	4'	5'	6'	7'	8'
1500 Df	4'	5'	6'	7'	8'	9'
2000 Df	5'	6'	7'	8'	9'	10'
2500 Df	6'	7'	8'	9'	10'	11'
3000 Df	7'	8'	9'	10'	11'	12'
3500 Df	8'	9'	10'	11'	12'	13'
Interpolated from Rule 15-G-1 pier spacing table.						

POPULAR PAD SIZES

Pad Size	Sq. In
16 x 16	256
16 x 18	288
18 x 18	324
16 x 20	320
18 x 20	360
20 x 20	400
18 x 22	396
20 x 22	440
22 x 22	484
24 x 24	576
26 x 26	676

Basement pier pad size **17x22**
 Perimeter pier pad size **17x25**
 Other pier pad sizes (required by the mfg.) **23x31**

Draw the approximate locations of marriage wall openings 4 foot or greater. Use this symbol to show the piers.

List all marriage wall openings greater than 4 foot and their pier pad sizes below.

Opening pier pad size
FACTORY DIAGRAM
 ANCHORS ☒ 4 ft ☒ 5 ft
 FRAME TIES ☐
 Within 2' of end of home spaced at 5' 4" oc
 OTHER TIES
 Sidewall Number **6**
 Longitudinal Marriage wall
 Shearwall
 TIEDOWN COMPONENTS
 Longitudinal Stabilizing Device (LSD) **OTI**
 Longitudinal Stabilizing Device w/ Lateral Arms **OTI**

Mobile Home Permit Worksheet

POCKET PENETROMETER TEST

The pocket penetrometer tests are rounded down to _____ psf or check here to declare 1000 lb. soil X without testing.

X _____ X _____ X _____

POCKET PENETROMETER TESTING METHOD

1. Test the perimeter of the home at 6 locations.
2. Take the reading at the depth of the footer.
3. Using 500 lb. increments, take the lowest reading and round down to that increment.

X _____ X _____ X _____

TORQUE PROBE TEST

The results of the torque probe test is 275 inch pounds or check here if you are declaring 5' anchors without testing showing 275 inch pounds or less will require 5 foot anchors.

Note: A state approved lateral arm system is being used and 4 ft. anchors are allowed at the sidewall locations. I understand 5 ft anchors are required at all centerline tie points where the torque test reading is 275 or less and where the mobile home manufacturer may requires anchors with 4000 lb. holding capacity.

Installer's initials

ALL TESTS MUST BE PERFORMED BY A LICENSED INSTALLER

Installer Name DAVID ALBRIGHT MOBILE HOME SVC

Date Tested _____

Electrical

Connect electrical conductors between multi-wide units, but not to the main power source. This includes the bonding wire between multi-wide units. Pg. 73-77

Plumbing

Connect all sewer drains to an existing sewer tap or septic tank. Pg. 79-80

Connect all potable water supply piping to an existing water meter, water tap, or other independent water supply systems. Pg. 78-110

Application Number: _____

Date: _____

Site Preparation

Debris and organic material removed X
Water drainage: Natural _____ Swale _____ Pad X Other _____

Fastening multi wide units

Type Fastener: LAGS Length: 6" Spacing: 2'
Type Fastener: SCREWS Length: 3" Spacing: 18"
Type Fastener: LAGS Length: 6" Spacing: 2'
For used homes a min. 30 gauge, 8" wide, galvanized metal strip will be centered over the peak of the roof and fastened with galv. roofing nails at 2" on center on both sides of the centerline.

Gasket (weatherproofing requirement)

I understand a properly installed gasket is a requirement of all new and used homes and that condensation, mold, mildew and buckled marriage walls are a result of a poorly installed or no gasket being installed. I understand a strip of tape will not serve as a gasket.

Installer's initials DAV

Type gasket FACTORY

Pg. 41

Installed:
Between Floors Yes X
Between Walls Yes END WALLS
Bottom of ridgebeam Yes X

Weatherproofing


The bottomboard will be repaired and/or taped. Yes X Pg. 124
Siding on units is installed to manufacturer's specifications. Yes X
Fireplace chimney installed so as not to allow intrusion of rain water. Yes X

Miscellaneous

Skirting to be installed. Yes _____ No X
Dryer vent installed outside of skirting. Yes _____ N/A X
Range downflow vent installed outside of skirting. Yes _____ N/A X
Drain lines supported at 4 foot intervals. Yes X
Electrical crossovers protected. Yes X
Other: _____

Installer verifies all information given with this permit worksheet is accurate and true based on the manufacturer's installation instructions and or Rule 15C-1 & 2

Installer Signature David Albright Date _____

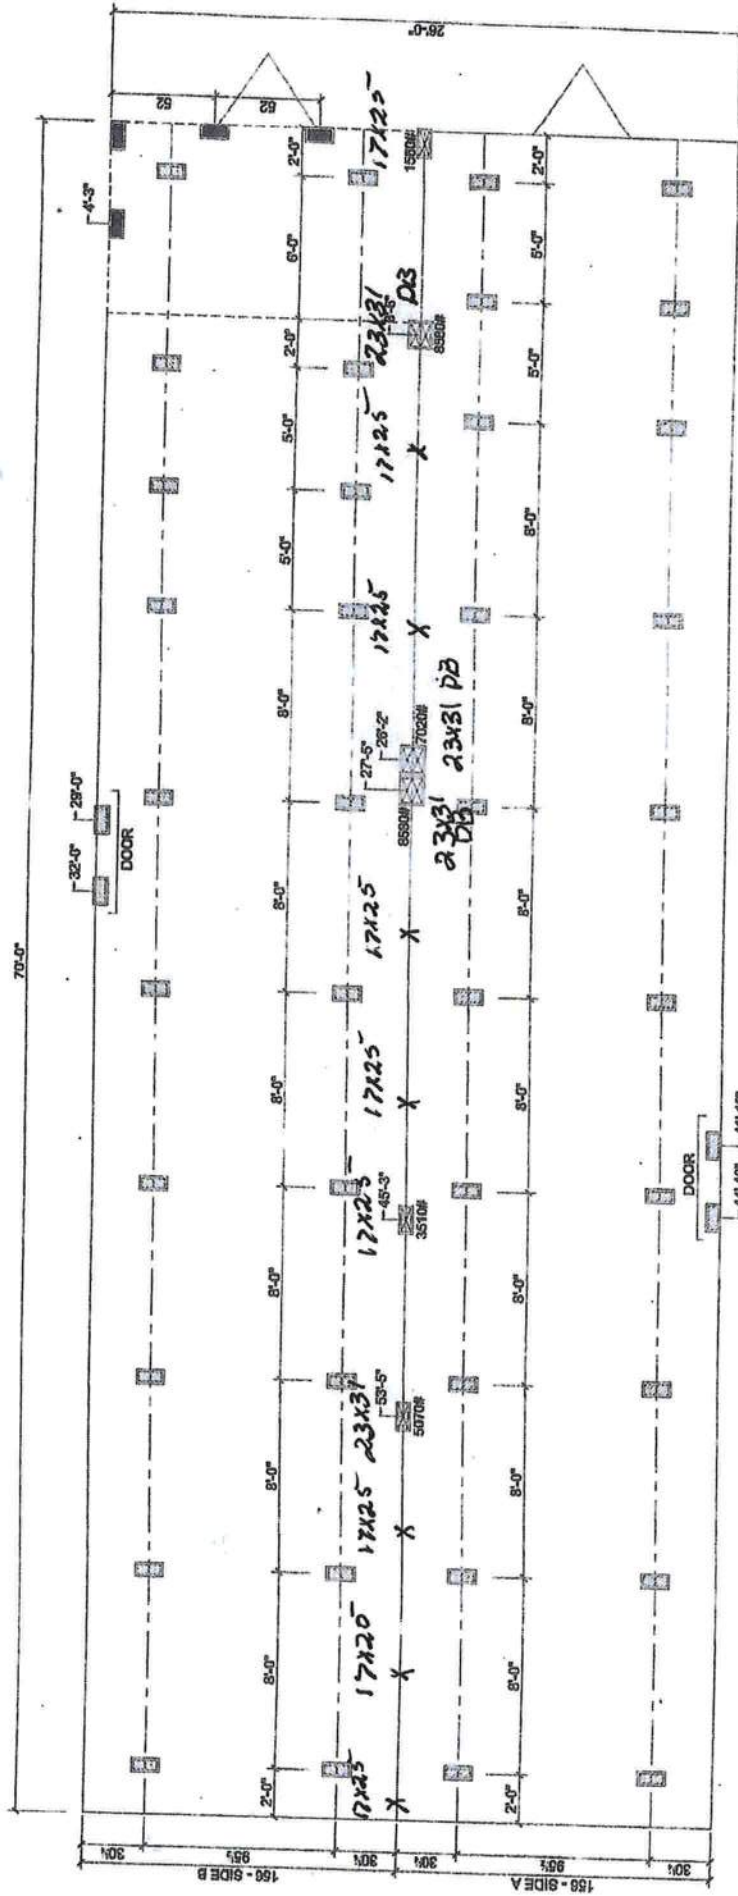

MARRIAGE LINE OPENING SUPPORT PIER/TYP.
 SUPPORT PIER/TYP

SUPPORT PIER/TYP

FOUNDATION NOTES:

- THIS DRAWING IS DESIGNED FOR THE STANDARD WIND ZONE AND IS TO BE USED IN CONJUNCTION WITH THE INSTALLATION MANUAL AND ITS SUPPLEMENTS.
- FOOTINGS ARE SHOWN FOR EXAMPLE ONLY QUANTITY AND SPACING MAY VARY BASED ON PAD TYPE, SOIL CONDITION, ETC.
- FOOTINGS ARE REQUIRED AT SUPPORT POSTS, SEE INSTALLATION MANUAL FOR REQUIREMENTS.

0521/19

Live Oak Homes
MODEL: V-2703A - 28 X 74
3-BEDROOM / 2-BATH



ROYAL

V-2703A

License Number: IH / 1129420 / 1 Name: DAVID E ALBRIGHT

Order #: 4444	Label #: 71613	Manufacturer: <u>LIVE OAK</u>	(Check Size of Home)
Homeowner: <u>LOT 6 BRANDON EST</u>	Year Model: <u>2020</u>	Single <u> </u>	
Address: <u>160 NW WHITNEY CEN</u>	Length & Width: <u>70/74 x 28</u>	Double <u>✓</u>	
City/State/Zip: <u>LAKE CITY FL 32024</u>	Type Longitudinal System: <u>6 OTI</u>	Triple <u> </u>	
Phone #:	Type Lateral Arm System: <u>6 OTI</u>	HUD Label #:	
Date Installed:	New Home: <u>✓</u> Used Home: <u> </u>	Soil Bearing / PSF:	
Installed Wind Zone: <u>A</u>	Data Plate Wind Zone: <u>A</u>	Torque Probe / in-lbs:	
Note:		Permit #:	

STATE OF FLORIDA
INSTALLATION CERTIFICATION LABEL

71613

LABEL #

DATE OF INSTALLATION

DAVID E ALBRIGHT

NAME

IH / 1129420 / 1

4444

LICENSE #

ORDER #

CERTIFIES THAT THE INSTALLATION OF THIS MOBILE HOME IS
IN ACCORDANCE WITH FLORIDA STATUTES 320.8249, 320.8325
AND RULES OF THE HIGHWAY SAFETY AND MOTOR VEHICLES.

INSTRUCTIONS

PLEASE WRITE DATE OF
INSTALLATION AND AFFIX
LABEL NEXT TO HUD LABEL.
USE PERMANENT INK PEN
OR MARKER ONLY.
COMPLETE INFORMATION
AND KEEP ON FILE
FOR A MINIMUM OF 2 YEARS.
YOU ARE REQUIRED TO
PROVIDE COPIES WHEN
REQUESTED.

