

PERMIT WORKSHEET

Page 1 of 1

PERMIT NUMBER

Installer ROY M. HARVEY License # IH1122397

Address of home being installed SW Carmine Way

Manufacturer NOBILITY Length x width 16' X 45'4"

NOTE: If home is a single wide fill out one half of the blocking plan
If home is a triple or quad wide sketch in remainder of home

I understand Lateral Arm Systems cannot be used on any home (new or used)
where the sidewall ties exceed 5 ft 4 in.

Installer's Initials RMH

New Home ☒ Used Home ☐

Home installed to the Manufacturer's Installation Manual ☒

Home is installed in accordance with Rule 15-C ☐

Single wide ☒ Wind Zone II ☒ Wind Zone III ☐

Double wide ☐ Installation Decal # _____

Triple/Quad ☐ Serial # _____

PIER SPACING TABLE FOR USED HOMES

Load bearing capacity	Footer size (sq in)	16" x 16" (256)	18 1/2" x 18 1/2" (342)	20" x 20" (400)	22" x 22" (484)	24" x 24" (576)	26" x 26" (676)
1000 psf		3'	4'	5'	6'	7'	8'
1500 psf		4' 6"	6'	7'	8'	9'	10'
2000 psf		5'	8'	8'	9'	10'	11'
2500 psf		7' 6"	8'	8'	9'	10'	11'
3000 psf		8'	8'	8'	9'	10'	11'
3500 psf		8'	8'	8'	9'	10'	11'

* Interpolated from Rule 15C-1 pier spacing table.

PIER PAD SIZES

I-beam pier pad size 17" X 25"

Perimeter pier pad size NA

Other pier pad sizes (required by the mfg.) _____

Draw the approximate locations of marriage wall openings 4 foot or greater. Use this symbol to show the piers.

List all marriage wall openings greater than 4 foot and their pier pad sizes below.

Opening _____ Pier pad size _____

POPULAR PAD SIZES

Pad Size	Sq In
16 x 16	256
16 x 18	288
18.5 x 18.5	342
16 x 22.5	360
17 x 22	374
13 1/4 x 26 1/4	348
20 x 20	400
17 3/16 x 25 3/16	441
17 1/2 x 25 1/2	448
24 x 24	576
26 x 26	676

ANCHORS

4 ft X 5 ft

FRAME TIES

within 2' of end of home
spaced at 5' 4" oc


OTHER TIES

Number _____

Sidewall _____
Longitudinal _____
Marriage wall _____
Shear wall _____

TIEDOWN COMPONENTS

Longitudinal Stabilizing Device (LSD)
Manufacturer OLIVER TECH
Longitudinal Stabilizing Device w/ Lateral Arms
Manufacturer OLIVER TECH

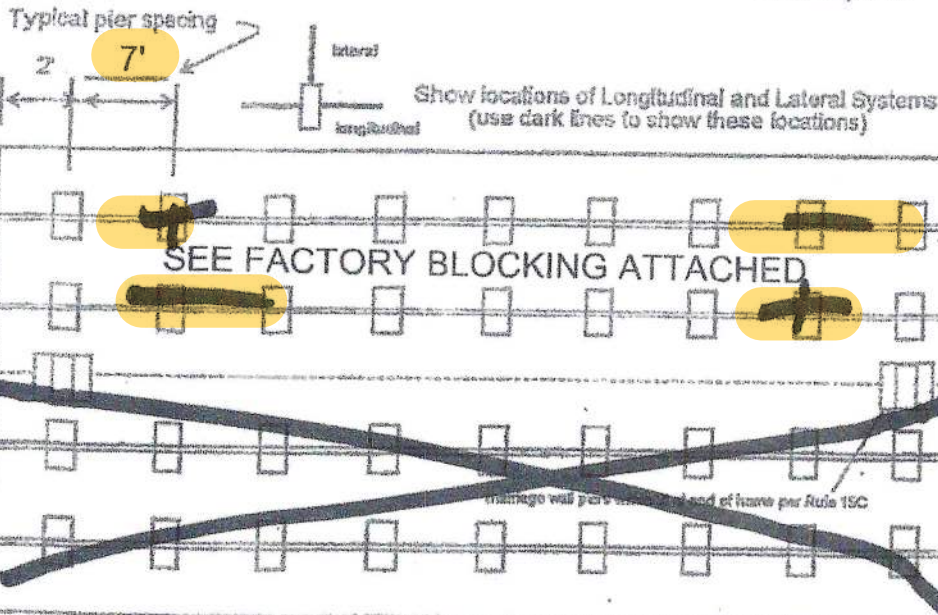

01-30-2024

PERMIT NUMBER

PERMIT WORKSHEET

page 1 of 1

POCKET PENETROMETER TEST

The pocket penetrometer tests are rounded down to 1500 psf or check here to declare 1000 lb. soil without testing.

x 1700 x 1700 x 1700

POCKET PENETROMETER TESTING METHOD

1. Test the perimeter of the home at 6 locations.
2. Take the reading at the depth of the footer.
3. Using 500 lb. increments, take the lowest reading and round down to that increment.

x 1700 x 1700 x 1700

TORQUE PROBE TEST

The results of the torque probe test is 285 inch pounds or check here if you are declaring 5" anchors without testing. A test showing 275 inch pounds or less will require 5 foot anchors.

Note: A state approved lateral arm system is being used and 4 ft. anchors are allowed at the sidewall locations. I understand 5 ft. anchors are required at all centerline tie points where the torque test reading is 275 or less and where the mobile home manufacturer may require anchors with 4000 lb. testing capacity.

Installer's Initials [Signature]

ALL TESTS MUST BE PERFORMED BY A LICENSED INSTALLER

Installer Name

ROY M. HARVEY

Date Tested

1-18-24

Electrical

Connect electrical conductors between multi-wide units, but not to the main power source. This includes the bonding wire between multi-wide units. Pg. NA

Plumbing

Connect all sewer drains to an existing sewer tap or septic tank. Pg. 47

Connect all potable water supply piping to an existing water meter, water tap, or other independent water supply systems. Pg. 44



Site Preparation

Debris and organic material removed YES
Water drainage: Natural Swale Pad X Other

Fastening multi wide units

Floor: Type Fastener: Length: Spacing:
Walls: Type Fastener: Length: Spacing:
Roof: Type Fastener: Length: Spacing:
For used homes a min. 2" square, galvanized metal strip will be centered over the peak of the roof and fastened with galv. roofing nails at 2" on center on both sides of the centerline.

Gasket (weatherproofing requirement)

I understand a properly installed gasket is a requirement of all new and used homes and that condensation, mold, mildew and buckled marriage walls are a result of a poorly installed or no gasket being installed. I understand a strip of tape will not serve as a gasket.

Installer's Initials [Signature]

Type gasket
Pg.

Installed:
Between Floors Yes
Between Walls Yes
Bottom of ridgebeam Yes

Weatherproofing

The bottomboard will be repaired and/or taped. Yes X Pg. SU.58
Siding on units is installed to manufacturer's specifications. Yes NA
Fireplace chimney installed so as not to allow intrusion of rain water. Yes

Miscellaneous

Skirting to be installed. Yes X No
Dryer vent installed outside of skirting. Yes X N/A
Range downflow vent installed outside of skirting. Yes N/A
Drain lines supported at 4 foot intervals. Yes X
Electrical crossovers protected. Yes
Other:


Installer verifies all information given with this permit worksheet is accurate and true based on the

Installer Signature

[Signature]

Date 1/22/24

1500 LB SOIL.....16' X 45'4"
 I BEAM PADS.....17" X 25"....6'o/c
 OLIVER TECH STABILIZING SYSTEM
 4' ANCHORS.....@ 5'4" OR LESS

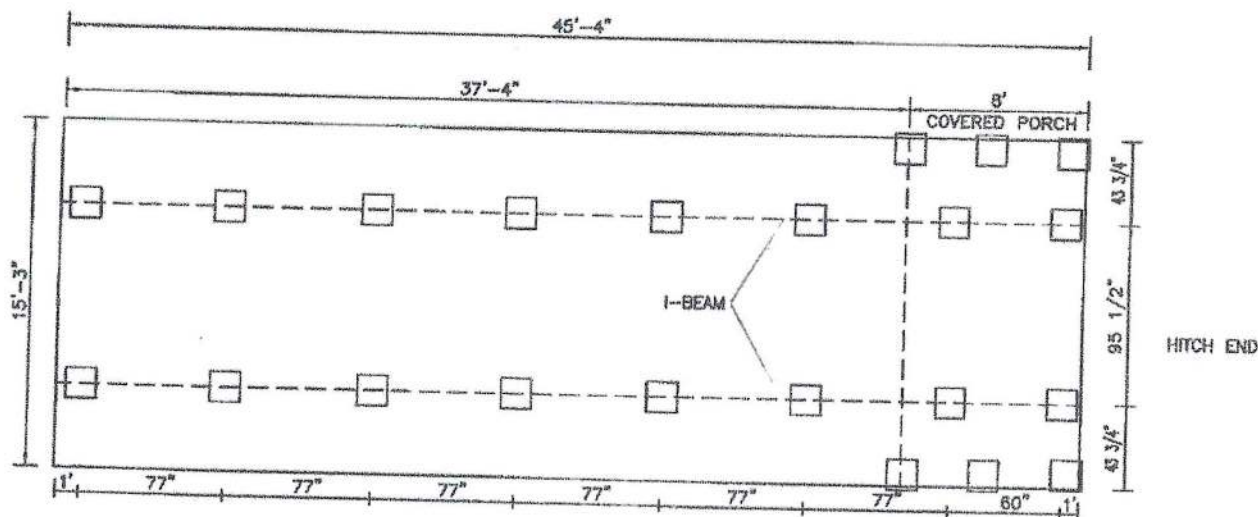

- NOTES: (1. ADDITIONAL PIERS ARE REQUIRED AT EACH SIDE OF EXTERIOR DOOR OPENINGS.
 (2. THIS IS A TYPICAL DRAWING FOR THIS MODEL. SPACING MAY BE DIFFERENT IF MAX. SPACING IS NOT EXCEEDED.

THIS HOME MAY BE BUILT
 IN A FLIPPED CONFIGURATION

☐ 17 1/2" X 25 1/2" BASE PAD

SPACING FOR 1500 PSF SOIL WITH 17 1/2" X 25 1/2" BASE PAD
 MAXIMUM SPACING FOR THE I-BEAM PIERS IS 77"


	1	3	W/ 8' COVERED PORCH PRINT NUMBER 37-4H1A(3)
	2	4	
	REVISIONS		
	DWG. BY: RITENOUR		
DATE		SCALE	

Prestige Home Centers

5700
M/L

CARPET
LIVING
Room

VACATION COTTAGE

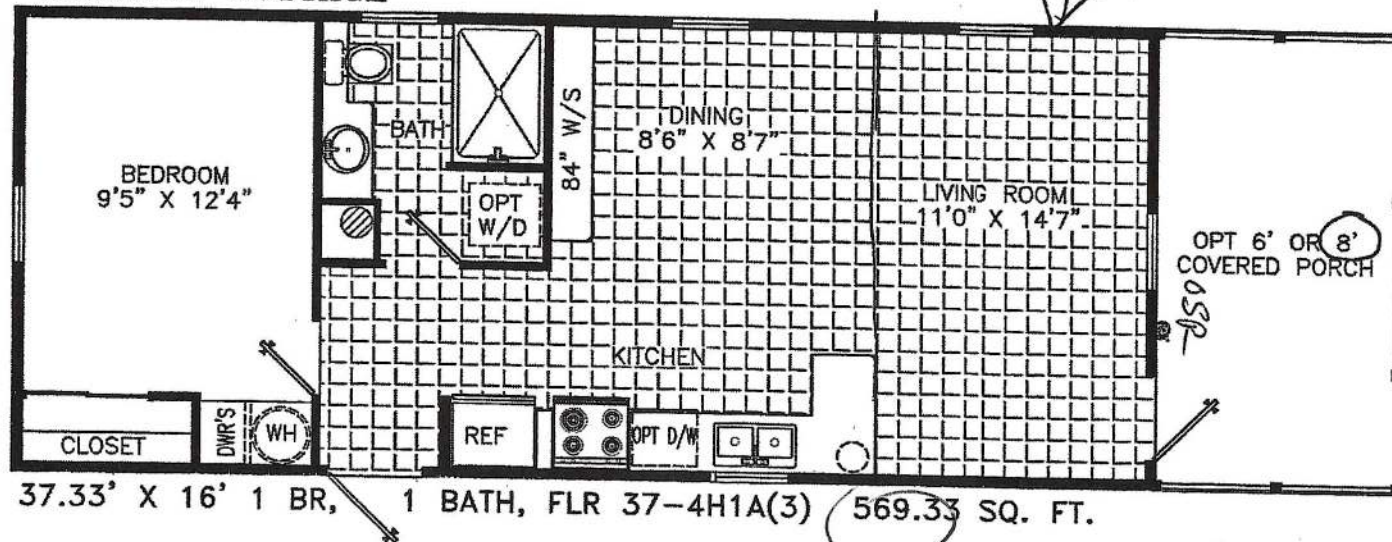

FLIPPING SIDE TO SIDE
WITH 8' PORCH



James Coenraets
Janice Kalich
Homes Designed, Built & Serviced
By NOBILITY HOMES

MANUFACTURED IN ACCORDANCE WITH STANDARDS DEVELOPED AND ENFORCED BY HUD. DUE TO OUR CONTINUING PROGRAM OF PRODUCT IMPROVEMENT, PRICES AND SPECIFICATIONS ARE SUBJECT TO CHANGE WITHOUT NOTICE. SOME ITEMS SUCH AS TIRES, RIMS, AXLES AND HITCHES MAY HAVE BEEN RECYCLED AFTER INSPECTION FOR SAFETY AND APPEARANCE. ALL DIMENSIONS ARE NOMINAL.