


Address of home being installed: _____
 Manufacturer: Fleetwood length x width: 14 x 52

NOTE if home is a single wide fill out one half of the blocking plan
 if home is a triple or quad wide sketch in remainder of home
 I understand Lateral Arm Systems cannot be used on any home (new or used)
 where the sidewall has exceeded 5 ft 4 in

Installer's initials: RS

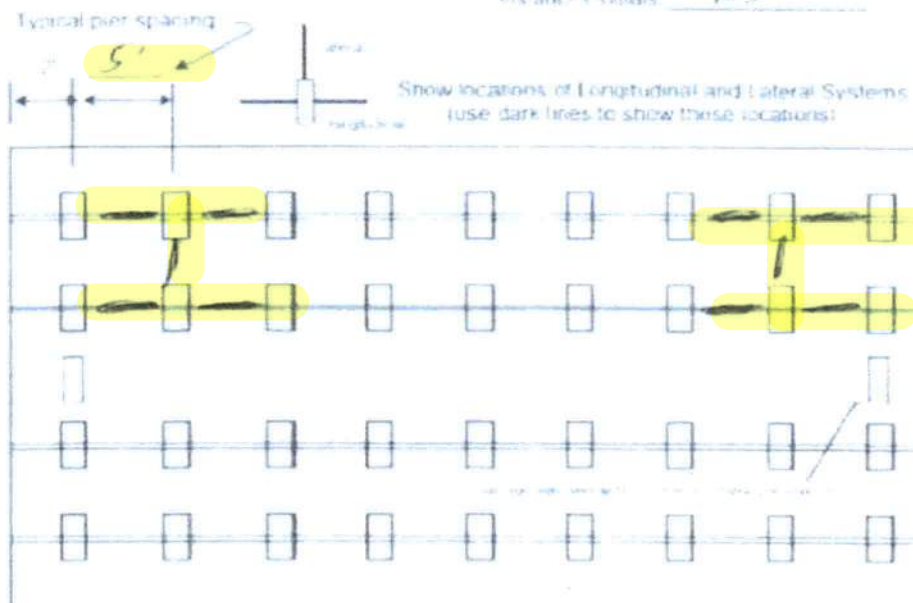

Laurie Hodson

Digitally signed by Laurie Hodson
 Date: 2020.10.08 17:13:18 -04'00'

Home is installed in accordance with Rule 15-C

Single wide: ☒ Wind Zone II: ☒ Wind Zone III: ☐
 Double wide: ☐ Installation Detail #: 49876
 Triple Quad: ☐ Series #: _____

PIER SPACING TABLE FOR USED HOMES

Load bearing capacity	Footer size (sq. ft.)	16' x 16' (256)	18' 1/2' x 18' (12' 1342)	20' x 20' (400)	22' x 22' (484)*	24' x 24' (576)*	26' x 26' (676)
1000 psf		3'	4'	5'	6'	7'	8'
1500 psf		4'	5'	6'	7'	8'	9'
2000 psf		5'	6'	7'	8'	9'	10'
2500 psf		6'	7'	8'	9'	10'	11'
3000 psf		7'	8'	9'	10'	11'	12'
3500 psf		8'	9'	10'	11'	12'	13'

* Interpolated from Rule 15-C Pier spacing table

PIER PAD SIZES

Flowmaster pier pad size: 17x25
 Flowmaster pier pad size: 16x16
 Other pier pad sizes required by the mfg.: 17x25

Draw the approximate locations of masonry wall openings 4 feet or greater. Use this symbol to show the piers.

List all masonry wall openings greater than 4 feet from then pier pad sizes below.

Closing: _____ Pier pad size: _____

POPULAR PAD SIZE

Pad Size	Spacing
16 x 16	2'
16 x 18	2'
18.5 x 18.5	3'
16 x 22.5	3'
17 x 22	3'
13 1/4 x 16 1/4	3'
20 x 20	4'
17 1/2 x 25 1/2	4'
17 1/2 x 25 1/2	4'
24 x 24	5'
26 x 26	5'

ANCHORS

4 ft ☒ 6 ft ☐

FRAME TIES

Within 2' of end of home spaced at 5' 4" or

TIEDOWN COMPONENTS

Longitudinal Stabilizing Device (LSD)
 Manufacturer: _____
 Longitudinal Stabilizing Device w/ Lateral Arms
 Manufacturer: Shure H01V

OTHER TIES

Name: _____
 Snowwall: _____
 Longitudinal: 4
 Marriage wall: _____
 Shearwall: 7

POCKET PENETROMETER TEST

The pocket penetrometer tests are rounded down to 1500 psi or check here to declare 1000 lb soil without testing

x 1600 x 1600 x 1500

POCKET PENETROMETER TESTING METHOD

1. Test the perimeter of the home at 5 locations
2. Take the reading at the depth of the footer
3. Using 500 lb increments, take the lowest reading and round down to that increment

x 1500 x 1600 x 1500

TORQUE PROBE TEST

The results of the torque probe test is 250 inch pounds or less. A test here if you are declaring 5 ft anchors without testing. A test showing 275 inch pounds or less will require 5 foot anchors.

Note: A state approved lateral arm system is being used and 4 ft anchors are allowed at the sidewall locations. I understand 5 ft anchors are required at all centerline tie points where the torque test reading is 275 or less and where the mobile home manufacturer may require anchors with 4000 lb holding capacity.

RS Installer's initials

ALL TESTS MUST BE PERFORMED BY A LICENSED INSTALLER

Installer Name

Robert Sheppard

Date Tested

9-29-20

Electrical

Connect electrical conductors between multi-wide units, but not to the main power source. This includes the bonding wire between multi-wide units. Pg. 23

Plumbing

Connect all sewer drains to an existing sewer tap or septic tank. Pg. 28

Connect all potable water supply piping to an existing water meter, water tap, or other independent water supply systems. Pg. 28



Debris and organic material removed ☒ Swale ☐ Pad ☒ Other ☐

Fastening multi wide units

Floor	Type Fastener	Length	Spacing
Walls	Type Fastener	Length	Spacing
Roof	Type Fastener	Length	Spacing

For used homes, a min. 30 gauge 3" wide galvanized metal strip will be centered over the peak of the roof and fastened with galv. roofing nails at 2' on center on both sides of the centerline.

Gasket (weatherproofing requirement)

I understand a properly installed gasket is a requirement of all new and used homes and that condensation, mold, mildew and buckled marriage walls are a result of a poorly installed or no gasket being installed. I understand a strip of tape will not serve as a gasket.

Installer's initials

Type gasket
Pg.

Installed
Between Floors: Yes
Between Walls: Yes
Bottom of ridgebeam: Yes

Weatherproofing

The bottomboard will be repaired and/or taped. Yes ☒ Pg. 23
Siding on units is installed to manufacturer's specifications. Yes ☒
Fireplace chimney installed so as not to allow intrusion of rain water. Yes ☒

Miscellaneous

Skirting to be installed. Yes ☒ No ☐
Dryer vent installed outside of skirting. Yes ☐ N/A ☒
Range/broil/oven vent installed outside of skirting. Yes ☐ N/A ☒
Drain lines supported at 4 foot intervals. Yes ☒
Electrical crossovers protected. Yes ☒
Other ☐

Installer verifies all information given with this permit worksheet is accurate and true based on the manufacturer's installation instructions and or Rule 15C-1 & 2

Installer Signature

Robert Sheppard

Date 9-29-20