


- DESIGN CODES:
2020 FLORIDA BUILDING CODE (FBC) - RESIDENTIAL

- NOTES:
1. DESIGN SPECIFICATIONS: 2020 FLORIDA BUILDING CODE - RESIDENTIAL 7TH EDITION.
 2. DECK HEIGHT 48" FROM THE CURRENT GRADE AND IS APPROXIMATE.
 3. DECK IS NOT ATTACHED TO THE HOME.
 4. DECK IS DESIGNED FOR A LIVE LOAD OF 40 PSF.
 5. DECK IS DESIGNED FOR A DEAD LOAD OF 10 PSF.
 6. FOOTER DEPTH IS 24".
 7. DECKING AND HANDRAILING IS TREX MATERIAL.
 8. ALL STRUCTURAL MEMBERS WILL BE PRESSURED TREATED LUMBER AS SHOWN.
 9. RING JOIST 2X10 - TYPICAL

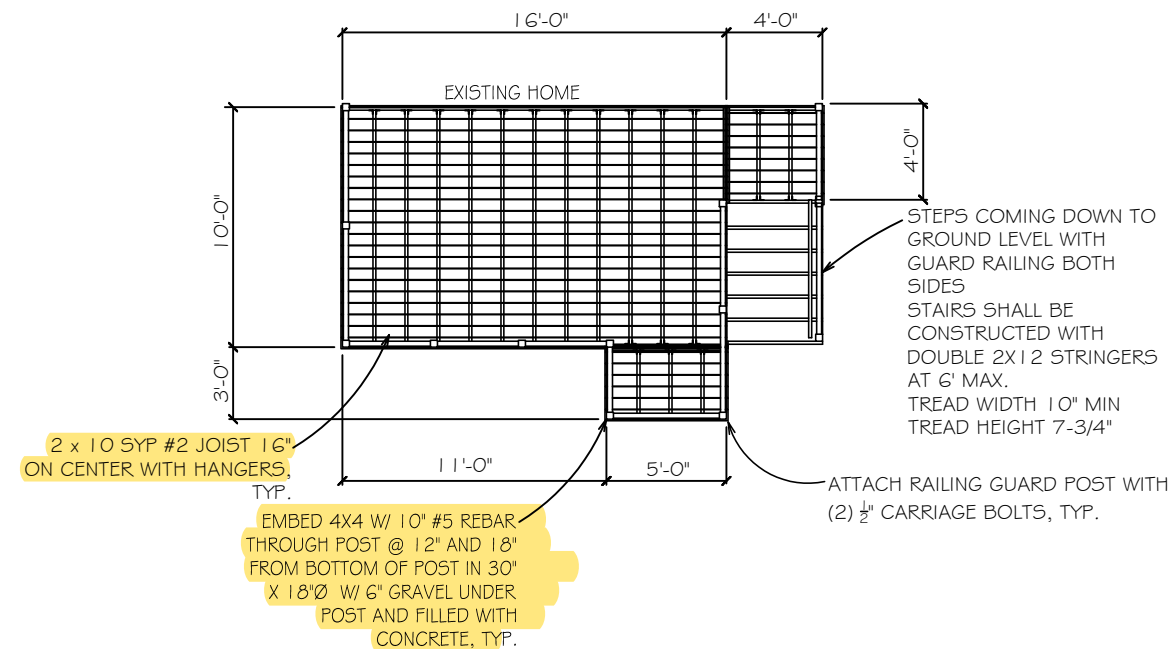

SCALE: $1/8" = 1'$




Digitally signed by
Carol Chadwick
DN: c=US,
o=Florida,
dnQualifier=A01410
D0000017EB6D924
CE0005954C,
cn=Carol Chadwick
Date: 2022.11.19
19:16:58 -05'00'

PRINTED COPIES OF THIS DOCUMENT ARE NOT
CONSIDERED SIGNED AND SEALED AND THE SIGNATURE
MUST BE VERIFIED ON ANY ELECTRONIC COPIES.

C:\CONSULTING\JOB FILES\PLAN REVIEW\F22452-WHIDDON DICK DECK\DETAILS\F22452 S-1.dwg, 1/19/2022 4:14:20 PM

CAROL CHADWICK, P.E.
Carol Chadwick, P.E.
 President
 The Chadwick Group
 208 SW Madison Blvd.
 Lake City, FL 32225
 307.583.3772
carol@wagmail.com
www.chadwickp.e.com
 P.E. • F.L.D.A. • W.A.G.M.I.N.G.
 OREGON • CALIFORNIA • N.C. • FLA.

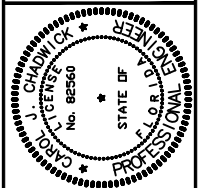[illegible]

PREPARED FOR
WHIDDON CONSTRUCTION CO
295 NW COMMONS LOOP
SUITE 115-262
LAKE CITY, FL 32055
386.754.7367

MICHAEL DICK
DECK PLAN
218 SW APPELACHEE TERRACE
FORT WHITE, FL

PROJECT NO.	FL22452
DATE	NOV. 19, 2022
REVISION DATE	
SHEET	S-1