


ROOF VENT SCHEDULE (FBC R806)





VERIFY WITH GENERAL CONTRACTOR ALL ROOF VENT LOCATIONS, QUANTITIES AND SIZES. ROOF VENTS SHALL BE INSTALLED FOR A MINIMUM OF VENTED AREA AS LISTED BELOW OR EQUIVALENT SYSTEM

MARK	LOCATION	OFF RIDGE VENTS (SQ. IN.)	SOFFIT VENT (SQ. IN.)
RV 1	AREA 1	126	126

NOTE: FLASHING SHALL BE INSTALLED AT WALL AND ROOF INTERSECTIONS, DECK AND WALL INTERSECTIONS, AT GUTTERS, AT ALL CHANGES IN ROOF SLOPE OR DIRECTION, AND AROUND ROOF OPENINGS.

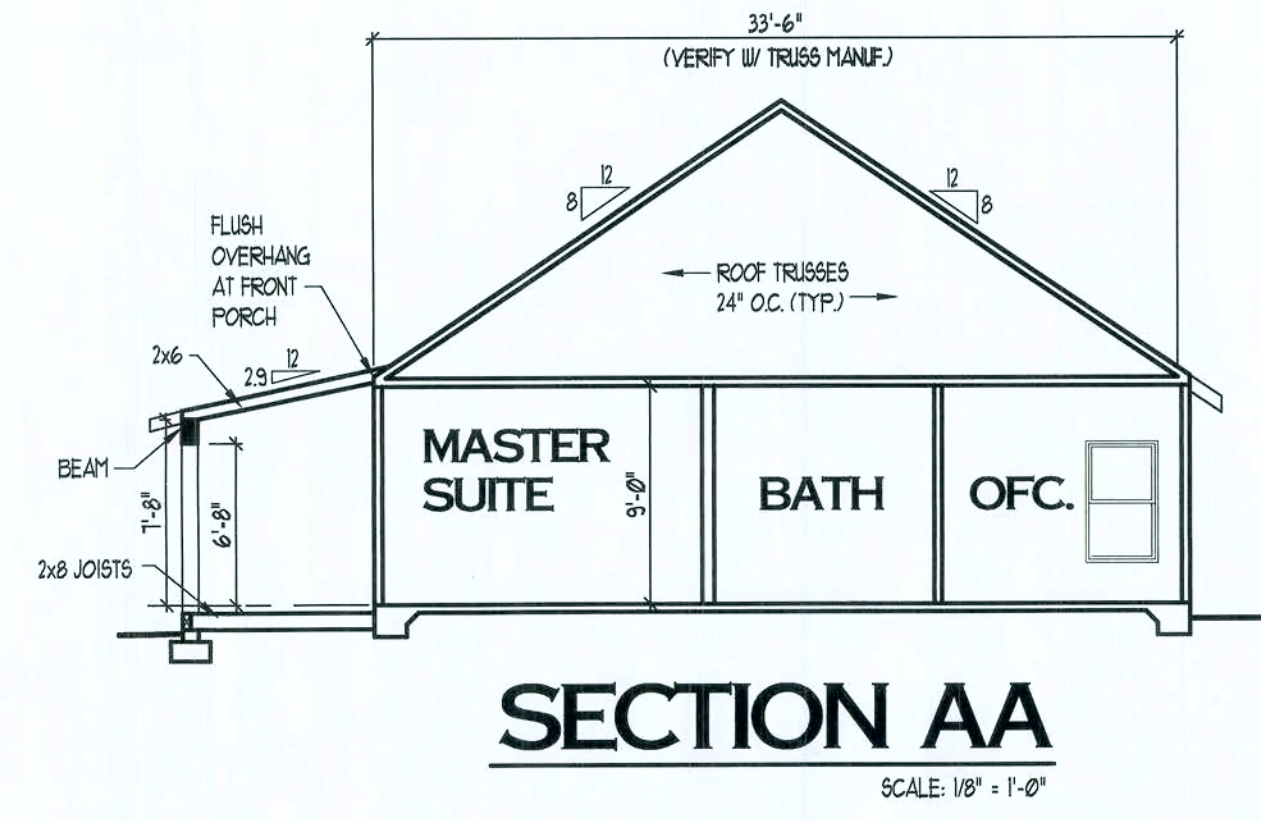

EGRESS NOTE:  
 EACH BEDROOM MUST HAVE ONE WINDOW THAT COMPLES WITH EGRESS CODES. IF THERE IS NO ACCESS TO EXTERIOR THROUGH A DOOR, THE WINDOW MUST HAVE A MAXIMUM OPENING HEIGHT OF 44" ABOVE FINISH FLOOR LINE OF THAT PARTICULAR ROOM

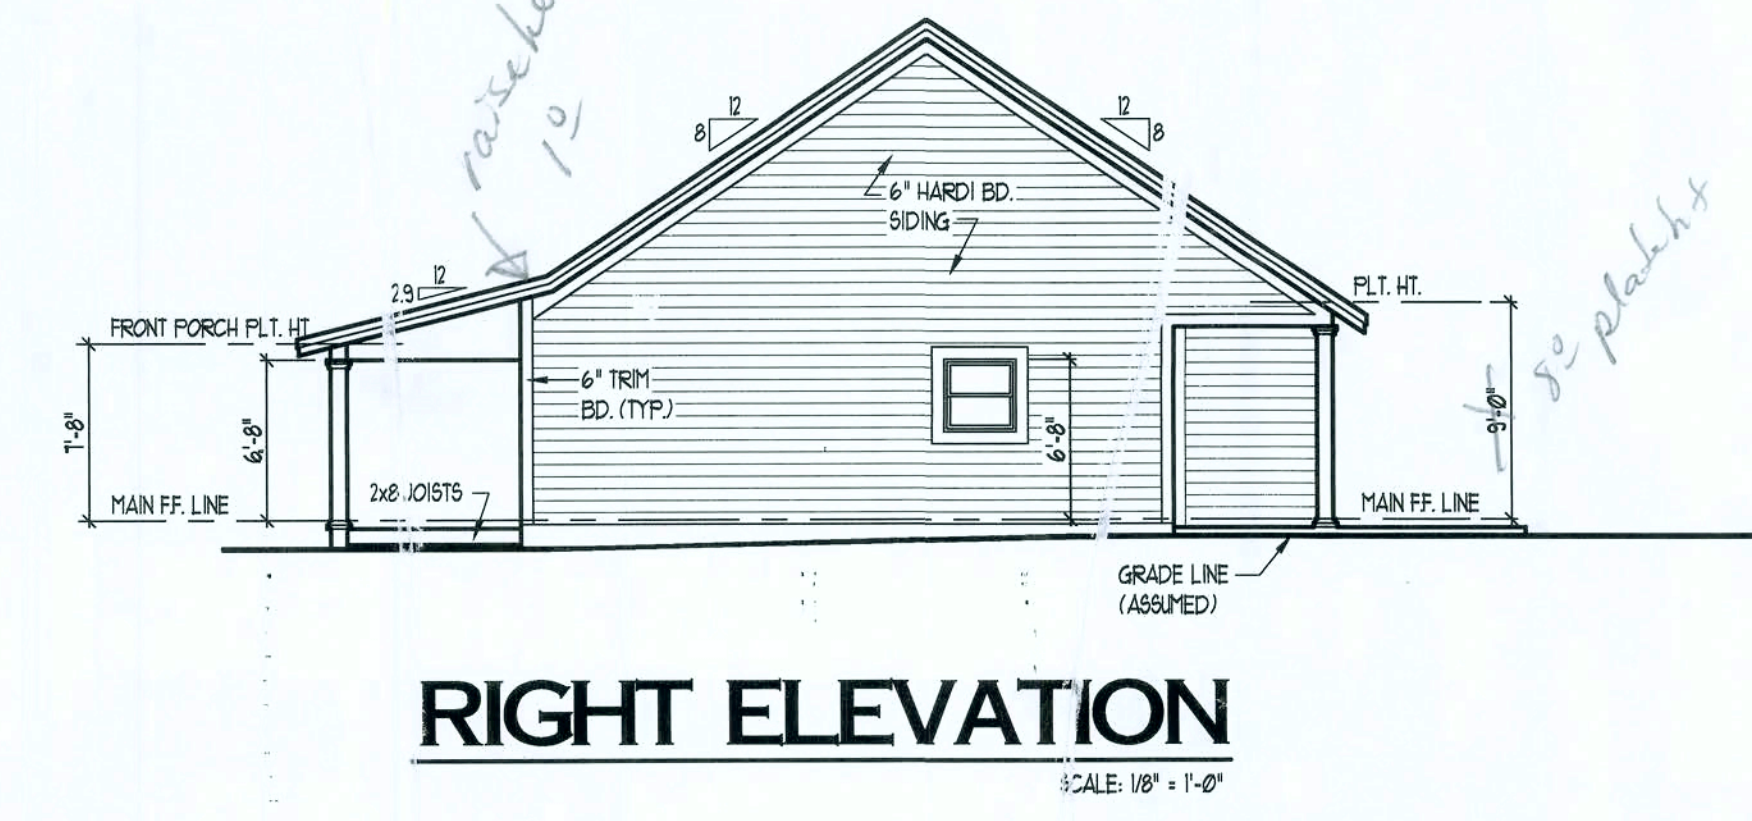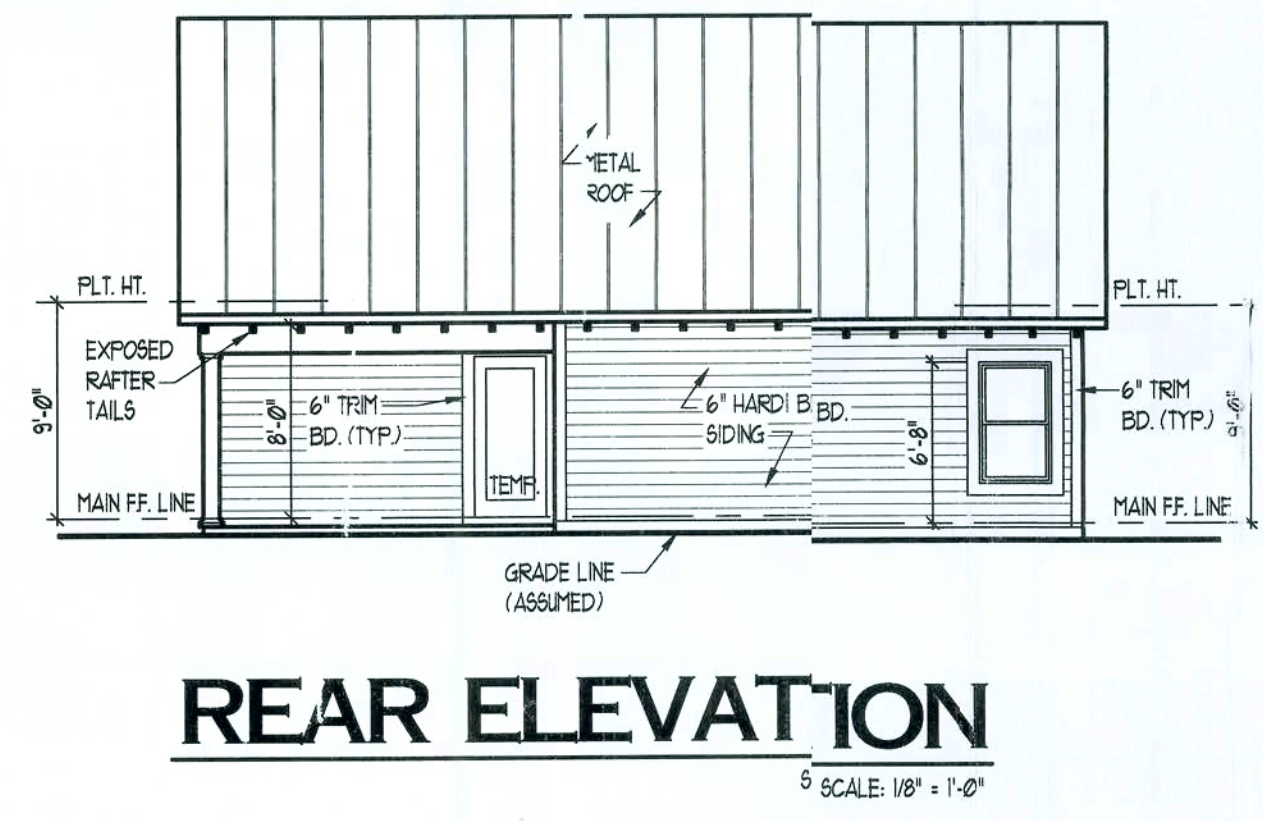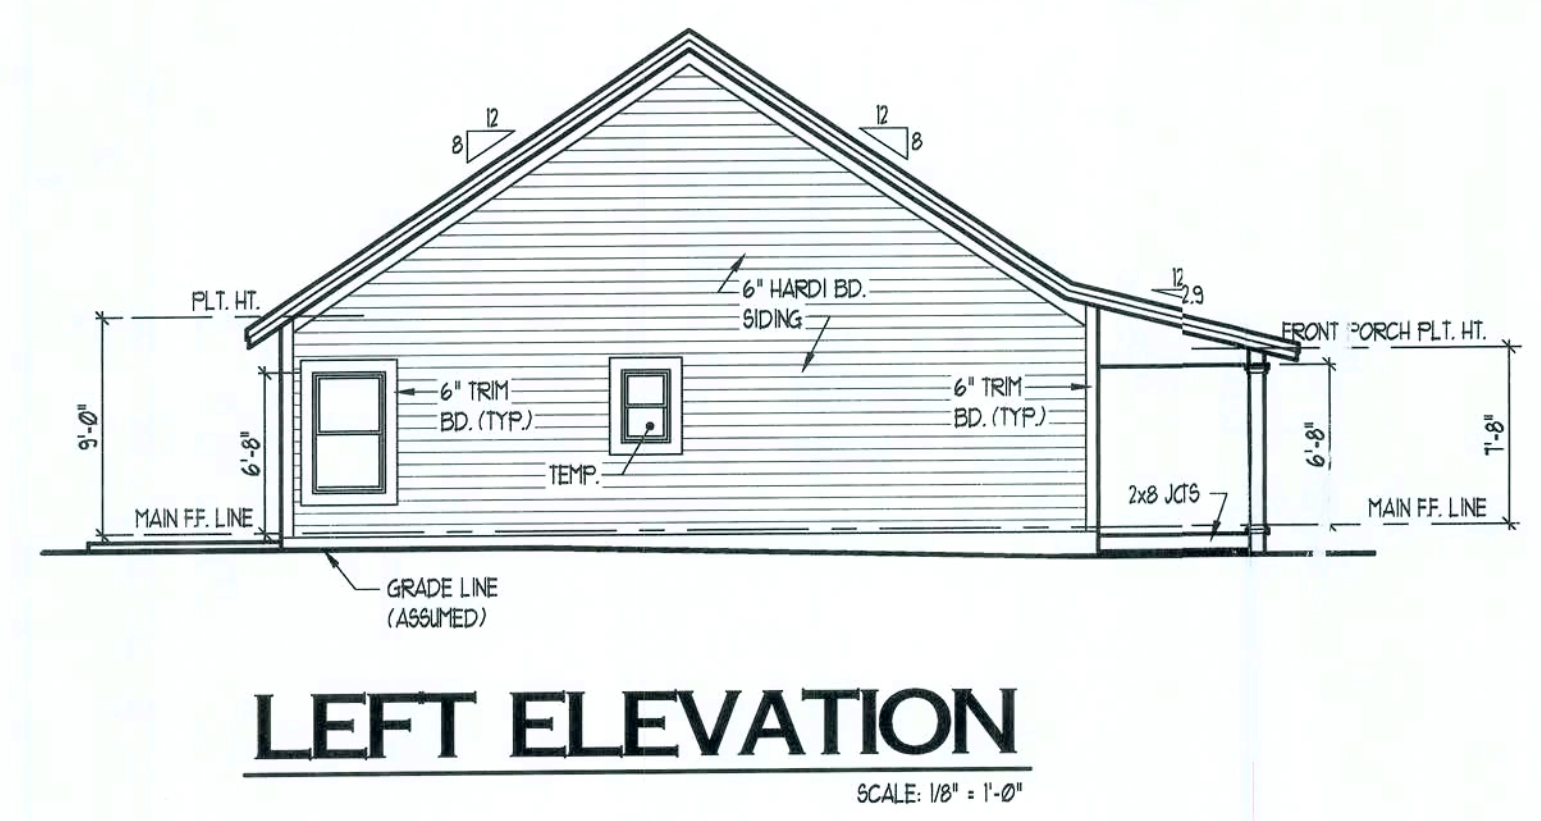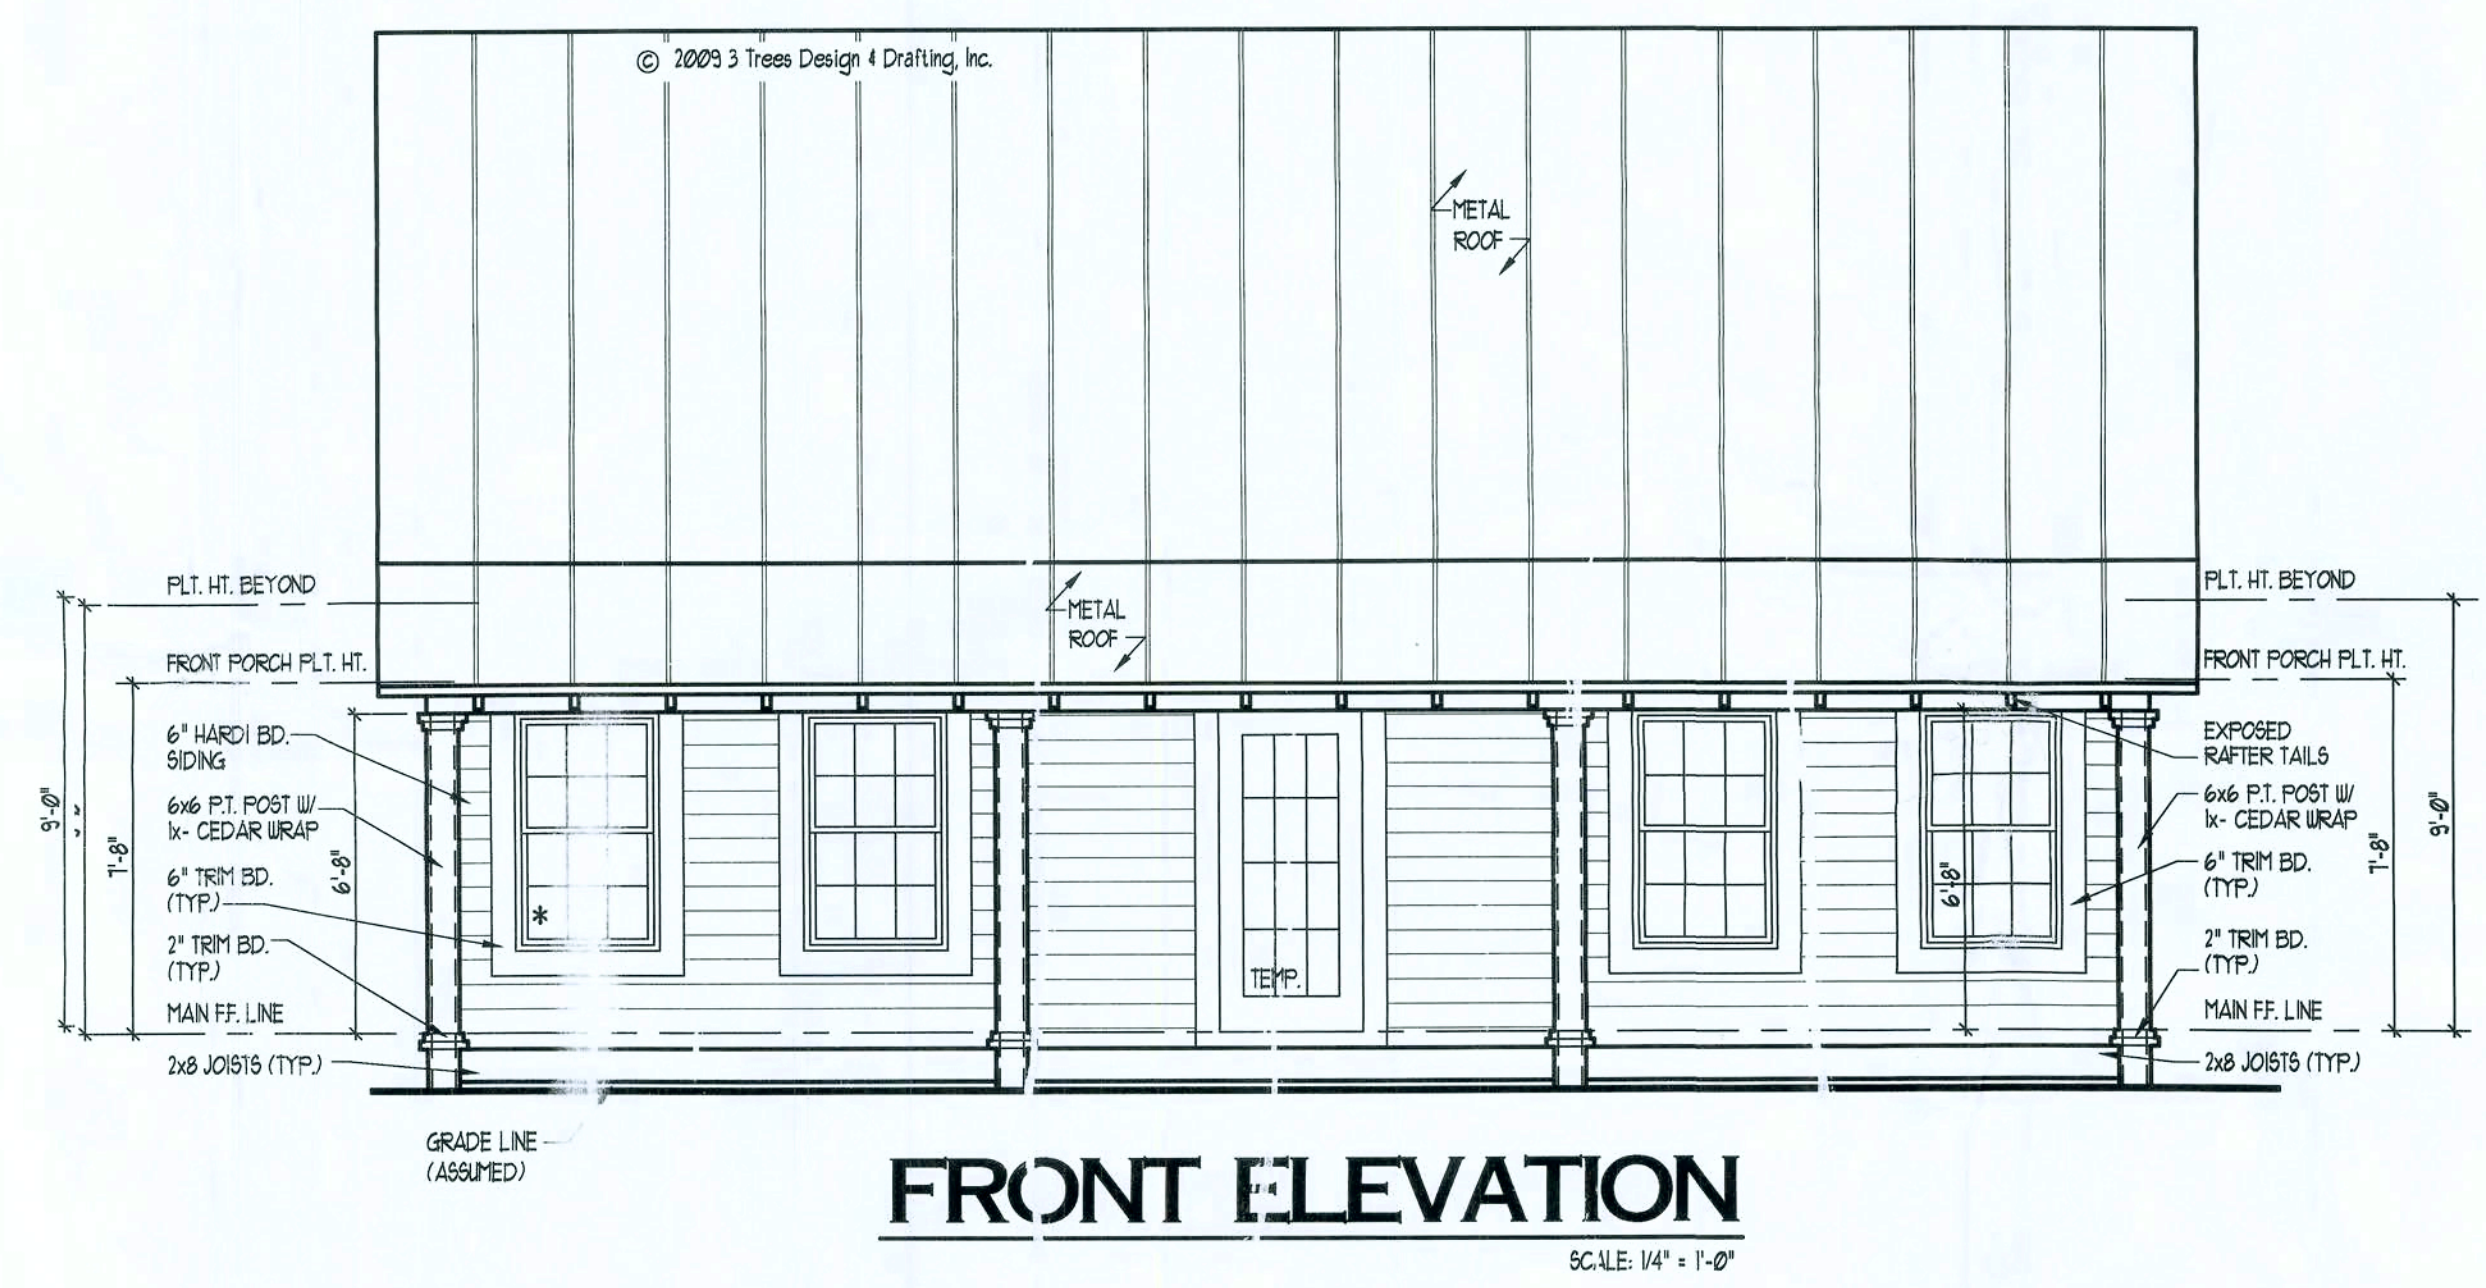

NOTE: IT IS THE CONTRACTOR'S RESPONSIBILITY TO REVIEW ALL DRAWINGS BEFORE CONSTRUCTION BEGINS. THE ARCHITECT OF RECORD IS RESPONSIBLE FOR THE STRUCTURAL INTEGRITY OF THIS PROJECT ONLY. ANY DISCREPANCY BETWEEN FIELD CONDITIONS, OTHER DESIGN PROFESSIONALLY SHOWN DRAWINGS, CONTRACTOR'S BUILDING METHODS, AND THEIR OWNED AND SCALED DRAWINGS MUST BE BROUGHT TO THE ATTENTION OF THE ARCHITECT OF RECORD PRIOR TO THE COMMENCEMENT OF CONSTRUCTION. CONTRACTOR TO VERIFY ALL DIMENSIONS PRIOR TO START OF ANY CONSTRUCTION.

To the best of the architect's knowledge, the plans and specifications comply with the minimum requirements of The Florida Building Code - Residential Section R3020007 edition.

Plans and specifications comply with the Florida building code, section 9008 for 120 mph wind zone (OSDF edition).




This drawing is valid for 12 months after the date it is signed and sealed or until the requirements of the Florida Building Code (OSDF) edition is changed.

This drawing is signed and sealed for the structural and life safety portions of the drawing only. Electrical, Plumbing or Mechanical details, if shown, are for visual reference only and are not covered under this seal.

NOTE: DRAWINGS ON 11"x17" SHEET WILL BE ONE HALF THE SCALE NOTED

Adrian Perry  
 4-8-09



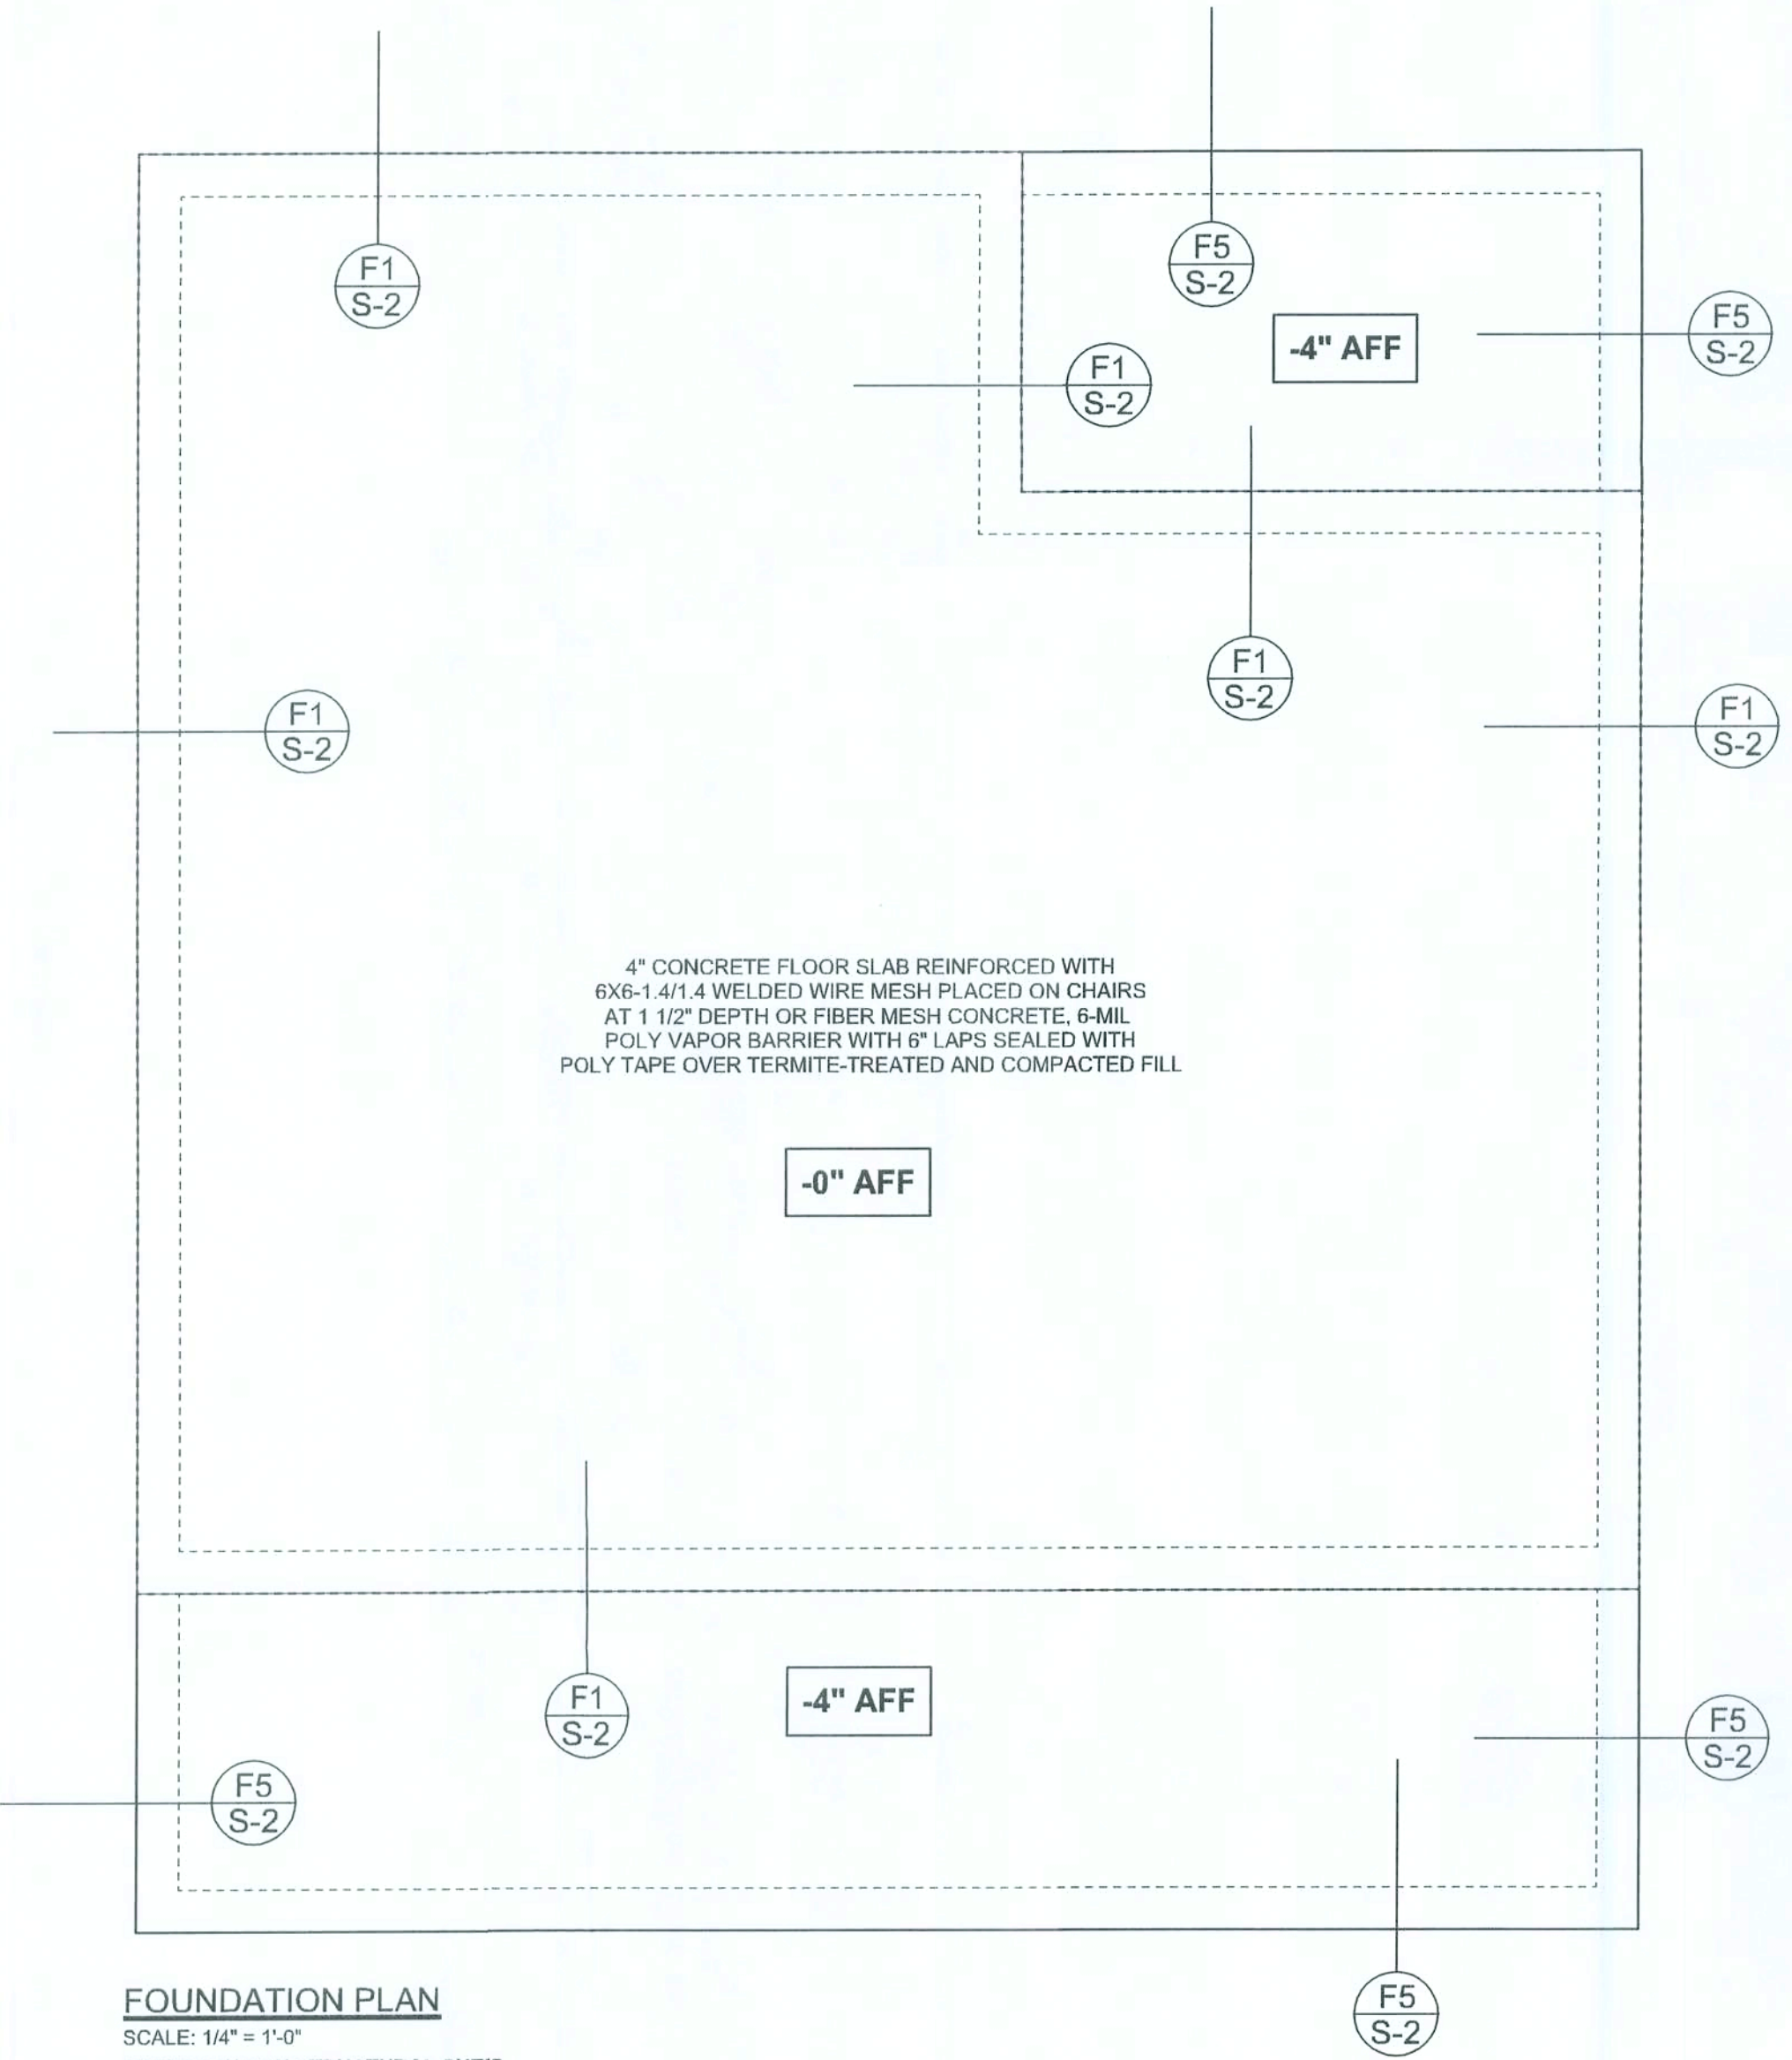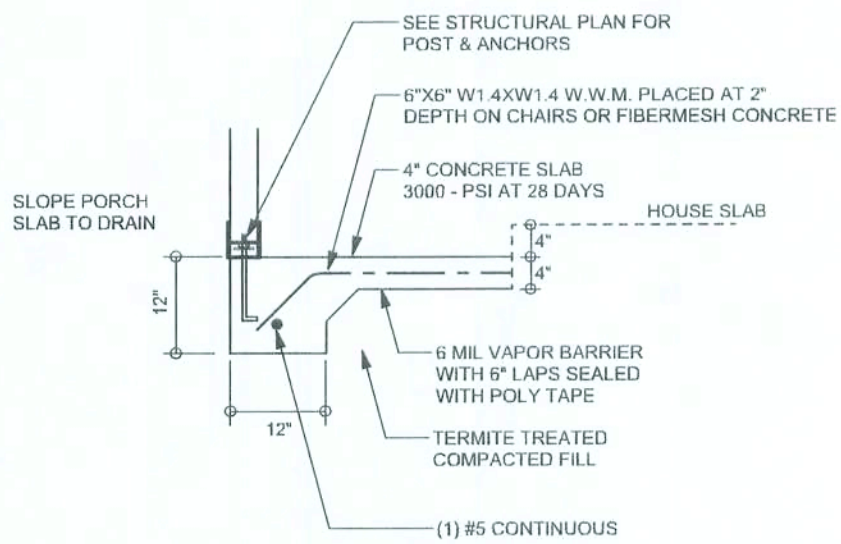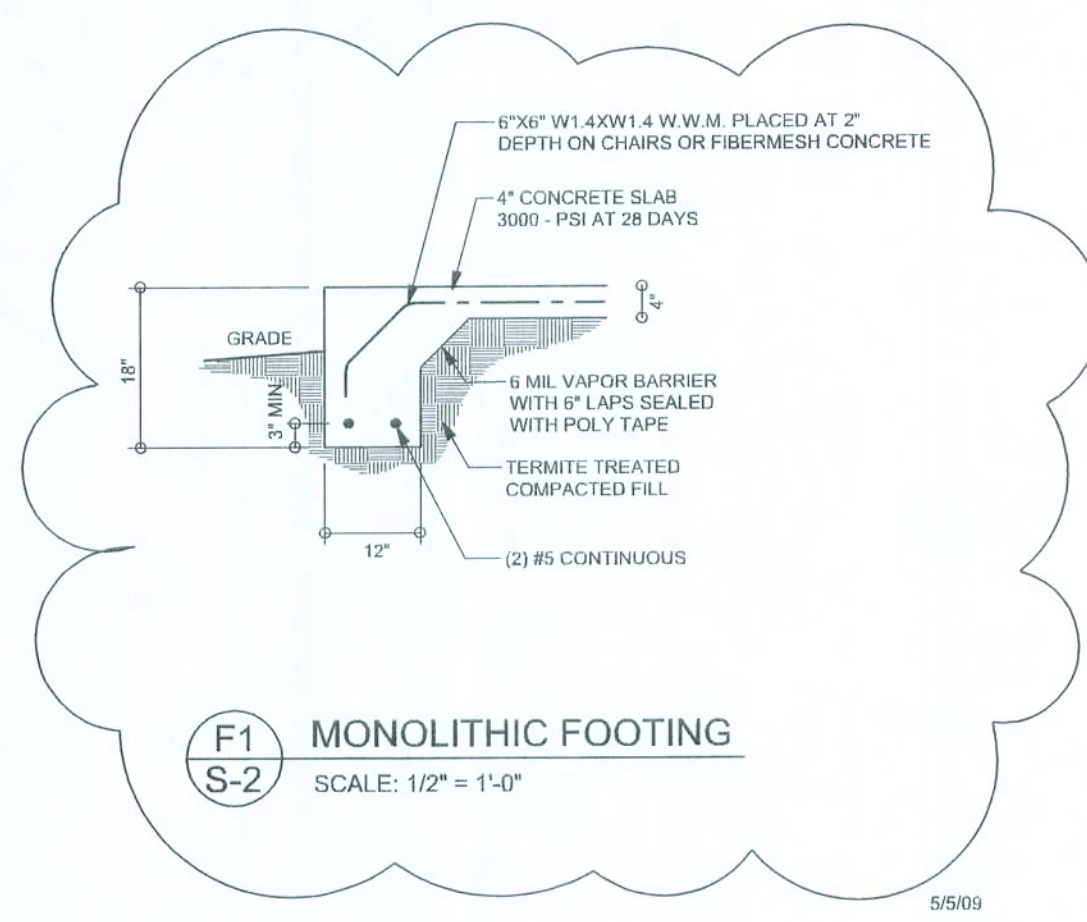

FOUNDATION PLAN  
SCALE: 1/4" = 1'-0"  
DIMENSIONS ON STRUCTURAL SHEETS ARE NOT EXACT. REFER TO ARCHITECTURAL FLOOR PLAN FOR ACTUAL DIMENSIONS


STRUCTURAL PLAN NOTES

- SN-1 ALL LOAD BEARING FRAME WALL & PORCH HEADERS SHALL BE A MINIMUM OF (2) 2X10 SYP #2 (U.N.O.)
- SN-2 ALL LOAD BEARING FRAME WALL HEADERS SHALL HAVE (1) JACK STUD & (1) KING STUD EACH SIDE (U.N.O.)
- SN-3 DIMENSIONS ON STRUCTURAL SHEETS ARE NOT EXACT. REFER TO ARCHITECTURAL FLOOR PLAN FOR ACTUAL DIMENSIONS
- SN-4 PERMANENT TRUSS BRACING IS TO BE INSTALLED AT LOCATIONS AS SHOWN ON THE SEALED TRUSS DRAWINGS. LATERAL BRACING IS TO BE RESTRAINED PER BCSI-03, BCSI-B1, BCSI-B2, & BCSI-B3. BCSI-B1, BCSI-B2, & BCSI-B3 ARE FURNISHED BY THE TRUSS SUPPLIER, WITH THE SEALED TRUSS PACKAGE

WALL LEGEND


	EXTERIOR WALL
	INTERIOR NON-LOAD BEARING WALL
	INTERIOR LOAD BEARING WALL w/ NO UPLIFT
	INTERIOR LOAD BEARING WALL w/ UPLIFT

HEADER LEGEND

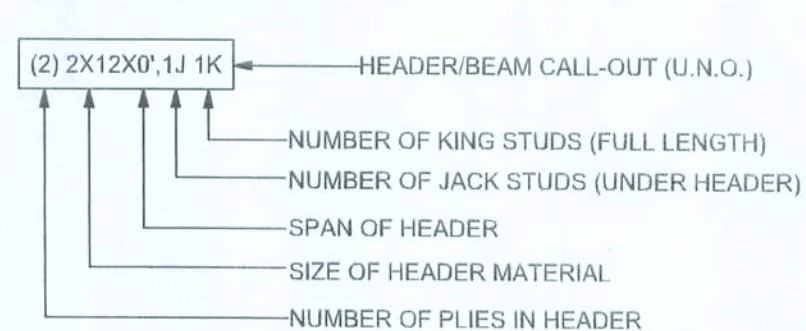

TOTAL SHEAR WALL SEGMENTS

	REQUIRED	ACTUAL
TRANSVERSE	44.1'	57.5'
LONGITUDINAL	30.4'	45.0'

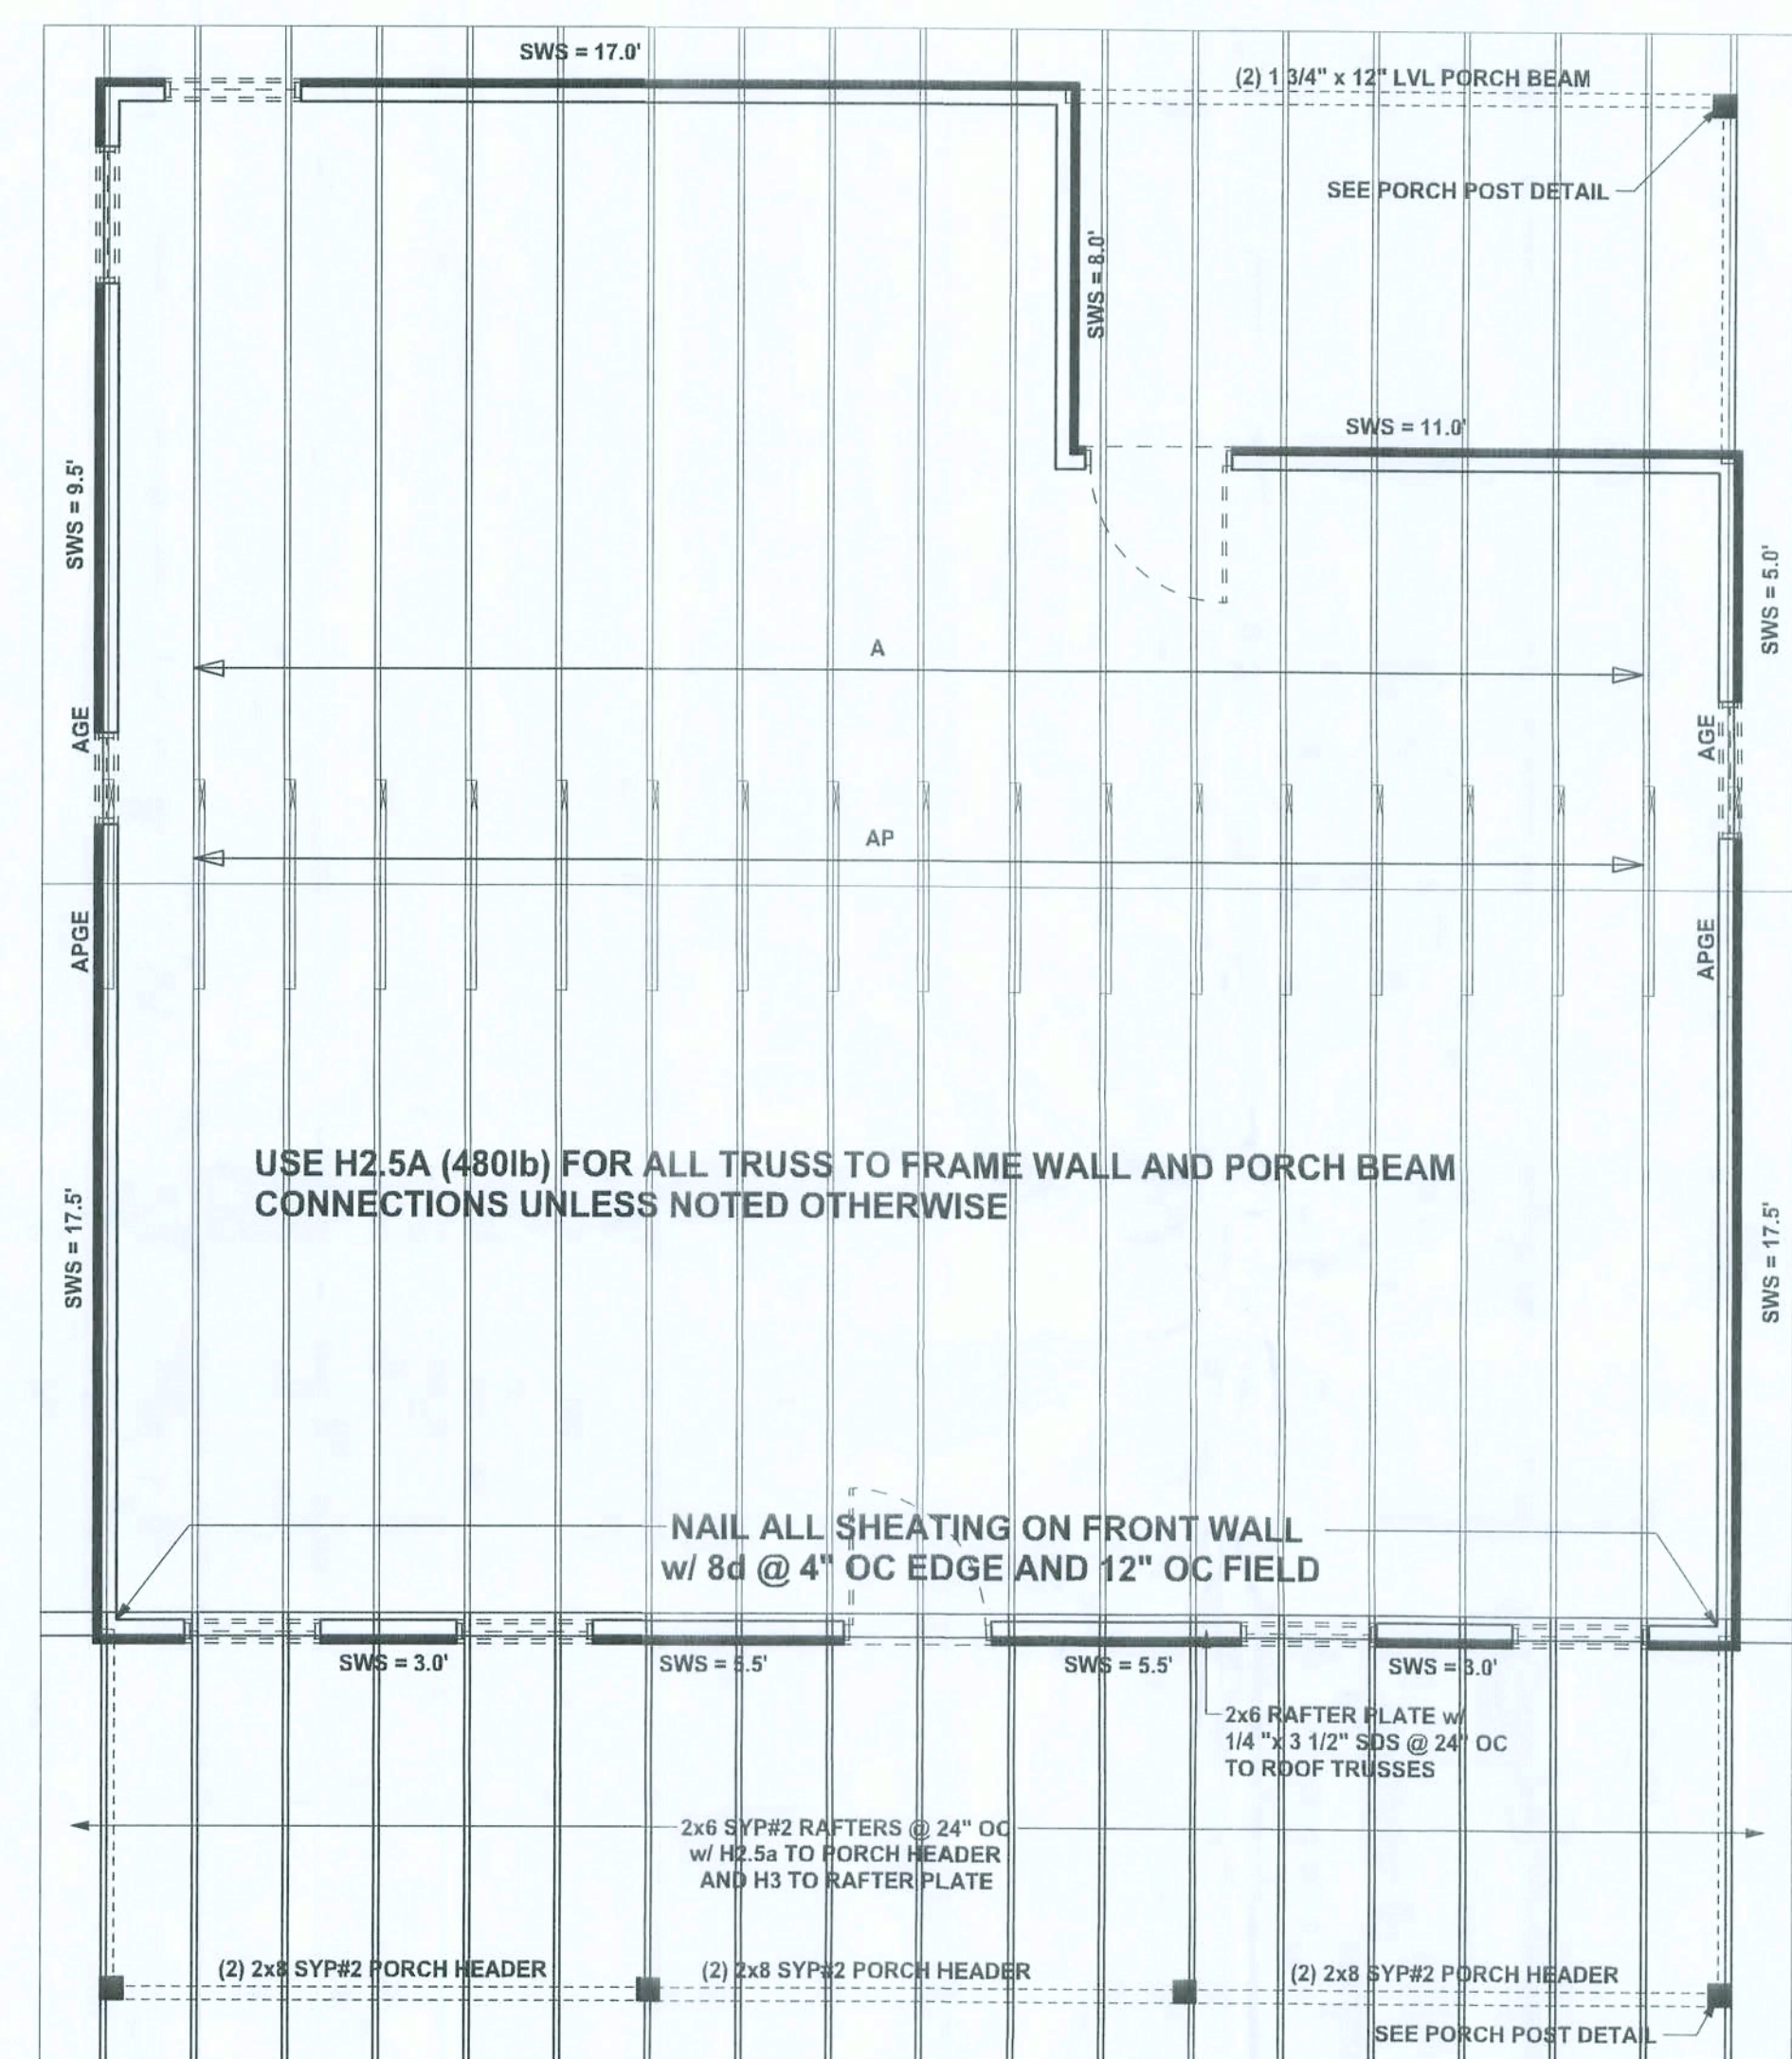

STRUCTURAL PLAN  
SCALE: 1/4" = 1'-0"

CONNECTIONS, WALL, & HEADER DESIGN IS BASED ON REACTIONS & UPLIFTS FROM TRUSS ENGINEERING FURNISHED BY BUILDER: ANDERSON TRUSS CO. JOB # 9-097

WINDLOAD ENGINEER: Mark Disoway, P.E. No. 53915, P.C. 868, Lake City, FL 32055, 386-754-5119

DIMENSIONS: Stated dimensions supersede scaled dimensions. Referral questions to Mark Disoway, P.E. for resolution. Do not proceed without clarification.

COPYRIGHTS AND PROPERTY RIGHTS: Mark Disoway, P.E. hereby expressly reserves his common law copyright and property right in these instrument of service. This document is not to be reproduced, altered or copied in any form or manner without first the express written permission and consent of Mark Disoway.

CERTIFICATION: I hereby certify that I have examined this plan, and that the applicable portions of the plan, relating to wind engineering comply with section R301.2.1, Florida building code residential 207, to the best of my knowledge.

LIMITATION: This design is valid for one building, at specified location.

MARK DISOWAY  
P.E. 53915  
SEAL

Jefi Swanson

Harris-Shepherd Residence

ADDRESS:  
Ft. White, Florida

Mark Disoway P.E.  
P.O. Box 868  
Lake City, Florida 32056  
Phone: (386) 754 - 5419  
Fax: (386) 269 - 4871

PRINTED DATE:  
May 15, 2009

DRAWN BY: STRUCTURAL BY:  
Evan Beamsley

FINAL DATE  
28Apr09

JOB NUMBER:  
04272

DRAWING NUMBER  
S-2  
OF 2 SHEETS







REVISIONS



ANCHOR TABLE

OBTAIN UPLIFT REQUIREMENTS FROM TRUSS MANUFACTURER'S ENGINEERING

UPLIFT LBS. SYP	UPLIFT LBS. SPF	TRUSS CONNECTOR*	TO PLATES	TO RAFTER/TRUSS	TO STUDS
< 420	< 245	H5A	3-8d	3-8d	
< 455	< 265	H5	4-8d	4-8d	
< 380	< 235	H4	4-8d	4-8d	
< 455	< 320	H3	4-8d	4-8d	
< 415	< 365	H2.5	5-8d	5-8d	
< 600	< 535	H2.5A	5-8d	5-8d	
< 950	< 820	H6	8-8d	8-8d	
< 745	< 565	H8	5-10d, 1 1/2"	5-10d, 1 1/2"	
< 1465	< 1050	H14-1	13-8d	12-8d, 1 1/2"	
< 1465	< 1050	H14-2	15-8d	12-8d, 1 1/2"	
< 990	< 850	H10-1	8-8d, 1 1/2"	8-8d, 1 1/2"	
< 760	< 655	H10-2	6-10d	6-10d	
< 1470	< 1295	H16-1	10-10d, 1 1/2"	2-10d, 1 1/2"	
< 1470	< 1295	H16-2	10-10d, 1 1/2"	2-10d, 1 1/2"	
< 1000	< 860	MTS24C	7-10d 1 1/2"	7-10d 1 1/2"	
< 1450	< 1245	HTS24	12-10d 1 1/2"	12-10d 1 1/2"	
< 2900	< 2400	2 - HTS24			
< 2250	< 1785	LGT2	14-16d	14-16d	
HEAVY GIRDER TIEDOWNS*					TO FOUNDATION
< 3965	< 3330	MSGT		22-10d	1-5/8" THREADED ROD 12" EMBEDMENT
< 10980	< 6485	HGT-2		16-10d	2-5/8" THREADED ROD 12" EMBEDMENT
< 10530	< 9035	HGT-3		16-10d	2-5/8" THREADED ROD 12" EMBEDMENT
< 9250	< 9250	HGT-4		16-10d	2-5/8" THREADED ROD 12" EMBEDMENT
STUD STRAP CONNECTOR*					TO STUDS
< 435	< 435	SSP DOUBLE TOP PLATE	3-10d		4-10d
< 455	< 420	SSP SINGLE SILL PLATE	1-10d		4-10d
< 825	< 825	DSP DOUBLE TOP PLATE	6-10d		8-10d
< 825	< 600	DSP SINGLE SILL PLATE	2-10d		8-10d
< 885	< 760	SP4			6-10d, 1 1/2"
< 1240	< 1065	SPH4			10-10d, 1 1/2"
< 885	< 760	SP6			6-10d, 1 1/2"
< 1240	< 1065	SPH6			10-10d, 1 1/2"
< 1235	< 1165	LSTA18	14-10d		
< 1235	< 1235	LSTA21	16-10d		
< 1030	< 1030	CS20	18-8d		
< 1705	< 1705	CS16	28-8d		
STUD ANCHORS*					TO FOUNDATION
< 1350	< 1305	LTT19	8-16d		1/2" AB
< 2310	< 2310	LTT131	18-10d, 1 1/2"		1/2" AB
< 2775	< 2570	HD2A	2-5/8" BOLTS		5/8" AB
< 4175	< 3695	HTT16	18 - 16d		5/8" AB
< 1400	< 1400	PAHD42	16-16d		
< 3335	< 3335	HPAHD22	16-16d		
< 2200	< 2200	ABU44	12-16d		1/2" AB
< 2300	< 2300	ABU66	12-16d		1/2" AB
< 2320	< 2320	ABU88	18 - 16d		2-5/8" AB

GENERAL NOTES:

TRUSSES: TRUSSES SHALL BE DESIGNED BY A FLORIDA LICENSED ENGINEER IN ACCORDANCE WITH THE FBCR 2007 TRUSS ENGINEERING SHALL INCLUDE TRUSS DESIGN, DETAILING PLANS, TEMPORARY AND PERMANENT BRACING DETAILS, TRUSS-TO-TRUSS CONNECTIONS, AND UPLIFT AND REACTION LOADS FOR ALL BEARING LOCATIONS. TRUSS ENGINEERING IS THE RESPONSIBILITY OF THE TRUSS MANUFACTURER AND SHALL BE SIGNED & SEALED BY THE MANUFACTURER'S DESIGN ENGINEER. IT IS THE BUILDER'S RESPONSIBILITY TO VERIFY THE TRUSS DESIGNER FULLY SATISFIED ALL THE ABOVE REQUIREMENTS AND TO SELECT UPLIFT CONNECTIONS BASED ON TRUSS ENGINEERING UPLIFT AND PROVIDE FOOTINGS FOR INTERIOR BEARING WALLS. BUILDER IS TO FURNISH TRUSS ENGINEERING TO WIND LOAD ENGINEER FOR REVIEW OF TRUSS REACTIONS ON THE BUILDING STRUCTURE. STRAP 2X6 RAFTERS WITH MIN UPLIFT CONNECTION 415LB EACH END; 2X8 RAFTERS 700 LB EACH END.

SITE PREPARATION: SITE ANALYSIS AND PREPARATION IS NOT PART OF THIS PLAN.

FOUNDATION: CONFIRM THAT THE FOUNDATION DESIGN & SITE CONDITIONS MEET GRAVITY LOAD REQUIREMENTS (ASSUME 1000 PSF BEARING CAPACITY UNLESS VISUAL OBSERVATION OR SOIL'S TEST PROVIDES OTHERWISE).

CONCRETE: MINIMUM COMPRESSIVE STRENGTH OF CONCRETE AT 28 DAYS,  $F_c = 3000$  PSI.

WELDED WIRE REINFORCED SLAB: 8" x 8" W14 x W14, FB = 85KSI. WELDED WIRE REINFORCEMENT FABRIC (W.W.R.) CONFORMING TO ASTM A185 LOCATED IN MIDDLE OF THE SLAB, SUPPORTED WITH APPROVED MATERIALS OR SUPPORTS AT SPACINGS NOT TO EXCEED 3'.

FIBER CONCRETE SLAB: CONCRETE SLABS ON GROUND CONTAINING SYNTHETIC FIBER REINFORCEMENT. FIBER LENGTH 1/2 INCH TO 2 INCHES. DOSAGE AMOUNTS FROM 0.75 TO 1.5 POUNDS PER CUBIC YARD PER THE MANUFACTURER'S RECOMMENDATIONS. FIBERS TO COMPLY WITH ASTM C 1116. SUPPLIER TO PROVIDE ASTM C 1116 CERTIFICATION OF COMPLIANCE WHEN REQUESTED BY BUILDING OFFICIAL.

CONTROL JOINTS: WHERE SPECIFIED, SAWN CONTROL JOINTS IN SLAB-ON-GRADE SHALL BE CUT IN ACCORDANCE WITH ACI 302. JOINTS SHALL BE CUT WITHIN 12 HOURS OF SLAB PLACEMENT. THE LENGTH / WIDTH RATIOS OF SLAB AREAS SHALL NOT EXCEED 1.5 AND TYPICAL SPACING OF CUTS TO BE 12 FT. DO NOT CUT W.W.R. OR REINFORCING STEEL. RECOMMENDED LOCATION OF CONTROL JOINTS IS SUBJECT TO OWNER AND CONTRACTOR'S APPROVAL. THE CONTROL JOINTS ARE NOT INTENDED TO PREVENT CRACKS BUT RATHER TO ENCOURAGE THE SLAB TO CRACK ON A GIVEN LINE.)

REBAR: ASTM A 615, GRADE 60, DEFORMED BARS,  $F_y = 60$  KSI. ALL LAP SPICES 40" DB (25" FOR #5 BARS); UNO. ALL REINFORCEMENT SHALL BE DETAILLED AND PLACED IN ACCORDANCE WITH ACI 315-96, U.N.O.

GLULAM BEAMS: GLULAM BEAM GLB, 24F-V3SP,  $F_b = 2400$  psi,  $E = 1800000$  psi. SUPPLIER MAY SUPPLY AN ALTERNATE BEAM WITH EQUAL PROPERTIES OR MAY SUBMIT THEIR OWN SIZING CALC.

ROOF SHEATHING: ALL ROOFS ARE HORIZONTAL DIAPHRAGMS. 7/16" OSB SHEATHING, UNBLOCKED, APPLIED PERPENDICULAR TO FRAMING, OVER A MINIMUM OF 3 FRAMING MEMBERS, WITH PANEL EDGES STAGGERED, FASTENED WITH #6 COMMON NAILS (131), 6"OC PANEL EDGES, 12"OC INTERMEDIATE MEMBERS, GABLE ENDS AND DIAPHRAGM BOUNDARY, 4"OC UNO.

STRUCTURAL CONNECTORS: MANUFACTURERS AND PRODUCT NUMBER FOR CONNECTORS, ANCHORS, AND REINFORCEMENT ARE LISTED FOR EXAMPLE NOT ENDORSEMENT, AN EQUIVALENT DEVICE OF THE SAME OR OTHER MANUFACTURER CAN BE SUBSTITUTED FOR ANY DEVICES LISTED IN THE EXAMPLE TABLES AS LONG AS IT MEETS THE REQUIRED LOAD CAPACITIES. MANUFACTURER'S INSTALLATION INSTRUCTIONS MUST BE FOLLOWED TO ACHIEVE RATED LOADS.

ANCHOR BOLTS: A-307 ANCHOR BOLTS WITH MINIMUM EMBEDMENT AS SPECIFIED IN DRAWINGS BUT NO LESS THAN 7" IN CONCRETE OR REINFORCED BOND BEAM OR 15" IN GROUTED CMU.

WASHERS: WASHERS USED WITH 1/2" BOLTS TO BE 2" x 2" x 9/64", WITH 5/8" BOLTS TO BE 3" x 3" x 9/64", WITH 3/4" BOLTS TO BE 3" x 3" x 9/64". WITH 1/2" BOLTS TO BE 2" x 2" x 9/64".

NAILS: ALL NAILS ARE COMMON NAILS UNLESS OTHERWISE SPECIFIED OR ACCEPTED BY FBC TEST REPORTS AS HAVING EQUAL STRUCTURAL VALUES.

BUILDER'S RESPONSIBILITY

THE BUILDER AND OWNER ARE RESPONSIBLE FOR THE FOLLOWING, WHICH ARE SPECIFICALLY NOT PART OF THE WIND LOAD ENGINEER'S SCOPE OF WORK.

CONFIRM SITE CONDITIONS, FOUNDATION BEARING CAPACITY, GRADE AND BACKFILL HEIGHT, WIND SPEED AND DEBRIS ZONE, AND FLOOD ZONE.

PROVIDE MATERIALS AND CONSTRUCTION TECHNIQUES, WHICH COMPLY WITH FBCR 2007 REQUIREMENTS FOR THE STATED WIND VELOCITY AND DESIGN PRESSURES.

PROVIDE A CONTINUOUS LOAD PATH FROM TRUSSES TO FOUNDATION. IF YOU BELIEVE THE PLAN OMMITS A CONTINUOUS LOAD PATH CONNECTION, CALL THE WIND LOAD ENGINEER IMMEDIATELY.


VERIFY THE TRUSS MANUFACTURER'S SEALED ENGINEERING INCLUDING TRUSS DESIGN, DETAILING PLANS, TEMPORARY AND PERMANENT BRACING DETAILS, TRUSS-TO-TRUSS CONNECTIONS, AND UPLIFT AND REACTION LOADS FOR ALL BEARING LOCATIONS.

ROOF SYSTEM DESIGN

THE SEAL ON THESE PLANS FOR COMPLIANCE WITH FBCR 2007, SECTION R301.2.1 IS BASED ON REACTIONS, UPLIFTS, AND BEARING LOCATIONS IN TRUSS ENGINEERING SUBMITTED TO THE WIND LOAD ENGINEER. IT IS THE RESPONSIBILITY OF THE BUILDER TO CHECK ALL DETAILS OF THE COMPLETE ROOF SYSTEM DESIGN SUBMITTED BY THE TRUSS MANUFACTURER AND HAVE IT SIGNED, AND SEALED BY A DESIGN PROFESSIONAL FOR CORRECT APPLICATION OF FBC 2007 REQUIRED LOADS AND ANY SPECIAL LOADS. THE BUILDER IS RESPONSIBLE TO REVIEW EACH INDIVIDUAL TRUSS MEMBER AND THE TRUSS ROOF SYSTEM AS A WHOLE AND TO PROVIDE RESTRAINT FOR ANY LATERAL BRACING. THE BUILDER SHOULD USE CARE CHECKING THE REACTIONS DESIGN BECAUSE THE WIND LOAD ENGINEER IS SPECIFICALLY NOT RESPONSIBLE FOR THE TRUSS LAYOUT WHICH WAS CREATED BY THE TRUSS MANUFACTURER AND THE TRUSS DESIGNER ALSO DESIGNS RESPONSIBILITY FOR THE LAYOUT PER NOTES ON THEIR SEALED TRUSS SHEETS.

GRADE & SPECIES TABLE


		Fb (psi)	E (10 <sup>6</sup> psi)
2x8	SYP #2	1200	1.6
2x10	SYP #2	1050	1.6
2x12	SYP #2	975	1.6
GLB	24F-V3 SP	2400	1.8
LSL	TIMBERSTRAND	1700	1.7
LVL	MICROLAM	1600	1.9
PSL	PARALAM	2800	2.0

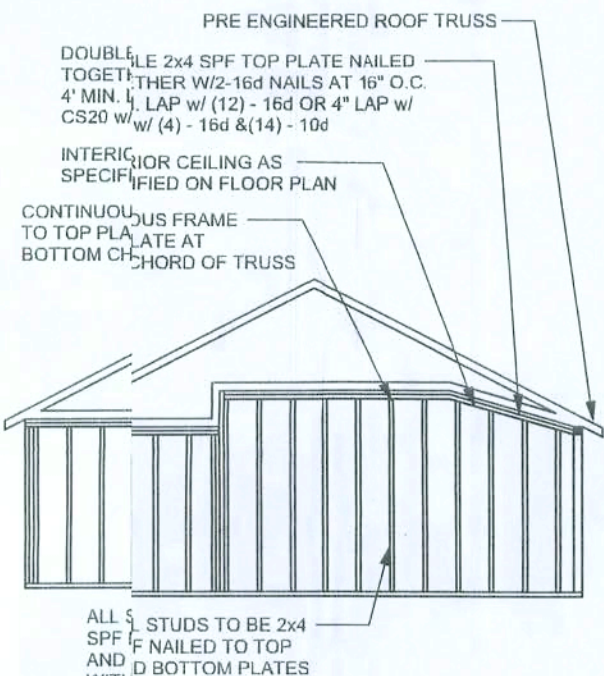

CONTINUOUS FRAME TO CEILING DIAPHRAGM DETAIL


SCALE: E = N.T.S.

NOTE: IF TRUSS TO WALL STRAPS ARE NAILED TO THE HEADER THE SPH4/6 @ 48" O.C. ARE NOT REQUIRED

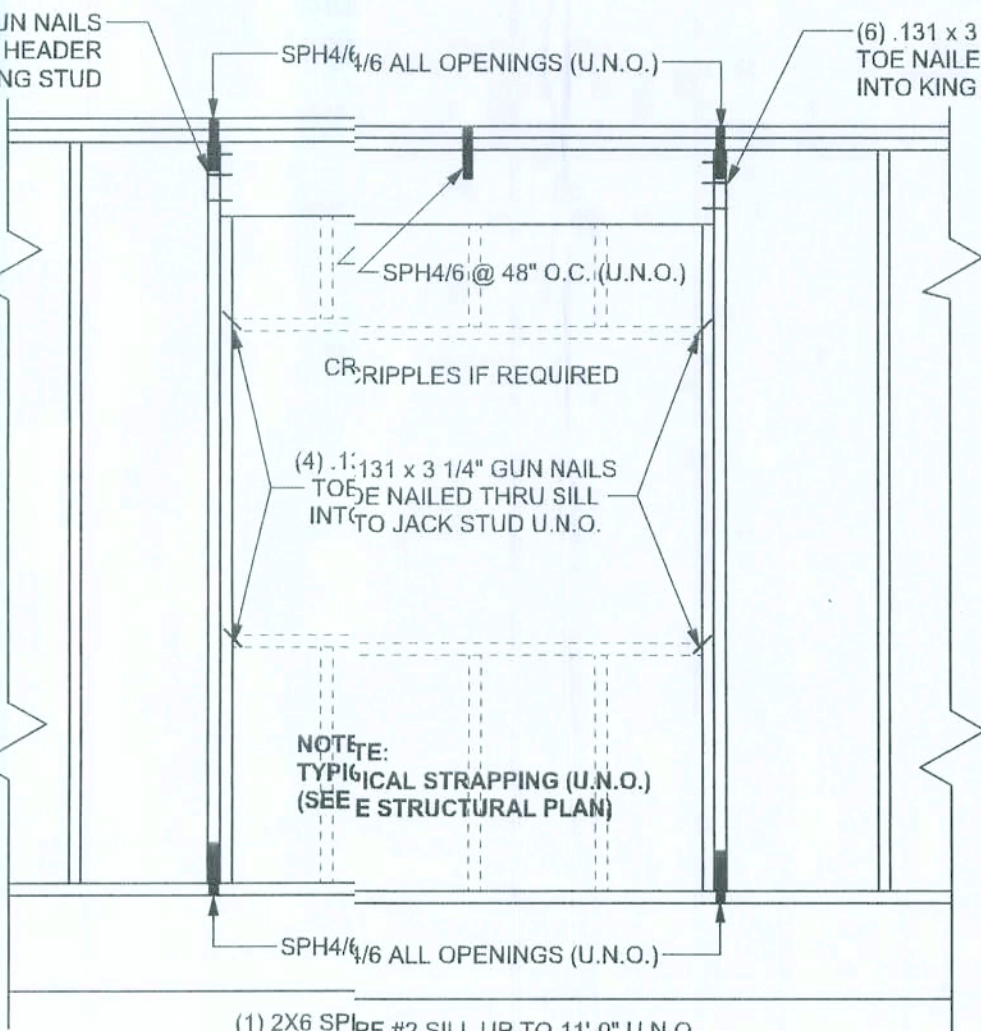

TYPICAL HEADER STRAPPING DETAIL

SCALE: 1/2" = 1'-0"

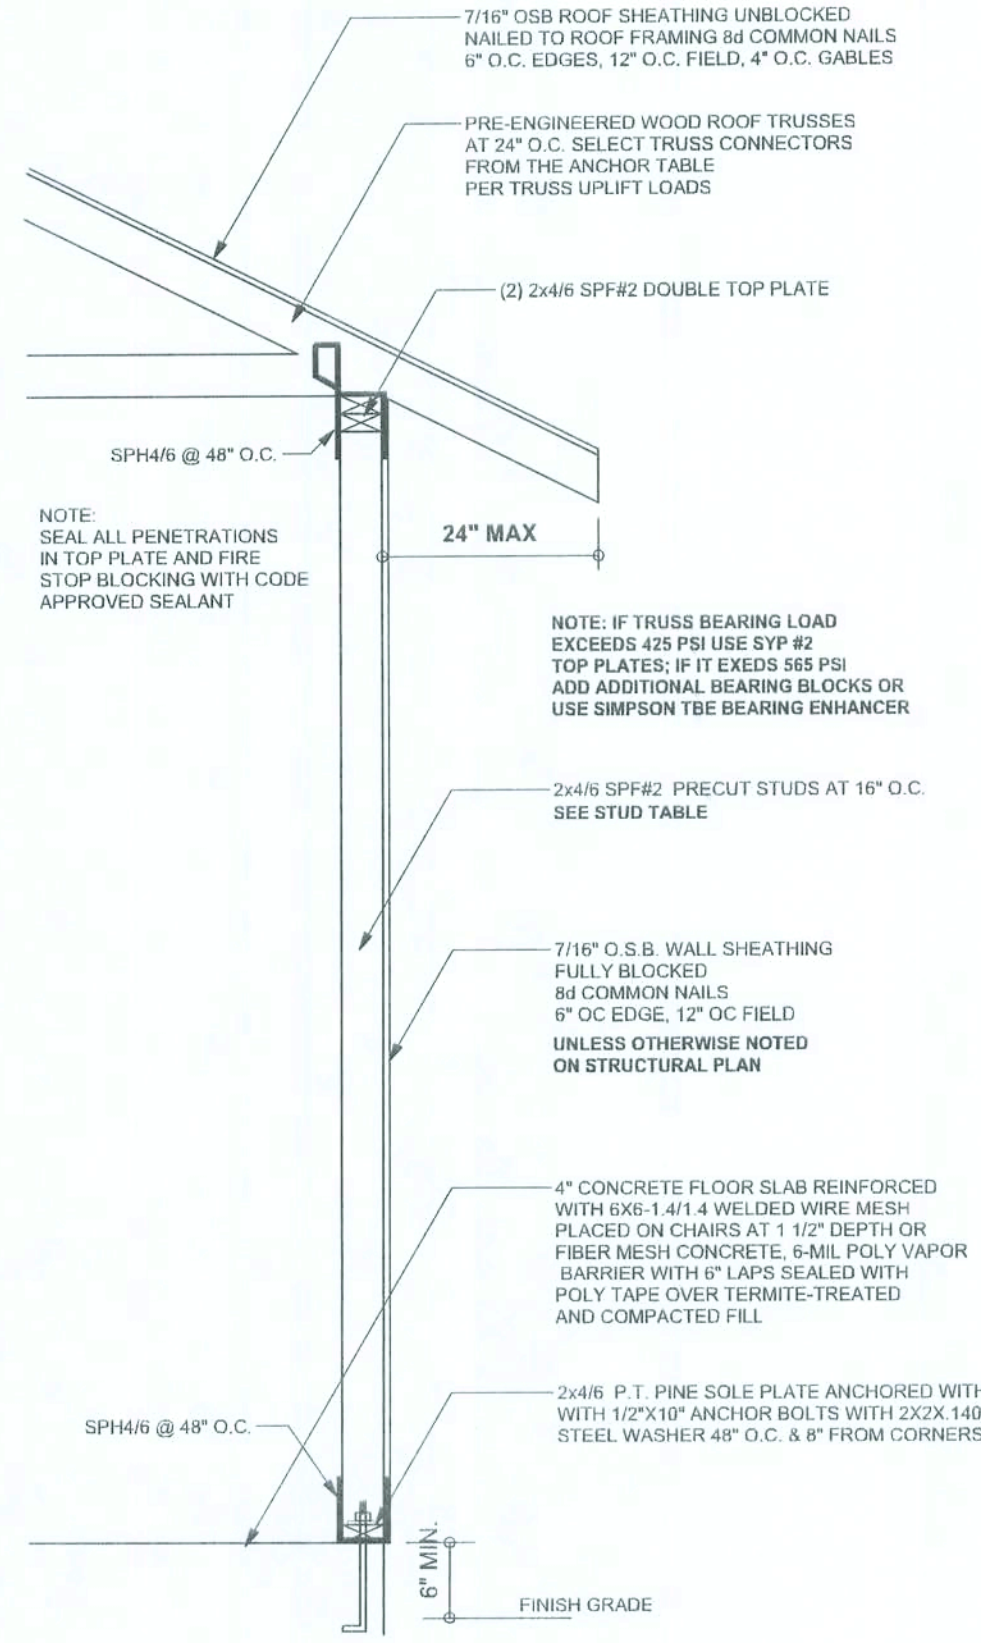


ONE STORY WALL SECTION

SCALE: 3/4" = 1'-0"

EXTERIOR WALL STUD TABLE FOR SPF #2 STUDS


(1) 2x4 @ 16" OC	TO 10'-6" STUD HEIGHT
(1) 2x4 @ 12" OC	TO 11'-7" STUD HEIGHT
(1) 2x6 @ 16" OC	TO 16'-10" STUD HEIGHT
(1) 2x6 @ 12" OC	TO 18'-7" STUD HEIGHT

THIS STUD HEIGHT TABLE IS PER WFCM 2001, TABLE 3.208. EXTERIOR LOAD BEARING & NON LOAD BEARING STUD LENGTHS RESISTING INTERIOR ZONE WIND LOADS 110 MPH EXPOSURE C STUD SPACINGS SHALL BE MULTIPLIED BY 0.85 FOR FRAMING LOCATED WITHIN 4 FEET OF CORNERS FOR END ZONE LOADS. EXAMPLE 16" O.C. x 0.85 = 13.6" O.C.

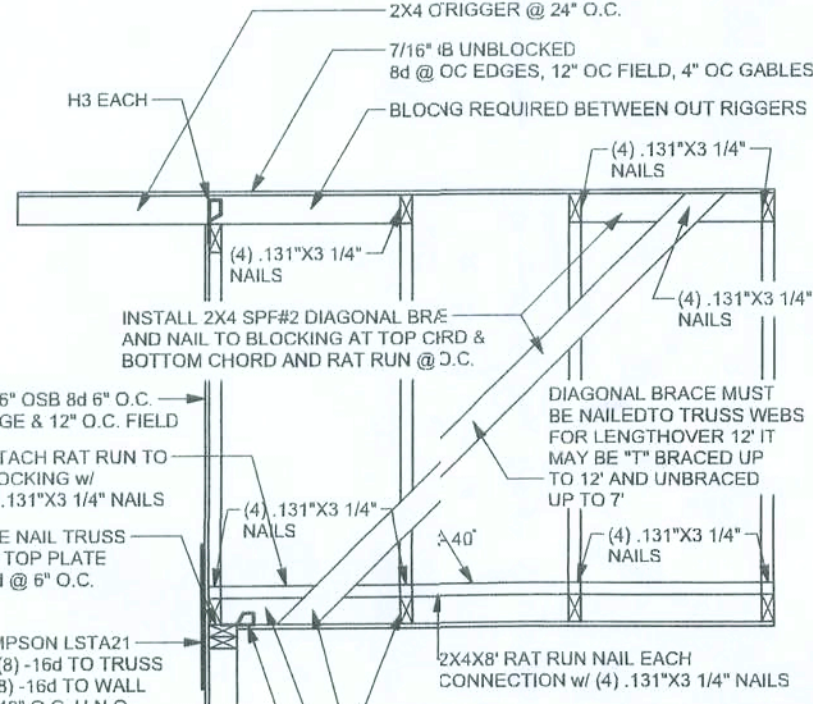


(TYP.) GABLE BRACING DETAIL

WOOD FRAME

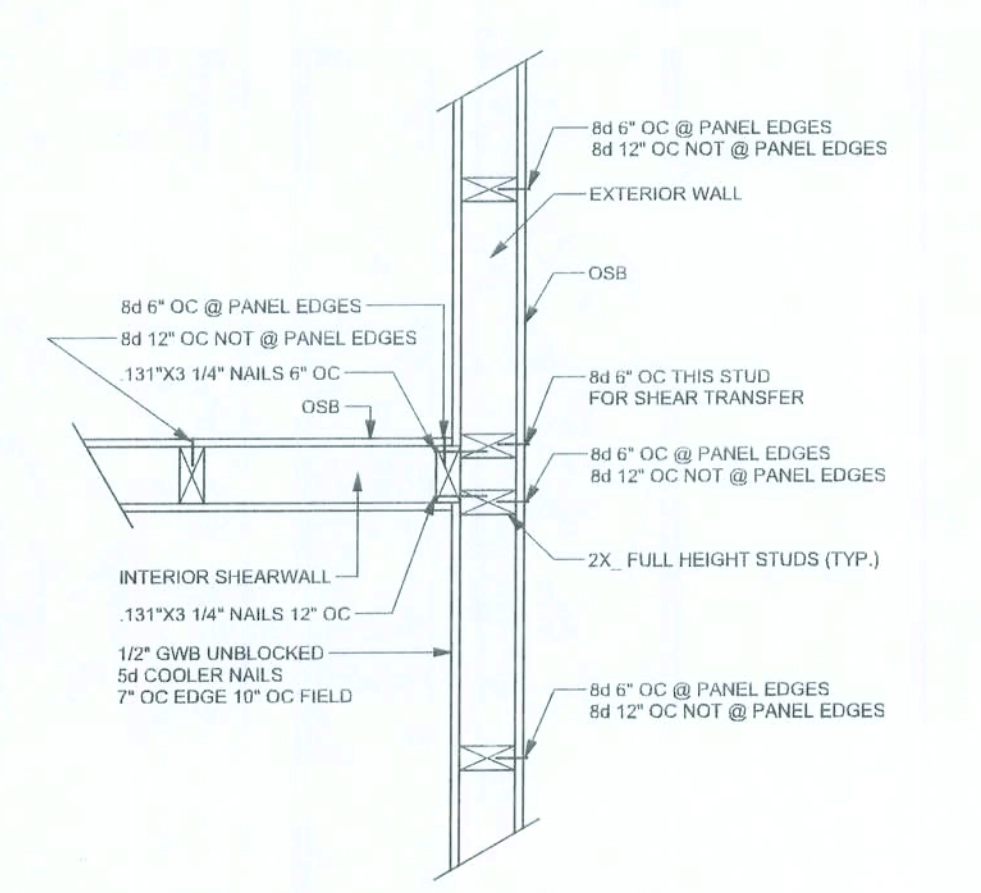

(TYP.) INTERSECTING WALL FRAMING

WOOD FRAME

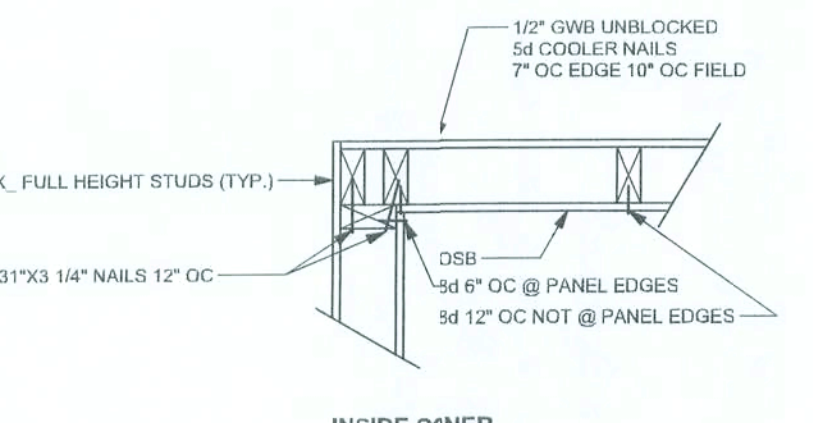

(TYP.) CORNER FRAMING

WOOD FRAME

DESIGN DATA


WIND LOADS PER FLORIDA BUILDING CODE 2007 RESIDENTIAL, SECTION R301.2.1

(ENCLOSED SIMPLE DIAPHRAGM BUILDINGS WITH FLAT, HIPPED, OR GABLE ROOFS. MEAN ROOF HEIGHT NOT EXCEEDING LEAST HORIZONTAL DIMENSION OR 60 FT.; NOT ON UPPER HALF OF HILL OR ESCARPMENT 60FT IN EXP. B, 30FT IN EXP. C AND >10% SLOPE AND UNOBSTRUCTED UPWIND FOR 50x HEIGHT OR 1 MILE WHICHEVER IS LESS.)

BUILDING IS NOT IN THE HIGH VELOCITY HURRICANE ZONE

BUILDING IS NOT IN THE WIND-BORNE DEBRIS REGION

- 1.) BASIC WIND SPEED = 110 MPH
- 2.) WIND EXPOSURE = C
- 3.) WIND IMPORTANCE FACTOR = 1.0
- 4.) BUILDING CATEGORY = II
- 5.) ROOF ANGLE = 10-45 DEGREES
- 6.) MEAN ROOF HEIGHT = <30 FT
- 7.) INTERNAL PRESSURE COEFFICIENT = N/A (ENCLOSED BUILDING)
- 8.) COMPONENTS AND CLADDING DESIGN WIND PRESSURES (TABLE R301.2(2))

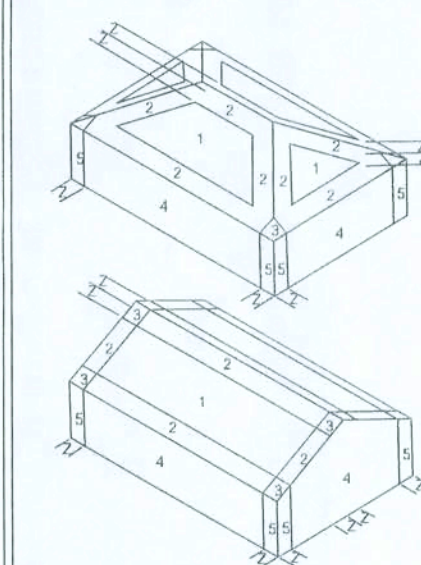

Zone	Effective Wind Area (ft <sup>2</sup> )	10	15	20	25	30
1	27.8	30.5	25.3	25.3		
2	27.8	35.7	25.3	30.5		
2 Orhg			56.8	56.8		
3	27.8	35.7	25.3	30.5		
3 Orhg			56.8	56.8		
4	30.5	33.0	25.9	28.5		
5	30.5	40.7	25.9	31.6		
Doors & Windows			30.5	40.7		
Worst Case (Zone 5, 10 ft2)					27.3	32.0
8x7 Garage Door					25.9	29.4
16x7 Garage Door						

DESIGN LOADS

FLOOR	40 PSF (ALL OTHER DWELLING ROOMS)
	30 PSF (SLEEPING ROOMS)
	30 PSF (ATTICS WITH STORAGE)
	10 PSF (ATTICS WITHOUT STORAGE, <3:12)
ROOF	20 PSF (FLAT OR <4:12)
	16 PSF (4:12 TO <12:12)
	12 PSF (12:12 AND GREATER)
STAIRS	40 PSF (ONE & TWO FAMILY DWELLINGS)
SOIL BEARING CAPACITY	1000PSF
NOT IN FLOOD ZONE (BUILDER TO VERIFY)	

WINDLOAD ENGINEER: Mark Dicosway, P.E. No. 53915, P.O. Box 868, Lake City, FL 32056, 386-754-549

DIMENSIONS: Stated dimensions are approximate scaled dimensions. Refer all questions to Mark Dicosway, P.E. for resolution. Do not proceed without clarification.

COPYRIGHTS AND PROPERTY RIGHTS: Mark Dicosway, P.E. hereby expressly reserves his common law copyrights and property right in these instruments & service. This document is not to be reproduced, altered or copied in any form or manner without first the express written permission and consent of Mark Dicosway.

CERTIFICATION: I hereby certify that I have examined this plan and that the applicable portions of the plan, relating to wind engineering comply with section R301.2.1, Florida building code residential 2007, to the best of my knowledge.

LIMITATION: This design is valid for one building, at specified location.

MARK DICOSWAY P.E. 53915

SEAL

Jeff Swanson

Harri-Shepherd Residence

ADDRESS: Ft. Ytute, Florida

Mark Dicosway P.E.  
P.O. Box 868  
Lake City, Florida 32056  
Phone: (386) 754 - 5419  
Fax: (386) 269 - 4871

PRINTED DATE: April 18, 2009

DRAWN BY: STRUCTURAL BY: Evan Beasley

FINALS DATE: 28Apr09


JOB NUMBER: 904272

DRAWING NUMBER

S-1

OF 2 SHEETS



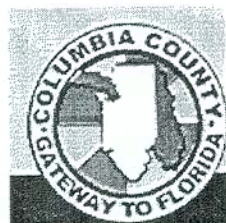

From: The Columbia County Building & Zoning Department  
Plan Review  
135 NE Hernando Av.  
P.O. Box 1529  
Lake City Florida 32056-1529

Reference to a building permit application Number: **0905-21**

Applicant: Diane Shepherd Owner/Builder: Property Identification number:  
8-6S-17-096266-116  
On the date of May 22, 2009 application 0905-21 and plans were reviewed for  
compliance of the 2007 Florida building code/ Residential. The documents are  
plans submitted are for construction of a R3 single family dwelling.

Reviewed the following listed information for code compliance with the Florida  
building code/ Residential.

On the electrical plan all circuits within the bedroom shall be protected with an  
Arc-Fault Circuit breaker.

If a gas air handler is used the wall and ceiling which enclose the gas air handler  
closet shall be protected with type X 5/8" sheetrock and all joints shall be sealed  
and taped. The Florida Energy Efficiency Code line 13 states that the heating  
system to be an electrical heat pump. Please verify with this department if a gas  
air handler is installed.


At the electrical service entrance point (utility author meter base) an overcurrent  
protection device shall be installed on the exterior of structure which will provide  
overcurrent protection for the total service amperage rating and a means of  
disconnecting electrical service from the serving utility company. Conductors  
used from the exterior disconnecting means to a panel or sub panel shall have  
four-wire conductors, of which one conductor shall be used as an equipment  
ground.

Thank You:

## ELECTRICAL KEY

- ⊕ DUPLEX CONVENIENCE OUTLET
- ⊕ DUPLEX OUTLET ABOVE COUNTER
- ⊕ WEATHERPROOF DUPLEX OUTLET
- ⊕ GROUND FAULT INTERRUPTER DUPLEX OUTLET
- ⊕ ARCH FAULT INTERRUPTER OUTLET IN ALL BEDROOMS
- ⊕ HALF-SWITCHED DUPLEX OUTLET
- ⊕ SPECIAL PURPOSE OUTLET
- ⊕ DUPLEX OUTLET IN FLOOR
- ⊕ 220 VOLT OUTLET
- ⊕ WALL SWITCH
- ⊕ MANUAL ON OCCUPANT SENSORS SWITCH
- ⊕ WALL DIMMER SWITCH
- ⊕ THREE-WAY SWITCH
- ⊕ FOUR-WAY SWITCH
- ⊕ SURFACE MOUNTED LIGHT FIXTURE (INCANDESCENT UNLESS LABELED HEL)
- ⊕ WALL MOUNT LIGHT FIXTURE (INCANDESCENT UNLESS LABELED HEL)
- ⊕ RECESSED LIGHT FIXTURE (INCANDESCENT UNLESS LABELED HEL)
- ⊕ LIGHT FIXTURE WITH PULL CHAIN
- ⊕ TRACK LIGHT
- ⊕ FLUORESCENT LIGHT FIXTURE
- ⊕ EXHAUST FAN
- ⊕ EXHAUST FAN/LIGHT COMBINATION
- ⊕ HIGH EFFICACY LUMINAIRES (PIN BASED)
- ⊕ ELECTRIC DOOR OPERATOR (OPTIONAL)
- ⊕ CHIMES
- ⊕ PUSH-BUTTON SWITCH
- ⊕ SMOKE DETECTOR
- ⊕ CARBON MONOXIDE DETECTOR
- ⊕ TELEPHONE
- ⊕ TELEVISION
- ⊕ THERMOSTAT
- ⊕ GAS STUB WITH VALVE
- ⊕ ELECTRIC METER
- ⊕ 200 AMP. ELECTRIC PANEL
- ⊕ DISCONNECT SWITCH
- ⊕ SPEAKER (OPTIONAL)
- ⊕ FUTURE ELECTRIC VEHICLE CIRCUIT PROVIDE 3/4" CONDUIT FROM PANEL TO 2-GANG BOX AT 18" MIN. - 48" MAX. ABV. FLOOR
- ⊕ CEILING FAN W/ TWO SWITCHES
- ⊕ BLOCK LIGHT BOX FOR CEILING FAN CONVERSION

- NOTES:**
1. PROVIDE AND INSTALL GROUND FAULT CIRCUIT-INTERRUPTERS (GFI) AS INDICATED ON PLANS.
  2. UNLESS OTHERWISE INDICATED, INSTALL SWITCHES & RECEPTACLES AT THE FOLLOWING HEIGHTS ABOVE FINISH FLOOR:  
SWITCHES...42"  
OUTLETS...18"  
TELEPHONE...14"  
TELEVISION...14"
  3. ALL SMOKE DETECTORS SHALL BE HARDWIRED INTO AN ELECTRICAL POWER SOURCE AND SHALL BE EQUIPPED WITH A MONITORED BATTERY BACKUP. PROVIDE AND INSTALL LOCALLY CERTIFIED SMOKE DETECTORS.
  4. ALL CIRCUITS IN SLEEPING ROOMS SHALL BE ON A AFCI PROTECTED CIRCUIT.
  5. IT IS THE RESPONSIBILITY OF THE LICENSED ELECTRICIAN TO INSURE THAT ALL ELECTRICAL WORK IS IN FULL COMPLIANCE WITH NEC, CALIFORNIA BUILDING CODE, AND ALL APPLICABLE LOCAL STANDARDS, CODES, AND ORDINANCES.
  6. BATHROOM OUTLETS SHALL BE SUPPLIED BY AT LEAST ONE 20AMP BRANCH CIRCUIT WITH NO OTHER OUTLETS ON SUCH CIRCUIT (NEC 210-52(d)).
  7. PROVIDE A RECEPTACLE WITHIN 25 FEET OF THE A/C CONDENSER UNIT (DUC 306.3, 307.3, NEC 210-63).
  8. SPRINKLER IRRIGATION: PROVIDE LOW VOLTAGE WIRE FROM THEIR LOCATION TO HOUSE WATER SHUTOFF LOCATION.

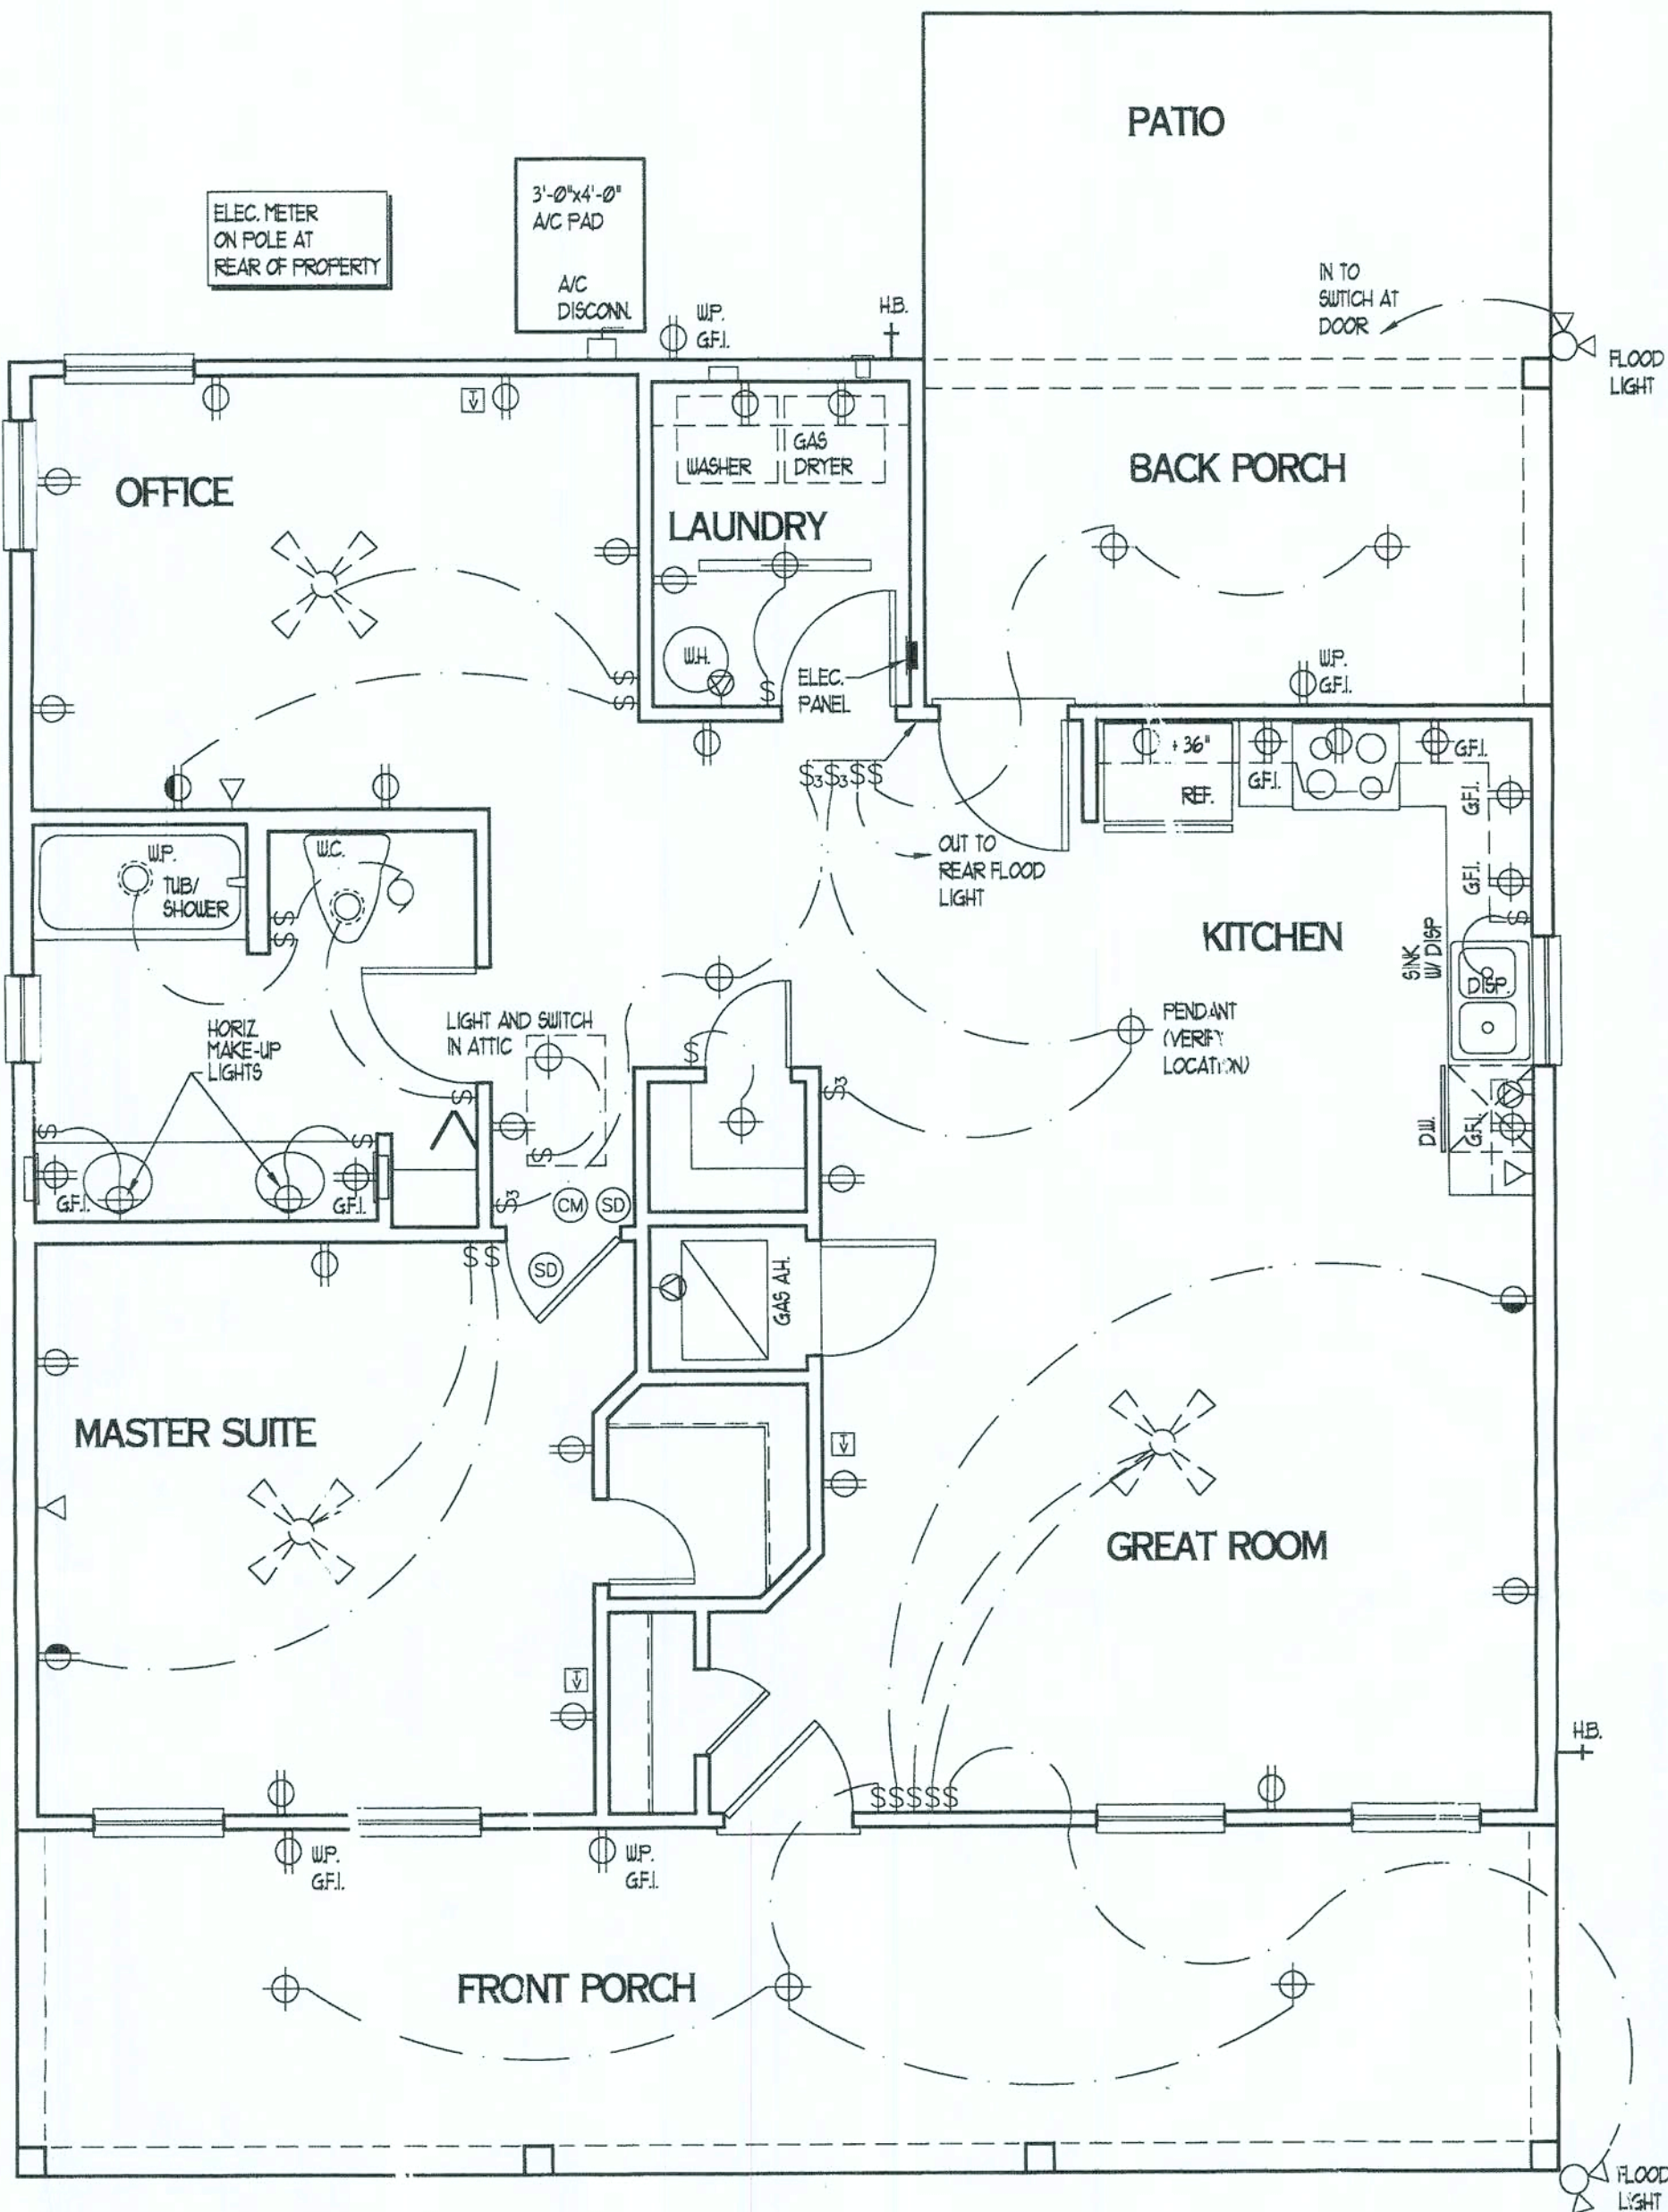


## ELECTRICAL PLAN

SCALE: 1/4" = 1'-0"



JOB NUMBER 3203  
CAD FILE 1107FL  
ISSUED 04-07-09  
REVISED

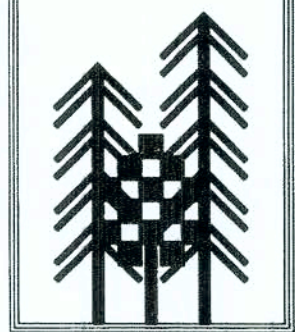

3 TREES  
DESIGN AND DRAFTING, INC.  
305 693 1142 ph  
305 693 1209 fax  
31222-30941INGARCONCAST.NET

HARRIS-SHEPHERD  
FT. WHITE, FL

1107

TITLE  
ELECTRICAL PLAN

SHEET

7