




Mobile Home Permit Worksheet

Installer: William Price License # 114-1041934
 Address of home being installed: 243 NW Concord Ct.
Lake City FL 32055
 Manufacturer: LOH Length x width: 72x28



NOTE: If home is a single wide fill out one half of the blocking plan
 If home is a triple or quad wide sketch in remainder of home
 I understand Lateral Arm Systems cannot be used on any home (new or used)
 where the sidewall ties exceed 5 ft 4 in.

Installer's initials WRP

Typical pier spacing

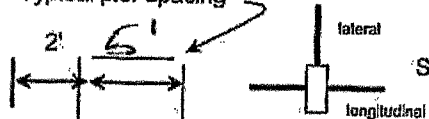

Show locations of Longitudinal and Lateral Systems
 (use dark lines to show these locations)

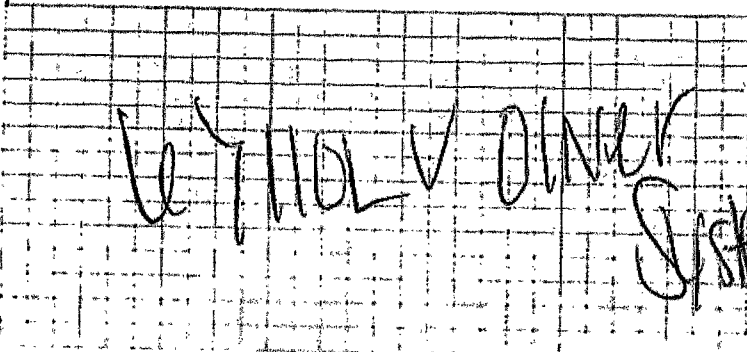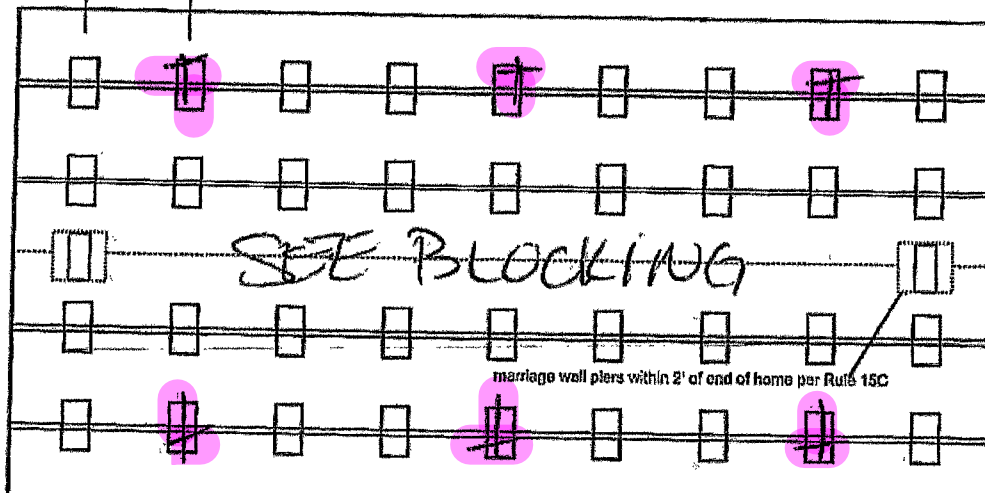

Permit Number: _____ Date: _____

New Home ☒ Used Home ☐

Home installed to the Manufacturer's Installation Manual
 Home is installed in accordance with Rule 15-C ☒

Single wide ☐ Wind Zone II ☒ Wind Zone III ☐

Double wide ☒ Installation Decal # 91577

Triple/Quad ☐ Serial # LOHGA20041141AB

PIER SPACING TABLE FOR USED HOMES

Load bearing capacity	Footer size (sq in)	16' x 16" (256)	18 1/2" x 18 1/2" (342)	20" x 20" (400)	22" x 22" (484)*	24" x 24" (576)*	26" x 26" (676)
1000 psf		3'	4'	5'	6'	7'	8'
1500 psf		4'6"	6'	7'	8'	8'	8'
2000 psf		6'	8'	8'	8'	8'	8'
2500 psf		7'6"	8'	8'	8'	8'	8'
3000 psf		8'	8'	8'	8'	8'	8'
3500 psf		8'	8'	8'	8'	8'	8'

*interpolated from Rule 15C-1 pier spacing table.

PIER PAD SIZES

I-beam pier pad size 17x25

Perimeter pier pad size 11x11

Other pier pad sizes (required by the mfg.) _____

Draw the approximate locations of marriage wall openings 4 foot or greater. Use this symbol to show the piers.

List all marriage wall openings greater than 4 foot and their pier pad sizes below.

Opening	Pier pad size
<u>Large</u>	<u>23x31</u>

POPULAR PAD SIZES

Pad Size	Sq In
18 x 16	256
16 x 18	288
18.5 x 18.5	342
16 x 22.5	360
17 x 22	374
13 1/2 x 26 1/2	348
20 x 20	400
17 3/16 x 26 3/16	441
17 1/2 x 25 1/2	446
24 x 24	576
26 x 26	676

4 ft ☒ 5 ft _____

ANCHORS

FRAME TIES

within 2' of end of home spaced at 5' 4" oc 2x

TIEDOWN COMPONENTS

Longitudinal Stabilizing Device (LSD)

Manufacturer _____

Longitudinal Stabilizing Device w/ lateral Arms

Manufacturer Over Tech

OTHER TIES

	Number
Sidewall	<u>14</u>
Longitudinal	<u>2</u>
Marriage Wall	<u>2</u>
Shear Wall	<u>2</u>



Mobile Home Permit Worksheet

POCKET PENETROMETER TEST

The pocket penetrometer tests are rounded down to _____ psf or check here to declare 1000 lb. soil _____ without testing.

x1000

x1000

x1000

POCKET PENETROMETER TESTING METHOD

1. Test the perimeter of the home at 6 locations.
2. Take the reading at the depth of the footer.
3. Using 500 lb. increments, take the lowest reading and round down to that increment.

x1000

x1000

x1000

TORQUE PROBE TEST

The results of the torque probe test is _____ inch pounds or check here if you are declaring 5' anchors without testing _____. A test showing 275 inch pounds or less will require 5' anchors.

Note: A state approved lateral arm system is being used and 4 ft. anchors are allowed at the sidewall locations. I understand 5' anchors are required at all centerline tie points where the torque test reading is 275 or less and where the mobile home manufacturer may require anchors with 4000 lb. holding capacity.

Installer's initials UPT

ALL TESTS MUST BE PERFORMED BY A LICENSED INSTALLER

Installer Name _____

Date Tested _____

ELECTRICAL

Connect electrical conductors between multi-wide units, but not to the main power source. This includes the bonding wire between multi-wide units. Pg. 69

PLUMBING

Connect all sewer drains to an existing sewer tap or septic tank. Pg. 78

Connect all potable water supply piping to an existing water meter, water tap, or other independent water supply systems. Pg. 77

Permit Number: _____

Date: _____

Site Preparation

Debris and organic material removed 90% to 100%
Water drainage: Natural _____ Swale _____ Pad X Other _____

Fastening multi wide units

Floor- Type Fastener: Lags Length: _____ Spacing: 18"
Walls- Type Fastener: Screws Length: _____ Spacing: 18"
Roof- Type Fastener: 1/2" x 12" Length: _____ Spacing: 18"

For used homes a min. 30 gauge, 8" wide, galvanized metal strip will be centered over the peak of the roof and fastened with galv. roofing nails at 2" on center on both sides of the centerline.

Gasket (weatherproofing requirement)

I understand a properly installed gasket is a requirement of all new and used homes and that condensation, mold, mildew and buckled marriage walls are a result of a poorly installed or no gasket being installed. I understand a strip of tape will not serve as a gasket.

Type gasket FOAM

Pg. 41

Installed:

Between Floors _____ Yes X

Between Walls _____ Yes X

Bottom of ridge beam _____ Yes X

Installer's initials UPT

Weatherproofing

The bottom board will be repaired and/or taped. _____ Yes X Pg. 124
Siding on units is installed to manufacturer's specifications. _____ Yes X
Fireplace chimney installed so as not to allow intrusion of rain water. _____ Yes X


Miscellaneous

Skirting to be installed. _____ Yes X No _____ N/A
Dryer vent installed outside of skirting. _____ Yes X No _____ N/A
Range downflow vent installed outside of skirting. _____ Yes X No _____ N/A
Drain lines supported at 4' intervals. _____ Yes X No _____ N/A
Electrical crossovers protected. _____ Yes X No _____ N/A
Other: _____

Installer verifies all information given with this permit worksheet is accurate and true based on the manufacturer's installation instructions and or Rule 15C-1 & 2

Installer's Signature [Signature]

Date 10/24/25

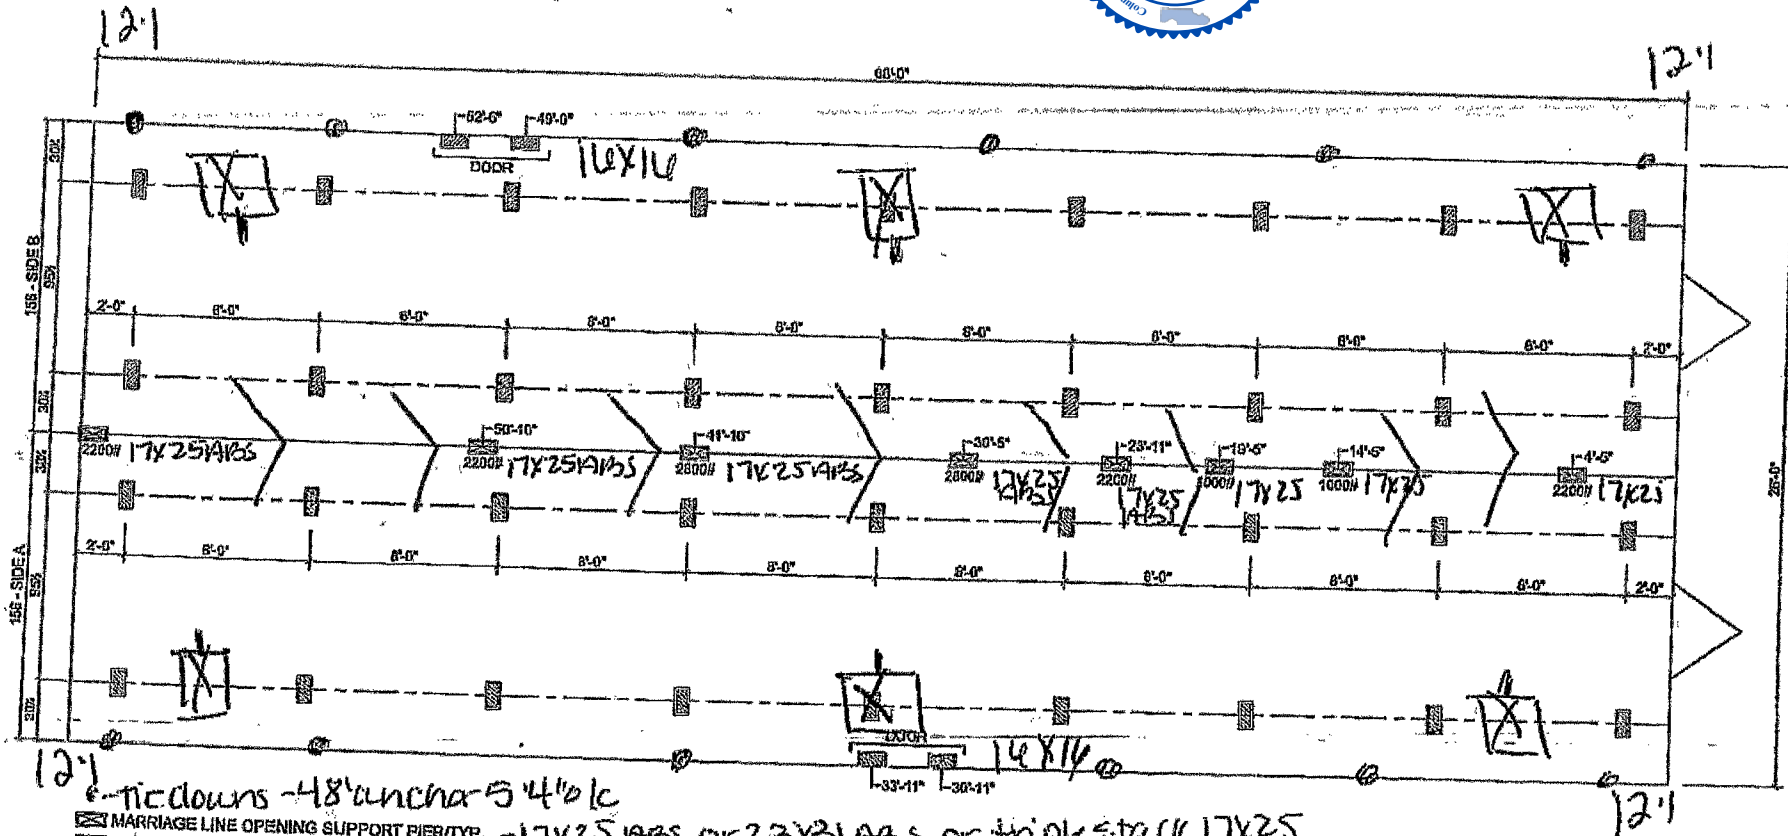

12'-0" tie downs - 48' anchor 5' 4" o/c

MARRIAGE LINE OPENING SUPPORT PIER/TYP. - 17x25 ABS or 23x31 ABS or triple stack 17x25

SUPPORT PIER/TYP - 17x25 ABS w/ 8x8x16 5' o/c

03/21/24

FOUNDATION NOTES:

- THIS DRAWING IS DESIGNED FOR THE STANDARD WIND ZONE AND IS TO BE USED IN CONJUNCTION WITH THE INSTALLATION MANUAL AND ITS SUPPLEMENTS.
- FOOTINGS ARE SHOWN FOR EXAMPLE ONLY QUANTITY AND SPACING MAY VARY BASED ON PAD TYPE, SOIL CONDITION, ETC.
- FOOTINGS ARE REQUIRED AT SUPPORT POSTS, SEE INSTALLATION MANUAL FOR REQUIREMENTS.

XL-Driver System > Double Frame Tie - 48' anchor 5' from end then 12' o/c

Live Oak Homes

MODEL: L-2684H - 28 X 68 (BOX)

4-BEDROOM / 2-BATH



* All perimeter / doors 16x16

* All centerline / shearwalls - 60'

(95-1/2" I-BEAM SPACING)

L-2684H

The COSTNER

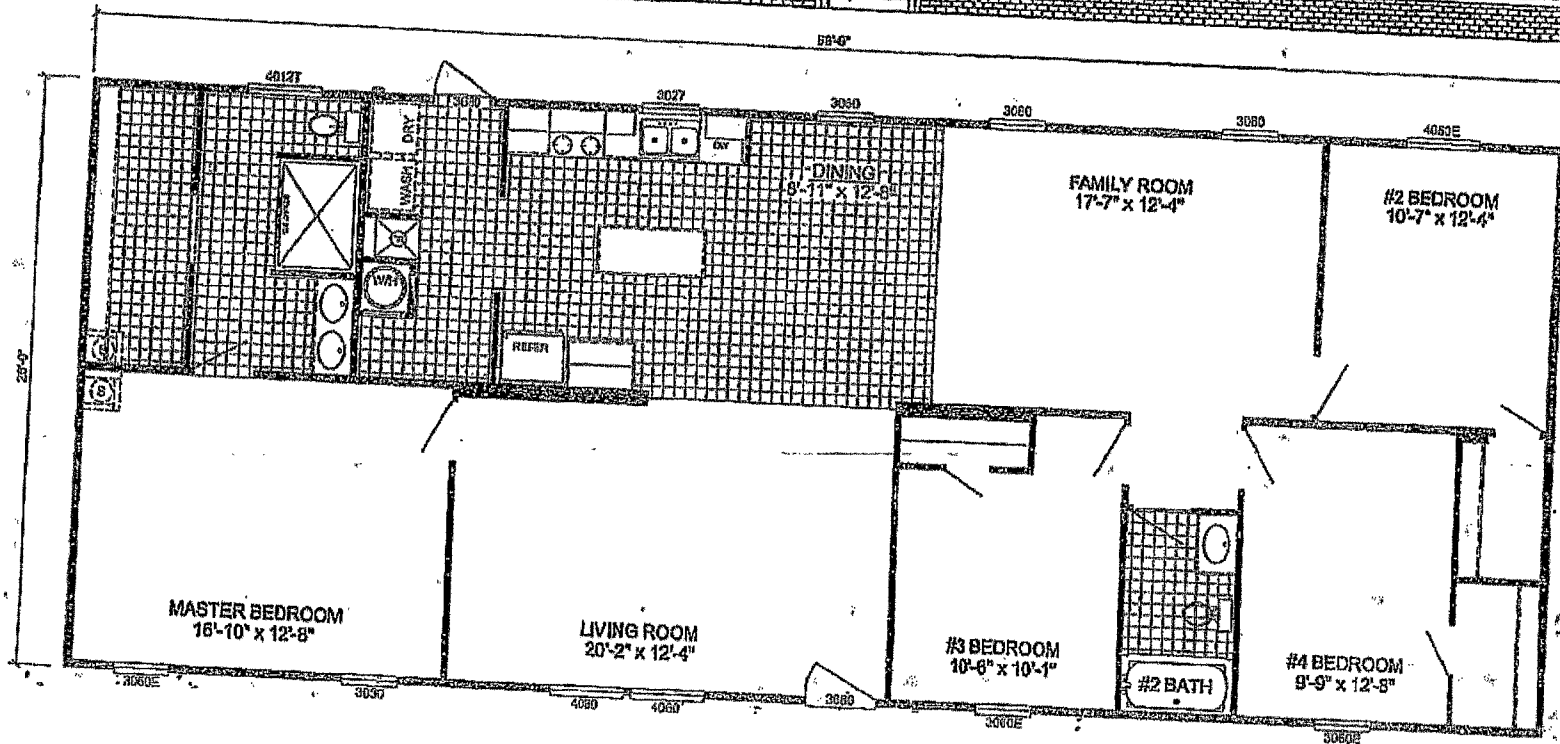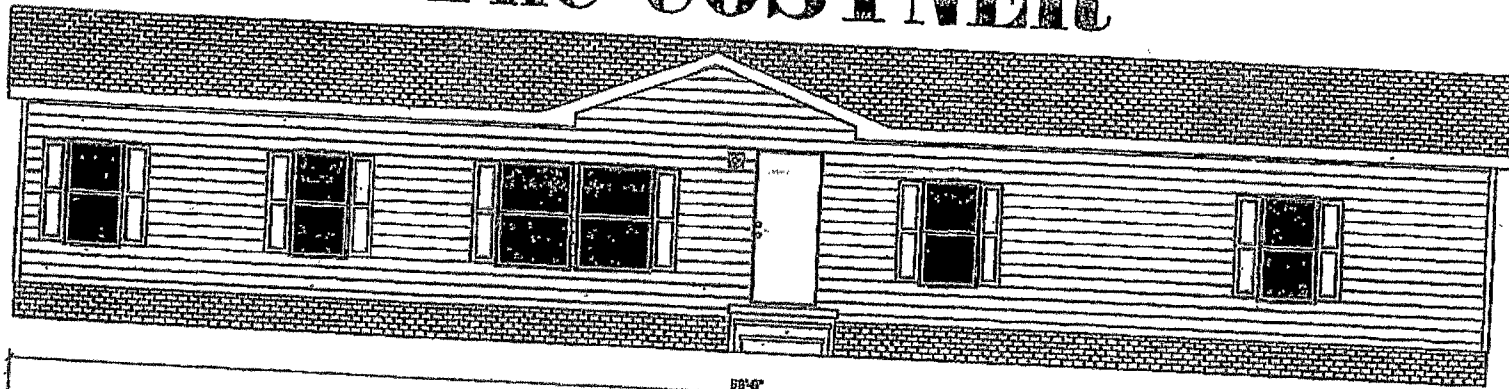

L-2684H - RUNNER SS
4-BEDROOM / 2-BATH
28 x 72 - Approx. 1768 Sq. Ft.

Date: 03/21/24

* All room dimensions include closets and square footage figures are approximate.
 * Live Oak Homes reserves the right to change product offering at any time.



Runner **SS**

Williams

28X72

Columbia
IWHP

License Number: IH / 1041936 / 1 Name: WILLIAM R PRICE

Order #: 5453

Label #: 91527

Homeowner:

Address:

City/State/Zip:

Phone #:

Date Installed:

Installed Wind Zone:

Note:

Manufacturer:

Year Model:

Length & Width:

Type Longitudinal System:

Type Lateral Arm System:

New Home: _____ Used Home: _____

Data Plate Wind Zone:

(Check Size of Home)

Single _____

Double _____

Triple _____

HUD Label #:

Soil Bearing / PSF:

Torque Probe / in-lbs:

Permit #:



STATE OF FLORIDA
INSTALLATION CERTIFICATION LABEL

91527

LABEL #

DATE OF INSTALLATION

WILLIAM R PRICE

NAME

IH / 1041936 / 1

5453

LICENSE #

ORDER #

CERTIFIES THAT THE INSTALLATION OF THIS MOBILE HOME IS
IN ACCORDANCE WITH FLORIDA STATUTES 320.8249, 320.8325
AND RULES OF THE HIGHWAY SAFETY AND MOTOR VEHICLES.

INSTRUCTIONS

PLEASE WRITE DATE OF
INSTALLATION AND AFFIX
LABEL NEXT TO HUD LABEL.
USE PERMANENT INK PEN
OR MARKER ONLY.
COMPLETE INFORMATION
ABOVE AND KEEP ON FILE
FOR A MINIMUM OF 2 YEARS.
YOU ARE REQUIRED TO
PROVIDE COPIES WHEN
REQUESTED.