

37929

These worksheets must be completed and signed by the installer.
Submit the originals with the packet.

Installer **DAVID ALBRIGHT**

License # **JH/ 1129420**

911 Address where home is being installed. **212 NW WHITNEY GLEN**

LAKE CITY, FL 32055

Manufacturer **LIVE OAK HOMES**

Length x width **32 x 52/56**

NOTE: If home is a single wide fill out one half of the blocking plan
if home is a triple or quad wide sketch in remainder of home


I Underland Lateral Arm Systems cannot be used on any home (new or used) where the sidewall ties exceed 5 ft 4 in.

Installer's initials **DA**

Typical pier spacing



Show locations of Longitudinal and Lateral Systems
(use dark lines to show these locations)

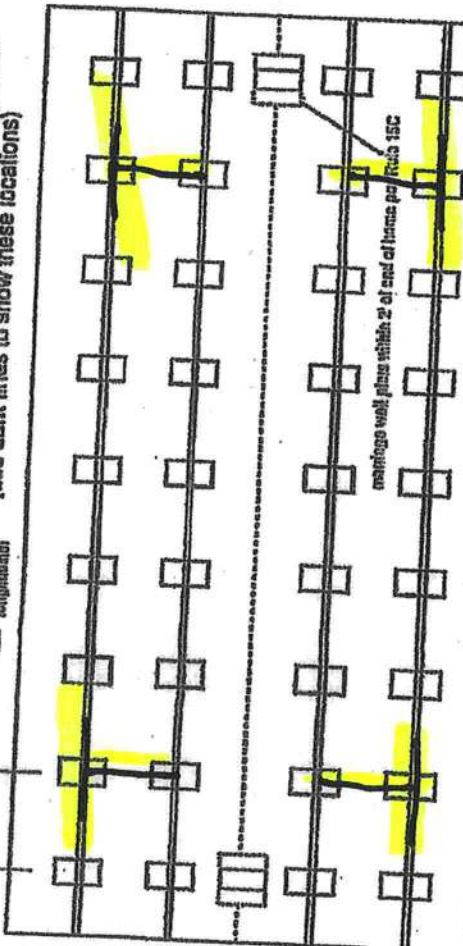

marriage wall plus within 2' of end of home per Rule 15C



10/30/2020

DUKE u-3524D

page 1 of 2

New Home ☒ Used Home ☐

Home installed to the Manufacturer's Installation Manual

Home is installed in accordance with Rule 15-C

Single wide ☐ Wind Zone II ☒ Wind Zone III ☐

Double wide ☒ Installation Detail # **72914**

Triple/Quad ☐ Serial # **LOHGA31770153AB**

PIER SPACING TABLE FOR USED HOMES

Load bearing capacity	Pier size (sq ft)	18" x 18" (256)	18 1/2" x 18 1/2" (342)	20" x 20" (400)	22" x 22" (484)	24" x 24" (576)	26" x 26" (676)
1000 psf	3'	3'	4'	5'	6'	7'	8'
1500 psf	4'	4'	5'	6'	7'	8'	9'
2000 psf	5'	5'	6'	7'	8'	9'	10'
2500 psf	6'	6'	7'	8'	9'	10'	11'
3000 psf	7'	7'	8'	9'	10'	11'	12'
3500 psf	8'	8'	9'	10'	11'	12'	13'

* Interpolated from Rule 15C-1 pier spacing table.

PIER PAD SIZES

I-beam pier pad size **17 x 25**

Perimeter pier pad size **16 x 16**

Other pier pad sizes (required by the mfg.) **23 x 31**

Draw the approximate locations of marriage wall openings 4 foot or greater. Use this symbol to show the piers.

List all marriage wall openings greater than 4 foot and their pier pad sizes below.

Opening **15** Pier pad size **32 x 23**

4 **17 x 25**

3 **17 x 25**

TIEDOWN COMPONENTS

Longitudinal Stabilizing Device (LSD) **OTI**

Longitudinal Stabilizing Device w/ Lateral Arms **OTI**

ANCHORS

4 ft ☒ 5 ft **CTR**

FRAME TIES

within 2' of end of home spaced at 5' 4" oc

OTHER TIES

Number **23**

Shearwall

Longitudinal

Marriage wall

Shearwall

Mobile Home Permit Worksheet

Application Number: _____

Date: _____

POCKET PENETROMETER TEST

The pocket penetrometer tests are rounded down to 1500 psf or check here to declare 1000 lb. soil _____ without testing.

X 1500 X 1500 X 1500

POCKET PENETROMETER TESTING METHOD

1. Test the perimeter of the home at 6 locations.
2. Take the reading at the depth of the footer.
3. Using 500 lb. increments, take the lowest reading and round down to that increment.

X 1500 X 1300 X 1500

TORQUE PROBE TEST

The results of the torque probe test is 285 inch pounds or check here if you are declaring 5' anchors without testing. A test showing 275 inch pounds or less will require 5 foot anchors.

Note: A state approved lateral arm system is being used and 4 ft. anchors are allowed at the sidewall locations. I understand 5 ft anchors are required at all centerline tie points where the torque test reading is 275 or less and where the mobile home manufacturer may require anchors with 4000 lb. holding capacity.

Installer's initials _____

ALL TESTS MUST BE PERFORMED BY A LICENSED INSTALLER

Installer Name DAVID ALBRIGHT MOBILE HOME SVC

Date Tested _____

Electrical

Connect electrical conductors between multi-wide units, but not to the main power source. This includes the bonding wire between multi-wide units. Pg. 73-77

Plumbing

Connect all sewer drains to an existing sewer tap or septic tank. Pg. 79-80

Connect all potable water supply piping to an existing water meter, water tap, or other independent water supply systems. Pg. 78-110



Site Preparation

Debris and organic material removed X
Water drainage: Natural _____ Swale _____ Pad X Other _____

Fastening multi wide units

Floor: _____ Type Fastener: _____ Length: 6" _____ Spacing: 2' _____
Walls: _____ Type Fastener: SCREWS _____ Length: 3" _____ Spacing: 18" _____
Roof: _____ Type Fastener: LAGS _____ Length: 6" _____ Spacing: 2' _____

For used homes a min. 30 gauge, 8" wide, galvanized metal strip will be centered over the peak of the roof and fastened with galv. roofing nails at 2" on center on both sides of the centerline.

Gasket (weatherproofing requirement)

Understand a properly installed gasket is a requirement of all new and used homes and that condensation, mold, mildew and buckled marriage walls are a result of a poorly installed or no gasket being installed. I understand a strip of tape will not serve as a gasket.

Installer's initials DA

Type gasket FACTORY

Pg. 41

Installed:

Between Floors Yes X
Between Walls Yes END WALLS
Bottom of ridgebeam Yes X

Weatherproofing

The bottomboard will be repaired and/or taped. Yes X Pg. 124
Siding on units is installed to manufacturer's specifications. Yes X
Fireplace chimney installed so as not to allow intrusion of rain water. Yes X


Miscellaneous

Skirting to be installed. Yes _____ No X
Dryer vent installed outside of skirting. Yes _____ N/A X
Range downflow vent installed outside of skirting. Yes _____ N/A X
Drain lines supported at 4 foot intervals. Yes X
Electrical crossovers protected. Yes X
Other: _____

Installer verifies all information given with this permit worksheet is accurate and true based on the manufacturer's installation instructions and or Rule 15C-1 & 2

Installer Signature David Albright Date _____

52'-0"

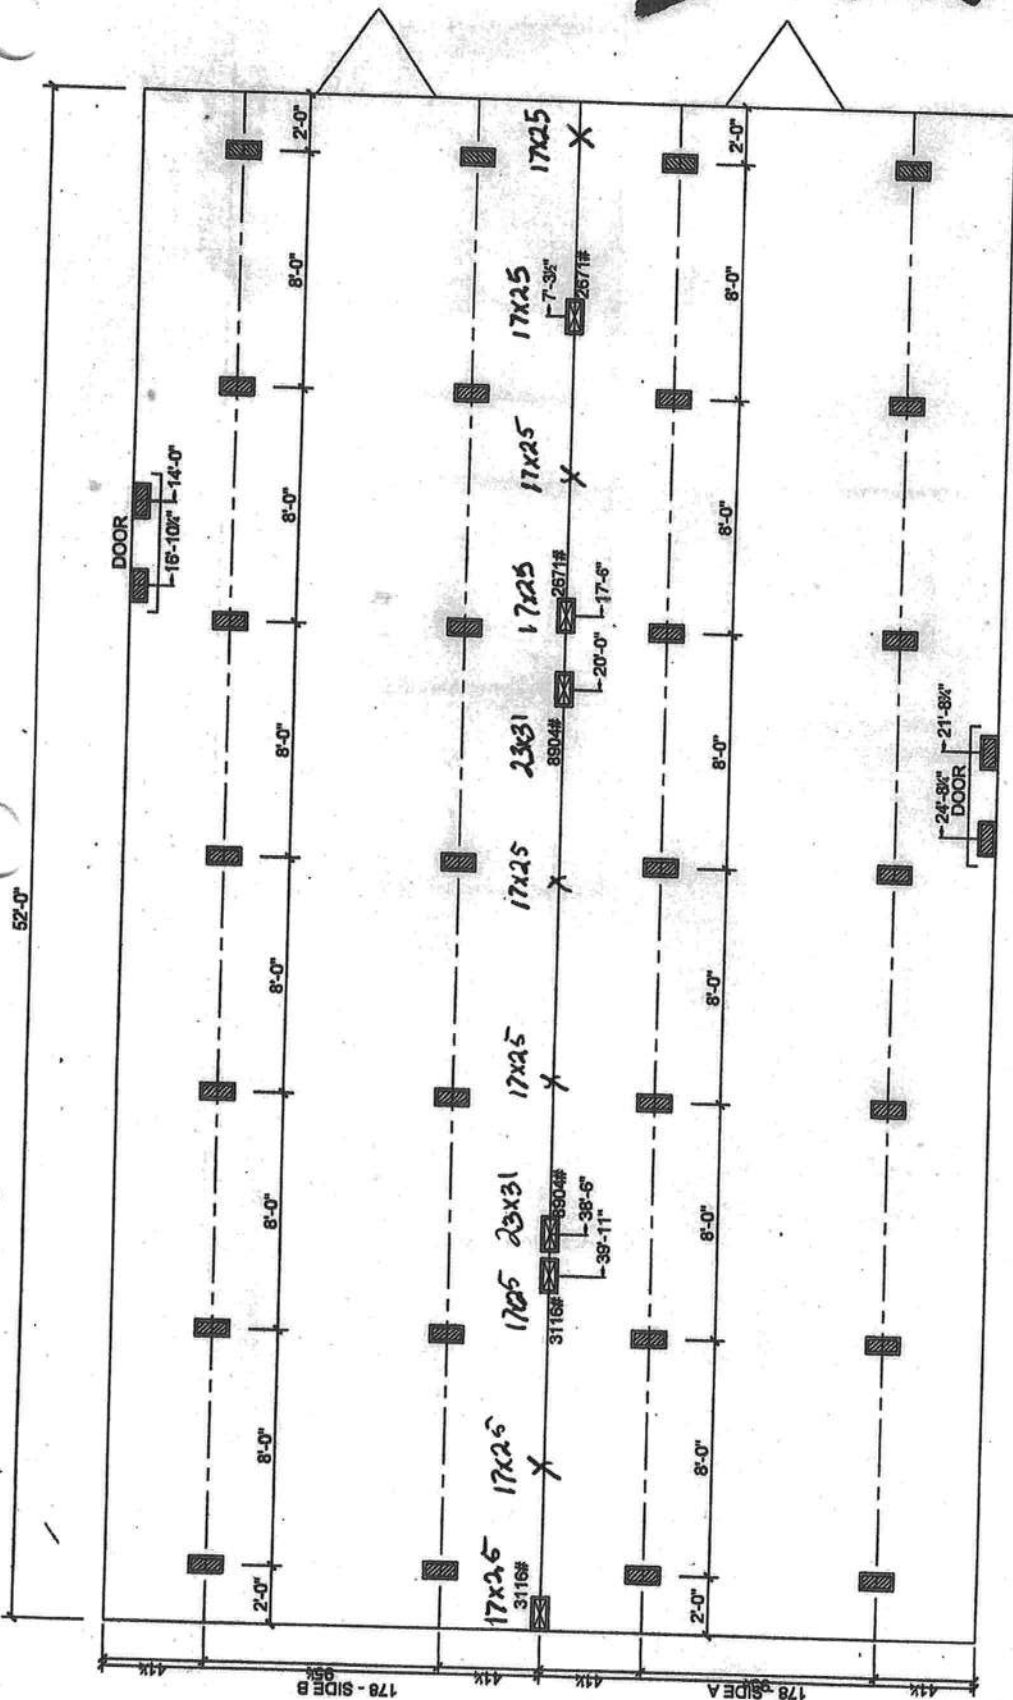

☒ MARRIAGE LINE OPENING SUPPORT PIERTYP.

 **SUPPORT PIER/TYP**

FOUNDATION NOTES:

THIS DRAWING IS DESIGNED FOR THE STANDARD WIND ZONE AND IS TO BE USED IN CONJUNCTION WITH THE INSTALLATION MANUAL AND FOOTINGS ARE SHOWN FOR EXAMPLE ONLY QUANTITY AND SPACING MAY VARY BASED ON PAD TYPE, SOIL CONDITION, ETC. FOOTINGS ARE REQUIRED AT SUPPORT POSTS, SEE INSTALLATION MANUAL FOR REQUIREMENTS.

Live Oak Homes
MODEL: U3524D - 32 X 52
4-BEDROOM / 2-BATH




8-22-2011

- State of FL
- 11-35
- (A) MAIN ELECTRICAL
(B) ELECTRICAL CROSSOVER
(C) WATER INLET
(D) WATER CROSSOVER (IF ANY)
(E) GAS INLET (IF ANY)
(F) GAS CROSSOVER (IF ANY)
(G) DUCT CROSSOVER
(H) SEWER DROPS
(I) RETURN AIR (W/OPT. HEAT PUMP OH DUCT)
(J) SUPPLY AIR (W/OPT. HEAT PUMP OH DUCT)



U-3524D

DUKE

DUKE

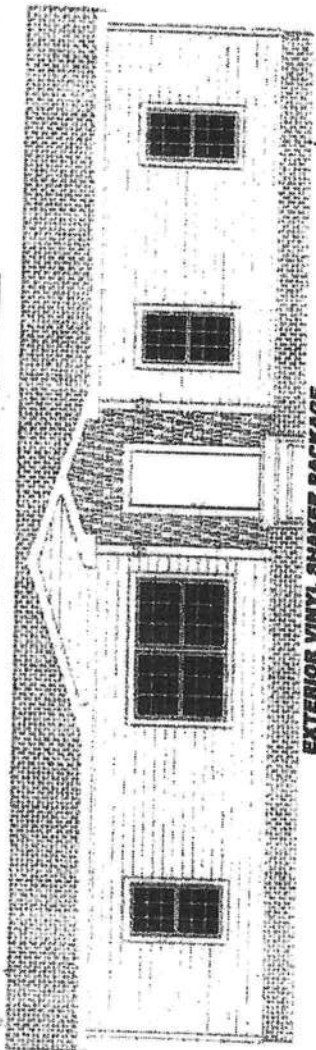

EXTERIOR VINYL SHAKER PACKAGE (STD)

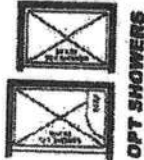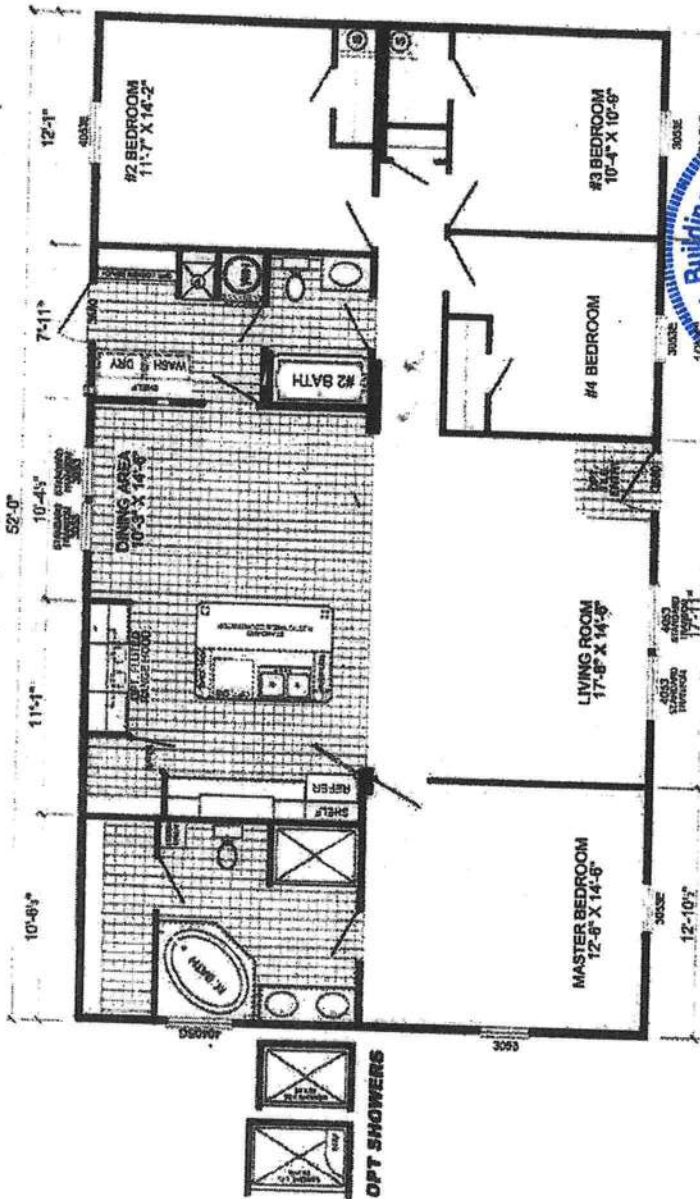

OPT SHOWERS



OPTIONAL 3 BEDROOM LAYOUT



U-3524D-OAK
4-BEDROOM / 2-BATH
32 X 56 - Approx. 1525 Sq. Ft.

Date: 05/23/18
 * All room dimensions include closets and are approximate.
 * Window locations are indicated on optional 5'-0" standard footer only.
 * Underlayment shown is optional.
 * Live Oak Homes reserves the right to modify product offerings at any time.

OAKS
Signature Series