

page 1 of 2

	Number
Sidewall	28
Longitudinal	0
Marriage wall	10
Shearwall	2

PERMIT NUMBER

PERMIT WORKSHEET

page 2 of 2

POCKET PENETROMETER TEST

The pocket penetrometer tests are rounded down to _____ psf or check here to declare 1000 lb. soil without testing

X _____ X _____ X _____

POCKET PENETROMETER TESTING METHOD

1. Test the perimeter of the home at 6 locations.
2. Take the reading at the depth of the footer.
3. Using 500 lb. increments, take the lowest reading and round down to that increment.

X _____ X _____ X _____

TORQUE PROBE TEST

The results of the torque probe test is _____ inch pounds or check here if you are declaring 5' anchors without testing _____. A test showing 275 inch pounds or less will require 5 foot anchors.

Note: A state approved lateral arm system is being used and 4 ft anchors are allowed at the sidewall locations. I understand 5 ft anchors are required at all centerline tie points where the torque test reading is 275 or less and where the mobile home manufacturer may require anchors with 4000 lb holding capacity.

EGJ Installer's initials

ALL TESTS MUST BE PERFORMED BY A LICENSED INSTALLER

Installer Name Ernest S. Johnson

Date Tested Assumed Oliver 1101V Uses

455 foot Anchors

Electrical

Connect electrical conductors between multi-wide units, but not to the main power source. This includes the bonding wire between multi-wide units. Pg. _____

Plumbing

Connect all sewer drains to an existing sewer tap or septic tank. Pg. _____

Connect all potable water supply piping to an existing water meter, water tap, or other independent water supply systems. Pg. _____

Site Preparation

Debris and organic material removed _____
Water drainage: Natural _____ Swale _____ Pad _____ Other _____

Fastening multi wide units

Floor: Type Fastener: 145 Length: 2 Spacing: 20
Walls: Type Fastener: 145 Length: 4 Spacing: 10
Roof: Type Fastener: 145 Length: 2 Spacing: 20
For used homes a min. 30 gauge, 8" wide, galvanized metal strip will be centered over the peak of the roof and fastened with galv. roofing nails at 2' on center on both sides of the centerline.

Gasket (weatherproofing requirement)

I understand a properly installed gasket is a requirement of all new and used homes and that condensation, mold, mildew and buckled marriage walls are a result of a poorly installed or no gasket being installed. I understand a strip of tape will not serve as a gasket.

Installer's initials EGJ

Type gasket

Pg. RH

Installed:

Between Floors Yes

Between Walls Yes

Bottom of ridgebeam Yes

Weatherproofing

The bottomboard will be repaired and/or taped. Yes Pg. _____
Siding on units is installed to manufacturer's specifications. Yes _____
Fireplace chimney installed so as not to allow intrusion of rain water. Yes _____

Miscellaneous

Skirting to be installed. Yes _____ No _____
Dryer vent installed outside of skirting. Yes _____ N/A _____
Range downflow vent installed outside of skirting. Yes _____ N/A _____
Drain lines supported at 4 foot intervals. Yes _____
Electrical crossovers protected. Yes _____
Other: _____


Installer verifies all information given with this permit worksheet is accurate and true based on the manufacturer's installation instructions and or Rule 15C-1 & 2

Installer Signature Ernest S. Johnson

Date 5/27/22



STONE

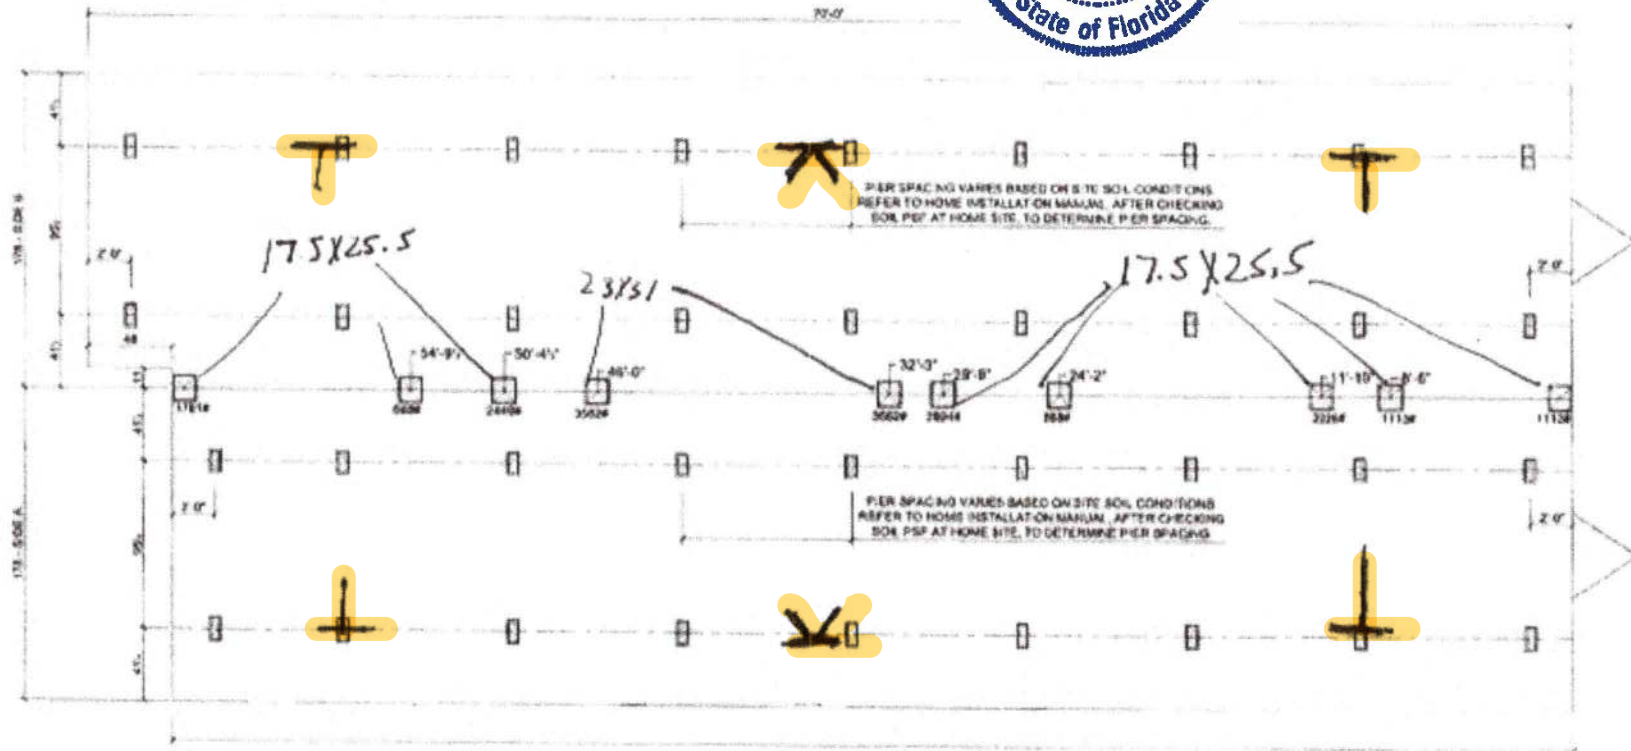

□ MARRIAGE LINE OPENING SUPPORT PIERTYP

■ SUPPORT PIERTYP

FOUNDATION NOTES:

THIS DRAWING IS DESIGNED FOR THE STANDARD WIND ZONE AND IS TO BE USED IN CONJUNCTION WITH THE INSTALLATION MANUAL AND ITS SUPPLEMENTS.
FOOTINGS ARE SHOWN FOR EXAMPLE ONLY. QUANTITY AND SPACING MAY VARY BASED ON PAD TYPE, SOIL CONDITION, ETC.
FOOTINGS ARE REQUIRED AT SUPPORT POSTS. SEE INSTALLATION MANUAL FOR REQUIREMENTS.

ScotBilt
HOMES, INC.

3266398FDM

FREEDOM
32 X 70 - 3BR 2 BATH

DATE 2-4-2020
REVISION A

AREA 1,999 SQ. FT.


1,999 SQ. FT.
0 SQ. FT.

*Stone
Proposed*




NOTE: ELEVATION SHOWN WITH OPTIONAL ADIRONDACK DORMERS

70'-0"

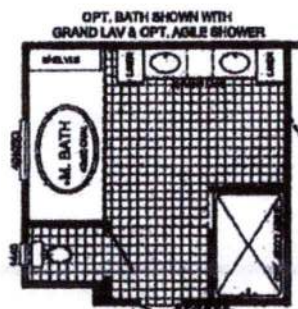

OPT. BATH SHOWN WITH
GRAND LAV & OPT. ADIR. SHOWER

29'-8"

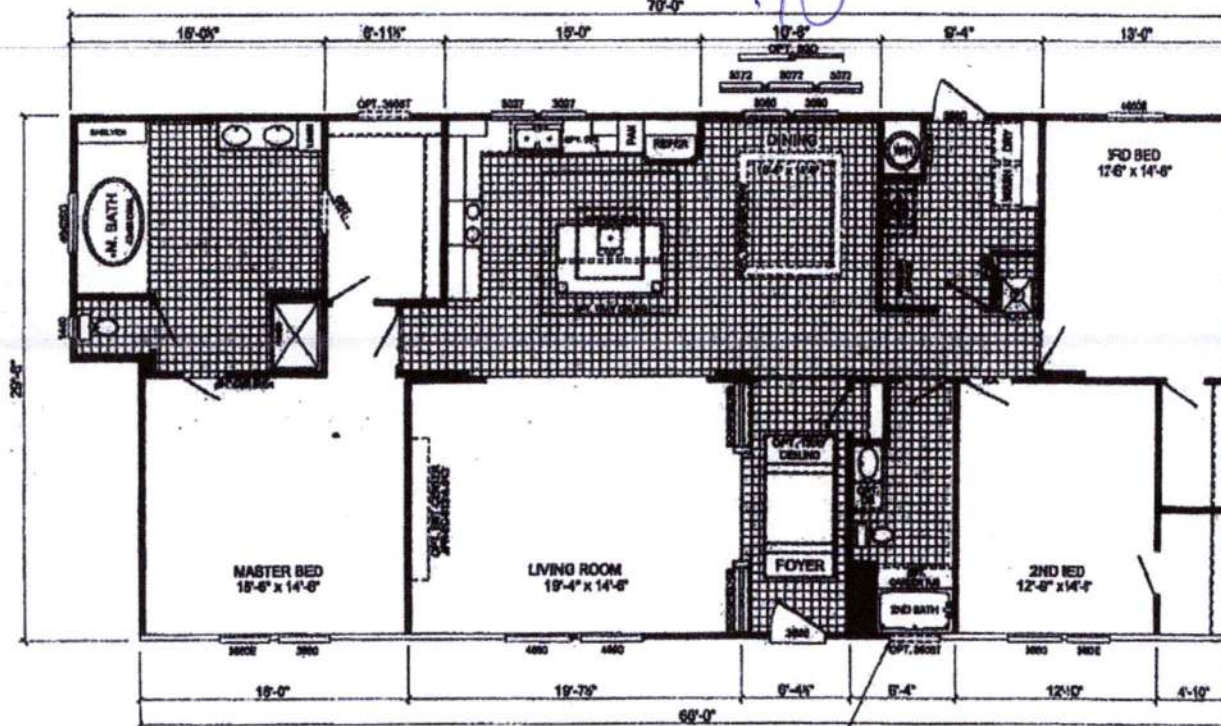

NOTE: OPTIONAL TRANSOM NOT AVAILABLE WITH ADIRONDACK EXTERIOR OPTION

STONE

X [Signature]
X [Signature]

6'6"
[Signature]



[Signature]
5/25/22

ScotBilt
HOMES, INC.

MODEL # **3266398FDM**

PLAN SPECIES **FREEDOM**
32 X 70 - 3BR 2 BATH

DATE **12-2-2019**
VERSION **A**

AREA **1,999 SQ. FT.**

COVERED **1,999 SQ. FT.**
PATIO AREA **0 SQ. FT.**