


Mobile Home Permit Worksheet

Installer John Nettles License # JH1143556
 Address of home being installed 180 SW Helene Ave
Lake City, FL, 32024
 Manufacturer Town Homes Length x width 60 x 15


NOTE: If home is a single wide fill out one half of the blocking plan
 If home is a triple or quad wide sketch in remainder of home
 I understand Lateral Arm Systems cannot be used on any home (new or used)
 where the sidewall has exceed 6 ft 4 in

Installer's initials JN

Typical pier spacing

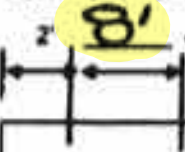

Show locations of Longitudinal and Lateral Systems
 (use dark lines to show these locations)

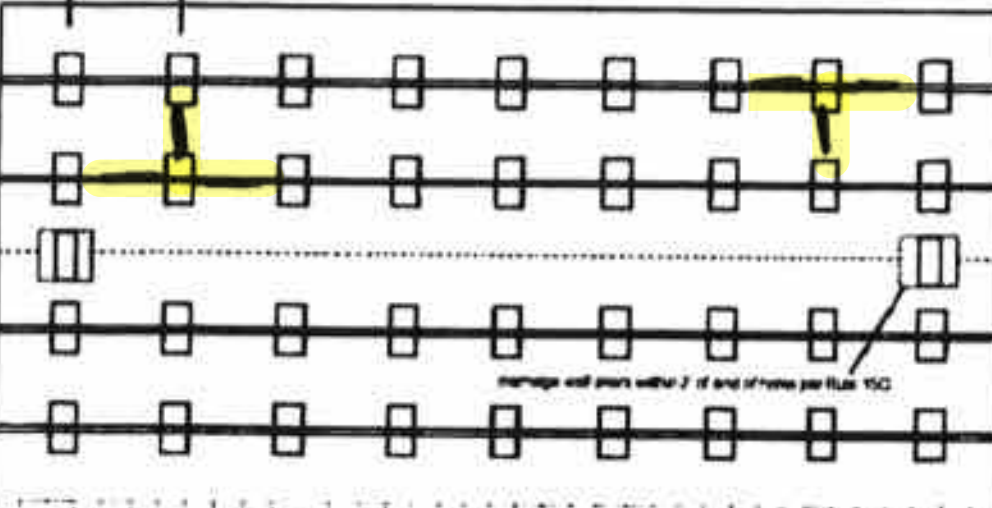

marriage wall piers within 2' of end of home per Rule 15C

Application Number: _____ Date: _____

New Home ☒ Used Home ☐

Home installed to the Manufacturer's Installation Manual
 Home is installed in accordance with Rule 5-C ☒

Single wide ☒ Wind Zone II ☒ Wind Zone III ☐

Double wide ☐ Installation Detail 6733

Triple/Quad ☐ Serial # FLHLCIE6266

PIER SPACING TABLE FOR USED HOMES

Load bearing capacity	Footer size (sq in)	16' x 16' (256)	18 1/2' x 18 1/2' (342)	2' x 20' (800)	22' x 22' (484)	24' x 24' (576)	26' x 26' (676)
1000 psf		3'	4'	5'	6'	7'	8'
1800 psf		4' 6"	6'	7'	8'	9'	10'
2000 psf		5'	6'	8'	9'	10'	11'
2500 psf		7' 6"	8'	9'	10'	11'	12'
3000 psf		8'	9'	10'	11'	12'	13'
3600 psf		8'	9'	10'	11'	12'	13'

* Interpolated from Rule 15C-1 pier spacing table.

PIER PAD SIZES

I-beam pier pad size 23.75 x 31.25

Perforator pier pad size 16 x 16

Other pier pad sizes
 (required by the mfg.) _____

Draw the approximate locations of marriage wall openings 4 foot or greater. Use this symbol to show the piers.

List all marriage wall openings greater than 4 foot and their pier pad sizes below.

Opening _____ Pier pad size _____

TIEDOWN COMPONENTS

Longitudinal Stabilizing Device (LSD)
 Manufacturer Oliver Hovig
 Longitudinal Stabilizing Device w/ Lateral Arms
 Manufacturer Oliver Hovig

POPULAR PAD SIZES

Pad Size	Sq in
16 x 16	256
18 x 18	324
18.5 x 18.5	342
18 x 22.5	405
17 x 22	374
13 1/4 x 28 1/4	343
20 x 20	400
17 3/16 x 28 3/16	441
17 1/2 x 26 1/2	448
24 x 24	576
26 x 26	676

ANCHORS

4 ft ☒ 5 ft ☒

FRAME TIES

within 2' of end of home
 spaced at 5' 4" oc

OTHER TIES

Number _____
 Sidewall _____
 Longitudinal _____
 Marriage wall _____
 Shearwall _____

Mobile Home Permit Worksheet

POCKET PENETROMETER TEST

The pocket penetrometer tests are rounded down to psf or check here to declare 1000 lb soil ☒ without testing

X X X

POCKET PENETROMETER TESTING METHOD

- 1 Test the perimeter of the home at 6 locations
- 2 Take the reading at the depth of the footer
- 3 Using 500 lb increments, take the lowest reading and round down to that increment

X X X

TORQUE PROBE TEST

The results of the torque probe test is 350 inch pounds or check here if you are declaring 5' anchors without testing A test showing 275 inch pounds or less will require 5 foot anchors

Note: A state approved lateral arm system is being used and 4 ft anchors are allowed at the sidewall locations. I understand 5 ft anchors are required at all centerline tie points where the torque test reading is 275 or less and where the mobile home manufacturer may require anchors with 4000 lb holding capacity

JW Installer's initials

ALL TESTS MUST BE PERFORMED BY A LICENSED INSTALLER

Installer Name John Nettles

Date Tested

Electrical

Connect electrical conductors between multi-wide units, but not to the main power source. This includes the bonding wire between multi-wide units. Pg NA

Plumbing

Connect all sewer drains to an existing sewer tap or septic tank. Pg 105-108

Connect all potable water supply piping to an existing water meter, water tap, or other independent water supply systems. Pg 105-108

Application Number: Date:

Site Preparation

Debris and organic material removed ☒
Water drainage Natural ☒ Swale ☒ Pad ☒ Other ☒

Fastening multi-wide units

Floor	Type Fastener	Length	Spacing
Walls	Type Fastener	Length	Spacing
Roof	Type Fastener	Length	Spacing

For used homes a min 30 gauge, 6' wide, galvanized metal strip will be centered over the peak of the roof and fastened with galv roofing nails at 2' on center on both sides of the centerline

Gasket (meeting/sealing requirements)

I understand a properly installed gasket is a requirement of all new and used homes and that condensation, mold, mildew and buckled marriage walls are a result of a poorly installed or no gasket being installed. I understand a strip of tape will not serve as a gasket.

Installer's initials JW

Type gasket	Installed
Pg <u>NA</u>	Between Floors Yes <u>NA</u>
	Between Walls Yes <u>NA</u>
	Bottom of ridgebeam Yes <u>NA</u>

Weatherproofing

The bottomboard will be repaired and/or taped. Yes NA Pg NA
Siding on units is installed to manufacturer's specifications. Yes NA
Fireplace chimney installed so as not to allow intrusion of rain water. Yes NA

Miscellaneous

Skirting to be installed. Yes ☒ No ☒
Dryer vent installed outside of skirting. Yes ☒ N/A ☒
Range downflow vent installed outside of skirting. Yes ☒ N/A ☒
Drain lines supported at 4 foot intervals. Yes ☒
Electrical crossovers protected. Yes NA
Other

Installer verifies all information given with this permit worksheet is accurate and true based on the manufacturer's installation instructions and or Rule 15C-1 & 2

Installer Signature John Nettles

Date 8/26/25

License Number: IH / 1143556 / 1 Name: JOHN M NETTLES

Order #: 6733

Label #: 123333

Manufacturer: **Town Homes**

(Check Size of Home)

Homeowner:

Kent

Year Model

Single **X**

Address:

SW Itchetucknee Ave

Length & Width

15 x 60

Double _____

City/State/Zip

Type Longitudinal System

Triple _____

Phone #:

Type Lateral Arm System

HUD Label #

Date Installed

New Home **X** Used Home _____

Soil Bearing / PSF

Installed Wind Zone: **2**

Data Plate Wind Zone

Torque Probe / in-lbs

Note

STATE OF FLORIDA
INSTALLATION CERTIFICATION LABEL

123333

LABEL #

DATE OF INSTALLATION

JOHN M NETTLES

NAME

IH / 1143556 / 1

6733

LICENSE #

ORDER #

CERTIFIES THAT THE INSTALLATION OF THIS MOBILE HOME IS
IN ACCORDANCE WITH FLORIDA STATUTES 320.8249, 320.8325
AND RULES OF THE HIGHWAY SAFETY AND MOTOR VEHICLES

INSTRUCTIONS

PLEASE WRITE DATE OF
INSTALLATION AND AFFIX
LABEL NEXT TO HUD LABEL.
USE PERMANENT INK PEN
OR MARKER ONLY.
COMPLETE INFORMATION
ABOVE AND KEEP ON FILE
FOR A MINIMUM OF 2 YEARS.
YOU ARE REQUIRED TO
PROVIDE COPIES WHEN
REQUESTED.