

License Number: IH / 1129420 / 1 Name: DAVID E ALBRIGHT

Order #: 6744	Label #: 123592	Manufacturer: LIVE OAK HOMES	(Check Size of Home)
Homeowner: ALBRIGHT, REBELLA	Year Model: 2025		Single _____
Address: 337 BELFRY CT.	Length & Width: 52/56 x 32		Double <input checked="" type="checkbox"/> _____
City/State/Zip: WHITE SPRINGS 32096	Type Longitudinal System: OT1		Triple _____
Phone #:	Type Lateral Arm System: OT1		HUD Label #:
Date Installed:	New Home: <input checked="" type="checkbox"/> Used Home: _____		Soil Bearing / PSF:
Installed Wind Zone: II	Data Plate Wind Zone:		Torque Probe / in-lbs:
Note:			Permit #:

**STATE OF FLORIDA
INSTALLATION CERTIFICATION LABEL**

123592

LABEL #	DATE OF INSTALLATION
DAVID E ALBRIGHT	
NAME	
IH / 1129420 / 1	6744
LICENSE #	ORDER #

CERTIFIES THAT THE INSTALLATION OF THIS MOBILE HOME IS IN ACCORDANCE WITH FLORIDA STATUTES 320.8249, 320.8325 AND RULES OF THE HIGHWAY SAFETY AND MOTOR VEHICLES.

INSTRUCTIONS

PLEASE WRITE DATE OF INSTALLATION AND AFFIX LABEL NEXT TO HUD LABEL. USE PERMANENT INK PEN OR MARKER ONLY. COMPLETE INFORMATION ABOVE AND KEEP ON FILE FOR A MINIMUM OF 2 YEARS. YOU ARE REQUIRED TO PROVIDE COPIES WHEN REQUESTED.

Stars & Stripes Mobile Home Sales, Inc.

DATE OF BIRTH
 BUYER: 11/16/89
 CO-BUYER: _____
 EMAIL RALBRIGHT1315@GMAIL.COM

466 SW DEPUTY J DAVIS LN,
 LAKE CITY, FLORIDA 32024
 (386) 752-5355 Fax: (386) 752-4757

DRIVER'S LICENSE
 BUYER: A416-734-89-916-0
 CO-BUYER: 0

BUYER(S) REBECCA NICOLE ALBRIGHT		PHONE (386) 292-5021	DATE 01/00/00
ADDRESS 449 SE DOE GLN LAKE CITY FL 32025		Salesperson: JACOB LITTLE	
DELIVERY ADDRESS 337 BELFRY CT. WHITE SPRINGS FL 32096			
MAKE & MODEL LIVE OAK V-3524G-E	YEAR 2025	BEDROOMS 4X2	WIDTH w 32
SERIAL NUMBER LOHGA20040620AB	LENGTH w/o HITCH L 52	STOCK NUMBER 2017	
New or Used TELFORD		KEY NUMBERS	
LOCATION	R-VALUE	THICKNESS	TYPE OF INSULATION
CEILING	27	9 1/5	ROCKWOOL
EXTERIOR	11	3 1/2	FIBERGLASS
FLOORS	22	7	FIBERGLASS
THIS INSULATION INFORMATION WAS FURNISHED BY THE MANUFACTURER AND IS DISCLOSED IN COMPLIANCE WITH THE FEDERAL TRADE COMMISSION RULE 16 CRF, SECTION 460.16.			
OPTIONAL EQUIPMENT, LABOR, AND ACCESSORIES			
Delivered and Set Up:	Included		
Trim	Included		
Tied Down:	Included		
Dirt Pad	Included		
land clearing	NO		
Connect water and sewer within 20 feet of existing facility	Included		
Furnished	\$	NO	
Unfurnished	AGREE		
Customer responsible for any wrecker fees incurred on lot.	AGREE		
Wheels & axles deleted from sale price of home.	AGREE		
Electrical Hookup	Included		
Type of A/C HTPKG Included			
Type of Skirting LAP Included			
Type of steps WOODCODE Included			
NOTE: WARRANTY, EXCLUSIONS AND LIMITATIONS OF DAMAGES ON THE REVERSE			
DESCRIPTION OF TRADE-IN	YEAR	BEDROOMS	SIZE
MAKE	N/A	N/A	N/A
TITLE NO.	SERIAL	COLOR	
N/A	N/A		
LIEN HOLDER	PHONE NO	AMOUNT	
N/A	N/A	N/A	
TRADE PAYOFF IS TO BE PAID BY 0			
THIS AGREEMENT CONTAINS THE ENTIRE UNDERSTANDING BETWEEN DEALER AND BUYER AND NO OTHER REPRESENTATION OR INDUCEMENT, VERBAL OR WRITTEN HAS BEEN MADE WHICH IS NOT CONTAINED IN THIS CONTRACT. Dealer and Buyer certify that the additional terms and conditions printed on Page 2 of this contract are agreed to as part of the contract and accessories, the insurance as described has been voluntary, the Buyer's trade-in is free of all claims whatsoever except as noted.			
1, CASH PURCHASE PRICE \$127,752.77 TRADE-IN ALLOWANCE \$0.00 LESS BAL. DUE ON ABOVE \$0.00 NET ALLOWANCE \$0.00 CASH RCVD 10/1 \$4,000.00 0 \$0.00 LESS TOTAL CREDITS \$4,000.00 BALANCE DUE TO S & S \$123,752.77 LAND PAYOFF \$0.00 CLOSING COST FINANCED BY LENDER \$0.00 INSURANCE \$0.00 ESTIMATED FINAL LOAN AMOUNT \$123,752.77			
Initial: _____ NO VERBAL AGREEMENTS WILL BE HONORED. SELLER AGREES TO PAY UP TO \$0.00 OF BUYERS CLOSING COST AND PREPAIDS The U.S. Department of Housing and Urban Development (HUD) Manufactured Home Dispute Resolution Program is available to resolve disputes among manufacturers, retailers, or installers concerning defects in manufactured homes. Many states also have a consumer assistance or dispute resolution program. For additional information about these programs see sections titled "Dispute Resolution Process" and "additional Information -- HUD Manufactured Home Dispute Resolution Program" in the consumer manual required to be provided to the purchaser. These programs are not warranty programs and do not replace the manufacturer's or any other person's warranty program. _____			
Liquidated Damages are agreed to \$900.00 or 10% of the cash price, whichever is greater. REFER TO PARAGRAPH #6 ON THE REVERSE SIDE OF THIS CONTRACT			


Stars & Stripes Mobile Home Sales, Inc. _____ DEALER
 Not Valid Unless Signed by Steve Smith (Vice Pres)

SIGNED _____ BUYER
 SOCIAL SECURITY NO. _____

BY _____ Agent

SIGNED X _____ BUYER
 SOCIAL SECURITY NO. _____


NW BELFRY CT

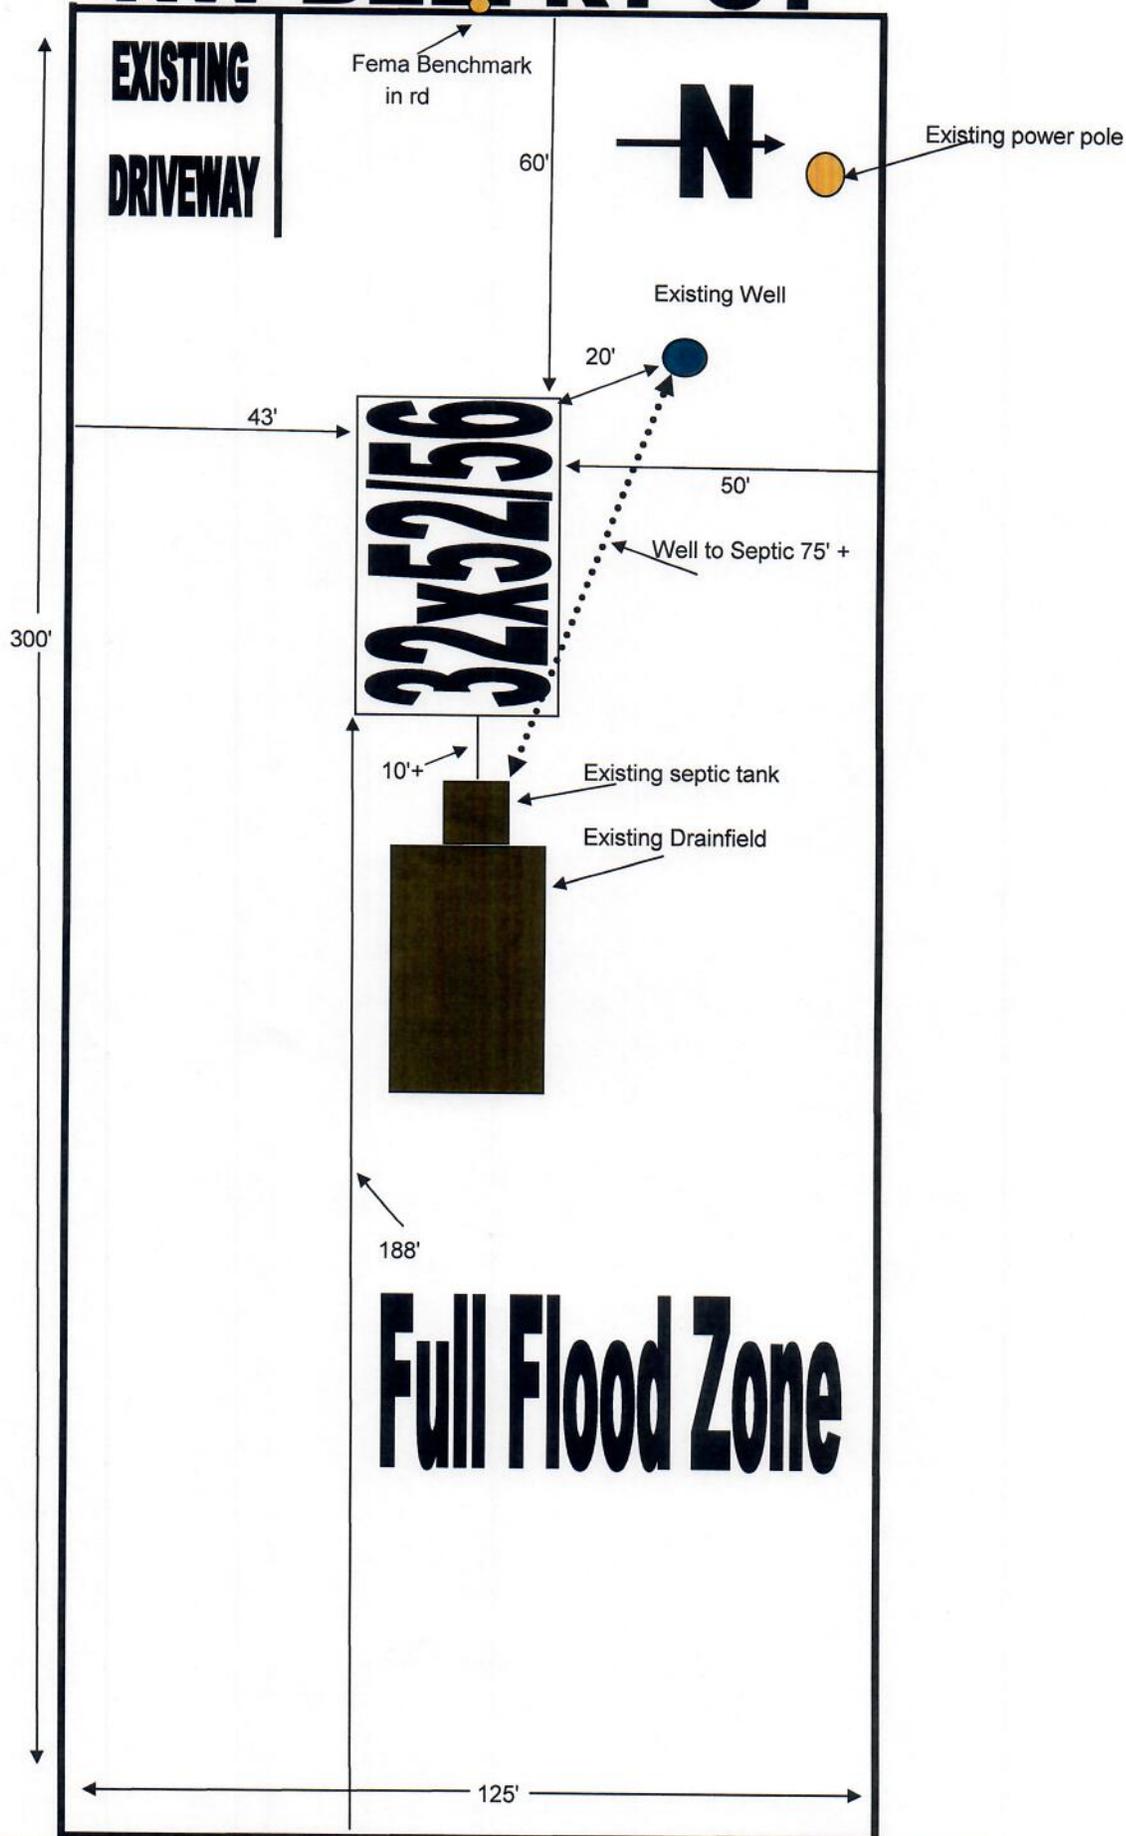

THE TELFORD



SHOWN WITH OPTIONAL DORMER

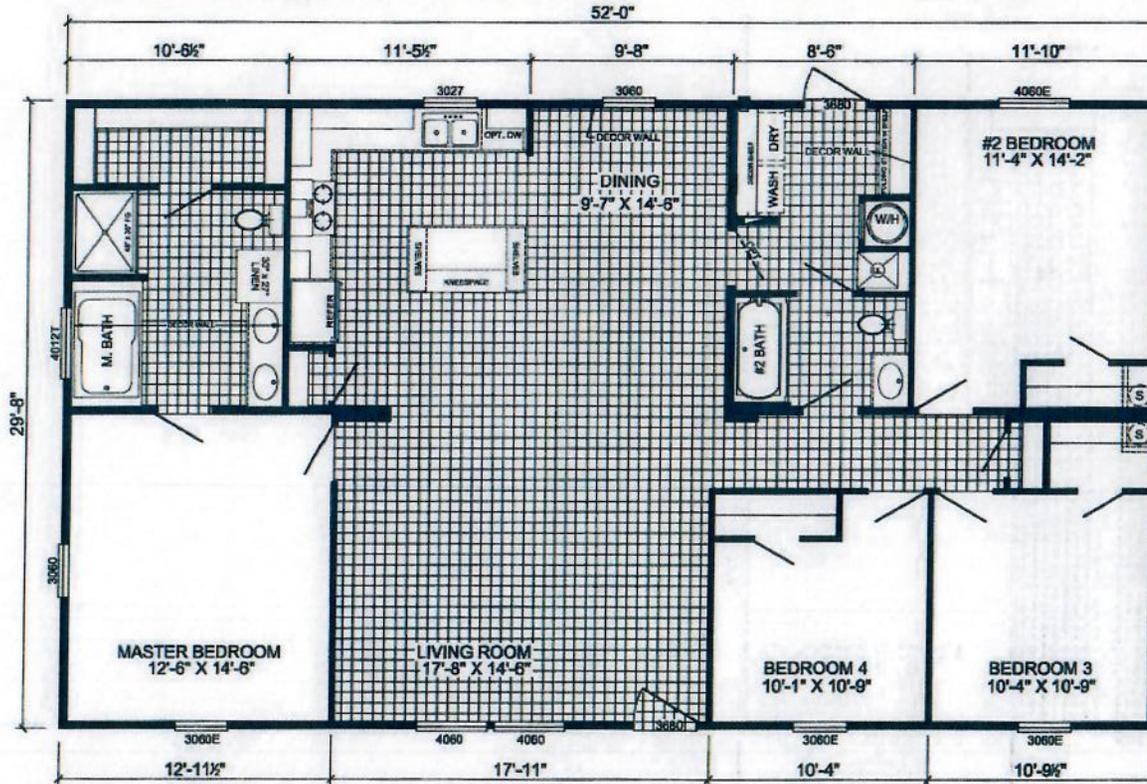

V-3524G - SUWANNEE VALLEY - ELITE
4-BEDROOM / 2-BATH
32 X 52 - Approx. 1525 Sq. Ft.

Date: 10/04/22

* All room dimensions include closets and square footage figures are approximate.
 * Transom windows are available on optional 9'-0" sidewall houses only.

Mobile Home Permit Worksheet DW




Application Number: _____ Date: _____

Installer: DAVID AIBRIGHT License # 1H-1129420
 Address of home being installed: 337 Belfry CT White Springs FL 32096
20-2s-16-01657-049
 Manufacturer: Live Oak Length x width: 32x52/56

New Home Used Home
 Home installed to the Manufacturer's Installation Manual
 Home is installed in accordance with Rule 15-C
 Single wide Wind Zone II Wind Zone III
 Double wide Installation Decal # 123592
 Triple/Quad Serial # LOHGA20040620AB

NOTE: if home is a single wide fill out one half of the blocking plan
 if home is a triple or quad wide sketch in remainder of home
 I understand Lateral Arm Systems cannot be used on any home (new or used)
 where the sidewall ties exceed 5 ft 4 in.

Installer's initials DA

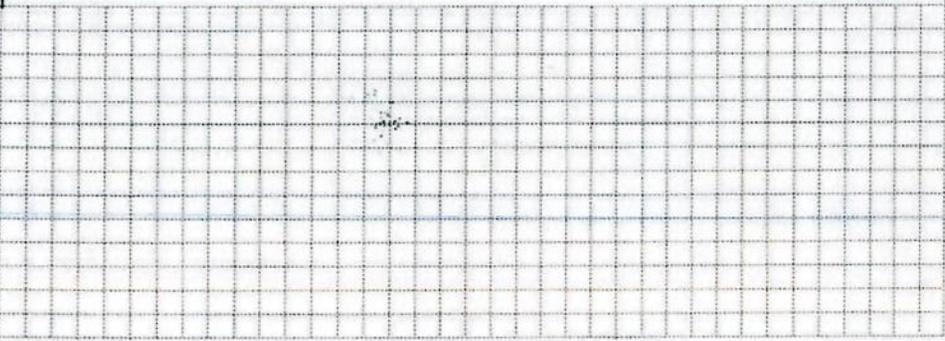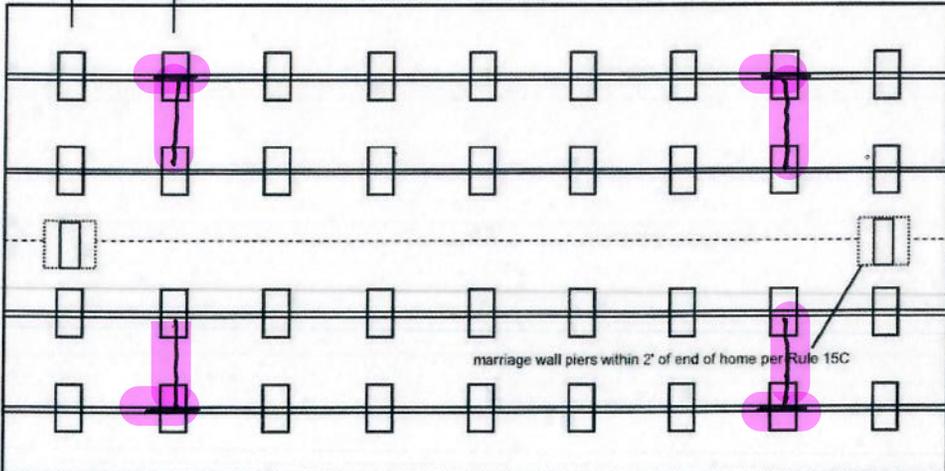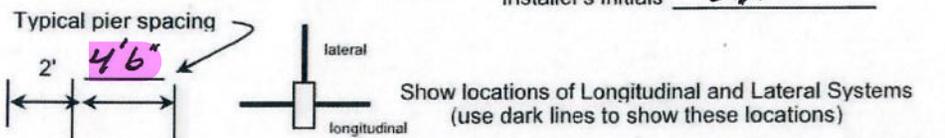

PIER SPACING TABLE FOR USED HOMES

Load bearing capacity	Footer size (sq in)	16" x 16" (256)	18 1/2" x 18 1/2" (342)	20" x 20" (400)	22" x 22" (484)*	24" X 24" (576)*	26" x 26" (676)
1000 psf		3'	4'	5'	6'	7'	8'
1500 psf		4' 6"	6'	7'	8'	8'	8'
2000 psf		6'	8'	8'	8'	8'	8'
2500 psf		7' 6"	8'	8'	8'	8'	8'
3000 psf		8'	8'	8'	8'	8'	8'
3500 psf		8'	8'	8'	8'	8'	8'

* interpolated from Rule 15C-1 pier spacing table.

PIER PAD SIZES

I-beam pier pad size: 17x25
 Perimeter pier pad size: 16x16
 Other pier pad sizes (required by the mfg.): 24x24, 34x22

Draw the approximate locations of marriage wall openings 4 foot or greater. Use this symbol to show the piers.

List all marriage wall openings greater than 4 foot and their pier pad sizes below.

Opening	Pier pad size
<u>FACTORY</u>	<u>DIAGRAM</u>

POPULAR PAD SIZES

Pad Size	Sq In
16 x 16	256
16 x 18	288
18.5 x 18.5	342
16 x 22.5	360
17 x 22	374
13 1/4 x 26 1/4	348
20 x 20	400
17 3/16 x 25 3/16	441
17 1/2 x 25 1/2	446
24 x 24	576
26 x 26	676

ANCHORS

4 ft 5 ft

FRAME TIES

within 2' of end of home spaced at 5' 4" oc

TIEDOWN COMPONENTS

Longitudinal Stabilizing Device (LSD)
 Manufacturer: OLIVER TECHNOLOGIES
 Longitudinal Stabilizing Device w/ Lateral Arms
 Manufacturer: OLIVER TECHNOLOGIES

OTHER TIES

	Number
Sidewall	<u>25</u>
Longitudinal	<u>4</u>
Marriage wall	<u>6-5' 6-4'</u>
Shearwall	<u>2</u>

Mobile Home Permit Worksheet

Application Number: _____ Date: _____

POCKET PENETROMETER TEST

The pocket penetrometer tests are rounded down to _____ psf or check here to declare 1000 lb. soil without testing.

X _____ X _____ X _____

POCKET PENETROMETER TESTING METHOD

1. Test the perimeter of the home at 6 locations.
2. Take the reading at the depth of the footer.
3. Using 500 lb. increments, take the lowest reading and round down to that increment.

X _____ X _____ X _____

TORQUE PROBE TEST

The results of the torque probe test is 245 inch pounds or check here if you are declaring 5' anchors without testing _____. A test showing 275 inch pounds or less will require 5 foot anchors.

Note: A state approved lateral arm system is being used and 4 ft. anchors are allowed at the sidewall locations. I understand 5 ft anchors are required at all centerline tie points where the torque test reading is 275 or less and where the mobile home manufacturer may requires anchors with 4000 lb holding capacity.

DAVID Installer's initials

ALL TESTS MUST BE PERFORMED BY A LICENSED INSTALLER

Installer Name DAVID AIBRIGHT MOBILE HOME SVC

Date Tested _____

Electrical

Connect electrical conductors between multi-wide units, but not to the main power source. This includes the bonding wire between multi-wide units. Pg. 64-68

Plumbing

Connect all sewer drains to an existing sewer tap or septic tank. Pg. 70

Connect all potable water supply piping to an existing water meter, water tap, or other independent water supply systems. Pg. 107

Site Preparation

Debris and organic material removed
 Water drainage: Natural Swale Pad Other

Fastening multi wide units

Floor: Type Fastener: LAG Length: 6" Spacing: 2'
 Walls: Type Fastener: SCREW Length: 4" Spacing: 18"
 Roof: Type Fastener: LAG Length: 6" Spacing: 2'
 For used homes a min. 30 gauge, 8" wide, galvanized metal strip will be centered over the peak of the roof and fastened with galv. roofing nails at 2" on center on both sides of the centerline.

Gasket (weatherproofing requirement)

I understand a properly installed gasket is a requirement of all new and used homes and that condensation, mold, mildew and buckled marriage walls are a result of a poorly installed or no gasket being installed. I understand a strip of tape will not serve as a gasket.

Installer's initials

Type gasket Pg. 36

Installed:
 Between Floors Yes
 Between Walls Yes END WALLS
 Bottom of ridgebeam Yes

Weatherproofing


The bottomboard will be repaired and/or taped. Yes Pg. 119
 Siding on units is installed to manufacturer's specifications Yes
 Fireplace chimney installed so as not to allow intrusion of rain water. Yes

Miscellaneous

Skirting to be installed. Yes _____ No
 Dryer vent installed outside of skirting. Yes _____ N/A
 Range downflow vent installed outside of skirting. Yes _____ N/A
 Drain lines supported at 4 foot intervals. Yes
 Electrical crossovers protected. Yes
 Other: _____

Installer verifies all information given with this permit worksheet is accurate and true based on the manufacturer's installation instructions and or Rule 15C-1 & 2

Installer Signature David Aibright Date _____

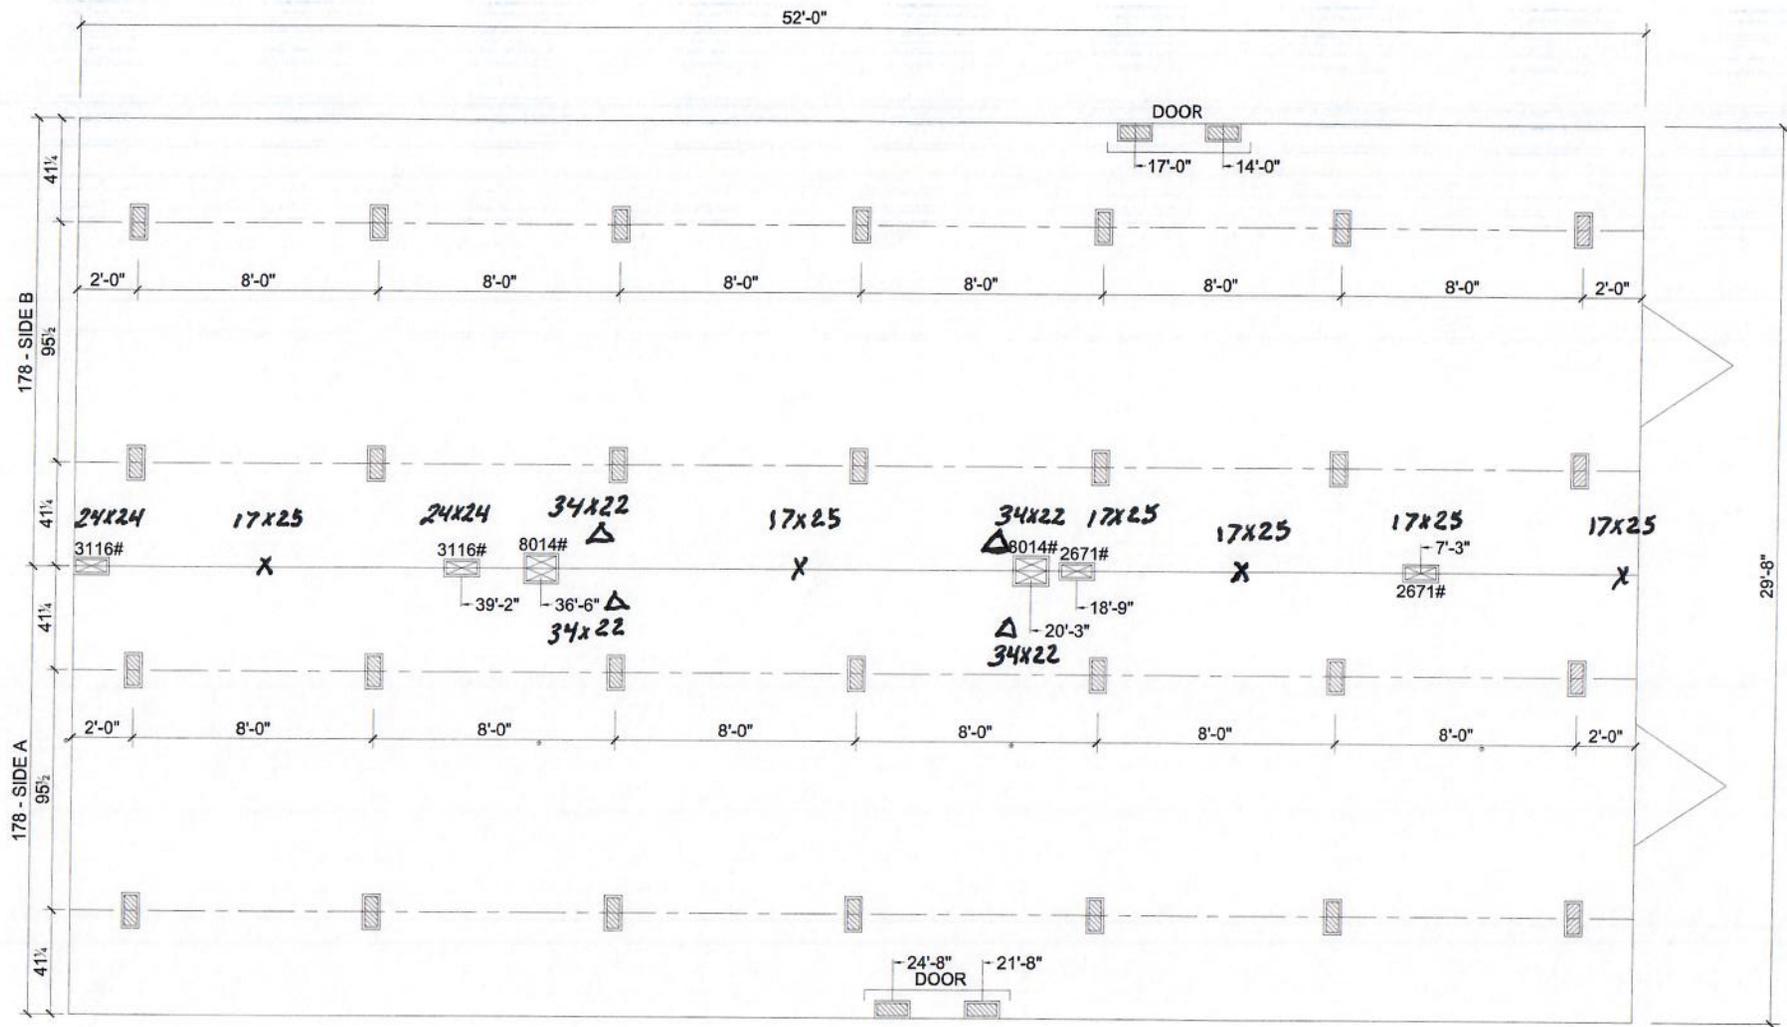

- MARRIAGE LINE OPENING SUPPORT PIER/TYP.
- SUPPORT PIER/TYP

07/08/19

FOUNDATION NOTES:

- THIS DRAWING IS DESIGNED FOR THE STANDARD WIND ZONE AND IS TO BE USED IN CONJUNCTION WITH THE INSTALLATION MANUAL AND ITS SUPPLEMENTS.
- FOOTINGS ARE SHOWN FOR EXAMPLE ONLY QUANTITY AND SPACING MAY VARY BASED ON PAD TYPE, SOIL CONDITION, ETC.
- FOOTINGS ARE REQUIRED AT SUPPORT POSTS, SEE INSTALLATION MANUAL FOR REQUIREMENTS.

Live Oak Homes
MODEL: V-3524G - 32 X 52
4-BEDROOM / 2-BATH

V-3524G