

621039

JOB NUMBER
20250121

SHEET NUMBER

© WM DEJGN & ASSOCIATES, INC. 426 SW COMMERCE DR. STE 130 LAKE CITY, FL 32025

(386) 758-8406 will@willmyers.net

SOFTPIAN

EXTERIOR ELEVATIONS
SCALE: 14" = 1.0"

MCAM A.1

© WM DESIGN &

A550CIATE.5, INC. 426 SW COMMERCE DR. STE 130 LAKE CITY, FL 32025

JOB NUMBER 20250121

AREA SUMMARY

1,826 S.F.

386 S.F.

88 S.F.

40 S.F.

2,340 S.F.

LIVING AREA

**GARAGE AREA** 


TOTAL AREA

COVERED PORCH AREA

ENTRY PORCH AREA

SHEET NUMBER

A.2

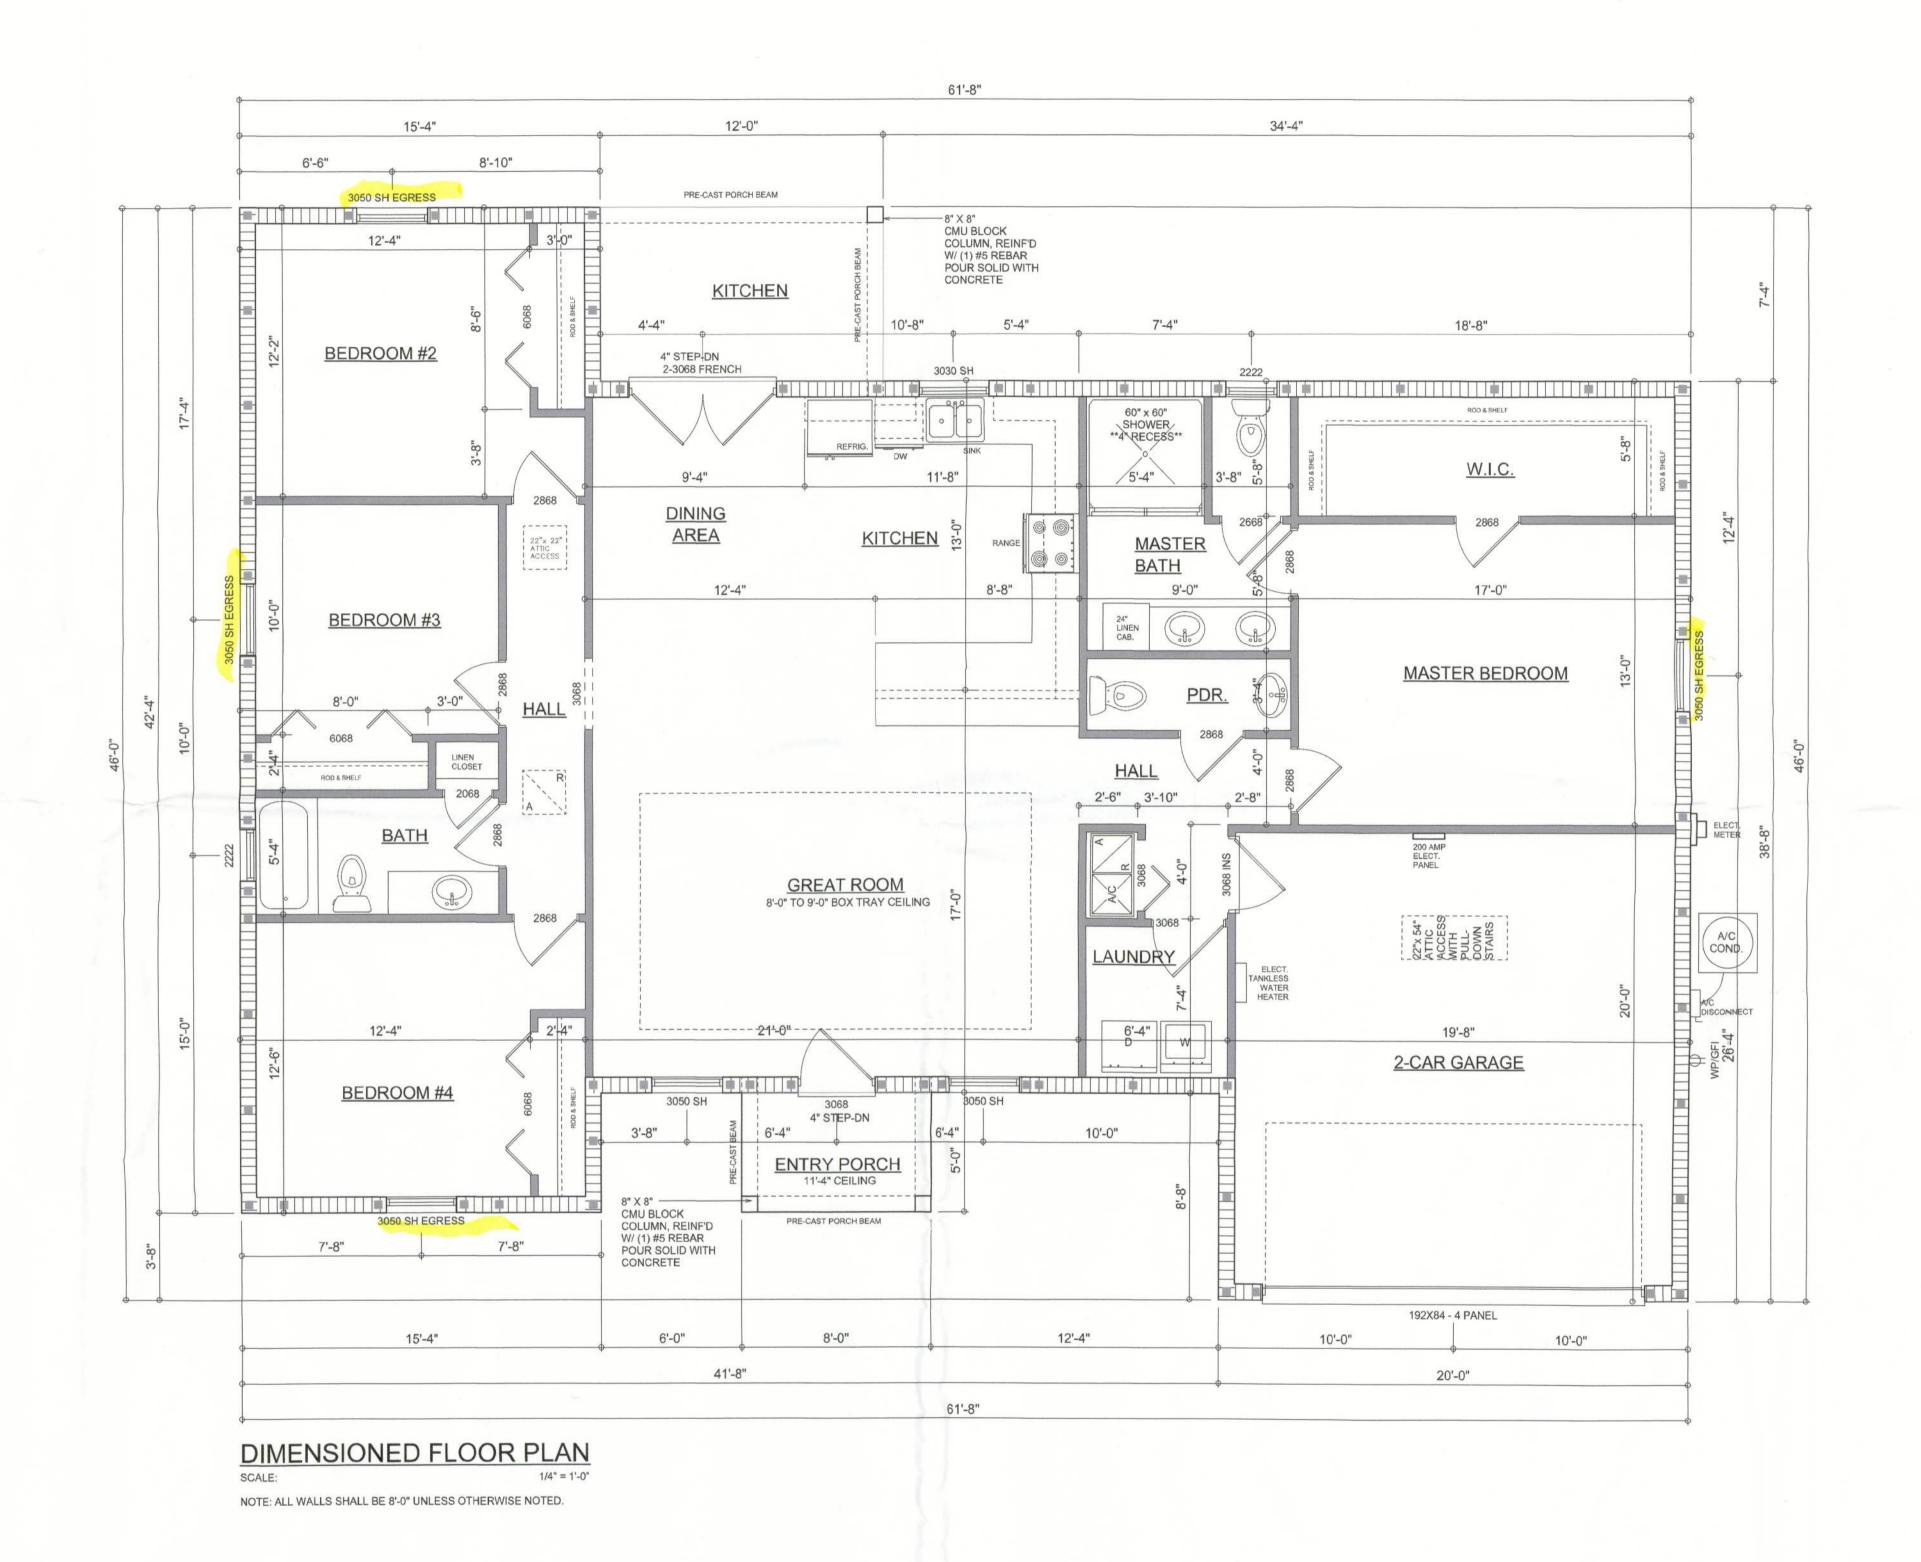

Garage fire separations shall comply with the following:

1. The private garage shall be separated from the dwelling unit and its attic area by means of a minimum ½-inch (12.7 mm) gypsum board applied to the garage side. Garages beneath habitable rooms shall be separated from all habitable rooms above by not less than 5/8-inch Type X gypsum board or equivalent. Door openings between a private garage and the dwelling unit shall be equipped with either solid wood doors, or solid or honeycomb core steel doors not less than 13/8 inches (34.9 mm) thick, or doors in compliance with Section 715.3.3. Openings from a private garage directly into a room used for sleeping purposes shall not be permitted.

2. Ducts in a private garage and ducts penetrating the walls or ceilings separating the dwelling unit from the garage shall be constructed of a minimum 0.019-inch (0.48 mm) sheet steel and shall have no openings into the garage.

A separation is not required between a Group R-3 and U carport provided the carport is entirely open on two or more sides and there are not enclosed areas above.

4. When installing an attic access and/or pull-down stair unit in the garage, devise shall have a minimum 20 min. fire rating.

	ELECTRICAL LEGEND				
	CEILING FAN (PRE-WIRE FOR LIGHT KIT)				
₫₽	DOUBLE SECURITY LIGHT				
0	RECESSED CAN LIGHT  BATH EXHAUST FAN  LIGHT FIXTURE  DUPLEX OUTLET (AFCI & TAMPER RESISTANT)				
₩					
<b>-</b>					
Ф					
	220v OUTLET				
⊕GF1	GFI DUPLEX OUTLET (PER NEC 406.8)				
TV †	TELEVISION JACK				
(N)	ETHERNET JACK				
	CIRCUIT FOR MINI-SPLIT A/C UNIT				
•	SMOKE / CARBON MONOXIDE DETECTOR (see note below)				
\$	WALL SWITCH				
\$3	3 WAY WALL SWITCH				
₩P/GFI	WATER PROOF GFI OUTLET				
48" FLOUR.	2 OR 4 TUB FLUORESCENT FIXTURE				

ALL INTERIOR RECEPTACLES SHALL BE AFCI
(ARC FAULT CIRCUIT INTERRUPT) PER NEC 210.12 & TAMPER RESISTANT PER


ALL INTERIOR & EXTERIOR LIGHTING SHALL MEET OR EXCEED THE MIN. 75% HIGH-EFFICIENCY LIGHTING PER FBC-ENERGY CONSERVATION R404.

ALL SMOKE DETECTORS BE A COMBO SMOKE & CARBON MONOXIDE DETECTOR AND SHALL HAVE BATTERY BACKUP POWER

AND ALL WIRED TOGETHER SO IF ANY ONE UNIT IS ACTUATED THEY THE ELECTRICAL SERVICE OVERCURRENT PROTECTION DEVICE SHALL BE INSTALLED ON THE EXTERIOR OF STRUCTURES TO SERVE AS A DISCONNECT MEANS.
CONDUCTORS USED FROM THE EXTERIOR DISCONNECTING MEANS TO A PANEL OR SUB
PANEL SHALL HAVE FOUR-WIRE CONDUCTORS, OF WHICH ONE CONDUCTOR

SHALL BE USED AS AN EQUIPMENT GROUND.

IT IS THE LICENSED ELECTRICAL CONTRACTORS RESPONSIBILITY TO INSURE THAT ALL WORK PERFORMED AND EQUIPMENT INSTALLED MEETS OR EXCEEDS THE 2020 (NFPA-70) NATIONAL ELECTRIC CODE AND ALL OTHER LOCAL CODES AND ORDINANCES.

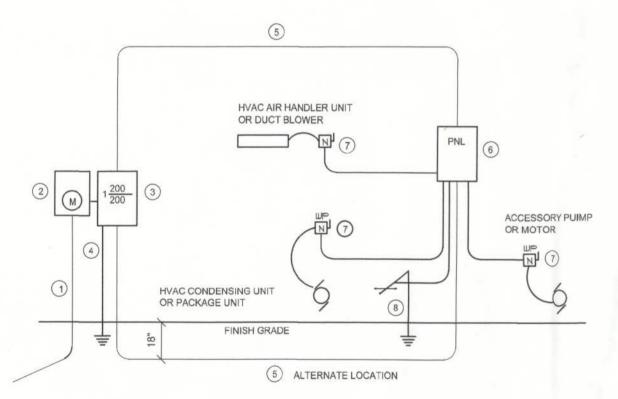


- Service/Feeder Entrance Conductors: 2" rigid conduit, min.
  18" deep, w/ continuous Ground Bonding Conductor, Service/
  Entrance Conductors shall not be spliced except that bolted connections at the Meter, Disconnecting Devices and Panel shall be allowed.
- 2 Meter Enclosure, weatherproof, U.L. Listed.
- 3 Main Disconnect Switch: fused or Main BRKR, weatherproof, U.L. Listed.
- Service entrance Ground: }" ~ iron/steel rod x 8'-0" long and/or concrete encased foundation steel rebar x 20'-0" long. Grounding Conductor shall be bonded to each piece of Service/Entrance Equipment, and shall be sized per Item #5, below.
- 5) 200 AMPERE SERVICE: 3-#2/0-USE-Cu, 1-#4-Cu-GND, 2" Conduit.
- 6 House Panel (PNL), U.L. Lised, sized per schedule.
- 7 Equipment Disconnect Switch: non-fused, in weatherproof enclosure, size according to Panel Schedule loads.
- Provide Ground Bond Wire to metal piping, size in accordance with the Service Ground Conductor.

THE MINIMUM AIC RATING FOR PANEL BOARDS, BRKRS AND DISCONNECT SWITCHES SHALL BE 22,000 AIC.

# ELECTRICAL RISER DIAGRAM: 200A

SCALE: NONE

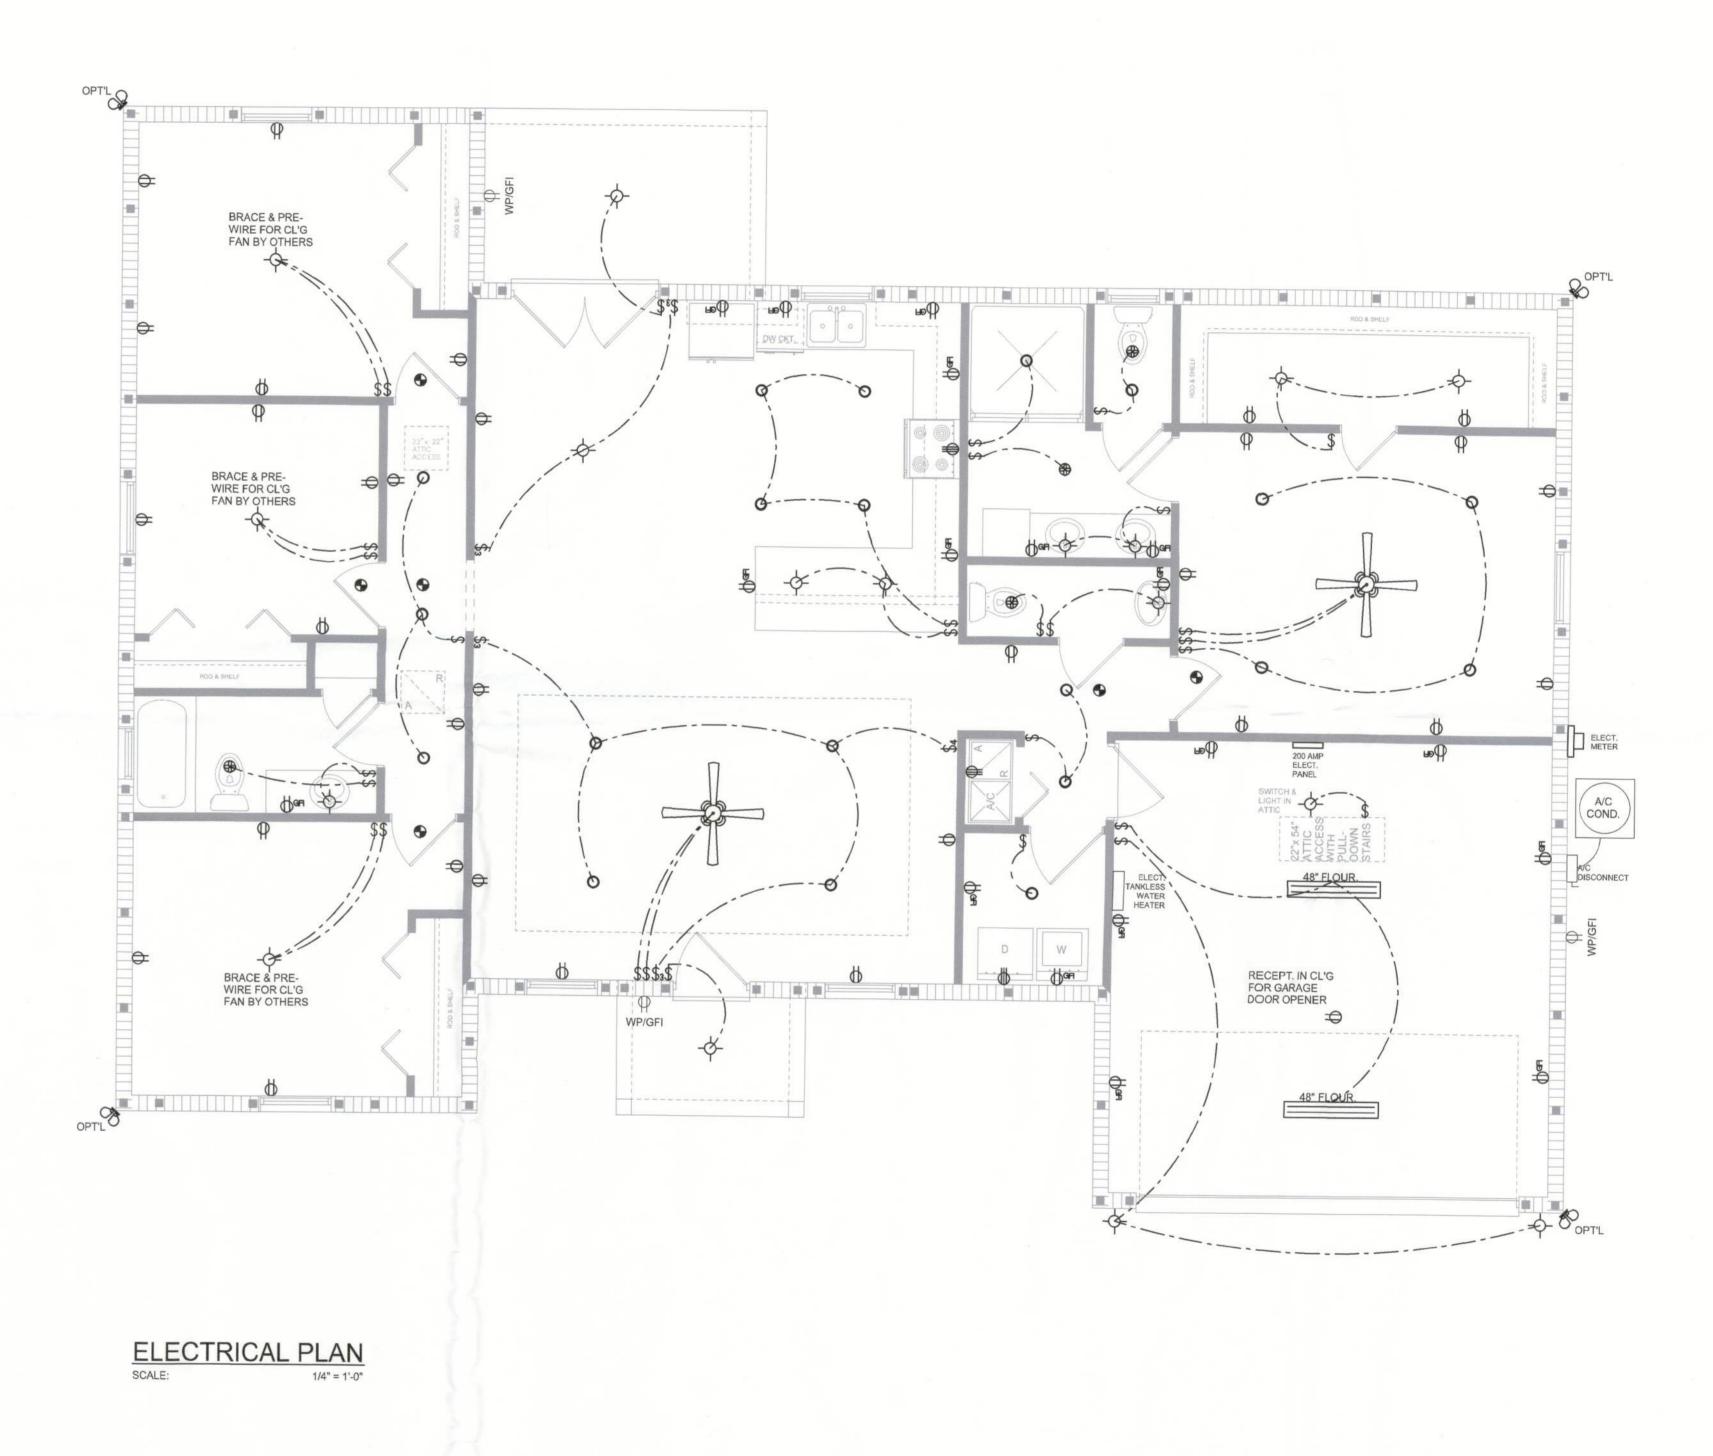

SOFTPIAN


© WM DEJGN & ASSOCIATES. NC. 426 SW COMMERCE DR. STE 17 LAKE CITY, FL 32025 (386) 758-8406 will@willmyers.net



JOB NUMBER 20250121

SHEET NUMBER

A.3

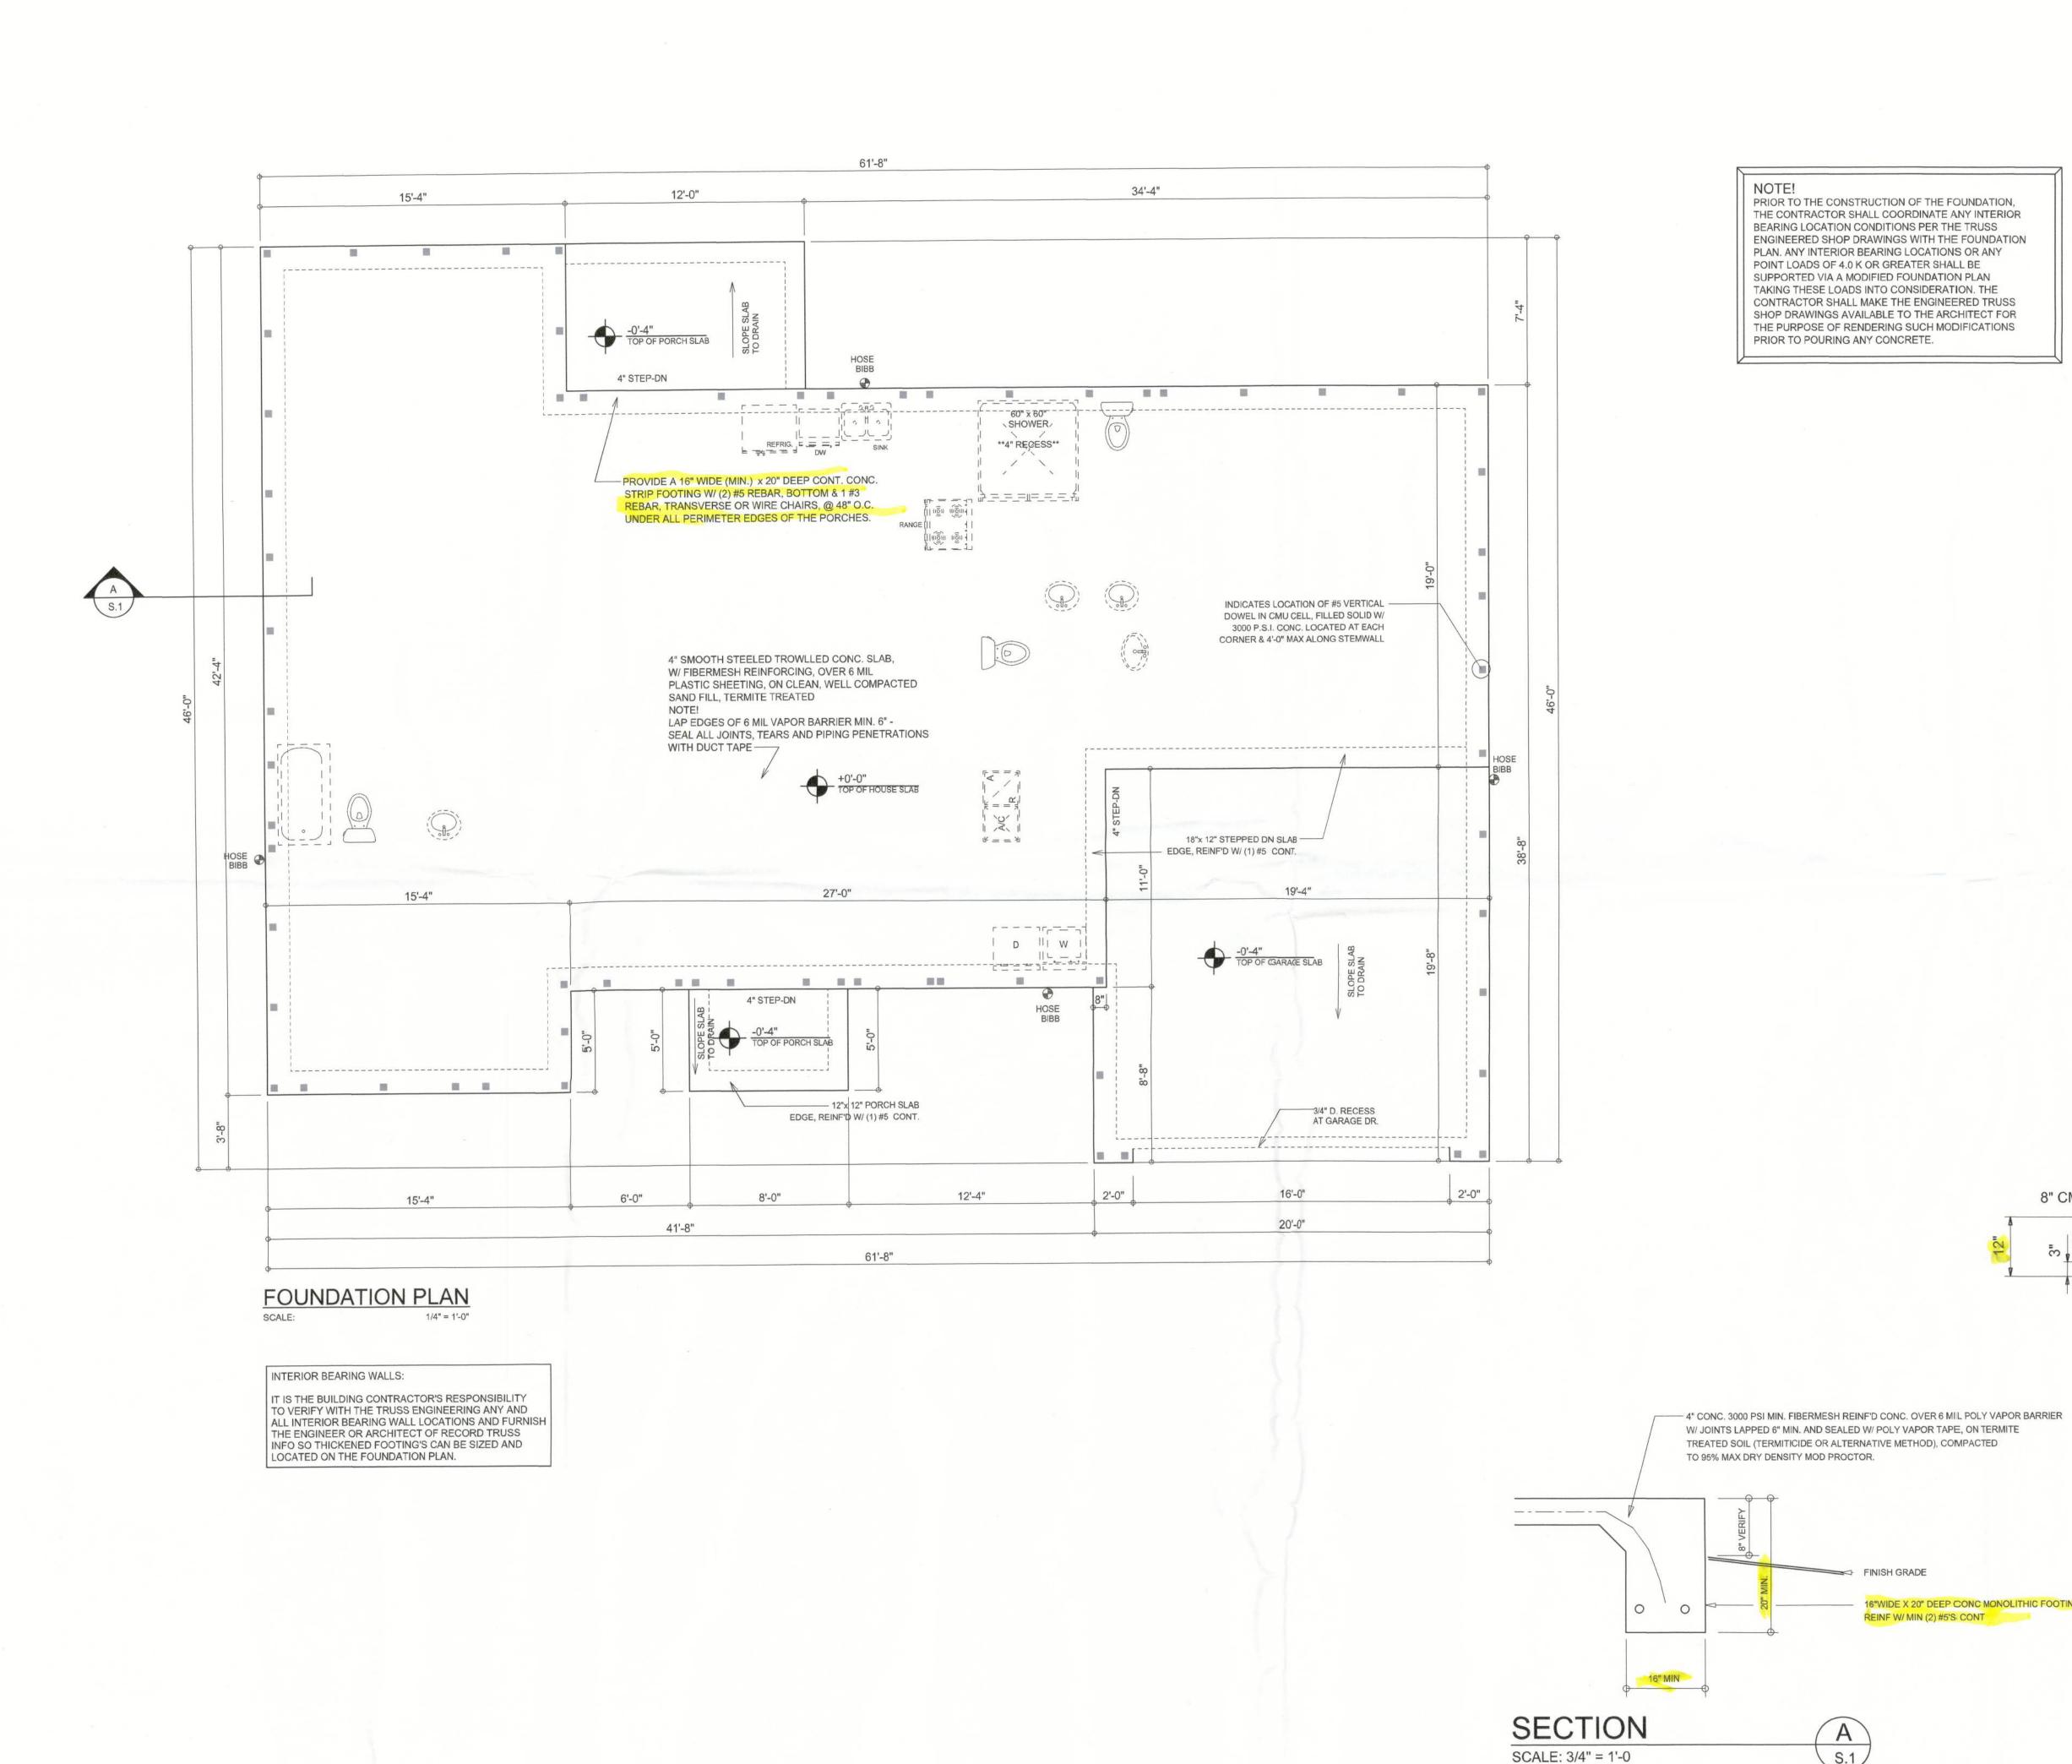

## CONCRETE / MASONRY / **METALS GENERAL NOTES:**

1. DESIGN SOIL BEARING PRESSURE: 1000 PSF.

PRIOR TO THE CONSTRUCTION OF THE FOUNDATION.

THE CONTRACTOR SHALL COORDINATE ANY INTERIOR BEARING LOCATION CONDITIONS PER THE TRUSS

ENGINEERED SHOP DRAWINGS WITH THE FOUNDATION

PLAN. ANY INTERIOR BEARING LOCATIONS OR ANY

POINT LOADS OF 4.0 K OR GREATER SHALL BE

PRIOR TO POURING ANY CONCRETE.

SUPPORTED VIA A MODIFIED FOUNDATION PLAN TAKING THESE LOADS INTO CONSIDERATION. THE

CONTRACTOR SHALL MAKE THE ENGINEERED TRUSS

SHOP DRAWINGS AVAILABLE TO THE ARCHITECT FOR

THE PURPOSE OF RENDERING SUCH MODIFICATIONS

⇒ FINISH GRADE

A

S.1

16"WIDE X 20" DEEP CONC MONOLITHIC FOOTING

REINF W/ MIN (2) #5'S CONT

2. EXPANSIVE SOILS: WHERE DIRECTED BY THE SOILS ENGINEER, SOIL AUGMENTATION PER THE SOILS ENGINEER'S SPECIFICATIONS SHALL BE IMPLEMENTED PRIOR TO PLACING ANY FOUNDATIONS - TESTS AS SPECIFIED SHALL BE PREFORMED TO DETERMINE THE SUITABILITY OF THE SUB-GRADE TO SUPPORT THE DESIGN LOADS.

CLEAN SAND FILL OVER STRIPPED AND COMPACTED EXISTING GD. SHALL BE PLACED IN 12" LIFTS. BOTH SUB-SOIL AND FILL COMPAC-TION SHALL BE NOT LESS THAN 98% AS MEASURED BY A MODIFIED PROCTOR TEST AT THE RATE OF ONE TEST FOR EACH 1500 SF OF BUILDING PAD AREA, OR FRACTION THEREOF, FOR EACH 12" LIFT.

4. REINFORCING STEEL SHALL BE GRADE 60 AND MEET THE REQUIRE-MENTS OF ASTM A615, ALL BENDS SHALL BE MADE COLD.

WELDED WIRE MESH SLAB REINFORCING SHALL MEET THE REQUIRE-MENTS OF ASTM A185 - MIN. YEILD STRESS = 85 KSI.

CONCRETE SHALL BE STANDARD MIX F'c = 3000 PSI FOR ALL FTGS, SLABS, COLUMNS AND BEAMS OR SHALL BE STANDARD PUMP MIX F'c = 3000 PSI. STRENGTH SHALL BE ATTAINED WITHIN 28 DAYS OF PLACE-MENT. MIXING, PLACING AND FINISHING SHALL BE AS PER ACI STANDARDS.

 CONCRETE BLOCK SHALL BE AS PER MANUFACTURER'S PRODUCT GUIDE FOR ASTM C-90 REQUIREMENTS WITH MEDIUM SURFACE FINISH -F'm = 1500 PSI.

8. MORTAR SHALL BE TYPE "M" OR "N" FOR ALL MASONRY UNITS.

STRUCTURAL STEEL SHALL CONFORM TO ASTM A36 STANDARDS FOR STRENGTH, BOLTS SHALL BE ASTM A307 / GRADE 1 OR A325, AS PER PLAN REQUIREMENTS.

10. WELDS SHALL BE AS PER "AMERICAN WELDING SOCIETY" STANDARDS FOR STRUCTURAL STEEL APPLICATIONS.

11. 2X4 P/T WOOD SILL, CONT., ALL AROUND, W/ 5/8"~ A.B. W/ 3" SQ. X 1/4" PLATE WASHERS WITHIN 6" FROM EACH CORNER, EA. WAY, & WITHIN 6" FROM ALL WALL OPENINGS / ENDS - 1/2"~ A.B. W/ 2" SQ. WASHERS ALONG EACH RUN @ 48" O.C., MAX. - ALL ANCHOR BOLTS SHALL HAVE A MINIMUM OF 8" EMBEDMENT INTO THE CONCRETE

- 4" THK. 3,000 PSI CONCRETE SLAB W/ FIBERMESH CONCRETE ADDITIVE, OVER TREATED, CLEAN COMPACTED FILL -#5 ELLS X 18" X 18" @ 48" O.C. MAX. -8" CMU BOND BEAM W/#5 BAR CONT/25" MIN. LAP #5 DOWELS @ 48" O.C. MAX. 8" CMU #3 BARS HORIZ. OR CHAIRS @ 48" O.C. -3,000 PSI CONCRETE FOOTING 4" (2) #5 BARS CONTINUOUS

SECTION (optional)

SCALE: 3/4" = 1'-0

THE DESIGN WIND SPEED FOR THIS PROJECT IS 140 MPH PER 2023 FBC (8TH EDITION) AND LOCAL JURISDICTION REQUIREMENTS

ADDED FILL SHALL BE APPLIED IN 8" LIFTS -EA. LIFT SHALL BE CONPACTED TO 98% DRY COMPACTION PER THE "MODIFIED PROCTOR" METHOD.

PLUMBING CONTRACTOR SHALL PREPARE "AS-BUILT" SHOP DRAWINGS INDICATING ALL PLUMBING WORK, INCLUDING ALL PLUMBING LINE LOCATIONS AND RISER DIAGRAM - CONT'R SHALL PROVIDE 1 COPY OF AS-BUILT DWGS TO OWNER AND 1 COPY TO THE PERMIT ISSUING AUTHORITY.

H.V.A.C. CONTRACTOR SHALL PREPARE "AS-BUILT" SHOP DRAWINGS INDICATING ALL H.V.A.C. WORK, INCLUDING ALL DUCTWORK LOC., SIZES, LINES, EQUIPMENT SCH. & BALANCING REPORT - CONT'R SHALL PROVIDE 1 COPY OF AS-BUILT DWGS TO OWNER & 1 COPY TO THE PERMIT ISSUING AUTHORITY.


SOFTPIAN

Z

JOB NUMBER 20250121

SHEET NUMBER

OF 4 SHEETS

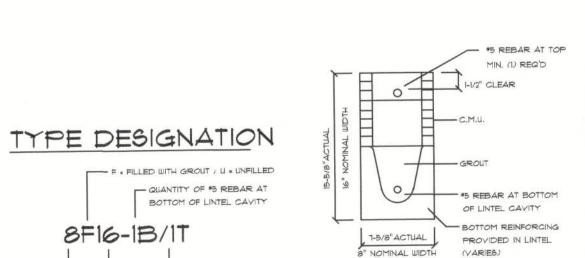

NOMINAL HEIGHT REBAR AT TOP e" PRECAST & PRESTRESSED ILI INTELS

DETAIL A/3 PRE-CAST LINTEL OVER GARAGE DOOR DDE CAST LINTELS & LANAL COLUMNS

+ 8'-0"

						GF	RAVIT	$\prec$			
			TYPE		8F8-0B	8F12-0B	8F16-0B	8F2O-0B	8F24-0B	8F28-CB	8F32-0E
MARK	LENGT	4		sus	8F8-IB	8=12-1B	8F16-1B	8F2O-IB	8F24-1B	8F28-IB	8F32-IB
	United States (1999)			Kitheren	3166	4473	6039	1526	9004	10472	11936
L1	2'-10"	(34")	PRECAST	2302	3166	4473	6039	7526	9004	10472	11936
			-	CONTROL OF THE PARTY OF THE PAR	3138	3377	4689	6001	7315	8630	9947
L2	3'-6"	(42")	PRECAST	2302	3166	4473	6039	7526	9004	10472	11936
	V 107-5V2				2325	2496	3467	4438	5410	6384	7358
L3	4'-0"	(48")	PRECAST	2029	2646	4473	6039	7526	9004	10472	11936
		NO STANIA VIV			דפרו	1913	2657	3403	4149	4896	5644
L4	4'-6"	(54")	PRECAST	1651	2170	4027	6039	7526	9004	10472	9668
					1223	1301	1809	2317	2826	3336	3846
L5	5'-4"	(64")	PRECAST	1184	1665	2889	5057	6096	5400	6424	7450
					1000	1059	1474	1889	2304	2721	3137
L6	5'-10"	(10")	PRECAST	972	1459	2464	4144	5458	4437	5280	6122
9940	177 640			200	1255	2101	3263	2746	3358	3971	4585
LT	6'-6"	("8")	PRECAST	937	1255	2101	3396	5260	7134	8995	6890
/West	earen escue			202	1029	1675	2385	1994	2439	2886	3333
L8	7'-6"	(90")	PRECAST	767	1029	1675	2610	3839	5596	6613	5047
200000	9'-4" (112")	PRECAST	573	632	1049	1469	1210	1482	1754	2027	
T-9				768	1212	1818	2544	3469	4030	3127	
17177847	721 21 MA2 85		454	482	802	1125	915	1122	1328	1535	
LIO	10'-6"	(126")	PRECAST	456	658	1025	1514	2081	2774	3130	2404
					598	935	1365	1854	2355	1793	2075
LII	11'-4"	(136")	PRECAST	445	598	935	1365	1854	2441	3155	4044
					545	864	1254	1689	2014	1570	1818
L12	12'-0"	(144")	PRECAST	414	555	864	1254	1693	2211	2832	3590
		10.			427	726	1028	1331	1635	1224	1418
LI3	13'-4"	(160")	PRECAST	362	485	748	1076	1438	1855	2343	2920
1000					381	648	919	1190	1462	1087	1260
L14	14'-0"	(168")	PRECAST	338	455	T00	1003	1335	1714	2153	2666
7.52	200			110	NR	NR	NR.	NR	NR	NR	NR
LIB	14'-8"	(176")	PRESTRESSED	N.R.	465	765	1370	2045	2610	3185	3765
11000			DDESTDESSED	N.R.	NR	NR	NR	NR	NR	NR	NR
LI6	15'-4"	(184")	PRESTRESSED	N.K.	420	695	1250	1855	2370	2890	3410
	1001 431	(2007)	PRESTRESSED	N.R.	NR	NR	NR	NR	NR	NR	NR
LIT	17'-4"	(200)	PREDIRECOED	N.K.	310	530	950	1400	1800	2200	2600
1.10	19'-4"	(232")	PRESTRESSED	N.R.	NR	NR	NR	NR	NR	NR	NR
LIS	15-4	(434.)	PRESTRESOLD	N.K.	240	400	750	1090	1400	1720	2030
1.10	21'-4"	(254 H)	PRESTRESSED	N.R.	NR	NR	NR	NR	NR	NR	NR
TI3	21-4	(200 )	FREDIREGGED	(8)(8)	183	330	610	940	1340	1780	2110 NR
120	22'-0"	(264")	PRESTRESSED	N.R.	NR	NR	NR	NR	NR	NR V660	_
L20				1307	160	300	510	870	1250	1660 NB	1970 NR
	24'-0"		PRESTRESSED	N.R.	NR	NR	NR	NR	NR	NR	NR

8" PRECAST W/ 2" RECESS DOOR U-LINTELS

					GRAVITY									
			TVDT		8RF6-OB	BRFIO-OB	SRFI4-OB	SRFIS-OB	SRF22-OB	SRF26-OB	SRF30-0E			
MARK	LENGT	Н	TYPE	8RU6	8RF6-IB	SRFIO-IB	8R=14-1B	SRFIS-IB	8RF22-IB	eRF26-IB	SRF30-IB			
		Mariner.	79-29-02-29-29-2	Town serior	1591	3053	2982	3954	4929	5904	6880			
L22	4'-4"	(52")	PRECA6T	1489	1827	3412	4982	6472	7947	9416	10878			
					1449	2782	2714	3600	4487	5375	6264			
L23	L23 4'-6"	(54")	PRECAST	1357	1702	3412	4982	6472	7947	9416	10878			
								832	1602	1550	2058	2566	3075	3585
L24	5'-8"	(68")	PRECAST	785	1153	2162	4074	6472	6516	5814	6839			
_					TT9	1500	1449	1924	2400	2876	3352			
L25	5'-10"	("0")	PRECAST	735	1103	2051	3811	6472	6516	5450	6411			
	W 1000				907	1677	2933	2576	3223	3872	4522			
L26	6'-8"	(80")	PRECAST	822	907	1677	2933	4100	6130	SITT	6101			
					761	1377	2252	1958	2451	2944	3439			
L27	7'-6"	(90")	") PRECAST	665	764	1377	2329	3609	5492	6624	5132			
					420	834	1253	ITOI	1342	1614	1886			
L28	9'-8"	(116")	PRECAST	371	535	928	1497	2179	2618	3595	2875			

SHOP DWG COORDINATION: THE TRUSS ANCHOR STRAPS AS INDICATED IN THE CONSTRUCTION DOCUMENTS ARE SUGGESTED STRAPS AND THAT THE TRUSS ENGINEERED SHOP DRAWING LOADS TAKE PRECEDENCE OVER THAT INDICATED IN THE CONSTRUCTION DOCUMENTS. THE UPLIFT LOADS INDICATED FOR EACH TRUSS IN THE ENGINEERED TRUSS SHOP DRAWINGS MAY BE MATCHED TO STANDARD PRODUCT UPLIFT RATINGS FOR COMPARABLE UPLIFT CONNECTORS, AND THAT THE PRODUCTS THAT PROVIDE EQUAL OR GREATER UPLIFT RESISTANCE FOR THE LISTED LOADS MAY BE USED IN LIEU OF THOSE INDICATED IN THE CONSTRUCTION DOCUMENTS OR AS APPROVED BY THE BUILDING OFFICIAL.

THE CONTRACTOR SHALL COORDINATE THE TRUSS TO TRUSS ANCHOR REQUIREMENTS WITH THE TRUSS ENGINEERING SHOP DRAWINGS, SOME OF THE TRUSS TO TRUSS CONNECTIONS WILL REQUIRE ANCHOR STRAPS IN ADDITION TO TYPICAL NAILING, ANCHOR DEVICES SHALL BE REQUIRED FOR ALL JOINTS WITH AN UPLIFT OR GRAVITY LOAD OF 100 LBS OR GREATER.

TRUSSES BEARING ON INTERIOR PARTITIONS WHERE UPLIFT LOADS ARE PRESENT SHALL REQUIRE ANCHORS OF EQUAL OR GREATER LOAD CAPACITY THAN THAT INDICATED BY THE TRUSS SHOP DRAWINGS. THE UPLIFT ANCHOR SYSTEM SHALL BE CONTINUOUS TO THE FOUNDATION.

## GENERAL TRUSS NOTES:

1. TRUSSES SHALL BE DESIGNED BY A LICENSED ENGINEER, AND IN ACCORDANCE WITH THE REQUIREMENTS OF THE "NATIONAL FOREST PRODUCTS ASSOCIATION" MANUAL FOR "STRESS RATED LUMBER AND IT'S CONNECTIONS", LATEST Ed., ALONG W/ THE "TRUSS PLATE INSTITUTE" SUGGESTED GUIDELINES FOR TEMPORARY AND PERMANENT BRACING, AND HANDLING OF TRUSSES. TRUSS SHOP DRAWINGS SHALL INCLUDE TRUSS DESIGN, PLACEMENT PLANS, DETS, & TRUSS TO TRUSS CONNECTIONS.

#### 2. TRUSS SHOP DRAWINGS SHALL BE SIGNED & SEALED BY THE DESIGNING ENGINEER.

3. FOLLOWING DEVELOPMENT OF TRUSS SHOP DRAWINGS, ADJUSTMENTS TO THE ANCHOR REQUIRMENTS MAY BE REQUIRED DEPENDING ON THE ENGINEERED GRAVITY AND WIND UPLIFT REQUIREMENTS OF TRUSSES OR GIRDERS. THE CONTRACTOR SHALL MAKE AVAILABLE A COMPLETE SET OF TRUSS SHOP DRAWINGS TO THE ARCHITECT FOR THE PURPOSE OF REVIEW OF LOADS IMPOSED ON THE BALANCE OF THE STRUCTURE, ANY SUCH REQUIRED CHANGE SHALL BE INCORPORATED INTO THE CONSTRUCTION OF THIS

(L17)

### ROOF PLAN NOTES

R-1 SEE EXTERIOR ELEVATIONS FOR ROOF PITCH

SOFTPLAN

R-2 ALL OVERHANG 18" UNLESS OTHERWISE NOTED

PROVIDE ATTIC VENTILATION IN AC-

SEE EXTERIOR ELEVATIONS AND FLOOR PLANS TO VERIFY PLATE AND HEEL HEIGHTS


CORDANCE WITH SCHEDULE ON SD.3

MOVE ALL VENTS AND OTHER ROOF PENETRATIONS TO REAR

SHEATH ROOF W/ 1/2" CDX PLYWOOD PLACED W/ LONG DIMENSION PERPENDICULAR TO THE ROOF TRUSSES, SECURE TO FRAMING W/ 10d RING-SHANK NAILS - AS PER DETAIL ON SHEET 5.4

THE DESIGN WIND SPEED FOR THIS PROJECT IS 130 MPH PER 2023 FBC (8TH EDITION) AND LOCAL JURISDICTION REQUIREMENTS


AREA OF ATTIC	REQ'D L.F. OF YENT	NET FREE AREA OF INTAKE
1600 SF	20 LF	410 SQ.IN.
1900 SF	24 LF	490 SQ.IN.
2200 SF	28 LF	570 SQ.IN.
2500 SF	32 LF	650 SQ.IN.
2800 SF	36 LF	730 SQ.IN.
3100 SF	40 LF	820 SQ.IN.
3600 SF	44 LF	900 SQ.IN.

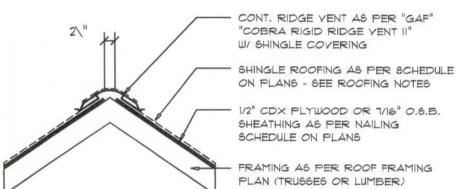

MIAMI/DADE PRODUCT APPROVAL REPORT: #96-0113,05

# Ridge Vent DETAIL



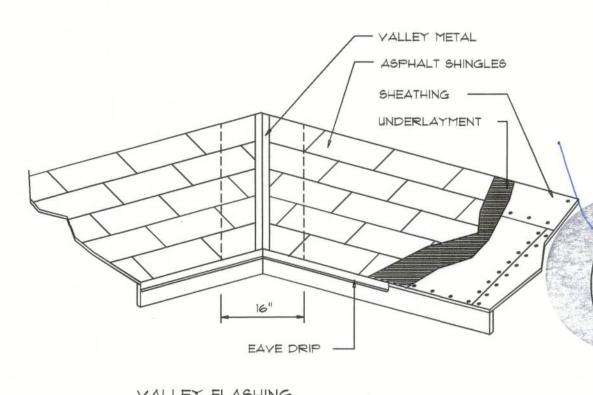


VALLEY FLASHING

三日

# Roof Framing PLAN

SCALE: 1/4" = 1'-0"

ALL PENETRATIONS OF THE TOP PLATE OF ALL LOAD BEARING WALLS SHALL BE SEALED WITH FIRE RETARDANT CAULKING, INCLUDING WIRING, PLUMBING OR OTHER SUCH PENETRATIONS. WALLS OVER 8'-0" TALL SHALL HAVE CONTINUOUS BLOCKING TO LIMIT CAVITY HEIGHT TO 8'-O". PENETRATIONS THROUGH SUCH BLOCKING SHALL BE TREATED IN THE SAME MANNER AS TOP PLATES, NOTED ABOVE

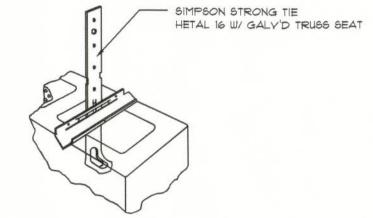

Truss Anchor DETAIL

SCALE: 1/2" = 1'-0"

#### ROOFING METALS for FLASHING/ROOFING MINIMUM THICKNESS REQUIREMENTS MINIMUM MATERIAL

TATENAL	THICKNESS (in)	GAGE	(OZ.)
COPPER			16
ALUMINUM	0.024		
STAINLESS STEEL		28	
GALYANIZED STEEL	er10.0	26 (ZINC COATED G90)	
ZINC ALLOY LEAD PAINTED TERNE	0.027		40 20

# PROJECT COORDINATION REQUIREMENTS

THESE PLANS ARE DRAWN FOR AVERAGE SITE CONDITIONS AND COMPLIANCE WITH APPLICABLE CODES AT THE TIME THEY ARE DRAWN. DUE TO YARYING STATE, LOCAL, AND NATIONAL CODES RULES AND REGULATIONS, N.P.GEISLER, ARCHITCT CANNOT WARRANT COMPLIANCE WITH ALL APPLICABLE STATE, LOCAL, AND NATIONAL CODES IN YOUR AREA OR WITH YOUR PARTICULAR SITE CONDITIONS. IT IS THE RESPONSIBILITY OF THE PURCHASER AND/OR BUILDER TO SEE THAT THE STRUCTURIE IS BUILT IN STRICT COMPLIANCE WITH ALL GOVERNING MUNICIPAL CODES (CITY, COUNTY, STATE, AND FEDERAL), IF YOUR CITY OR STATE REQUIRES AN ENGINEER'S SEAL FOR THE SITE/CIVIL PORTIONS OF THE WORK,,, YOU WILL NEED TO HAVE THAT DONE LOCALLY BY A QUALIFIED, LICENCED PROFESSIONAL ENGINEER.

NOTE: ALL DRAWINGS NOT TO BE SCALED, WRITTEN DIMENSIONS TAKE PRECEDENCE OVER SCALED DIMENSIONS

(L13)

ANCHOR ALL TRUSSES WITH "SIMPSON" - HETEL 16 W/ TSS

(L4)

CMU BLOCK COLUMN, REINF'D W/#5 REBAR, POUR SOLID WITH CONCRETE.

1758 | 1758 | Eake (386)

LU Z

2

ASMANI SJECT ADDRESS: 188 SW

JOB NUMBER 20250121

SHEET NUMBER

OF 4 SHEETS

#### TYPE OF CONSTRUCTION

Gable / Hip Construction, Wood Trusses @ 24" O.C. 8" CMU W/ (1) #5 VERTICAL @ 48" O.C. MAX Walls: 4" Thk. Concrete Slab W/ Fibermesh Concrete Additive Floor: Continuous monolithic footing or /Stem Wall foundation system Foundation:

#### ROOF DECKING

1/2" CDX Plywood or 7/16" O.S.B. Material: 48"x96" Sheets Perpendicular to Roof Framing Sheet Size: 10d Ring-Shank Nails per schedule on sheet S.4 Fasteners:

#### SHEARWALLS

Material: 8" CMU W/ (1) #5 VERTICAL @ 48" O.C. MAX AND BESIDE EACH OPENING

#### HURRICANE UPLIFT CONNECTORS

SIMPSON HETEL 16 W/ TSS

Truss Anchors (FRAME): SIMPSON H2.5A (OR EQUIVALENT), W/ 6 - 10d NAILS

Simpson ABU44/ABU66 @ each column Porch Column Base Connector: Porch Column to Beam Connector: Simpson EPC44 or 66 /PC44 or 66 @ each column

## FOOTINGS AND FOUNDATIONS

House walls: 20"D x 16"W Cont. W/ (2) #5 Bars Cont. on chairs or (1) #3 Transverse @ 24" O.C. Optional Stemwall: 8" C.M.U. W/1-#5 Vertical Dowel @ 48" O.C.

#### STRUCTURAL DESIGN CRITERIA:

THE DESIGN COMPLIES WITH THE REQUIREMENTS OF THE 2023 FLORIDA BUILDING CODE (8TH EDITION) AND OTHER REFERENCED CODES AND SPECIFICATIONS. ALL CODES AND SPECIFICATIONS SHALL BE LATEST EDITION AT TIME OF PERMIT.

2. WIND LOAD CRITERIA: RISK CATAGORY: 2, EXPOSURE: "C"

BASED ON ANSI/ASCE 7-22. 2023 FBC 1609-A WIND YELOCITY: YULT = 140 MPH VASD = 108 MPH

3. ROOF DESIGN LOADS:

SUPERIMPOSED DEAD LOADS: . . . . . . 20 PSF SUPERIMPOSED LIVE LOADS: . . . . . . 20 PSF

4. FLOOR DESIGN LOADS: SUPERIMPOSED DEAD LOADS: . . . . . . . 25 PSF

SUPERIMPOSED LIVE LOADS: 40 PSF RESIDENTIAL . . . . . . . ..... 60 PSF

BALCONIES

5. WIND NET UPLIFT: ARE AS INDICATED ON PLANS

## **TERMITE PROTECTION NOTES:**

## SOIL CHEMICAL BARRIER METHOD:

FBC 1816.1.7

1. A PERMANENT SIGN WHICH IDENTIFIES THE TERMITE TREATMENT PROVIDER AND NEED FOR REINSPECTION AND TREATMENT CONTRACT RENEWAL SHALL BE PROVIDED. THE SIGN SHALL BE POSTED NEAR THE WATER HEATER OR ELECTRIC PANEL. FBC 104.2.6

2. CONDENSATE AND ROOF DOWNSPOUTS SHALL DISCHARGE AT LEAST 1'-0" AWAY FROM BUILDING SIDE WALLS. FBC 1503.4.4

3. IRRIGATION/SPRINKLER SYSTEMS INCLUDING ALL RISERS AND SPRAY HEADS SHALL NOT BE INSTALLED WITHIN 1'-0" FROM BUILDING SIDE WALLS. FBC 1503.4.4

4. TO PROVIDE FOR INSPECTION FOR TERMITE INFESTATION, BETWEEN WALL COVERINGS AND FINAL EARTH GRADE SHALL NOT BE LESS THAN 6". EXCEPTION: PAINT AND DECORATIVE CEMENTIOUS FINISH LESS THAN 5/8"

THICK ADHERED DIRECTLY TO THE FOUNDATION WALL. FBC 1403.1.6 5. INITIAL TREATMENT SHALL BE DONE AFTER ALL EXCAVATION AND BACKFILL IS COMPLETE. FBC 1816.1.1

6. SOIL DISTURBED AFTER THE INITIAL TREATMENT SHALL BE RETREATED INCLUDING SPACES BOXED OR FORMED. FBC 1816.1.2

7. BOXED AREAS IN CONCRETE FLOOR FOR SUBSEQUENT INSTALLATION OF TRAPS, ETC., SHALL BE MADE WITH PERMANENT METAL OR PLASTIC FORMS, PERMANENT FORMS MUST BE OF A SIZE AND DEPTH THAT WILL ELIMINATE THE DISTURBANCE OF SOIL AFTER THE INITIAL TREATMENT.

FBC 1816.1.3 8. MINIMUM 6 MIL VAPOR RETARDER MUST BE INSTALLED TO PROTECT AGAINST RAINFALL DILUTION. IF RAINFALL OCCURS BEFORE VAPOR RET-ARDER PLACEMENT, RETREATMENT IS REQUIRED. FBC 1816.1.4

9. CONCRETE OVERPOUR AND MORTAR ALONG THE FOUNDATION PERIMETER MUST BE REMOVED BEFORE EXTERIOR SOIL TREATMENT. FBC 1816.1.5

10. SOIL TREATMENT MUST BE APPLIED UNDER ALL EXTERIOR CONCRETE OR GRADE WITHIN 1'-0" OF THE STRUCTURE SIDEWALLS. FBC 1816.1.6 11. AN EXTERIOR VERTICAL CHEMICAL BARRIER MUST BE INSTALLED AFTER CONSTRUCTION IS COMPLETE INCLUDING LANDSCAPING AND IRRIGATION.

ANY SOIL DISTURBED AFTER THE VERTICAL BARRIER IS APPLIED, SHALL BE RETREATED. FBC 1816.1.6 12. ALL BUILDINGS ARE REQUIRED TO HAVE PER-CONSTRUCTION TREATMENT.

13. A CERTIFICATE OF COMPLIANCE MUST BE ISSUED TO THE BUILDING DEPART-MENT BY # LICENSED PEST CONTROL COMPANY BEFORE A CERTIFICATE OF OCCUPANCY WILL BE ISSUED. THE CERTIFICATE OF COMPLIANCE SHALL STATE: "THE BUILDING HAS RECEIVED A COMPLETE TREATMENT FOR THE PREVENTION OF SUBTERRANEAN TERMITES. THE TREATMENT IS IN ACCORDANCE WITH THE RULES AND LAWS OF THE FLORIDA DEPARTMENT OF AGRICULTURE AND CONS-UMER SERVICES". FBC 1816.1.7

14. AFTER ALL WORK IS COMPLETED, LOOSE WOOD AND FILL MUST BE REMOVED FROM BELOW AND WITHIN 1'-0" OF THE BUILDING. THIS INCLUDES ALL GRADE STAKES, TUB TRAP BOXES, FORMS, SHORING OR OTHER CELLULOSE CONTAINING MATERIAL. FBC 2303.1.3

15. NO WOOD, VEGETATION, STUMPS, CARDBOARD, TRASH, ETC., SHALL BE BURIED WITHIN 15'-0" OF ANY BUILDING OR PROPOSED BUILDING. FBC 2303.1.4

### FRAMING ANCHOR SCHEDULE

CAP. MANUF'R/MODEL APPLICATION 1410# TRUSS TO WALL: "SIMPSON" HETEL 16 W/ TSS

1700# PORCH BEAM TO POST (4x 4): SIMPSON PC44/EPC44 1700# PORCH BEAM TO POST (6x 6): SIMPSON PC66/EPC66 2200# PORCH POST TO FND.: SIMPSON ABU44 or ABU 66 315#/240# MISC. JOINTS SIMPSON A34

ALL ANCHORS SHALL BE SECURED W/ NAILS AS PRESCRIBED BY THE MANUFACTURER FOR MAXIMUM JOINT STRENGTH, UNLESS NOTED OTHERWISE.

NOTE: REFER TO THE INCLUDED STRUCTURAL DETAILS FOR ADDITIONAL ANCHORS/ JOINT REINFORCEMENT AND FASTENERS.

ALL UNLISTED JOINTS IN THE LOAD PATH SHALL BE REINFORCED WITH SIMPSON A34 FRAMING ANCHORS, TYPICAL T.O.


"SEMCO" PRODUCT APPROVAL:

MIAMI/DADE COUNTY REPORT #95-0818.15

"SIMPSON" PRODUCT APPROVALS:

MIAMI/DADE COUNTY REPORT #97-0107.05, #96-1126.11, #99-0623.04

SBCC1 NER-443, NER-393

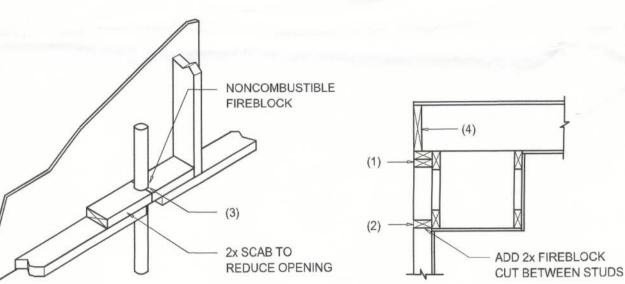

## FIREBLOCKING NOTES:

PENETRATIONS

FIREBLOCKING SHALL BE INSTALLED IN WOOD FRAME CONSTRUCTION IN THE FOLLOWING LOCATIONS:

1. IN CONCEALED SPACES OF STUD WALLS AND PARTITIONS INCLUDING FURRED SPACES AT CEILING AND FLOOR LEVELS.

2. AT ALL INTERCONNECTIONS BETWEEN CONCEALED VERTICAL AND HORIZONTAL SPACES SUCH AS OCCUR AT SOFFITS, DROP CEILINGS, COVE CEILINGS, ETC.

3. AT OPENINGS AROUND VENTS, PIPES, DUCTS, CHIMNEYS AND FIREPLACES AT

CEILING AND FLOOR LEVELS WITH "PYROPANEL MULTIFLEX SEALANT"

4. AT ALL INTERCONNECTIONS BETWEEN CONCEALED VERTICAL STUD WALL OR PARTITION SPACES AND CONCEALED SPACES CREATED BY AN ASSEMBLY OF FLOOR JOISTS, FIREBLOCKING SHALL BE PROVIDED FOR THE FULL DEPTH OF THE JOISTS AT THE ENDS AND OVER THE SUPPORTS.

Fire Stopping DETAILS

SCALE: NONE



SOFFIT/DROPPED CLG.

4		27	BUILDING MEAN BUIL		6 & CLADDING T = 30.0', EXF	71 - 15 5 5 5 5 5 5 5 5 5 5 5 5 5 5 5 5 5
	ZONE	AREA	Yult 110 MPH	Yult 120 MPH	Yult 130 MPH	Yult 140 MPH
2T	1 1	10 20 50	12.0 / -19.9 11.4 / -19.4 10.0 / -18.6	14.9 / -23.7 13.6 / -23.0 11.9 / -22.2	17.5 / -27.8 16.0 / -27.0 13.9 / -26.0	20.3 / -32.3 18.5 / -31.4 16.1 / -30.2
T 10	2 2 2	10 20 50	12.5 / -34.7 11.4 / -31.9 10.0 / -28.2	14.9 / -41.3 13.6 / -38.0 11.9 / -33.6	17.5 / -48.4 16.0 / -44.6 13.9 / -39.4	20.3 / -56.2 18.5 / -51.7 16.1 / -45.7
ROOF	3 3 3	10 20 50	12.5 / -51.3 11.4 /-47.9 10.0 / -43.5	14.9 / -61.0 13.6 / -57.1 11.9 / -51.8	17.5 / -71.6 16.0 / -67.0 13.9 / -60.8	20.3 / -83.1 18.5 / -77.7 16.1 / -70.5
4	4 4 4	10 20 50	21.8 / -23.6 20.8 / -22.6 19.5 / -21.3	25.9 / -34.7 24.7 / -26.9 23.2 / -25.4	30.4 / -33.0 29.0 / -31.6 27.2 / -29.8	35.3 / -38.2 33.7 / -36.7 31.6 / -34.6
MALL	5 5 5	10 20 50	21.8 / -29.1 20.8 / -27.2 19.5 / -24.6	25.9 / -34.7 24.7 / -32.4 23.2 / -29.3	30.4 /-40.7 29.0 / -38.0 27.2 / -34.3	35.3 / -47.2 33.7 / -44.0 31.6 / -39.8

	EXPOSURE ALL LDING COMPO		Oxens of the Control
BLDG HEIGHT	EXPOSURE	EXPOSURE "C"	EXPOSURE
15 20	1.00	1.21	1.47
25 3 <i>O</i>	1.00	1.35	1.61

1			MEAN BUI		6	
	ZONE	AREA	Vult 110 MPH	Vult 120 MPH	Vult 130 MPH	Vult 140 MPH
45,	1 1 1	10 20 50	19.9 / -21.8 19.4 / -20.7 18.6 / -19.2	23.7 / -25.9 23.0 / -24.6 22.2 / -22.8	27.8 / -30.4 27.0 / -28.9 26.0 / -26.8	32.3 / -35.3 31.4 / -33.5 30.2 / -31.1
F 2T TO	2 2 2	10 20 50	19.9 / -25.5 19.4 / -24.3 18.6 / -22.9	23.7 / -30.3 23.0 / -29.0 22.2 / -27.2	27.8 / -35.6 27.0 / -34.0 26.0 / -32.0	32.3 / -41.2 31.4 / -39.4 30.2 / -37.1
ROOF	3 3 3	10 20 50	19.9 / -25.5 19.4 / -24.3 18.6 / -22.9	23.7 / -30.3 23.0 / -29.0 22.2 / -27.2	27.8 / -35.6 27.0 / -34.0 26.0 / -32.0	32.3 / -41.2 31.4 / -39.4 30.2 / -37.1
1,	4 4 4	10 20 50	21.8 / -23.6 20.8 / -22.6 19.5 / -21.3	25.9 / -34.7 24.7 / -26.9 23.2 / -25.4	30.4 / -33.0 29.0 / -31.6 27.2 / -29.8	35.3 / -38.2 33.7 / -36.7 31.6 / -34.6
MALL	555	10 20 50	21.8 / -29.1 20.8 / -27.2 19.5 / -24.6	25.9 / -34.7 24.7 / -32.4 23.2 / -29.3	30.4 /-40.7 29.0 / -38.0 27.2 / -34.3	35.3 / -47.2 33.7 / -44. <i>C</i> 31.6 / -39.8

	EXPOSURE AL	Control MacCodin Control Control Control	Commence Charles of Sampling Carriery
BLDG HEIGHT	EXPOSURE	EXPOSURE	EXPOSURE

BLDG HEIGHT	EXPOSURE "B"	EXPOSURE	EXPOSURE
15	1.00	1.21	1.47
20	1.00	1,29	1.55
25	1.00	1.35	1.61
30	1.00	1.40	1.66

## General Roofing NOTES:

#### DECK REQUIREMENTS:

ASPHALT SHINGLES SHALL BE FASTENED TO SOLIDLY SHEATHED DECKS.

## SLOPE:

ASPHALT SHINGLES SHALL BE USED ONLY ON ROOF SLOPES OF 2:12 OR GREATER. FOR ROOF SLOPES FROM 2:12 TO 4:12, DBL. UNDERLAYMENT IS REQUIRED.

UNLESS OTHERWISE NOTED, UNDERLAYMENT SHALL CONFORM W/ ASTM D 226, TYPE 1, OR ASTM D 4869, TYPE 1.

#### SELF-ADHERING POLYMER MODIFIED BITUMEN SHEET: SELF ADHERING POLYMER MODIFIED BITUMEN SHALL COMPLY W/ ASTM D 1970.

ASPHALT SHINGLES:

ASPHALT SHINGLES SHALL HAVE SELF SEAL STRIPS OR BE INTERLOCKING. AND COMPLY WITH ASTM D 225 OR ASTM D 3462.

FASTENERS FOR ASPHALT SHINGLES SHALL BE GALVANIZED, STAINLESS STEEL, ALUMINUM OR COPPER ROOFING NAILS, MINIMUM 12 GAUGE SHANK WITH A MINIMUM 3/8 INCH DIAMETER HEAD, OF A LENGTH TO PENETRATE THROUGH THE ROOFING MATERIAL AND A MINIMUM 3/4" INTO THE ROOF SHEATHING. WHERE THE SHEATHING IS LESS THAN 3/4" THICK, THE NAILS SHALL PENETRATE THROUGH THE SHEATHING.

ASPHALT SHINGLES SHALL BE SECURED TO THE ROOF WITH NOT LESS THAN FOUR FASTENERS PER STRIP SHINGLE OR TWO FASTENERS PER INDIVIDUAL SHINGLE. WHERE ROOFS LOCATED IN BASIC WIND SPEED OF 110 MPH OR GREATER, SPECIAL METHODS OF FASTENING ARE REQUIRED. UNLESS OTHERWISE NOTED, ATTACHMENT OF ASPHALT SHINGLES SHALL CONFORM WITH ASTM D 3161 OR M-DC PA 107-95.

#### UNDERLAYMENT APPLICATION:

STAY IN PLACE.

FOR ROOF SLOPES FORM 2:12 TO 4:12, UNDERLAYMENT SHALL BE A MINIMUM OF TWO LAYERS APPLIED AS FOLLOWS: 1. STARTING AT THE EAVE, A 19 INCH STRIP OF UNDERLAYMENT SHALL BE APPLIED PARALLEL WITH THE EAVE AND FASTENED SUFFICIENTLY TO

2. STARTING AT THE EAVE, 36 INCH WIDE STRIPS OF UNDERLAYMENT FELT SHALL BE APPLIED OVERLAPPING SUCCESSIVE SHEETS 19 INCHES AND

FOR ROOF SLOPED 4:12 AND GREATER, UNDERLAYMENT SHALL BE A MINIMUM OF ONE LAYER OF UNDERLAYMENT FELT APPLIED AS FOLLOWS: STARTING AT THE EAVE, UNDERLAYMENT SHALL BE APPLIED SHINGLE FASHION PARALLEL TO THE EAVE, LAPPED 2 INCHES, AND FASTENED SUFFICIENTLY TO STAY IN PLACE.

## BASE AND CAP FLASHINGS:

IN FBC TABLE 1507.3.9.2.

FASTENED SUFFICIENTLY TO STAY IN PLACE.

BASE AND CAP FLASHING SHALL BE INSTALLED IN ACCORDANCE W/ MFGR'S INSTALLATION INSTRUCTIONS. BASE FLASHING SHALL BE OF EITHER CORROSION RESISTANT METAL OF MINIMUM NOMINAL THICKNESS 0.019 INCH OR MINERAL SURFACE ROLL ROOFING WEIGHING A MINIMUM OF 77 LBS PER 100 SQUARE FEET. CAP FLASHING SHALL BE CORROSION RESISTANT METAL OF MINIMUM NOMINAL THICKNESS OF 0.019 INCH.

## VALLEYS:

VALLEY LININGS SHALL BE INSTALLED IN ACCORDANCE W/ MANUFACTURER'S INSTALLATION INSTRUCTIONS BEFORE APPLYING ASPHALT SHINGLES. VALLEY LININGS OF THE FOLLOWING TYPES SHALL BE PERMITTED. 1. FOR OPEN VALLEYS LINED WITH METAL, THE VALLEY LINING SHALL BE AT LEAST 16" WIDE AND OF ANY OF THE CORROSION RESISTANT METALS

2. FOR OPEN VALLEYS, VALLEY LINING OF TWO PLIES OF MINERAL SURFACE ROLL ROOFING SHALL BE PERMITTED. THE BOTTOM LAYER SHALL BE 18 INCHES AND THE TOP LAYER A MINIMUM OF 36 INCHES WIDE.

3. FOR CLOSED VALLEYS VALLEY LINING SHALL BE ONE OF THE FOLLOWING: 1. BOTH TYPES 1 AND 2 ABOVE, COMBINED. 2. ONE PLY OF SMOOTH ROLL ROOFING AT LEAST 36 INCHES WIDE AND COMPLYING WITH ASTM D 224.

3. SPECIALTY UNDERLAYMENT AT LEAST 36 INCHES WIDE AND COMPLYING WITH ASTM D 1970.

ROOFSHINGLES SHALL BE AS MANUFACTURED BY "TAMKO ROOFING PRODUCTS" OF THE FOLLOWING MODELS:

GLASS-SEAL AR ELITE GLASS-SEAL AR HERITAGE 30 AR HERITAGE 40 AR HERITAGE 50 AR

THESE SHINGLES MEET THE REQUIREMENTS OF ASTM D-3161 TYPE 1 MODIFIED TO 110 MPH WINDS & FBC TAS 100, USING 4 NAILS/SHINGLE

2 7 600

SOFTPLAN





JOB NUMBER 20250121

SHEET NUMBER

OF 4 SHEETS



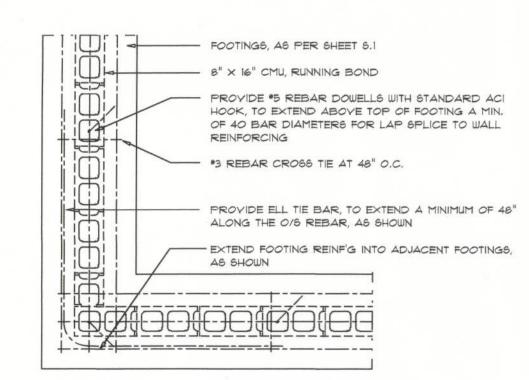

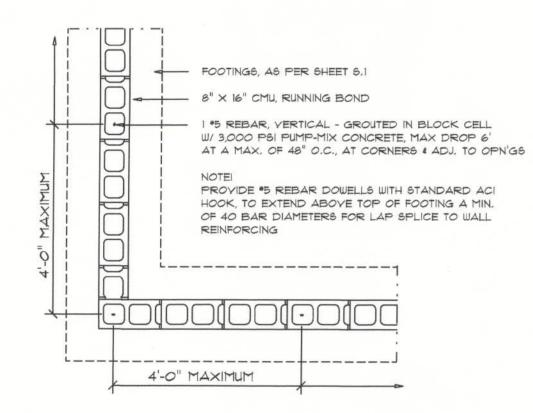

# Wall/Foundation Reinf'g DETAIL

SCALE: 1/2" = 1'-0"

# TERMITE PROTECTION NOTES:

#### SOIL CHEMICAL BARRIER METHOD:

I. A PERMANENT SIGN WHICH IDENTIFIES THE TERMITE TREATMENT PROVIDER AND NEED FOR REINSPECTION AND TREATMENT CONTRACT RENEWAL SHALL BE PROVIDED. THE SIGN SHALL BE POSTED NEAR THE WATER HEATER OR ELECTRIC PANEL. FBC 104.2.6

AWAY FROM BUILDING SIDE WALLS, FBC 1503.4.4 3. IRRIGATION/SPRINKLER SYSTEMS INCLUDING ALL RISERS AND SPRAY

HEADS SHALL NOT BE INSTALLED WITHIN 1'-0" FROM BUILDING SIDE WALLS. FBC 1503.4.4

THICK ADHERED DIRECTLY TO THE FOUNDATION WALL. FBC 1403.1.6

BACKFILL IS COMPLETE. FBC 1816.1.1 6. SOIL DISTURBED AFTER THE INITIAL TREATMENT SHALL BE RETREATED

7. BOXED AREAS IN CONCRETE FLOOR FOR SUBSEQUENT INSTALLATION OF TRAPS, ETC., SHALL BE MADE WITH PERMIANENT METAL OR PLASTIC FORMS, PERMANENT FORMS MUST BE OF A SIZE AND DEPTH THAT WILL ELIMINATE THE DISTURBANCE OF SOIL AFTER THE INITIAL TREATMENT.

8. MINIMUM 6 MIL VAPOR RETARDER MUST BE INSTALLED TO PROTECT AGAINST RAINFALL DILUTION, IF RAINFALL OCCURS BEFORE YAPOR RET-ARDER PLACEMENT, RETREATMENT IS REQUIRED. FBC 1816.1.4

OR GRADE WITHIN 1'-O" OF THE STRUCTURE SIIDEWALLS. FBC 1816.1.6

11. AN EXTERIOR YERTICAL CHEMICAL BARRIER MUST BE INSTALLED AFTER CONSTRUCTION IS COMPLETE INCLUDING LANDSCAPING AND IRRIGATION. ANY SOIL DISTURBED AFTER THE VERTICAL BARRIER IS APPLIED, SHALL BE RETREATED. FBC 1816.1.6

12. ALL BUILDINGS ARE REQUIRED TO HAVE PER-CONSTRUCTION TREATMENT.

MENT BY \* LICENSED PEST CONTROL COMP, ANY BEFORE A CERTIFICATE OF OCCUPANCY WILL BE ISSUED, THE CERTIFICATE OF COMPLIANCE SHALL STATE: "THE BUILDING HAS RECEIVED A COMPLETE TREATMENT FOR THE PREVENTION OF SUBTERRANEAN TERMITES, THE TREATMENT IS IN ACCORDANCE WITH THE RULES AND LAWS OF THE FLORIDA DEPARTMENT OF AGRICULTURE AND CONS-UMER SERVICES". FBC 1816.1.7

FROM BELOW AND WITHIN 1'-O" OF THE BUILDING, THIS INCLUDES ALL GRADE STAKES, TUB TRAP BOXES, FORMS, SHORING OR OTHER CELLULOSE CONTAINING MATERIAL. FBC 2303.1.3

15. NO WOOD, YEGETATION, STUMPS, CARDBOYARD, TRASH, ETC., SHALL BE BURIED WITHIN 15'-O" OF ANY BUILDING OR PROPOSED BUILDING. FBC 2303.1.4

# WOOD STRUCTURAL NOTES

TEMPORARY BRACING OF THE STRUCTURE DURING ERECTION, REQUIRED FOR SAFE AND STABLE CONSTRUCTION, SHALL BE THE SOLE RESPON-SIBILITY OF THE CONTRACTOR SO ENGAGED, TEMPORARY & PERMANENT BRACING OF ROOF TRUSSES SHALL BE ALS PER THE STANDARD GUIDE-LINES OF THE "TRUSS PLATE INSTITUTE",

2. ALL TRUSSES SHALL BE DESIGNED BY A LICENSED PROFESSIONAL ENGINEER & SHALL BE SIGNED AND SEALIED BY SAME, TRUSS DESIGN SHALL INCLUDE PLACEMENT PLANS, TRUSS DETAILS, TRUSS TO TRUSS CONNECTIONS & THE STANDARD SPECIFIC; ATIONS & RECOMMENDATIONS OF INSTALLATION OF THE "TRUSS PLATE INSTITUTE".

SIMPSON STRONG TIE

Truss Anchor

CONCRETE / MASONRY /

METALS GENERAL NOTES

THE SUB-GRADE TO SUPPORT THE DESIGN LOADS.

2. EXPANSIVE SOILS: WHERE DIRECTED BY THE SOILS ENGINEER, SOIL

3. CLEAN SAND FILL OVER STRIPPED AND COMPACTED EXISTING GD.

SHALL BE PLACED IN 12" LIFTS, BOTH SUB-SOIL AND FILL COMPAC-

TION SHALL BE NOT LESS THAN 98% AS MEASURED BY A MODIFIED

PROCTOR TEST AT THE RATE OF ONE TEST FOR EACH 1500 SF OF

BUILDING PAD AREA, OR FRACTION THEREOF, FOR EACH 12" LIFT.

4. REINFORCING STEEL SHALL BE GRADE 60 AND MEET THE REQUIRE-MENTS OF ASTM A615, ALL BENDS SHALL BE MADE COLD.

5. WELDED WIRE MESH SLAB REINFORCING SHALL MEET THE REQUIRE-

6. CONCRETE SHALL BE STANDARD MIX F'c = 3000 PSI FOR ALL FTGS,

MENT. MIXING, PLACING AND FINISHING SHALL BE AS PER ACI

1. CONCRETE BLOCK SHALL BE AS PER MANUFACTURER'S PRODUCT

8. MORTAR SHALL BE TYPE "M" OR "N" FOR ALL MASONRY UNITS.

PLAN REQUIREMENTS.

FOR STRUCTURAL STEEL APPLICATIONS.

GUIDE FOR ASTM C-90 REQUIREMENTS WITH MEDIUM SURFACE FINISH -

9. STRUCTURAL STEEL SHALL CONFORM TO ASTM A36 STANDARDS FOR

10. WELDS SHALL BE AS PER "AMERICAN WELDING SOCIETY" STANDARDS

STRENGTH, BOLTS SHALL BE ASTM A307 / GRADE I OR A325, AS PER

SLABS, COLUMNS AND BEAMS OR SHALL BE STANDARD PUMP MIX F'c = 3000 PSI, STRENGTH SHALL BE ATTAINED WITHIN 28 DAYS OF PLACE-

MENTS OF ASTM A185 - MIN, YEILD STRESS = 85 KSI,

AUGMENTATION PER THE SOILS ENGINEER'S SPECIFICATIONS SHALL

BE IMPLEMENTED PRIOR TO PLACING ANY FOUNDATIONS - TESTS AS

SPECIFIED SHALL BE PREFORMED TO DETERMINE THE SUITABILITY OF

1. IDESIGN SOIL BEARING PRESSURE: 1,000 PSF.

DETAIL

SCALE: 1/2" = 1'-0"

HETAL 16 W/ GALY'D TRUSS SEAT

E

3. WOOD STUDS IN EXTERIOR WALLS & INTER! OR BEARING WALLS SHALL BE NOT LESS THAN Nr.2 HEM-FIR OR BETTIER,

4. CONNECTORS FOR WOOD FRAMING SHALL BE GALYANIZED METAL OR BLACK METAL AS MANUFACTURED OR AS CALLED FOR IN THE PLANS AND BE OF A DESIGN SUITABLE FOR THE LOADS AND USE INTENDED. REFER TO THE JOINT REINFORCEMENT SCHEDULE FOR PRINCIPLE CON-NECTIONS.

				ENTS & CLADE GHT = 30.0', E.		
	ZONE	AREA	Vult 110 MPH	Vult 120 MPH	Vult 130 MPH	Vult 140 MPH
ROOF 7^ TO 27^	1 1 1	10 20 50	12.0 / -19.9 11.4 / -19.4 10.0 / -18.6	14.9 / -23.7 13.6 / -23.0 11.9 / -22.2	17.5 / -27.8 16.0 / -27.0 13.9 / -26.0	20.3 / -32.3 18.5 / -31.4 16.1 / -30.2
	2 2 2	10 20 50	12.5 / -34.7 11.4 / -31.9 10.0 / -28.2	14.9 / -41.3 13.6 / -38.0 11.9 / -33.6	17.5 / -48.4 16.0 / -44.6 13.9 / -39.4	20.3 / -56.2 18.5 / -51.7 16.1 / -45.7
	3 3	10 20 50	12.5 / -51.3 11.4 /-47.9 10.0 / -43.5	14.9 / -61.0 13.6 / -57.1 11.9 / -51.8	17.5 / -71.6 16.0 / -67.0 13.9 / -60.8	20.3 / -83.1 18.5 / -77.7 16.1 / -70.5
WALL	4 4 4	10 20 50	21.8 / -23.6 20.8 / -22.6 19.5 / -21.3	25.9 / -34.7 24.7 / -26.9 23.2 / -25.4	30.4 / -33.0 29.0 / -31.6 27.2 / -29.8	35.3 / -38.2 33.7 / -36.7 31.6 / -34.6
	5 5 5	10 20 50	21.8 / -29.1 20.8 / -27.2 19.5 / -24.6	25.9 / -34.7 24.7 / -32.4 23.2 / -29.3	30.4 /-40.7 29.0 / -38.0 27.2 / -34.3	35.3 / -47.2 33.7 / -44.0 31.6 / -39.8

#### CANTILEVER 2. CONDENSATE AND ROOF DOWNSPOUTS SHALL DISCHARGE AT LEAST I'-O" "E" BAR (END) "E" BAR TOP BAR TOP BAR

1111

SCALE: NONE

NAILING SHEATHING

TYPE

7/16 " O.S.B.

OR 19/32 CDX

L #3 STIRRUPS

OR \*3 HOOPS

SPACED FROM

SUPPORT FACE

AS SCHEDULED

4. TO PROVIDE FOR INSPECTION FOR TERMITTE INFESTATION, BETWEEN WALL COYERINGS AND FINAL EARTH GRADE SHALL NOT BE LESS THAN 6", EXCEPTION: PAINT AND DECORATIVE CEMEINTIOUS FINISH LESS THAN 5/8"

5. INITIAL TREATMENT SHALL BE DONE AFTER ALL EXCAYATION AND

INCLUDING 6PACES BOXED OR FORMED. FBC 1816.1.2

9, CONCRETE OVERPOUR AND MORTAR ALONG THE FOUNDATION PERIMETER MUST BE REMOVED BEFORE EXTERIOR SOIL TREATMENT. FBC 1816.1.5 10. SOIL TREATMENT MUST BE APPLIED UNDER ALL EXTERIOR CONCRETE

13. A CERTIFICATE OF COMPLIANCE MUST BE 166UED TO THE BUILDING DEPART-

14. AFTER ALL WORK IS COMPLETED, LOOSE WOOD AND FILL MUST BE REMOVED

# ROOF SHEATHING FASTENINGS

BOTTOM BARS - TOP BARS - "E" BARS

BENDING DIA .: CAST-IN-PLACE

CONCRETE BEAMS & SLABS

### GENERAL BEAM SCHEDULE NOTE:

- 1. SCHEDULED HOOPS OR STIRRUPS SHALL BE PLACED AT EACH END OF BEAM UNLESS NOTED OTHERWISE. STIRRUPS SHALL BE TYPE 5-6 4 HOOPS SHALLBE TYPE T-2 TYPICAL CRSI BAR BENDS UNLESS NOTED OTHERWISE.
- 2. BUNDLE ALL STRUCTURAL BEAM TOP BARS IN PAIRS OVER SUPPORTS WITH TOP BARS FROM ADJACENT BEAMS.
- 3. ALL CONCRETE BEAMS OTHER THAN THOSE WITH THE PREFIX TB SHALL BE POURED PRIOR TO PLACING OF BLOCK BELOW.
- 4. ALL TIE BEAM REINFORCING SHALL BE CONTINUOUS THROUGH TIE BEAMS ONLY, ALL SPLICES SHALL BE A MINIMUM OF 30 BAR DIAMETERS,
- 5. ALL TIE BEAM TOP REINFORCING SHALL EXTEND INTO SPAN OF ANY ADJACENT STRUCTURAL BEAM AS PER BENDING DIAGRAM.
- 6. DROP BOTTOM OF TIE BEAMS AS REQUIRED AT WINDOW AND DOOR HEADS (28" MAXIMUM) AND ADD 2 \*5 BOTTOM IF DROP EXCEEDS 8".
- 1. TIE BEAM SCHEDULED DEPTHS ARE MINIMUM AND MAY BE INCREASED (8" MAXIMUM) TO FIT BLOCK WORK.
- 8. ALL ADDED LONGITUDINAL BEAM REINFORCING SHALL EXTEND A MINIMUM OF 6" INTO SUPPORT UNLESS NOTED OTHERWISE.
- 9. MARK "C" IN REINFORCING COLUMN BETWEEN TWO BEAMS INDICATES THAT REINFORCING SHALL BE CONTINUOUS THROUGH THESE TWO BEAMS.


HEIGHT 8 FOR BUIL	EXPOSURE AD DING COMPONE	JUSTMENT COE	EFFICIENTS NG
BLDG HEIGHT	EXPOSURE "B"	EXPOSURE "C"	EXPOSURE
15	1.00	1.21	1.47

1.35 1.40

1.61

1.66

1.00

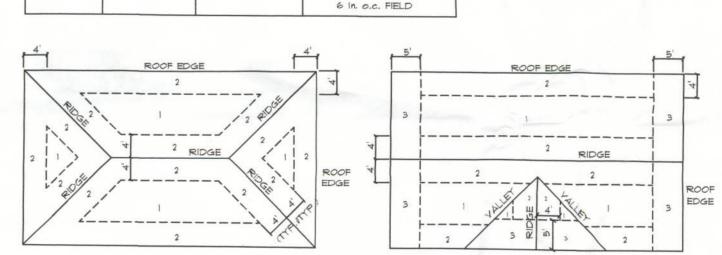

SPACING

12 in. o.c. FIELD

6 In. o.c. EDGE

6 In. o.c. FIELD

OR GABLE TRUSS

6 In. o.c. EDGE

n. o.c. . GABLE ENDWAL

- BOTT, BAR

ROOF SHEATHING NAILING ZONES (HIP ROOF)

ROOF SHEATHING NAILING ZONES (GABLE ROOF)

B

- BOTT, BAR

#3 HOOPS OR

SPACED FROM


SUPPORT FACE

AS SCHEDULED

#3 STIRRUPS



SCALE: NONE

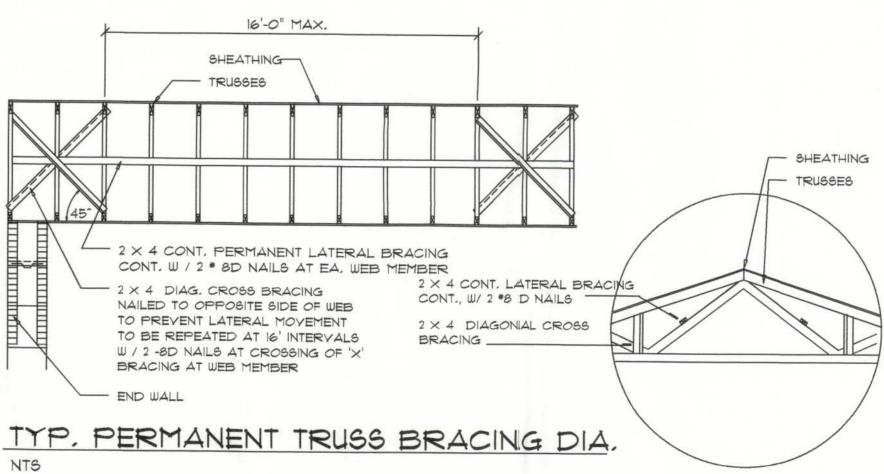

NOTE: ALL WOOD TO BE NUMBER 2 GRADE SOUTHERN YELLOW PINE

Truss Bracing DETAILS

SCALE: AS NOTED



JOB NUMBER

NOTE: ALL DRAWINGS NOT TO BE SCALED, WRITTEN DIMENSIONS TAKE PRECEDENCE OVER SCALED DIMENSIONS

SOFTPLAN

20250121

SHEET NUMBER OF 4 SHEETS