

# PERMIT WORKSHEET

page 1 of 2




## PERMIT NUMBER

Installer Brent Strickland License # IH 1104218  
 Installer Mobile Phone # 386-365-7043  
 Address of home being installed 289 NW ADRIENNE GLEN  
LAKE CITY, FL 32055  
 Manufacturer Live Oak Length x width 80 x 32 w/ tag

NOTE: if home is a single wide fill out one half of the blocking plan  
 if home is a triple or quad wide sketch in remainder of home

I understand Lateral Arm Systems cannot be used on any home (new or used)  
 where the sidewall ties exceed 5 ft 4 in.

Installer's initials B.S.

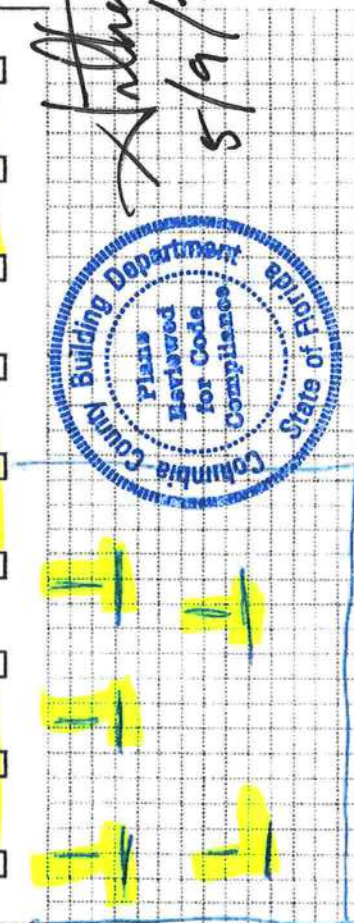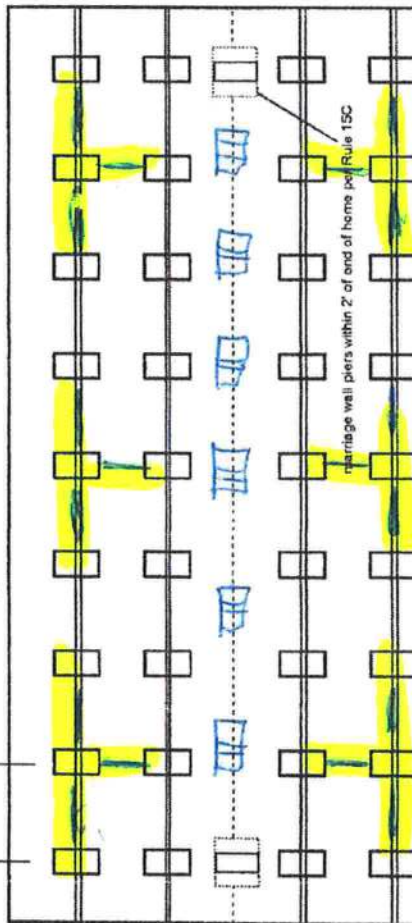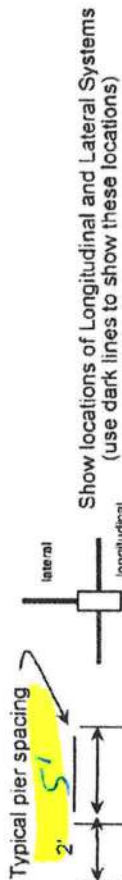

New Home ☒ Used Home ☐

Home installed to the Manufacturer's Installation Manual ☒

Home is installed in accordance with Rule 15-C ☐

Single wide ☐ Wind Zone II ☒ Wind Zone III ☐

Double wide ☐ Installation Decal # 86628

Triple/Quad ☒ Serial # LO16A1002574BCL

Roof System: ☒ Typical ☐ Hinged

## PIER SPACING TABLE FOR USED HOMES

| Load bearing capacity | Footer size (sq in) | 16" x 16" (256) | 18 1/2" x 18 1/2" (342) | 20" x 20" (400) | 22" x 22" (484)* | 24" x 24" (576)* | 26" x 26" (676) |
|-----------------------|---------------------|-----------------|-------------------------|-----------------|------------------|------------------|-----------------|
| 1000 psf              | 3'                  | 4'              | 5'                      | 6'              | 7'               | 8'               | 8'              |
| 1500 psf              | 4'                  | 6'              | 7'                      | 8'              | 9'               | 10'              | 11'             |
| 2000 psf              | 6'                  | 8'              | 9'                      | 10'             | 11'              | 12'              | 13'             |
| 2500 psf              | 7'                  | 9'              | 10'                     | 11'             | 12'              | 13'              | 14'             |
| 3000 psf              | 8'                  | 10'             | 11'                     | 12'             | 13'              | 14'              | 15'             |
| 3500 psf              | 8'                  | 10'             | 11'                     | 12'             | 13'              | 14'              | 15'             |

\* interpolated from Rule 15C-1 pier spacing table.

## PIER PAD SIZES

I-beam pier pad size 17x25

Perimeter pier pad size 16x16

Other pier pad sizes (required by the mfg.) 17x25

Draw the approximate locations of marriage wall openings 4 foot or greater. Use this symbol to show the piers.

List all marriage wall openings greater than 4 foot and their pier pad sizes below.

Opening Pier pad size

## ANCHORS

4 ft ☒ 5 ft ☐

## FRAME TIES

within 2' of end of home spaced at 5' 4" oc ☒

## OTHER TIES

Number  
 Sidewall 26  
 Longitudinal 6  
 Marriage wall 4  
 Shearwall 4

## TIEDOWN COMPONENTS

Longitudinal Stabilizing Device (LSD)  
 Manufacturer Oliver H01V  
 Longitudinal Stabilizing Device w/ Lateral Arms

# PERMIT NUMBER

## POCKET PENETROMETER TEST

The pocket penetrometer tests are rounded down to 1000 psf or check here to declare 1000 lb. soil without testing.

x 1000 x 1000 x 1000

## POCKET PENETROMETER TESTING METHOD

1. Test the perimeter of the home at 6 locations.
2. Take the reading at the depth of the footer.
3. Using 500 lb. increments, take the lowest reading and round down to that increment.

x 1000 x 1000 x 1000

## TORQUE PROBE TEST

The results of the torque probe test is 290 inch pounds or check here if you are declaring 5' anchors without testing \_\_\_\_\_. A test showing 275 inch pounds or less will require 5 foot anchors.

Note: A state approved lateral arm system is being used and 4 ft. anchors are allowed at the sidewall locations. I understand 5 ft. anchors are required at all centerline tie points where the torque test reading is 275 or less and where the mobile home manufacturer may requires anchors with 4000 lb holding capacity.

Installer's initials B.S.

## ALL TESTS MUST BE PERFORMED BY A LICENSED INSTALLER

Installer Name Grant Strickland

Date Tested 3-5-22

## Electrical

Connect electrical conductors between multi-wide units, but not to the main power source. This includes the bonding wire between multi-wide units. Pg. 24

## Plumbing

Connect all sewer drains to an existing sewer tap or septic tank. Pg. 28

Connect all potable water supply piping to an existing water meter, water tap, or other independent water supply systems. Pg. 29

## Site Preparation

Debris and organic material removed ✓  
Water drainage: Natural ✓ Swale ✓ Pad ✓ Other ✓

## Fastening multi wide units

Floor: Lags Type Fastener: 5" Length: 5" Spacing: 16"  
Walls: 4x4s Type Fastener: 4" Length: 4" Spacing: 16"  
Roof: lags Type Fastener: 6" Length: 6" Spacing: 16"  
For used homes a min. 30 gauge, 8" wide, galvanized metal strip will be centered over the peak of the roof and fastened with galv. roofing nails at 2" on center on both sides of the centerline.

## Gasket (weather/roofing requirement)

I understand a properly installed gasket is a requirement of all new and used homes and that condensation, mold, mildew and buckled marriage walls are a result of a poorly installed or no gasket being installed. I understand a strip of tape will not serve as a gasket.

Installer's initials B.S.

Type gasket Foam

Installed: Between Floors Yes ✓

Between Walls Yes ✓

Bottom of ridgebeam Yes ✓

## Weatherproofing

The bottomboard will be repaired and/or taped. Yes ✓ Pg. \_\_\_\_\_

Siding on units is installed to manufacturer's specifications. Yes ✓ Pg. \_\_\_\_\_

Fireplace chimney installed so as not to allow intrusion of rain water. Yes ✓

## Miscellaneous

Skirting to be installed. Yes ✓ No \_\_\_\_\_

Dryer vent installed outside of skirting. Yes ✓ N/A ✓

Range downflow vent installed outside of skirting. Yes ✓ N/A ✓

Drain lines supported at 4 foot intervals. Yes ✓

Electrical crossovers protected. Yes ✓

Other: \_\_\_\_\_

Installer verifies all information given with this permit worksheet is accurate and true based on the manufacturer's installation instructions and or Rule 15C-1 & 2

Installer Signature B.S. Date 3-5-22



**Live Oak Homes**  
**MODEL: P-7764A - 32 X 80 w/TAG**  
**4-BEDROOM / 2-BATH**

