



## Mobile Home Permit Worksheet

Installer Brent Stickland

License # 1H104218

Address of home  
being installed

Manufacturer \_\_\_\_\_ Length x width 14x66


NOTE:

If home is a single wide fill out one half of the blocking plan

If home is a triple or quad wide sketch in remainder of home

I understand Lateral Arm Systems cannot be used on any home (new or used) where the sidewall ties exceed 5 ft 4 in.

Installer's initials BS

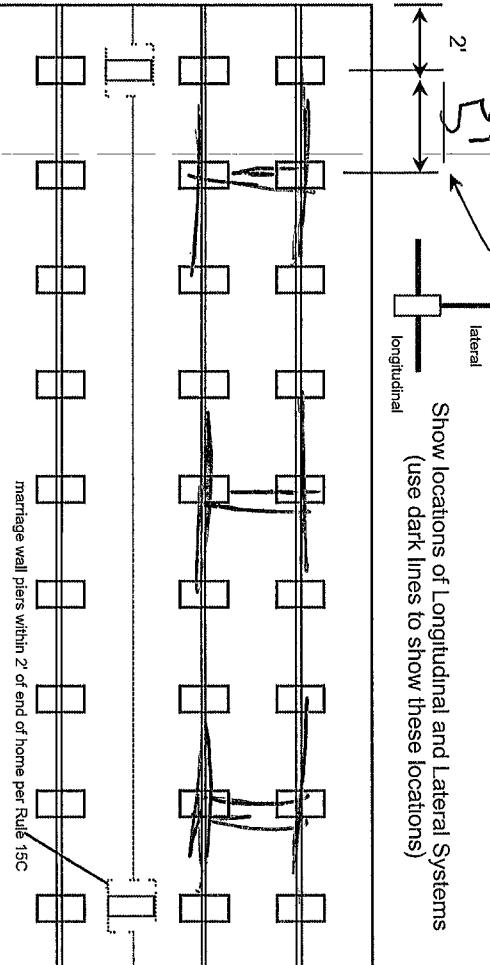

PIER SPACING TABLE FOR USED HOMES						
Load bearing capacity	Footer size (sq in)	16" x 16" (256)	18 1/2" x 18 1/2" (342)	20" x 20" (400)	22" x 22" (484)*	24" X 24" (576)*
1000 psf	3'	4'	5'	6'	7'	8'
1500 psf	4 1/2"	6"	7"	8"	8"	8"
2000 psf	6"	8"	8"	8"	8"	8"
2500 psf	7 1/2"	8"	8"	8"	8"	8"
3000 psf	8"	8"	8"	8"	8"	8"
3500 psf	8"	8"	8"	8"	8"	8"

\*Interpolated from Rule 15C-1 pier spacing table.

### PIER PAD SIZES

I-beam pier pad size 12x25

Perimeter pier pad size 16x16

Other pier pad sizes 16x16  
(required by the mfg.)

Draw the approximate locations of marriage wall openings 4 foot or greater. Use this symbol to show the piers.

List all marriage wall openings greater than 4 foot and their pier pad sizes below.

Opening

Pier pad size



### POPULAR PAD SIZES

Pad Size	Sq In
16x16	256
16x18	288
18.5x18.5	340
16x22.5	360
17x22	374
13 1/2x26 1/4	348
20x20	400
17 3/16x25 3/16	441
17 1/2x25 1/2	446
24x24	576
26x26	676

within 2' of end of home spaced at 5' 4" oc

### ANCHORS

### FRAME TIES

### TIEDOWN COMPONENTS

Longitudinal Stabilizing Device (LSD)

Manufacturer Ornco

Longitudinal Stabilizing Device w/ Lateral Arms

Manufacturer Ornco

Permit Number:  Used Home  Date \_\_\_\_\_

Home installed to the Manufacturer's Installation Manual  
Home is installed in accordance with Rule 15-C

Single wide  Wind Zone II  Wind Zone III

Double wide  Installation Decal # 13295

Triple/Quad  Serial # \_\_\_\_\_



## Mobile Home Permit Worksheet

Permit Number: \_\_\_\_\_

Date: \_\_\_\_\_

### POCKET PENETROMETER TEST

The pocket penetrometer tests are rounded down to \_\_\_\_\_ psf or check here to declare 1000 lb. soil  without testing.

### POCKET PENETROMETER TESTING METHOD

1. Test the perimeter of the home at 6 locations.
2. Take the reading at the depth of the footer.
3. Using 500 lb. increments, take the lowest reading and round down to that increment.

### TORQUE PROBE TEST

The results of the torque probe test is \_\_\_\_\_ inch pounds or check here if you are declaring 5' anchors without testing  275. A test showing 275 inch pounds or less will require 5' anchors.

Note: A state approved lateral arm system is being used and 4 ft. anchors are allowed at the sidewall locations. I understand 5' anchors are required at all centerline tie points where the torque test reading is 275 or less and where the mobile home manufacturer may require anchors with 4000 lb. holding capacity.

Installer's initials BS

### ALL TESTS MUST BE PERFORMED BY A LICENSED INSTALLER

Installer Name Brent Shick

Date Tested 12/12/25

### ELECTRICAL

Connect electrical conductors between multi-wide units, but not to the main power source. This includes the bonding wire between multi-wide units. Pg. \_\_\_\_\_

Installer verifies all information given with this permit worksheet is accurate and true based on the manufacturer's installation instructions and or Rule 15C-1 & 2

Connect all sewer drains to an existing sewer tap or septic tank. Pg. \_\_\_\_\_

Connect all potable water supply piping to an existing water meter, water tap, or other independent water supply systems. Pg. \_\_\_\_\_

### Site Preparation

Debris and organic material removed  \_\_\_\_\_

Water drainage Natural  \_\_\_\_\_ Swale  \_\_\_\_\_ Pad  \_\_\_\_\_ Other  \_\_\_\_\_

### Fastening multi wide units

Floor- Type Fastener: \_\_\_\_\_ Length: \_\_\_\_\_ Spacing:  12

Walls- Type Fastener: \_\_\_\_\_ Length: \_\_\_\_\_ Spacing: \_\_\_\_\_

Roof- Type Fastener: \_\_\_\_\_ Length: \_\_\_\_\_ Spacing: \_\_\_\_\_

For used homes a min. 30 gauge, 8" wide, galvanized metal strip will be centered over the peak of the roof and fastened with galv. roofing nails at 2" on center on both sides of the centerline.

### Gasket (weatherproofing requirement)

I understand a properly installed gasket is a requirement of all new and used homes and that condensation, mold, mildew and buckled marriage walls are a result of a poorly installed or no gasket being installed. I understand a strip of tape will not serve as a gasket.

Installer's initials BS

Type Gasket: \_\_\_\_\_

Installed: \_\_\_\_\_

Between Floors:  Yes  Pg. \_\_\_\_\_

Between Walls:  Yes  Pg. \_\_\_\_\_

Bottom of ridge beam:  Yes  Pg. \_\_\_\_\_

### Weatherproofing

The bottom board will be repaired and/or taped. \_\_\_\_\_ Yes  Pg. \_\_\_\_\_

Siding on units is installed to manufacturer's specifications. \_\_\_\_\_ Yes  Pg. \_\_\_\_\_

Fireplace chimney installed so as not to allow intrusion of rain water. \_\_\_\_\_ Yes  Pg. \_\_\_\_\_

### Miscellaneous

Skirting to be installed. \_\_\_\_\_ Yes  No  N/A

Dryer vent installed outside of skirting. \_\_\_\_\_ Yes  No  N/A

Range downflow vent installed outside of skirting. \_\_\_\_\_ Yes  No  N/A

Drain lines supported at 4' intervals. \_\_\_\_\_ Yes  No  N/A

Electrical crossovers protected. \_\_\_\_\_ Yes  No  N/A

Other: \_\_\_\_\_

Installer's Signature Brent Shick

Date 12/12/25