

Mobile Home Permit Worksheet

Installer: Michael Brannon License # TH/1025396



Address of home being installed 1197 SW Hartford Way
Lake City, FL 32024

Manufacturer Fleetwood Length x width 70 x 14

NOTE: If home is a single wide fill out one half of the blocking plan
if home is a triple or quad wide sketch in remainder of home
I understand Lateral Arm Systems cannot be used on any home (new or used)
where the sidewall ties exceed 5 ft 4 in.

Installer's initials MB

Typical pier spacing

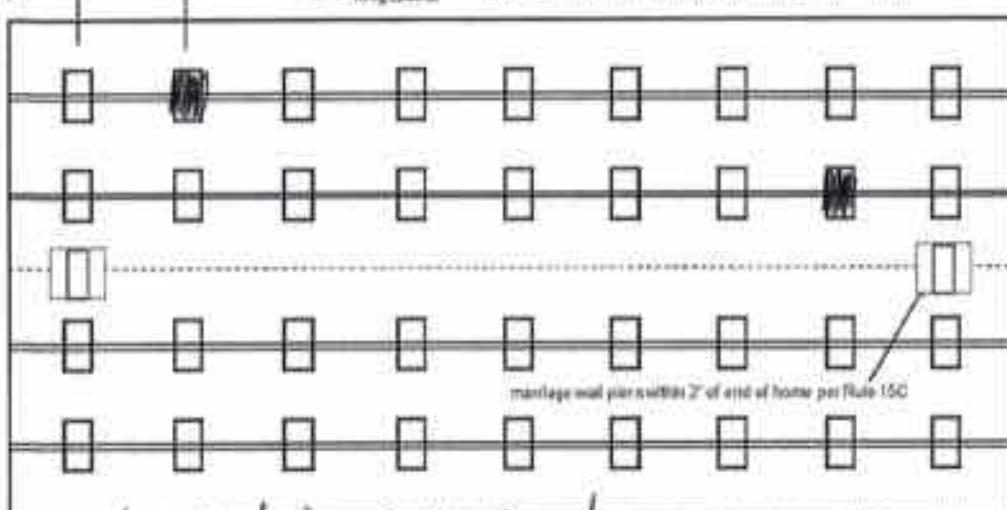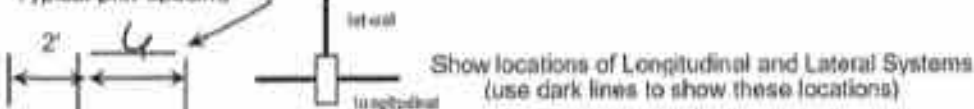

11010 All steel
21 17x25 ABS I-beam 6' oc

Application Number: _____ Date: _____

New Home ☐ Used Home ☒

Home installed to the Manufacturer's Installation Manual ☒
Home is installed in accordance with Rule 15-C

Single wide ☒ Wind Zone II ☒ Wind Zone III ☐

Double wide ☐ Installation Decal # 121472

Triple/Quad ☐ Serial # FLFLN70A2D344CM/2662A

PIER SPACING TABLE FOR USED HOMES

Load bearing capacity	Footer size (sq in)	16" x 16" (256)	18 1/2" x 18 1/2" (342)	20" x 20" (400)	22" x 22" (484)*	24" x 24" (576)*	26" x 26" (676)
1000 psf		3'	4'	5'	6'	7'	8'
1500 psf		4' 6"	5'	7'	8'	8'	8'
2000 psf		6'	6'	8'	8'	8'	8'
2500 psf		7' 6"	8'	8'	8'	8'	8'
3000 psf		8'	8'	8'	8'	8'	8'
3500 psf		8'	8'	8'	8'	8'	8'

* interpolated from Rule 15C-1 pier spacing table

PIER PAD SIZES

I-beam pier pad size 17x25

Perimeter pier pad size 16x16

Other pier pad sizes (required by the mfg.) _____

Draw the approximate locations of marriage wall openings 4 foot or greater. Use this symbol to show the piers.

List all marriage wall openings greater than 4 foot and their pier pad sizes below

Opening

Pier pad size

POPULAR PAD SIZES

Pad Size	Sq In
16 x 16	256
16 x 18	288
18.5 x 18.5	342
16 x 22.5	360
17 x 22	374
13 1/4 x 26 1/4	348
20 x 20	400
17 3/16 x 25 3/16	441
17 1/2 x 25 1/2	446
24 x 24	576
26 x 26	676

ANCHORS

5 ft

FRAME TIES

within 2' of end of home spaced at 5' 4" oc

TIEDOWN COMPONENTS

Longitudinal Stabilizing Device (LSD)
Manufacturer _____
Longitudinal Stabilizing Device w/ Lateral Arms
Manufacturer _____

OTHER TIES

Number
Sidewall _____
Longitudinal _____
Marriage wall _____
Shearwall _____

Mobile Home Permit Worksheet

POCKET PENETROMETER TEST

The pocket penetrometer tests are rounded down to 1500 psf or check here to declare 1000 lb. soil without testing.

x 1.5 x 1.5 x 1.5

POCKET PENETROMETER TESTING METHOD

1. Test the perimeter of the home at 6 locations.
2. Take the reading at the depth of the footer.
3. Using 500 lb. increments, take the lowest reading and round down to that increment.

x 1.5 x 1.5 x 1.5

TORQUE PROBE TEST

The results of the torque probe test is _____ inch pounds or check here if you are declaring 5' anchors without testing. A test showing 275 inch pounds or less will require 5 foot anchors.

Note: A state approved lateral arm system is being used and 4 ft. anchors are allowed at the sidewall locations. I understand 5 ft. anchors are required at all centerline tie points where the torque test reading is 275 or less and where the mobile home manufacturer may require anchors with 4000 lb. holding capacity.

ABJ Installer's initials

ALL TESTS MUST BE PERFORMED BY A LICENSED INSTALLER

Installer Name

Manuel Bocan

Date Tested

7-14-25

Electrical

Connect electrical conductors between multi-wide units, but not to the main power source. This includes the bonding wire between multi-wide units. Pg. 15C

Plumbing

Connect all sewer drains to an existing sewer tap or septic tank. Pg. 15C

Connect all potable water supply piping to an existing water meter, water tap, or other independent water supply systems. Pg. _____

Application Number: _____

Date: _____

Site Preparation

Debris and organic material removed

Water drainage: Natural

Swale

Pad

Other _____

Fastening multi wide units

Floor: Type Fastener: _____ Length: _____ Spacing: _____

Walls: Type Fastener: _____ Length: _____ Spacing: _____

Roof: Type Fastener: Self Length: _____ Spacing: _____

For used homes a min. 30 gauge, 8' wide, galvanized metal strip will be centered over the peak of the roof and fastened with adv. roofing nails at 2" on center on both sides of the centerline.

Gasket (weatherproofing required)

I understand a properly installed gasket is a requirement of all new and used homes and that condensation, mold, mildew and buckled marriage walls are a result of a poorly installed or no gasket being installed. I understand a strip of tape will not serve as a gasket.

Installer's initials

Type gasket

Pg. _____

Installed: CW

Between Floors: Yes

Between Walls: Yes

Bottom of ridgebeam: Yes

Weatherproofing

The bottomboard will be repaired and/or taped. Yes Yes Pg. _____

Siding on units is installed to manufacturer's specifications. Yes Yes

Fireplace chimney installed so as not to allow intrusion of rain water. Yes Yes

Miscellaneous

Skirting to be installed. Yes Yes No _____

Dryer vent installed outside of skirting. Yes _____ N/A _____

Range downflow vent installed outside of skirting. Yes _____ N/A _____

Drain lines supported at 4 foot intervals. Yes Yes

Electrical crossovers protected. Yes _____

Other: _____

Installer verifies all information given with this permit worksheet is accurate and true based on the manufacturer's installation instructions and or Rule 15C-1 & 2

Installer Signature

Manuel Bocan

Date

7-14-25

Watson - D.S.

License Number: TH / 1025396 / 1 Name: MANUEL M. BRANNAN

Order # 6664

Label # 121472

Manufacturer

Fleetwood

(Check Size of Home)

Homeowner

Adam & Kristian Ford

Year Model

1992

Single

Address

Length & Width

20 x 14

Double

City/State/Zip

Type Longitudinal System

Triple

Phone #

Type Lateral Arm System

HUD Label #

Date Installed

New Home _____ Used Home _____

Soil Bearing / PSF

Installed Wind Zone

Data Plate Wind Zone

Torque Probe / in-lbs

Note

STATE OF FLORIDA
INSTALLATION CERTIFICATION LABEL

121472

LABEL #

DATE OF INSTALLATION

MANUEL M. BRANNAN

NAME

TH / 1025396 / 1

6664

LICENSE #

ORDER #

CERTIFIES THAT THE INSTALLATION OF THIS MOBILE HOME IS
IN ACCORDANCE WITH FLORIDA STATUTES 320.8249, 320.8325
AND RULES OF THE HIGHWAY SAFETY AND MOTOR VEHICLES.

INSTRUCTIONS

PLEASE WRITE DATE OF
INSTALLATION AND AFFIX
LABEL NEXT TO HUD LABEL.
USE PERMANENT INK PEN
OR MARKER ONLY.
COMPLETE INFORMATION
ABOVE AND KEEP ON FILE
FOR A MINIMUM OF 2 YEARS.
YOU ARE REQUIRED TO
PROVIDE COPIES WHEN
REQUESTED.