

PROJECT DESCRIPTION:

39 x 450 REC SOLAR: REC450AA PURE-RX (450W) MODULES
ROOF MOUNTED SOLAR PHOTOVOLTAIC MODULES
DC SYSTEM SIZE: 17.55 kW DC STC
AC SYSTEM SIZE: 14.82 kW AC

EQUIPMENT SUMMARY

39 REC SOLAR: REC450AA PURE-RX (450W) MODULES
39 ENPHASE IQ8X-80-M-US (240V) MICRO-INVERTERS
01 FRANKLIN aGATE X ENERGY MANAGEMENT DEVICE
02 FRANKLIN aPOWER 2 BATTERY, 15 KWH

GOVERNING CODES :

FLORIDA RESIDENTIAL CODE, 8TH EDITION 2023 (FRC)
FLORIDA PLUMBING CODE, 8TH EDITION 2023 (FPC)
FLORIDA BUILDING CODE, 8TH EDITION 2023 (FBC)
FLORIDA MECHANICAL CODE, 8TH EDITION 2023 (FMC)
2020 NATIONAL ELECTRICAL CODE (NEC)
FLORIDA FIRE PREVENTION CODE, 8TH EDITION (FFPC)

ASCE 7-22 WIND DESIGN CRITERIA

ULTIMATE WIND SPEED: 130 MPH
NOMINAL WIND SPEED: 101 MPH
WIND EXPOSURE: B
RISK CATEGORY: II

SHEET INDEX

A-00 PLOT PLAN & VICINITY MAP
S-01 ROOF PLAN & MODULES
S-02 ATTACHMENT DETAILS
S-03 STRUCTURAL CALCULATIONS
E-01 ELECTRICAL SITE PLAN & BOM
E-02 ELECTRICAL LINE DIAGRAM
E-03 WIRING CALCULATIONS
E-04 SYSTEM LABELING
DS-01 MODULE DATA SHEET
DS-02 MICRO-INVERTER DATA SHEET
DS-03 BATTERY DATA SHEET
DS-04 aGATE DATA SHEET
DS-05 EXPANSION LUG KIT DATA SHEET
DS-06 RAIL DATA SHEET
DS-07 ATTACHMENT DATA SHEET

(E) DETACHED STRUCTURE (TYP.)

(E) GARAGE

ROOF #1
(39) REC SOLAR: REC450AA PURE-RX (450W) MODULES


(E) DRIVEWAY

1-STORY HOUSE

SW MEADOWLANDS DR.

DISCLAIMER :
THE SET OF PLANS FOR THIS PROJECT IS FOR DESIGNING THE PROJECT FOR BUILDING CODE COMPLIANCE. THIS DOES NOT EXPRESS OR IMPLY A PERFORMANCE GUARANTEE OF ANY KIND. CONTRACTOR RESPONSIBLE TO REVIEW AND APPROVE THE LAYOUT WITH THE END USER PRIOR TO INSTALLATION.

ALL DIMENSION AND CONDITION SHOWN ON THE SET OF PLANS IS BASED ON THE INFORMATION GIVEN. CONTRACTOR RESPONSIBLE TO FIELD VERIFY ALL CONDITION IN THE FIELD PRIOR TO INSTALLATION OR ACCEPTS FULL RESPONSIBILITY.

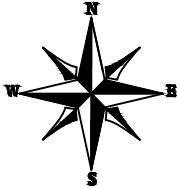

2 HOUSE PHOTO
A-00 SCALE: NTS



3 VICINITY MAP
A-00 SCALE: NTS

Digitally signed by Jeffrey A Torres
Date: 2025.06.11 '16:30:20 -04'00



POWER PRODUCTION MANAGEMENT INC
625 NW 8TH AVE.,
GAINESVILLE, FL 32601

REVISIONS

DESCRIPTION	DATE	REV
CLIENT COMMENT	06/05/2025	A
CLIENT COMMENT	06/12/2025	B

DATE: 05/26/2025

PROJECT NAME


LYE CHARLES
223 SW MEADOWLANDS DR,
LAKE CITY, FL 32024

SHEET NAME
PLOT PLAN & VICINITY MAP

SHEET SIZE
ANSI B
11" X 17"

SHEET NUMBER
A-00


Signature with Seal

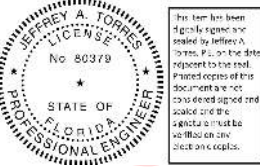


MODULE TYPE, DIMENSIONS & WEIGHT

NUMBER OF MODULES = 39 MODULES
MODULE TYPE = REC SOLAR: REC450AA PURE-RX (450W) MODULES
WEIGHT = 50.0 LBS / 22.67 KG.
MODULE DIMENSIONS = 68.0" x 47.4" = 22.38 SF

TOTAL ARRAY AREA = 872.95 SQ. FT.
TOTAL ROOF FACE AREA = 2659.60 SQ. FT.
872.95 / 2659.60= 32.82% OF ROOF
FACE AREA COVERED BY ARRAY

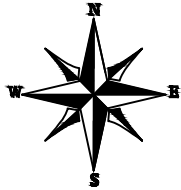

(E) BACK YARD

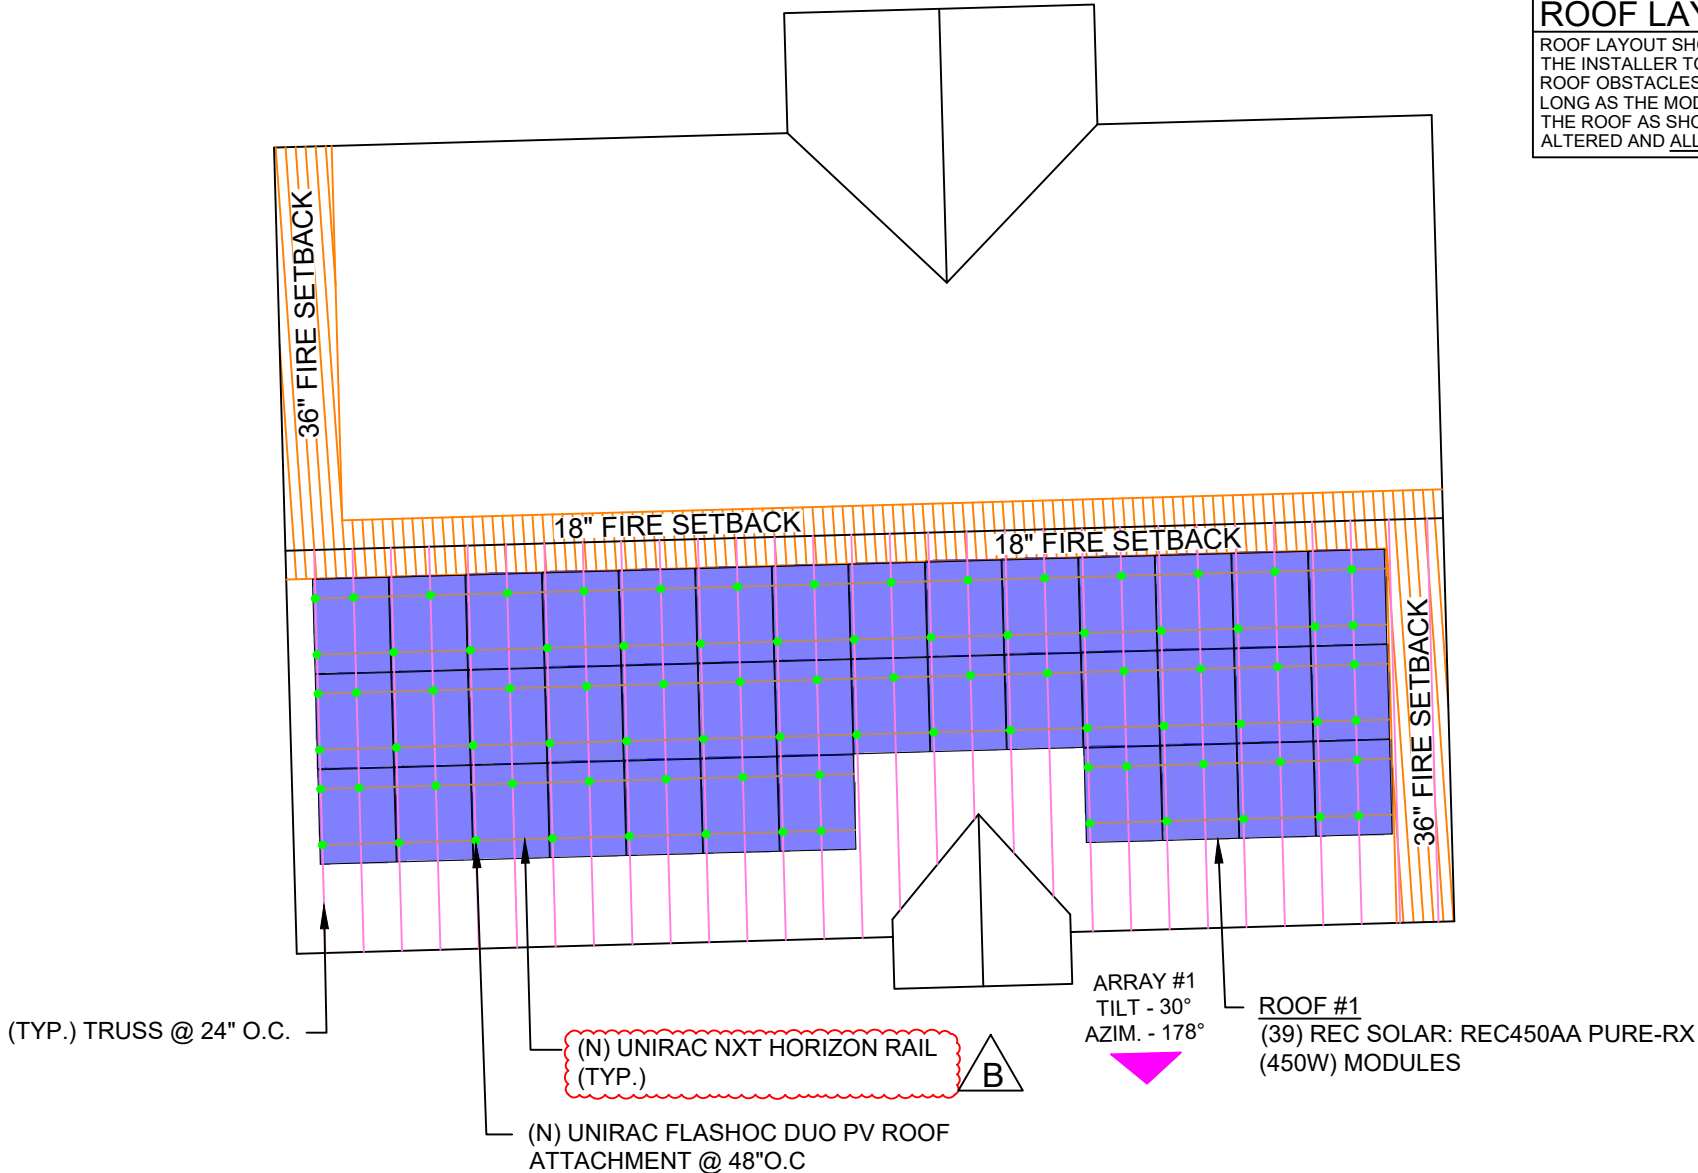


NOTE :THE METAL TRUSS LOCATIONS AND ATTACHMENT POINTS SHOWN ON SHEET S-01 IS ONLY SHOWS AN ILLUSTRATIVE REPRESENTATION OF A 2"X6" METAL TRUSS LAYOUT SPACED APPROX 24" ON CENTER WITH ATTACHMENT POINTS TO THE RAFTER . IT DOES NOT REPRESENT THE EXACT LOCATIONS AND THE CONTRACTOR IS RESPONSIBLE TO VERIFY THAT IN THE FIELD. AS LONG AS THE SPACING OF THE ROOF ATTACHMENTS AND THE RAIL CANTILEVER ARE WITHIN THE PARAMETERS ALLOWED AS STATED IN THE GENERAL STRUCTURAL NOTES SECTION ON SHEET S-03, IT COMPLIES WITH THE REQUIREMENTS OF MY DRAWINGS AND PER THE 2023 FLORIDA BUILDING BUILDING CODE (8TH EDITION).

ROOF LAYOUT NOTES

ROOF LAYOUT SHOWN MAY BE ADJUSTED IN THE FIELD BY THE INSTALLER TO ACCOUNT FOR ISSUES CAUSED BY ROOF OBSTACLES, TRUSS ALIGNMENT, OR SHADING. SO LONG AS THE MODULES ARE MOUNTED AND SECURED TO THE ROOF AS SHOWN ON S-02 THE LAYOUT MAY BE ALTERED AND ALL ROOF ORIENTATIONS MAY BE UTILIZED.

I CERTIFY THAT THE INSTALLATION OF THE MODULES IS IN COMPLIANCE WITH FBC: RESIDENTIAL CHAPTER 3. THE ADDITION OF THE SOLAR MODULES AND ALL ACCESSORIES TO THE EXISTING BUILDING WILL NOT ADVERSELY AFFECT THE STRUCTURAL INTEGRITY OF THE BUILDING AND CAN SAFELY ACCOMMODATE THE NEW IMPOSED LOADS OF THE SOLAR SYSTEM IN ACCORDANCE WITH THE FLORIDA BUILDING CODE 8TH EDITION 2023 RESIDENTIAL, CHAPTER 8.

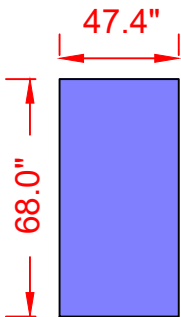

REC SOLAR:
REC450AA PURE-RX
(450W) MODULES

LEGEND

- ROOF OBSTRUCTION
- PV ROOF ATTACHMENT
- TRUSS
- RAIL

PPM.SOLAR

POWER PRODUCTION
MANAGEMENT INC
625 NW 8TH AVE.,
GAINESVILLE, FL 32601

REVISIONS		
DESCRIPTION	DATE	REV
CLIENT COMMENT	06/05/2025	A
CLIENT COMMENT	06/12/2025	B
DATE: 05/26/2025		

PROJECT NAME

LYE CHARLES

223 SW MEADOWLANDS DR,
LAKE CITY, FL 32024

SHEET NAME

ROOF PLAN &
MODULES

SHEET SIZE

ANSI B
11" X 17"

SHEET NUMBER

S-01

Signature with Seal

Digitally signed by Jeffrey A Torres
Date: 2025.06.11 16:30:30 -04'00

B

SEE (2/S-02) FOR
ENLARGED VIEW

PV MODULE

2"X6" METAL TRUSS @ 24"O.C.

DECKING

(E) ASPHALT SINGLE ROOF

1

ATTACHMENT DETAIL

S-02

SCALE: NTS

PV MODULE

GROUNDING END/MID CLAMP

UNIRAC NXT HORIZON RAIL

UNIRAC FLASHLOC DUO

DECKING

CAP ASSEMBLY
W/ 3/8" SS BOLT & NUT

(E) ASPHALT SINGLE ROOF

(2) #12 SCREW, HWH, SS, SELF-DR
WITH MIN #12 EPDM WASHER, IN.
2" EMBEDMENT INTO TRUSS
(TRUSS MOUNT)
OR
(4) #6.3X76 WOOD SCREWS FULL
EMBEDMENT
(DECK MOUNT)

2"X6" METAL TRUSS @ 24" O.C.

2

ATTACHMENT DETAIL (ENLARGED VIEW)

S-02

SCALE: NTS

PPM.SOLAR

**POWER PRODUCTION
MANAGEMENT INC**
625 NW 8TH AVE.,
GAINESVILLE, FL 32601

REVISIONS

DESCRIPTION	DATE	REV
CLIENT COMMENT	06/05/2025	A
CLIENT COMMENT	06/12/2025	B

DATE: 05/26/2025

PROJECT NAME

LYE CHARLES

223 SW MEADOWLANDS DR,
LAKE CITY, FL 32024

SHEET NAME

**ATTACHMENT
DETAILS**

SHEET SIZE

**ANSI B
11" X 17"**


SHEET NUMBER

S-02

Signature with Seal

Digitally
signed by
Jeffrey A
Torres

Date:
2025.06.11
16:30:38
'-04'00

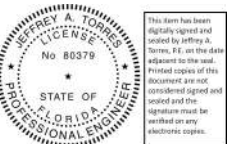

1. APPLICABLE CODES & STANDARDS:
 - 2023 FLORIDA BUILDING CODE (8TH EDITION)
 - 2023 FLORIDA RESIDENTIAL CODE (8TH EDITION)
 - ASCE-7-22 MINIMUM DESIGN LOADS FOR BUILDING AND OTHER STRUCTURES.
2. ALL FASTENERS & ANCHOR BOLTS THIS SHEET SHALL BE STAINLESS STEEL OR OTHERWISE CORROSION-RESISTANT.
3. ROOF SEALANTS SHALL CONFORM TO ASTM C920 AND ASTM 6511, AND IS THE RESPONSIBILITY OF THE CONTRACTOR TO PILOT FILL ALL HOLES. CONTRACTOR SHALL ENSURE ALL ROOF PENETRATIONS TO BE INSTALLED AND SEALED PER 2023 FLORIDA RESIDENTIAL CODE (8TH EDITION) OR LOCAL GOVERNING CODE.
4. THIS SHEET REFLECTS STRUCTURAL CONNECTIONS ONLY.
5. ALL EQUIPMENT SHALL BE INSTALLED PER MANUFACTURER INSTRUCTIONS.

SITE, MODULE, & ANCHOR INFORMATION							
VULN	130 MPH	ROOF		MODULE		ANCHOR TYPE	{2} #12, 2" EMBEDMENT
V	101 MPH	MEAN HEIGHT	15'-0"	WIDTH	47.4"		
RISK CAT.	II	TYPE	GABLE	LENGTH	68"		
EXP.	B	PITCH	7/12	MOUNTING	SHORT-AXIS		

- PLUS AND MINUS SIGNS SIGNIFY PRESSURES ACTING TOWARD AND AWAY FROM SURFACES, RESPECTIVELY.
- SEE DETAIL BELOW FOR WIND ZONE LOCATIONS. "----" IN TABLE INDICATE CONDITIONS WHERE INSTALLATION IS NOT ALLOWABLE OR NOT RELEVANT TO THE ROOF TYPE IN QUESTION.
- EXPOSED MODULES ARE THOSE DEFINED BY ASCE 7-22 29.4.4. SEE SHEET S-01 FOR ALL EXPOSED MODULE LOCATIONS, IF THEY EXIST.
- SCHEDULE REFLECTS COMPONENTS AND CLADDING (C&C) NOMINAL WIND PRESSURES WITH EXPOSURE AS NOTED, RISK CATEGORY AS NOTED, ENCLOSED BUILDING AND $h < 60'-0"$ PER ASCE 7-22 AND 2023 FLORIDA BUILDING CODE.
- FOR LAG BOLTS, DEPTH REQUIRED IN WOOD MEMBER SHALL EXCLUDE ANY ROOF DECKING THICKNESS.

SITE, MODULE, & ANCHOR INFORMATION							
VULN.	130 MPH	ROOF		MODULE		ANCHOR TYPE	(4) #6.3x76 WOOD SCREWS - FULL EMBEDMENT
V	101 MPH	MEAN HEIGHT	15'-0"	WIDTH	47.4"		
RISK CAT.	II	TYPE	GABLE	LENGTH	68"		
EXP.	B	PITCH	7/12	MOUNTING	SHORT-AXIS		

A diagram of a house cross-section. The roof is represented by two lines meeting at a peak. A horizontal red line is drawn across the roof, parallel to the ground. The angle between the right-hand roof slope and this horizontal line is labeled Θ' with a curved arrow.

NOTES:
1. "A" DIMENSION DEFINED PER ASCE 7-22 SHALL BE 4 FT PER FBC 2023 (8TH EDITION) FIGURE R301.2(7).
2. "Ø" DIMENSION IS ROOF PITCH, 27°-45°.

**POWER PRODUCTION
MANAGEMENT INC**
625 NW 8TH AVE.,
GAINESVILLE, FL 32601

DESCRIPTION	DATE	REV
CLIENT COMMENT	06/05/2025	A
CLIENT COMMENT	06/12/2025	B

PROJECT NAME

223 SW MEADOWLANDS DR,
LAKE CITY, FL 32024

SHEET NAME
STRUCTURAL
CALCULATIONS

ANSI B
11" X 17"

S-03

Digitally
signed by
Jeffrey A
Torres
Date:
2025.06.11
16:30:46
'-04'00




EQUIPMENT SUMMARY
DC SYSTEM SIZE: 17.55 KW DC STC
AC SYSTEM SIZE: 14.82 KW AC

(39) REC SOLAR: REC450AA PURE-RX (450W) MODULES
(03) BRANCHES OF 10 MODULES,
(01) BRANCH OF 09 MODULES

ELECTRICAL CERTIFICATION STATEMENT:

SUBJECT PV SYSTEM HAS BEEN DESIGNED TO MEET THE REQUIREMENTS OF THE NEC 2020, AND/OR THOSE SET FORTH BY THE FLORIDA SOLAR ENERGY CENTER CERTIFICATION, INCLUDING MAXIMUM NUMBER OF MODULE STRINGS, MAXIMUM NUMBER OF MODULES PER STRING, MAXIMUM OUTPUT, MODULE MANUFACTURER AND MODEL NUMBER, INVERTER MANUFACTURER AND MODEL NUMBER, AS APPLICABLE. HB1021 AMENDED F.S. 377.05 IN 2017 REMOVED THE REQUIREMENT FOR DESIGNERS TO HAVE THEIR SYSTEM DESIGNS CERTIFIED BY FSEC. THE VERBIAGE UNLESS OTHERWISE CERTIFIED BE AN ENGINEER LICENSED PURSUANT TO CHAPTER 471 USING THE STANDARDS CONTAINED IN THE MOST RECENT VERSION OF THE FLORIDA BUILDING CODE," ALLOWS LICENSED ENGINEERS TO DESIGN PV SYSTEMS ON THEIR OWN AS THEY DO IN ALL OTHER TRADES.

BILL OF MATERIALS		
EQUIPMENT	QTY	DESCRIPTION
SOLAR PV MODULE	39	REC SOLAR: REC450AA PURE-RX (450W) MODULES
MICRO-INVERTER	39	ENPHASE IQ8X-80-M-US (240V) MICRO-INVERTERS
COMBINER BOX	1	125A ENPHASE IQ COMBINER
BATTERY	2	FRANKLIN APOWER 2 BATTERY, 15 KWH
GATEWAY	1	FRANKLIN aGATE X ENERGY MANAGEMENT DEVICE
JUNCTION BOX	1	JUNCTION BOX 600V, NEMA 3R UL LISTED
FHP SWITCH	1	FHP EMRGENCY POWER OFF
BREAKER	1	15A/2P BREAKER
BREAKER	2	200A/2P BREAKER
BREAKER	2	125A/2P BREAKER
BREAKER	4	20A/2P BREAKER
BREAKER	1	80A/2P BREAKER
BREAKER	2	60A/2P BREAKER
AC DISCONNECT	1	100A RATED NON-FUSED AC DISCONNECT
BACKUP LOAD PANEL	01	125A RATED BACKUP LOAD PANEL
EXPENSION KIT	01	FRANKLINWH BACKUP LUG EXPANSION KIT
COMBINER PANEL	1	125A RATED COMBINER PANEL, 240V
RAIL	22	UNIRAC NXT HORIZON RAIL, 168 "
SPLICE	16	SPLICE KIT
GROUNDING LUG	8	GROUNDING LUG
ATTACHMENT	86	UNIRAC FLASHOC DUO PV ROOF ATTACHMENT @ 48"O.C
MID CLAMPS	70	MID CLAMPS
END CLAMPS	16	END CLAMPS

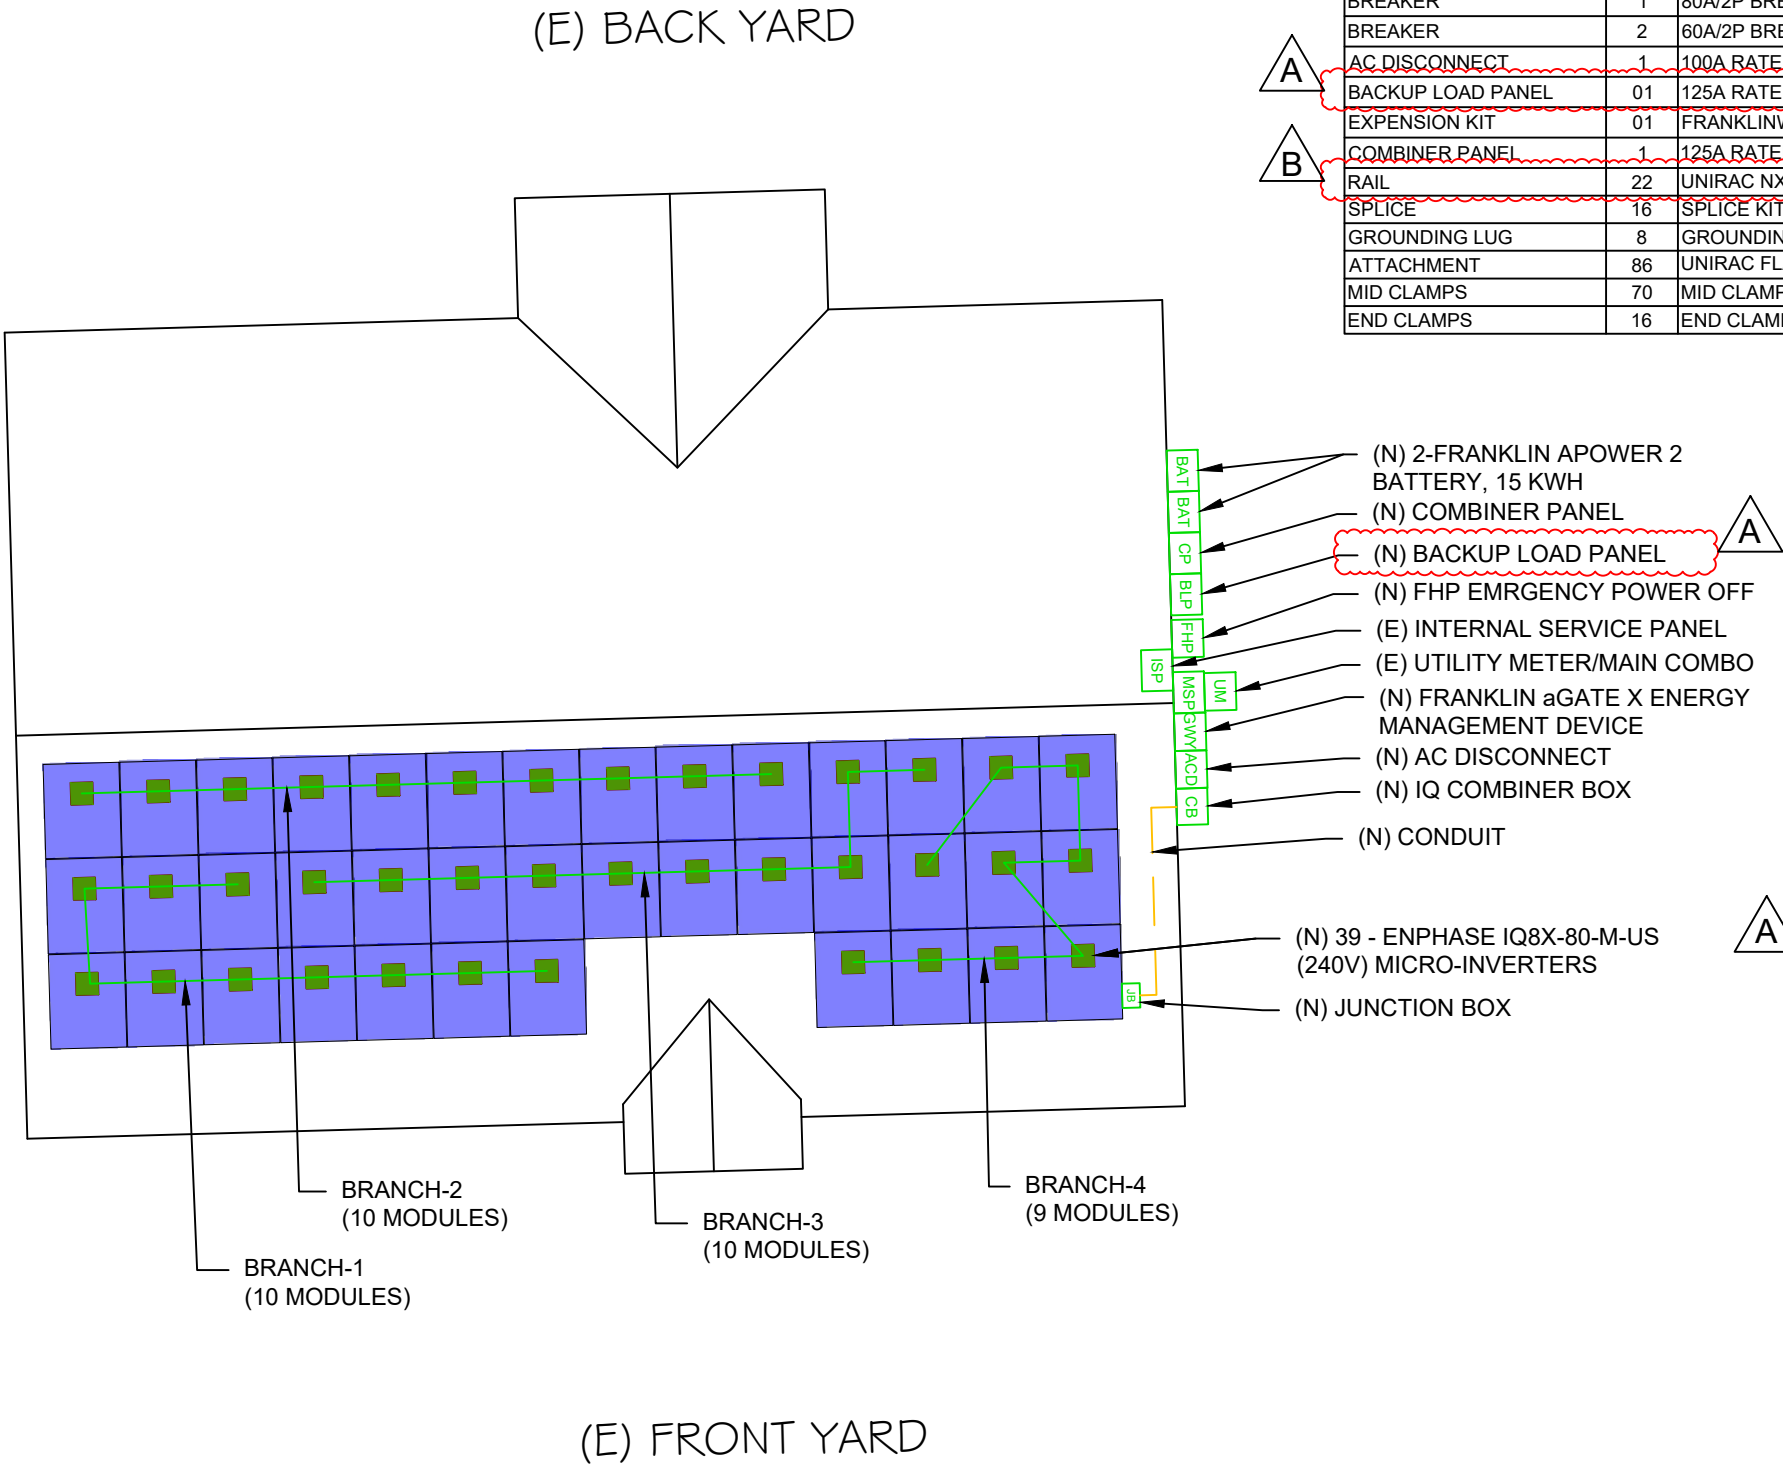

LEGEND	
<div>A</div> BLP	- BACKUP LOAD PANEL
FHP	- EMRGENCY POWER OFF
CP	- COMBINER PANEL
ACD	- AC DISCONNECT
CB	- IQ COMBINER BOX
BAT	- BATTERY
ISP	- INTERNAL SERVICE PANEL
GWY	- aGATE
UM	- UTILITY METER/MAIN COMBO
MSP	- JUNCTION BOX
JB	- JUNCTION BOX
○ □	- ROOF OBSTRUCTION
---	- CONDUIT

PPM.SOLAR

POWER PRODUCTION
MANAGEMENT INC
625 NW 8TH AVE.,
GAINESVILLE, FL 32601

REVISIONS		
DESCRIPTION	DATE	REV
CLIENT COMMENT	06/05/2025	A
CLIENT COMMENT	06/12/2025	B
DATE: 05/26/2025		

PROJECT NAME

LYE CHARLES

223 SW MEADOWLANDS DR,
LAKE CITY, FL 32024

SHEET NAME

ELECTRICAL
SITE PLAN & BOM

SHEET SIZE

ANSI B
11" X 17"

SHEET NUMBER


E-01

Signature with Seal

Digitally signed by Jeffrey A Torres
Date: 2025.06.11 16:30:55 -04'00'

JEFFREY A. TORRES
No. 86379
STATE OF FLORIDA
PROFESSIONAL ENGINEER

This item has been digitally signed and sealed by Jeffrey A. Torres, P.E. on this date and is not to be used. Printed copies of this document are not considered signed and sealed and the signature must be verified on any electronic copies.

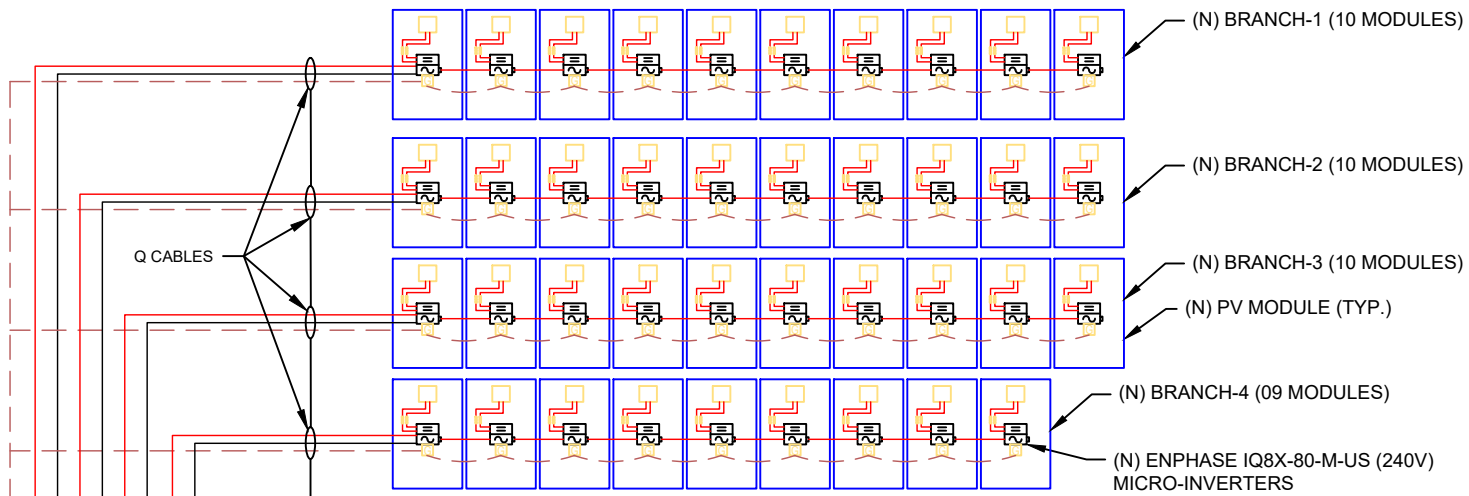

EQUIPMENT SUMMARY
DC SYSTEM SIZE: 17.55 KW DC STC
AC SYSTEM SIZE: 14.82 KW AC

(39) REC SOLAR: REC450AA PURE-RX (450W) MODULES
(03) BRANCHES OF 10 MODULES &
(01) BRANCH OF 09 MODULES

PPM.SOLAR

POWER PRODUCTION
MANAGEMENT INC
625 NW 8TH AVE.,
GAINESVILLE, FL 32601

REVISIONS		
DESCRIPTION	DATE	REV
CLIENT COMMENT	06/05/2025	A
CLIENT COMMENT	06/12/2025	B
DATE: 05/26/2025		

PROJECT NAME

LYE CHARLES

223 SW MEADOWLANDS DR,
LAKE CITY, FL 32024

SHEET NAME
**ELECTRICAL
LINE DIAGRAM-1**


SHEET SIZE
**ANSI B
11" X 17"**

SHEET NUMBER
E-02

Signature with Seal

Jeffrey A. Torres
No 80379
STATE OF FLORIDA
PROFESSIONAL ENGINEER

This document has been
electronically signed and
sealed by Jeffrey A. Torres, P.E. on the date
adjacent to the seal.
Printed copies of this
document are not
considered signed and
sealed and the
signature must be
verified on any
electronic copies.

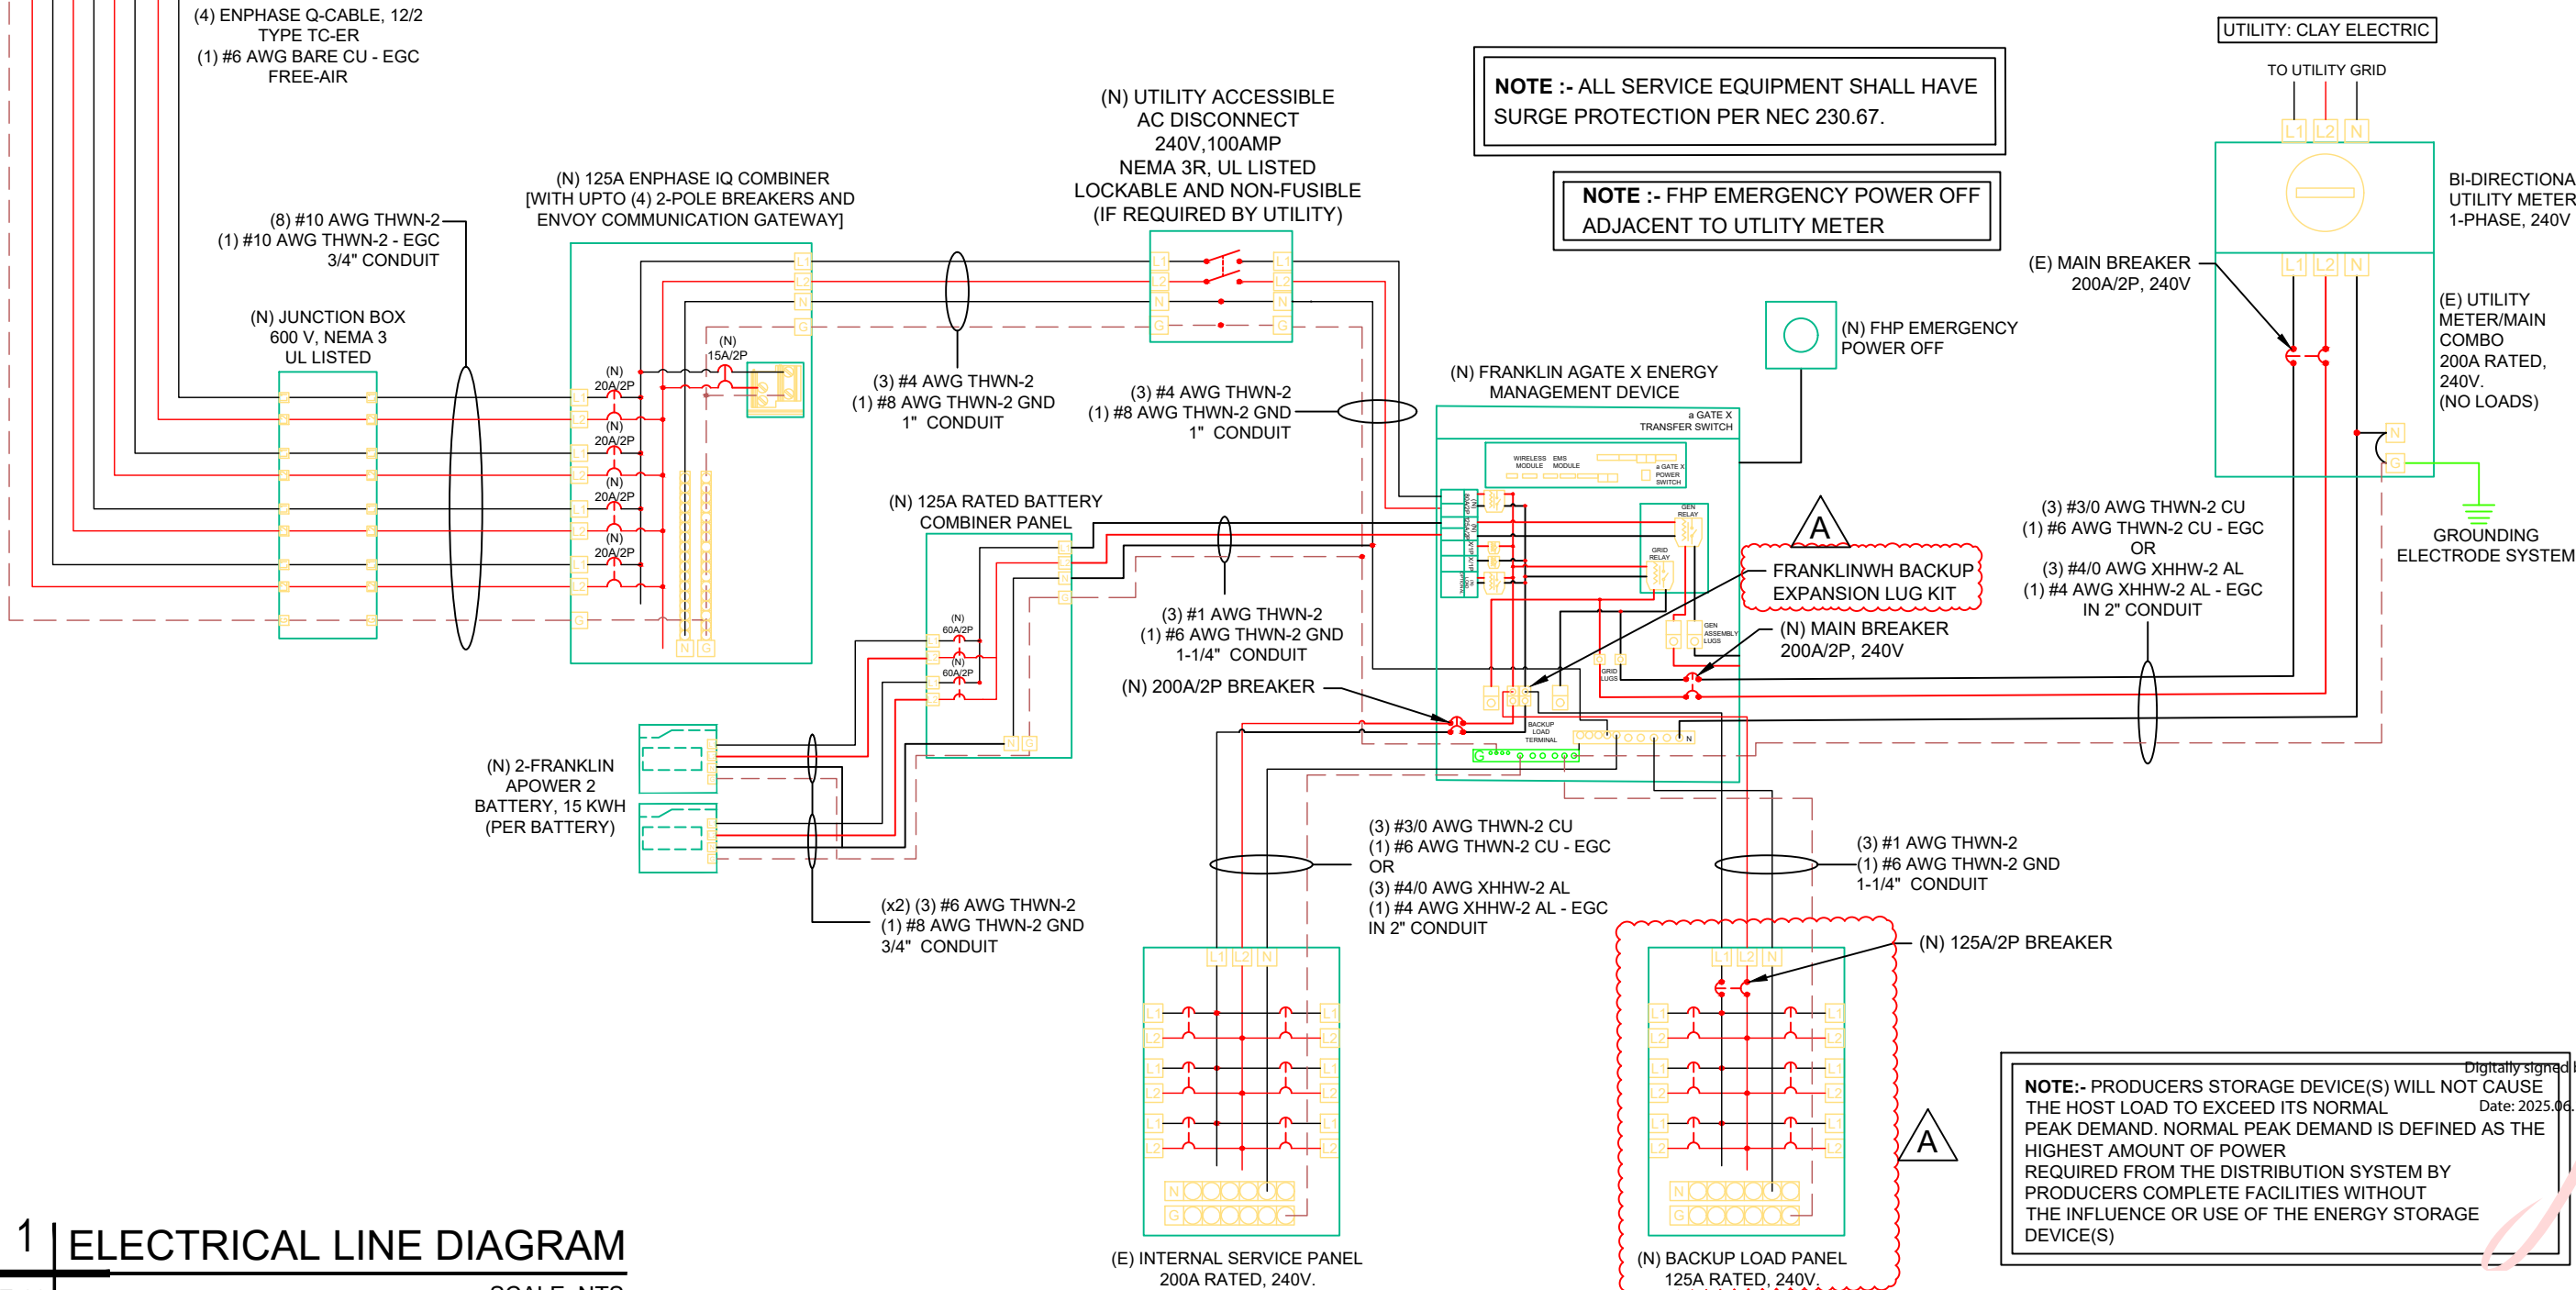

**NOTE :- ALL SERVICE EQUIPMENT SHALL HAVE
SURGE PROTECTION PER NEC 230.67.**

**NOTE :- FHP EMERGENCY POWER OFF
ADJACENT TO UTILITY METER**

**NOTE:- PRODUCERS STORAGE DEVICE(S) WILL NOT CAUSE
THE HOST LOAD TO EXCEED ITS NORMAL
PEAK DEMAND. NORMAL PEAK DEMAND IS DEFINED AS THE
HIGHEST AMOUNT OF POWER
REQUIRED FROM THE DISTRIBUTION SYSTEM BY
PRODUCERS COMPLETE FACILITIES WITHOUT
THE INFLUENCE OR USE OF THE ENERGY STORAGE
DEVICE(S)**

SOLAR MODULE SPECIFICATIONS	
MANUFACTURER / MODEL #	REC SOLAR: REC450AA PURE-RX (450W) MODULES
VMP	54.3V
IMP	8.29A
VOC	65.6V
ISC	8.81A
MODULE DIMENSION	68.0"L x 47.4"W x 1.2"D (In Inch)

MICRO-INVERTER SPECIFICATIONS	
MANUFACTURER / MODEL #	ENPHASE IQ8X-80-M-US (240V) MICRO-INVERTERS
MPPT VOLTAGE RANGE	43-60V
MAXIMUM INPUT VOLTAGE	79.5V
MAXIMUM UNIT PER BRANCH	10
MAXIMUM OUTPUT CURRENT	1.58A

AMBIENT TEMPERATURE SPECS	
RECORD LOW TEMP	-5°
AMBIENT TEMP (HIGH TEMP 2%)	30°
CONDUIT MINIMUM HEIGHT FROM ROOF	0.5"
CONDUCTOR TEMPERATURE RATING	90°
MODULE TEMPERATURE COEFFICIENT OF Voc	-0.24%/K

AC CONDUCTOR AMPACITY CALCULATIONS:
ARRAY TO JUNCTION BOX

EXPECTED WIRE TEMP (In Celsius)	30°
TEMP. CORRECTION PER TABLE (310.15)(B)(1)	1.00
# OF CURRENT CARRYING CONDUCTORS	N/A
# OF C.C. CONDUCTORS CORRECTION PER NEC 310.15(C)(1)	1.00
CIRCUIT CONDUCTOR SIZE	12 AWG
CIRCUIT CONDUCTOR AMPACITY	30A
REQUIRED CIRCUIT CONDUCTOR AMPACITY PER NEC 690.8(A) & (B)	19.75A
1.25 x MAX AC OUTPUT x MAX # OF MICROINVERTERS/CIRCUIT	
DERATED CIRCUIT CONDUCTOR AMPACITY	30.00A
Result should be greater than (19.75A)	

AC CONDUCTOR AMPACITY CALCULATIONS:
FROM JUNCTION BOX TO IQ COMBINER BOX

EXPECTED WIRE TEMP (In Celsius)	30°
TEMP. CORRECTION PER TABLE (310.15)(B)(1)	1.00
# OF CURRENT CARRYING CONDUCTORS	8
# OF C.C. CONDUCTORS CORRECTION PER NEC 310.15(C)(1)	0.70
CIRCUIT CONDUCTOR SIZE	10 AWG
CIRCUIT CONDUCTOR AMPACITY	40A
REQUIRED CIRCUIT CONDUCTOR AMPACITY PER NEC 690.8(A) & (B)	19.75A
1.25 x MAX AC OUTPUT x MAX # OF MICROINVERTERS/CIRCUIT	
DERATED CIRCUIT CONDUCTOR AMPACITY	28.00A
Result should be greater than (19.75A)	

AC CONDUCTOR AMPACITY CALCULATIONS:
FROM IQ COMBINER BOX TO ACD TO FRANKLIN
aGATE

EXPECTED WIRE TEMP (In Celsius)	30°
TEMP. CORRECTION PER TABLE (310.15)(B)(1)	1.00
# OF CURRENT CARRYING CONDUCTORS	3
# OF C.C. CONDUCTORS CORRECTION PER NEC 310.15(C)(1)	1.00
CIRCUIT CONDUCTOR SIZE	4 AWG
CIRCUIT CONDUCTOR AMPACITY	85A
REQUIRED CIRCUIT CONDUCTOR AMPACITY PER NEC 690.8(A) & (B)	77.03A
1.25 x MAX AC OUTPUT x TOTAL # OF MICROINVERTERS	
DERATED CIRCUIT CONDUCTOR AMPACITY	95.00A
Result should be greater than (77.03A)	

AC CONDUCTOR AMPACITY CALCULATIONS:
FROM COMBINER PANEL TO BATTERY

EXPECTED WIRE TEMP (In Celsius)	30°
TEMP. CORRECTION PER TABLE (310.15)(B)(1)	1.00
# OF CURRENT CARRYING CONDUCTORS	3
# OF C.C. CONDUCTORS CORRECTION PER NEC 310.15(C)(1)	1.00
CIRCUIT CONDUCTOR SIZE	6 AWG
CIRCUIT CONDUCTOR AMPACITY	65A
REQUIRED CIRCUIT CONDUCTOR AMPACITY PER NEC 690.8(A) & (B)	60.00A
1.25 x BATTERY OUTPUT CURRENT	
DERATED CIRCUIT CONDUCTOR AMPACITY	75.00A
Result should be greater than (60.00A)	

AC CONDUCTOR AMPACITY CALCULATIONS:
FROM COMBINER PANEL TO FRANKLIN aGATE

EXPECTED WIRE TEMP (In Celsius)	30°
TEMP. CORRECTION PER TABLE (310.15)(B)(1)	1.00
# OF CURRENT CARRYING CONDUCTORS	3
# OF C.C. CONDUCTORS CORRECTION PER NEC 310.15(C)(1)	1.00
CIRCUIT CONDUCTOR SIZE	1 AWG
CIRCUIT CONDUCTOR AMPACITY	130A
REQUIRED CIRCUIT CONDUCTOR AMPACITY PER NEC 690.8(A) & (B)	120.00A
1.25 x BATTERY OUTPUT CURRENT	
DERATED CIRCUIT CONDUCTOR AMPACITY	150.00A
Result should be greater than (120.00A)	

A

AC CONDUCTOR AMPACITY CALCULATIONS:
FROM FRANKLIN aGATE TO BACKUP LOAD PANEL

EXPECTED WIRE TEMP (In Celsius)	30°
TEMP. CORRECTION PER TABLE (310.15)(B)(1)	1.00
# OF CURRENT CARRYING CONDUCTORS	3
# OF C.C. CONDUCTORS CORRECTION PER NEC 310.15(C)(1)	1.00
CIRCUIT CONDUCTOR SIZE	1 AWG
CIRCUIT CONDUCTOR AMPACITY	130A
REQUIRED CIRCUIT CONDUCTOR AMPACITY PER NEC 690.8(A) & (B)	125.00A
MAX OUTPUT CURRENT	
DERATED CIRCUIT CONDUCTOR AMPACITY	150.00A
Result should be greater than (125.00A)	

ELECTRICAL NOTES

- 1.) ALL EQUIPMENT SHALL BE LISTED BY UL OR OTHER NRTL, AND LABELED FOR ITS APPLICATION.
- 2.) ALL CONDUCTORS SHALL BE COPPER, RATED FOR 600 V AND 90°C WET ENVIRONMENT.
- 3.) WIRING, CONDUIT, AND RACEWAYS MOUNTED ON ROOFTOPS SHALL BE ROUTED DIRECTLY TO, AND LOCATED AS CLOSE AS POSSIBLE TO THE NEAREST RIDGE, HIP, OR VALLEY.
- 4.) WORKING CLEARANCES AROUND ALL NEW AND EXISTING ELECTRICAL EQUIPMENT SHALL COMPLY WITH NEC 110.26.
- 5.) DRAWINGS INDICATE THE GENERAL ARRANGEMENT OF SYSTEM. CONTRACTOR SHALL FURNISH ALL NECESSARY OUTLETS, SUPPORTS, FITTINGS , AND ACCESSORIES TO MEET APPLICABLE CODES AND STANDARDS.
- 6.) WHERE SIZES OF JUNCTION BOXES, RACEWAYS, AND CONDUITS ARE NOT SPECIFIED, THE CONTRACTOR SHALL SIZE THEM ACCORDINGLY.
- 7.) ALL WIRE TERMINATIONS SHALL BE APPROPRIATELY LABELED AND ACCESSIBLE.
- 8.) INSTALL MODULE AND RACKING GROUNDING HARDWARE PER MANUFACTURER'S INSTRUCTION.

1 | WIRING CALCULATIONS

E-03

SCALE: NTS

Digitally signed
by Jeffrey A
Torres
Date:
2025.06.11
'16:31:11 -04'00

PPM.SOLAR

POWER PRODUCTION
MANAGEMENT INC
625 NW 8TH AVE.,
GAINESVILLE, FL 32601

REVISIONS		
DESCRIPTION	DATE	REV
CLIENT COMMENT	06/05/2025	A
CLIENT COMMENT	06/12/2025	B
DATE: 05/26/2025		

PROJECT NAME

LYE CHARLES

223 SW MEADOWLANDS DR,
LAKE CITY, FL 32024

SHEET NAME

WIRING
CALCULATIONS-1

SHEET SIZE

ANSI B
11" X 17"

SHEET NUMBER

E-03

Signature with Seal

JEFFREY A. TORRES
ELECTRICAL
LICENSE
No. 80378
STATE OF
FLORIDA
PROFESSIONAL ENGINEER

This has been
digitally signed and
certified by Jeffrey A.
Torres, the date
appears to the left.
The signed copy of this
document is a true
copy of the original
document and
has not been
altered in any
manner.

PHOTOVOLTAIC
POWER SOURCE

LABEL LOCATION:
EMT/CONDUIT RACEWAY
SOLADECK/JUNCTION BOX
CODE REF : NEC 690.31(D)(2) / Roll: 596-00999 / 10-Pk: 596-01007

PHOTOVOLTAIC

240V

AC DISCONNECT

LABEL LOCATION:
AC DISCONNECT
CODE REF: NEC 690.13(B), 690.15, 705.20

MAIN PHOTOVOLTAIC
SYSTEM DISCONNECT

LABEL LOCATION:
MAIN SERVICE DISCONNECT
CODE REF: NEC 690.13(B)
Roll: 596-00243 / 10-Pk: 596-00675

⚠ WARNING

ELECTRIC SHOCK HAZARD

TERMINALS ON BOTH LINE AND
LOAD SIDES MAY BE ENERGIZED
IN THE OPEN POSITION
NEC 690.13(B) & NEC 690.15(C)

LABEL LOCATION:
WHERE ALL TERMINALS OF THE DISCONNECTING MEANS
MAY BE ENERGIZED IN THE OPEN POSITION, A WARNING
SIGN SHALL BE MOUNTED ON OR ADJACENT TO THE
DISCONNECTING MEANS.
NEC 690.13(B) & NEC 690.15(C)

⚠ WARNING

THIS EQUIPMENT FED BY MULTIPLE SOURCES.
TOTAL RATING OF ALL OVERCURRENT DEVICES
EXCLUDING MAIN SUPPLY OVERCURRENT DEVICE,
SHALL NOT EXCEED AMPACITY OF BUSBAR.

LABEL LOCATION:
PERMANENT WARNING LABELS SHALL BE APPLIED TO
DISTRIBUTION EQUIPMENT
NEC 705.12(B)(3)(3)

ENERGY
STORAGE
SYSTEM
DISCONNECT

LABEL LOCATION ENERGY STORAGE SYSTEMS:
CODE REF: NEC 706.15(C)
Roll: 596-01004 / 10-Pk: 596-01041

RAPID SHUTDOWN SWITCH
FOR SOLAR PV SYSTEM

LABEL LOCATION:
AC DISCONNECT
CODE REF: NEC 690.12(D)(2)
Roll: 596-01003 / 10-Pk: 596-01040


PHOTOVOLTAIC AC DISCONNECT

NOMINAL OPERATING AC VOLATGE **240 V**
RATED AC OUTPUT CURRENT **61.62 A**

LABEL LOCATION:
AC DISCONNECT
CODE REF: NEC 690.54

EMERGENCY CONTACT
PPM SOLAR
(352) 309-7727

CAUTION
MULTIPLE SOURCES OF POWER

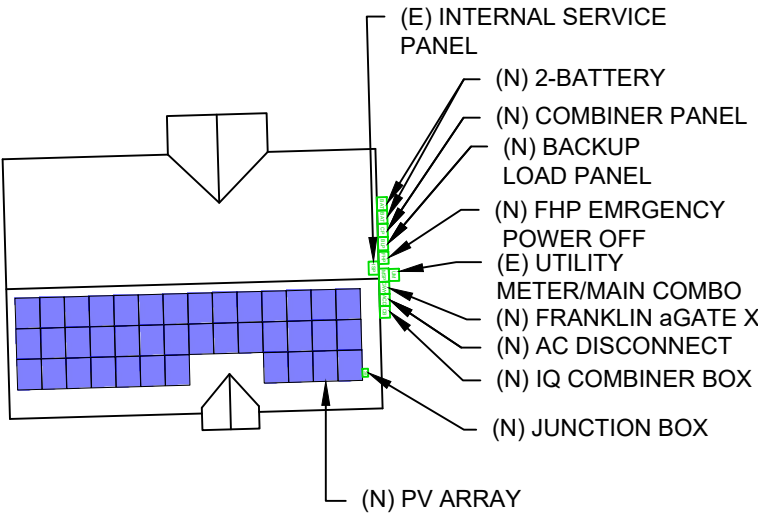


223 SW MEADOWLANDS DR, LAKE CITY, FL 32024

LABEL LOCATION:
MAIN SERVICE DISCONNECT / MAIN DISTRIBUTION PANEL, PV
DISCONNECT LOCATION NO MORE THAT 1 M (3 FT) FROM THE SERVICE
DISCONNECT PER CODE NEC 705.10 & NEC 710.10
Roll: 558-00358 OR 558-00346

SOLAR PV SYSTEM
EQUIPPED WITH RAPID
SHUTDOWN

TURN RAPID SHUTDOWN
SWITCH TO THE "OFF"
POSITION TO SHUT DOWN
PV SYSTEM AND REDUCE
SHOCK HAZARD IN THE
ARRAY.

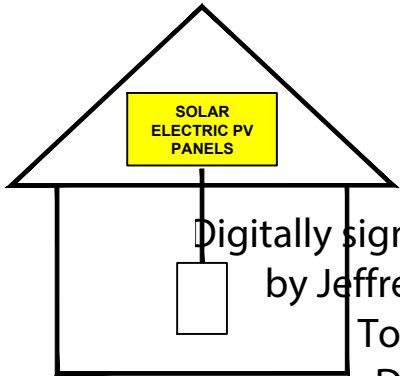

LABEL LOCATION:
ON OR NO MORE THAT 1 M (3 FT) FROM THE SERVICE DISCONNECT OR
MEANS TO WHICH THE PV SYSTEMS ARE CONNECTED.
PER CODE: IFC 605.11.3.1(1) & 690.12(D)
Roll: 596-00885 / 10-Pk: 596-00888

PPM.SOLAR

POWER PRODUCTION
MANAGEMENT INC
625 NW 8TH AVE.,
GAINESVILLE, FL 32601

REVISIONS

DESCRIPTION	DATE	REV
CLIENT COMMENT	06/05/2025	A
CLIENT COMMENT	06/12/2025	B

DATE: 05/26/2025

PROJECT NAME

LYE CHARLES


223 SW MEADOWLANDS DR,
LAKE CITY, FL 32024

SHEET NAME
SYSTEM
LABELING

SHEET SIZE
ANSI B
11" X 17"

SHEET NUMBER
E-09

Signature with Seal

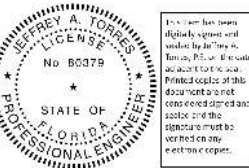

REC ALPHA[®]
PURE-RX SERIES

DATASHEET

SOLAR'S MOST TRUSTED



9 A MODULE CURRENT
COMPATIBLE WITH MLPE

450-470 W_P
HETEROJUNCTION TECHNOLOGY

22.6% MAX. EFFICIENCY
-0.24% /K TEMP. COEFF. P_{MAX}
92% MIN. POWER IN YEAR 25




REC ALPHA[®] PURE-RX SERIES
DATASHEET



GENERAL DATA

Cell Type	88 half-cut bifacial REC heterojunction cells, with gapless technology
Glass	0.13 in. solar glass with anti-reflective surface treatment in accordance with EN12150
Backsheet	Highly resistant polymer (Black)
Frame	Anodized aluminum (Black)
Junction Box	4-part, 4 bypass diodes, IP68 rated, in accordance with IEC 62790
Connectors	Stäubli MC4 PV-KB14/KST4 (12AWG) in accordance with IEC 62852, IP68 only when connected
Cable	12 AWG solar cable, 66.9 in. + 66.9 in. in accordance with EN50618
Dimensions	68 x 47.4 x 1.2 in. (22.4 ft ²)
Weight	50 lbs
Origin	Made in Singapore

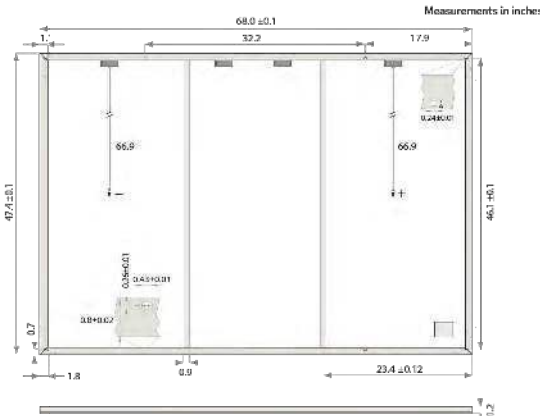

Specifications subject to change without notice.

ELECTRICAL DATA

PRODUCT CODE: RECxxxAA Pure-RX

	450	460	470
Power Output - P _{MAX} (W _P)	450	460	470
Watt Class Sorting - (W)	0/+10	0/+10	0/+10
Nominal Power Voltage - V _{MPP} (V)	54.3	54.9	55.4
Nominal Power Current - I _{MPP} (A)	8.29	8.38	8.49
Open Circuit Voltage - V _{OC} (V)	65.6	65.8	65.9
Short Circuit Current - I _{SC} (A)	8.81	8.88	8.95
Power Density (W/ft ²)	20.1	20.5	21.0
Panel Efficiency (%)	21.6	22.1	22.6

Power Output - P _{MAX} (W _P)	343	350	358
Nominal Power Voltage - V _{MPP} (V)	51.2	51.7	52.2
Nominal Power Current - I _{MPP} (A)	6.70	6.77	6.86
Open Circuit Voltage - V _{OC} (V)	61.8	62.0	62.1
Short Circuit Current - I _{SC} (A)	7.11	7.17	7.23

Values at standard test conditions (STC): air mass AM 1.5, irradiance 1000 W/m², temperature 77°F (25°C), based on a production spread with a tolerance of P_{MAX}, V_{OC} & I_{SC} ±3% within one watt class. Nominal module operating temperature (NMOT): air mass AM 1.5, irradiance 800 W/m², temperature 68°F (20°C), wind speed 3.3 m/s (7.4 mph). *Where xxx indicates the nominal power class (P_{MAX}) at STC above.

MAXIMUM RATINGS*

Operational Temperature	-40 °F - 185 °F
System Voltage	1000 V
Maximum Test Load (front)	+7000 Pa (146 lb/ft ²)
Maximum Test Load (rear)	-4000 Pa (83.4 lb/ft ²)
Max Series Fuse Rating	25 A
Max Reverse Current	25 A

*See installation manual for mounting instructions. Design load - Test load/1.5 (safety factor)

TEMPERATURE RATINGS*

Nominal Module Operating Temperature	44 °C ± 2 °C
Temperature coefficient of P _{MAX}	-0.24% /K
Temperature coefficient of V _{OC}	-0.24% /K
Temperature coefficient of I _{SC}	0.04% /K

DELIVERY INFORMATION

Panels per Pallet	33
Panels per 40 ft GP/high cube container	594 (18 Pallets)
Panels per 53 ft truck	792 (24 Pallets)

Available from:



Founded in 1996, REC Group is an international pioneering solar energy company dedicated to empowering consumers with clean, affordable solar power. As Solar's Most Trusted, REC is committed to high quality, innovation, and a low carbon footprint in the solar materials and solar panels it manufactures. Headquartered in Norway with operational headquarters in Singapore, REC also has regional hubs in North America, Europe, and Asia-Pacific.

CERTIFICATIONS

IEC 61215-2021: IEC 61730-2016: UL 61730
ISO 11925-2 Ignitability (EN 13501-1 Class E)
IEC 62716 Ammonia Resistance
IEC 61701 Salt Mist (SM6)
IEC 61215-2016 Hailstone (35mm)
UL 61730 Fire Type 2
ISO 14001; ISO 9001; IEC 45001; IEC 62941




WARRANTY

	Standard	REC ProTrust
Installed by an REC Certified Professional	No	Yes
System Size	All	<25 kW 25-500 kW
Product Warranty (yrs)	20	25
Power Warranty (yrs)	25	25
Labor Warranty (yrs)	0	10
Power in Year 1	98%	98%
Annual Degradation	0.25%	0.25%
Power in Year 25	92%	92%


REC ProTrust Warranty applies only for (i) REC panels installed by an REC Certified Solar Professional, and (ii) panels have been registered by the installer with REC. Subject to System Size and further conditions. See www.recgroup.com for details.

LOW LIGHT BEHAVIOR

Typical low irradiance performance of module at STC.

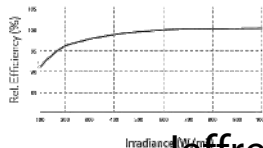

Digitally signed by
Jeffrey A Torres
Date: 2025.06.11
'16:31:35 -04'00

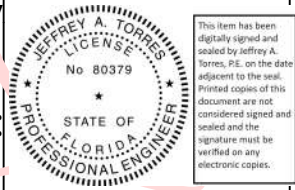

PPM.SOLAR

POWER PRODUCTION
MANAGEMENT INC
625 NW 8TH AVE.,
GAINESVILLE, FL 32601

REVISIONS

DESCRIPTION	DATE	REV
CLIENT COMMENT	06/05/2025	A
CLIENT COMMENT	06/12/2025	B

DATE: 05/26/2025

PROJECT NAME

LYE CHARLES

223 SW MEADOWLANDS DR,
LAKE CITY, FL 32024

SHEET NAME

MODULE
DATA SHEET

SHEET SIZE

ANSI B
11" X 17"

SHEET NUMBER

DS-01

Signature with Seal



DATA SHEET




IQ8X Microinverter

Our newest IQ8 Series Microinverters are the industry's first microgrid-forming*, software-defined microinverters with split-phase power conversion capability to convert DC power to AC power efficiently. The brain of the semiconductor-based microinverter is our proprietary application-specific integrated circuit (ASIC), which enables the microinverter to operate in grid-tied or off-grid mode. This chip is built using advanced 55-nm technology with high-speed digital logic and superfast response times to changing loads and grid events, alleviating constraints on battery sizing for home energy systems.

IQ8X Microinverter is the latest addition to this family, designed to support PV modules with high output DC voltage and cell counts, such as 80-half-cut cells, 88-half-cut cells and 96-cells.



Part of the Enphase Energy System, IQ8 Series Microinverters integrate with the IQ Battery, IQ Gateway, and the Enphase App monitoring and analysis software.

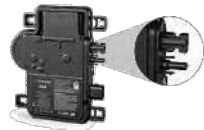

Connect PV modules quickly and easily to the IQ8 Series Microinverters with integrated MC4 connectors.

*Meets UL 1741 only when installed with IQ System Controller 2 or 3.

© 2024 Enphase Energy. All rights reserved. Enphase, the e and CC logos, IQ, and certain other marks listed at <https://enphase.com/trademark-usage-guidelines> are trademarks of Enphase Energy, Inc. in the U.S. and other countries. Data subject to change.



IQ8 Series Microinverters redefine reliability standards with more than one million cumulative hours of power-on testing, enabling an industry-leading limited warranty of up to 25 years.



IQ8 Series Microinverters are UL Listed as PV rapid shutdown equipment and conform with regulations when installed according to the manufacturer's instructions.

Easy to install

- Lightweight and compact with plug-and-play connectors
- Power line communication (PLC) between components
- Faster installation with simple two-wire cabling

High productivity and reliability

- Produces power even when the grid is down*
- More than one million cumulative hours of testing
- Class II double-insulated enclosure
- Optimized for the latest high-powered PV modules

Microgrid-forming

- Complies with the latest advanced grid support
- Remote automatic updates for the latest grid requirements
- Configurable to support a wide range of grid profiles
- Meets CA Rule 21 (UL 1741-SA) and IEEE 1547:2018 (UL 1741-SB)

NOTE:

- IQ8 Series Microinverters cannot be mixed with previous generations of Enphase microinverters (IQ7 Series, IQ6 Series, and so on) in the same system.
- IQ Microinverters ship with default settings that meet North America's IEEE 1547 interconnection standard requirements. Region-specific adjustments may be requested by an Authority Having Jurisdiction (AHJ) or utility representative, according to the IEEE 1547 interconnection standard. An IQ Gateway is required to make these changes during installation.

IQ8X-MC4-DSH-00185-3.0-EN-US-2024-02-12

IQ8X Microinverter

INPUT DATA (DC)	UNIT	IQ8X-80-M-US
Commonly used module pairings ¹	W	320-540
Module compatibility	—	To meet compatibility, PV modules must be within the following maximum input DC voltage and maximum module I_{sc} . Module compatibility can be checked at https://enphase.com/installers/microinverters/calculator
MPPT voltage range	V	43-60
Operating range	V	25-79.5
Minimum and maximum start voltage	V	30-79.5
Maximum input DC voltage	V	79.5
Maximum continuous operating DC current	A	10
Maximum input DC short-circuit current	A	16
Maximum module I_{sc}	A	13
Overvoltage class DC port	—	II
DC port backfeed current	mA	0
PV array configuration	—	Ungrounded array; no additional DC side protection required; AC side protection requires a maximum of 20 A per branch circuit

OUTPUT DATA (AC)	UNIT	IQ8X-80-M-US @240 VAC	IQ8X-80-M-US @208 VAC
Peak output power	VA	384	366
Maximum continuous output power	VA	380	360
Nominal grid voltage (L-L)	V	240, split-phase (L-L), 180°	208, single-phase (L-L), 120° ⁴
Minimum and maximum grid voltage ²	V	211-264	183-229
Max. continuous output current	A	1.58	1.73
Nominal frequency	Hz	60	
Extended frequency range	Hz	47-68	
AC short circuit fault current over three cycles	Arms	2.70	
Maximum units per 20 A (L-L) branch circuit ³	—	10	9
Total harmonic distortion	%	<5	
Overvoltage class AC port	—	III	
AC port backfeed current	mA	18	
Power factor setting	—	1.0	
Grid-tied power factor (adjustable)	—	0.85 leading ... 0.85 lagging	
Peak efficiency	%	97.3	97.0
CEC weighted efficiency	%	96.5	96.5
Night-time power consumption	mW	26	12

MECHANICAL DATA	
Ambient temperature range	-40°C to 65°C (-40°F to 149°F)
Relative humidity range	4% to 100% (condensing)
DC connector type	Stäubli MC4
Dimensions (H × W × D); Weight	212 mm (8.3") × 175 mm (6.9") × 30.2 mm (1.2"); 1.1 kg (2.43 lb)
Cooling	Natural convection - no fans
Approved for wet locations; Pollution degree	Yes; PD3
Enclosure	Class II double-insulated, corrosion-resistant polymeric enclosure
Environmental category; UV exposure rating	NEMA Type 6; outdoor

COMPLIANCE	
Certifications	CA Rule 21 (UL 1741-SA), UL 62109-1, IEEE 1547:2018 (UL 1741-SB), FCC Part 15 Class B, ICES-0003 Class B, CAN/CSA-C22.2 NO. 1071-01. This product is UL Listed as PV rapid shutdown equipment and conforms with NEC 2014, NEC 2017, NEC 2020, and NEC 2023 section 690.12 and C22.1-2018 Rule 64-218 rapid shutdown of PV systems for AC and DC conductors when installed according to the manufacturer's instructions.

- (1) No enforced DC/AC ratio.
(2) Nominal voltage range can be extended beyond nominal if required by the utility.
(3) Limits may vary. Refer to local requirements to define the number of microinverters per branch in your area.
(4) IQ8X is not certified for use with Enphase Three Phase Network Protection Relay (NPR-3P-208-NA) and is, therefore, designed for single-phase operation only. Check with the local utility requirements if you wish to install single-phase inverters across three phases.

IQ8X-MC4-DSH-00185-3.0-EN-US-2024-02-12

PPM.SOLAR

POWER PRODUCTION
MANAGEMENT INC
625 NW 8TH AVE.,
GAINESVILLE, FL 32601

REVISIONS

DESCRIPTION	DATE	REV
CLIENT COMMENT	06/05/2025	A
CLIENT COMMENT	06/12/2025	B

DATE: 05/26/2025

PROJECT NAME

LYE CHARLES
223 SW MEADOWLANDS DR,
LAKE CITY, FL 32024

SHEET NAME

MICRO-INVERTER
DATA SHEET

SHEET SIZE

ANSI B
11" X 17"

SHEET NUMBER

DS-02

Signature with Seal

Digitally signed
by Jeffrey A

Torres

Date:

2025.06.11

16:31:44 -04'00



This seal is not to be used for any other purpose than the one for which it was issued. It is the responsibility of the holder to ensure that the seal is used only for the purpose for which it was issued. Any other use is prohibited.

FRANKLINWH

aPower 2
AC-coupled battery

Store solar generated power while the sun is shining. Use the stored energy when needed to lower electric bills. Run heavy loads such as air conditioners and water heaters as usual even during grid outages. Provide homeowner peace of mind by fully charging before severe weather events.

The system is off-grid ready, designed to operate independently from the main power grid to deliver reliable energy in any situation.

- ✓ 10 kW continuous / 15 kW peak for 10s
- ✓ 8 kW charge power
- ✓ 15 kWh AC¹ per unit, up to 225 kWh (15 units) per aGate
- ✓ 60 MWh warranty throughput



PERFORMANCE SPECIFICATIONS

SKU	APR-10K15V2-US				
Name	aPower 2				
Nameplate Model	aPower X-20				
Certification / CEC Listing Name	aPower Xyyy				
Battery Chemistry	Lithium Iron Phosphate (LFP)				
Usable System Energy	15 kWh AC ¹ per unit, up to 15 units per aGate				
Aggregate Throughput	60 MWh				
Real Power (charge)	8 kW continuous				
Nominal Output Power (AC)	2.5 kW	5 kW	6.7 kW	8.4 kW	10 kW ²
Maximum Apparent Power	2.9 kVA	5.8 kVA	7.7 kVA	9.6 kVA	11.5 kVA
Maximum Continuous Current	12 A	24 A	32 A	40 A	48 A
Nominal AC Voltage	120 / 240 V, 120 / 208 V (single phase), 60 Hz				
Coupling	AC-coupled				
Phase	2 W+N+PE				
Round Trip Efficiency	90% ¹				
Maximum Short-Circuit Current Rating	10 kA				
Load Start Capability	185 A LRA				

Work Modes:	Self-Consumption
	Time of Use
	Emergency Backup

Noise Emission	30 dB(A) Typical / 45 dB(A) Maximum
Flood Resistance	Up to 29" from the aPower 2 base
User Interface	FranklinWH App
Warranty	15 years ³

COMPLIANCE INFORMATION


Certifications	UL 9540, UL 9540A, UL 1973, UL 1741, UL1741 SB, UL 1741 PCS, UL 60730-1, IEEE 1547, IEEE 1547.1, UN 38.3, CSA C22.2 No. 107.1
Seismic	AC 156, OSHPD, IEEE 693-2005 (high)
Environmental	California Proposition 65 RoHS Directive 2011 / EU
Emissions	FCC Part 15 Class B, ICES 003

- ¹ At beginning of life, 3 kW charge/discharge power, 77 °F (25 °C).
- ² Refer to the installation manual and commissioning guide for proper wire and OCPD sizes.
- ³ For more details, please refer to the FranklinWH System Limited Warranty for End Users available in the Documentation Center on the FranklinWH website.

WWW.FRANKLINWH.COM

MECHANICAL SPECIFICATIONS

Dimensions (H x W x D)	45.2 in x 29.5 in x 11.8 in (1149 mm x 750 mm x 300 mm)
Weight, aPower 2 Complete	357 lb. (162 kg)
Weight, without Cover	335 lb. (152 kg)
Weight, Cover	22 lb. (10 kg)
Mounting	Wall or floor mount
Cooling	Natural air-cooled design

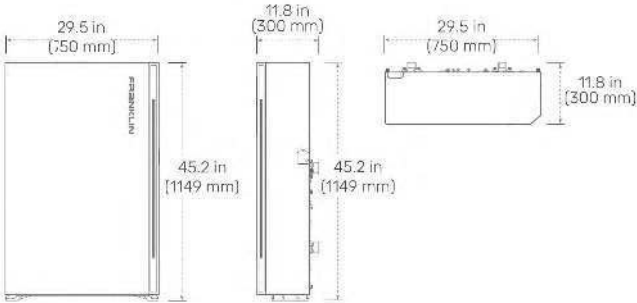

ENVIRONMENTAL SPECIFICATIONS

Enclosure Type	Type 3R
Ingress Protection	IP56 (Wiring) IP67 (Battery Pack & Inverter)
Operating Temperature	-4 °F to 122 °F (-20 °C to 50 °C) Operates up to 131 °F (55 °C) at 5kW derated output
Operating Humidity (RH)	Up to 100% RH, condensing
Altitude	Maximum 9,843 ft (3,000 m)
Environment	Indoor and outdoor rated

Compatibility Notice: At launch, the aPower 2 is compatible with the aGate 1.3 only. Compatibility with earlier aGate and aPower versions is anticipated by the end of Q2 2025.

Copyright 2025 FranklinWH Energy Storage Inc. All rights reserved. The Franklin logo, FranklinWH, and other trademarks or service names are the trademarks of FranklinWH Energy Storage Inc. This document is for informational purposes only, data subject to change. 2025-3-31

PPM.SOLAR

POWER PRODUCTION
MANAGEMENT INC
625 NW 8TH AVE.,
GAINESVILLE, FL 32601

REVISIONS

DESCRIPTION	DATE	REV
CLIENT COMMENT	06/05/2025	A
CLIENT COMMENT	06/12/2025	B

DATE: 05/26/2025

PROJECT NAME

LYE CHARLES
223 SW MEADOWLANDS DR,
LAKE CITY, FL 32024


SHEET NAME
BATTERY
DATA SHEET

SHEET SIZE
ANSI B
11" X 17"

SHEET NUMBER
DS-03

Signature with Seal

Digitally signed
by Jeffrey A
Torres
Date:
2025.06.11
'16:31:54 -04'00

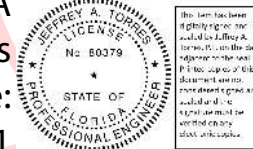

FRANKLINWH

aGate

Intelligent energy management system

The aGate serves as the controller for all home power sources by interconnecting solar, grid, batteries, and a standby generator to supply electricity to the home. It seamlessly transitions the home supply from grid power to backup power so that always-on appliances, such as the refrigerator and network router, will not be affected when the grid goes down.

The aGate can be installed at the service entrance, connected to the main load center, or used as a load center.



Robust

- ✓ Micro-grid interconnect device (MID)
- ✓ EMS Integrated PV and grid metering
- ✓ UL1741 certified PCS function & 280A busbar to avoid Main Panel Upgrades
- ✓ 12-year limited warranty



Flexible

- ✓ Compatible with micro and string solar inverter
- ✓ Indoor and outdoor / wall-mounted



Hassle-free

- ✓ Precise control of electricity usage through Smart Circuits Module
- ✓ Standby generator integration via generator module
- ✓ Remarkable black start function ensures battery charge after a prolonged outage or extended trip
- ✓ Vehicle to loads (V2L) function to power essential home appliances during an emergency
- ✓ Commissioning through the aGate Wifi hotspot or Bluetooth



Easy installation

- ✓ Built-in design Smart Circuits and Generator Modules
- ✓ Conduit entry options from the bottom, left, or right



WWW.FRANKLINWH.COM

DATASHEET

PERFORMANCE SPECIFICATIONS


SKU	AGT-RIV2-US
Model Number	aGate X
Coupling	AC-coupled
Nominal AC Voltage	120 / 208 V, 120 / 240 V, 60 Hz
Phase	2 W+N+PE
Grid Input Over Current Protection Device	200 A Max
aPower Over Current Protection Device	125 A Max
Solar Input Over Current Protection Device	80 A Max
Backup Load Port Over Current Protection Device	200 A Max
Non-backup Load Port Over Current Protection Device	200 A Max
Generator Over Current Protection Device ¹	200 A Max
Smart Circuits Over Current Protection Device ²	Opt. a 1 × 80 A Max @ 208 V / 240 V & 1 × 50 A Max @ 208 V / 240 V Opt. b 1 × 80 A Max @ 208 V / 240 V & 2 × 50 A Max @ 120 V
Maximum Supply Fault Current	22 kA
Busbar Rating	280 A
Work Modes	Self-Consumption, Time of Use, Emergency Backup
Communications	Ethernet / 4G / Wifi / Bluetooth
User Interface	FranklinWH App
Warranty	12-year limited
IEC Protective Class	Class I
Over-voltage Category	Category II
AC Meter	+/- 0.5%

COMPLIANCE INFORMATION

Certifications	UL 1741, UL 1741 PCS, UL 67, UL 869A, UL 916, CAN / CSA C22.2 No. 107.1-16, CSA C22.2 No. 29, CSA C22.2 No. 0.19
Seismic	AC 156, USHPD, IEEE 693-2005 (high)
Environmental	California Proposition 65 RoHS Directive 2011 / EU
Emissions	FCC Part 15 Class B, ICES 003

MECHANICAL SPECIFICATIONS

Dimensions (H x W x D)	31.5 in x 21.7 in x 6.3 in (800 mm x 550 mm x 160 mm)
Weight	38.6 lb (17.5 kg)
Mounting	Wall mount

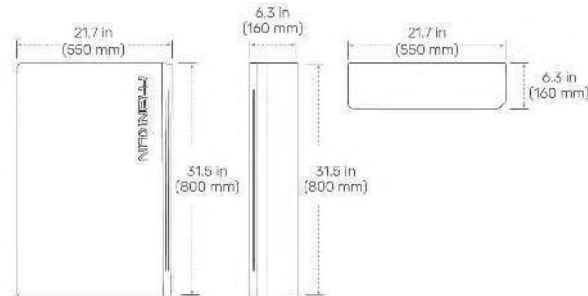


¹ Generator Module is optional.
² Smart Circuit Module is

ENVIRONMENTAL SPECIFICATIONS

Enclosure Type	NEMA Type 3R
Operating Temperature	-4°F to 122°F (-20°C to 50°C)
Operating Humidity (RH)	Up to 100% RH, condensing
Altitude	Maximum 9,843 ft (3,000 m)
Environment	Indoor and outdoor rated

Franklin Home Power Solution

Whole Home Backup

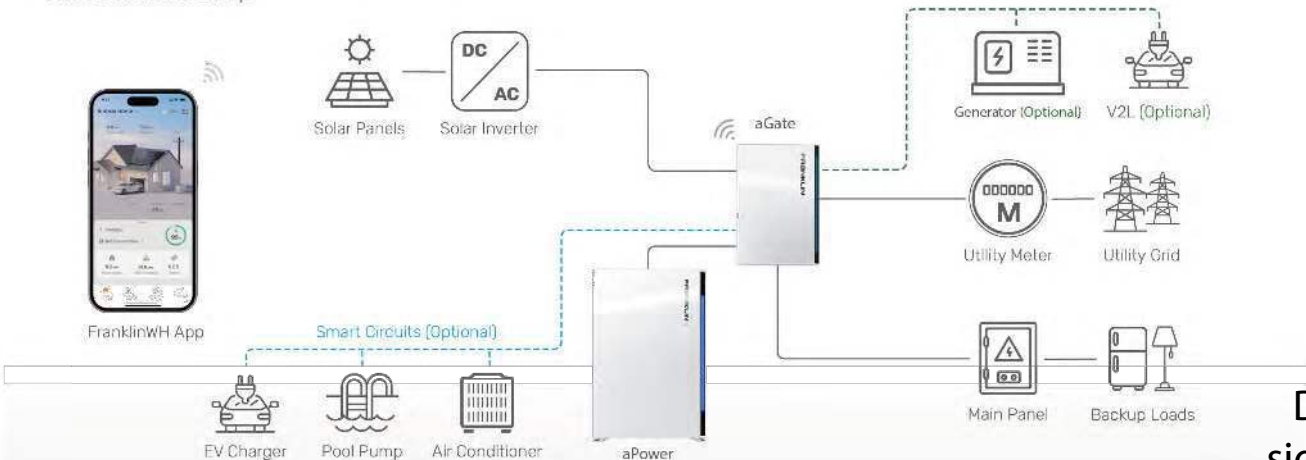

Address: 1731 Technology Dr., Suite 530 San Jose, CA 95110 Telephone: +1 888-837-2655 Email: info@franklinwh.com Website: www.franklinwh.com

Copyright 2025 FranklinWH Energy Storage, Inc. All rights reserved. The Franklin logo, FranklinWH, and other trademarks or service names are the trademarks of FranklinWH Energy Storage, Inc. This document is for informational purposes only, data subject to change. 2025-04-16

WWW.FRANKLINWH.COM

FRANKLINWH



Digitally signed by Jeffrey A Torres Date: 2025.06.11 16:32:04 -04'00

2025.06.11 16:32:04 -04'00

PPM.SOLAR

POWER PRODUCTION
MANAGEMENT INC
625 NW 8TH AVE.,
GAINESVILLE, FL 32601

REVISIONS

DESCRIPTION	DATE	REV
CLIENT COMMENT	06/05/2025	A
CLIENT COMMENT	06/12/2025	B

DATE: 05/26/2025

PROJECT NAME


LYE CHARLES
223 SW MEADOWLANDS DR,
LAKE CITY, FL 32024

SHEET NAME
aGATE
DATA SHEET

SHEET SIZE
ANSI B
11" X 17"

SHEET NUMBER
DS-04

Signature with Seal

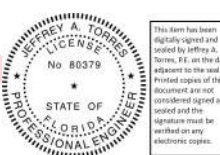

This document has been digitally signed and sealed by Jeffrey A. Torres, P.E. on the date indicated in the seal. Printed copies of this document are not considered signed and sealed and the signature must be verified on any electronic copies.

FRANKLINWH


FranklinWH Backup Expansion Lug Kit

As the demand for electricity continues to surge and more energy is generated by photovoltaic (PV) systems, there is an increasing need for larger energy storage systems to assist residents in efficiently managing household loads and PV systems. The Franklin Home Power (FHP) provides an optional Backup Expansion Lug Kit to meet homeowner needs.




Connect more aPowers

When there are up to three aPower batteries to be linked with the aGate, they can be directly connected to the aGate aPower port. For four or more aPowers, it is necessary to connect the batteries to the backup port with the Backup Expansion Lug Kit.

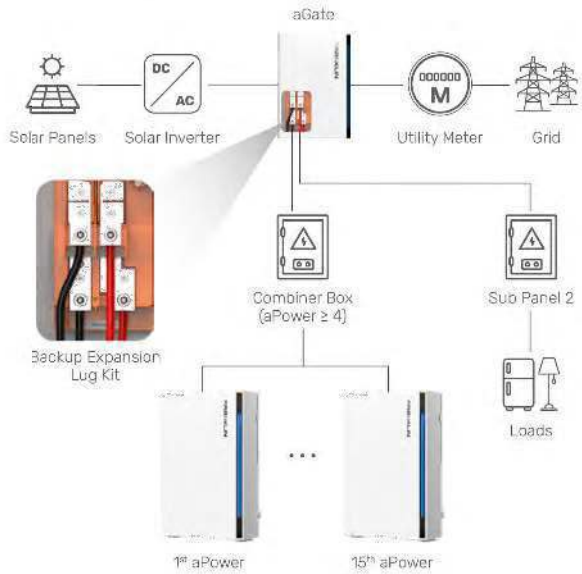

Connect more sub-panels

When there are two sub panels, they can be distributed by using the Backup Expansion Lug Kit.

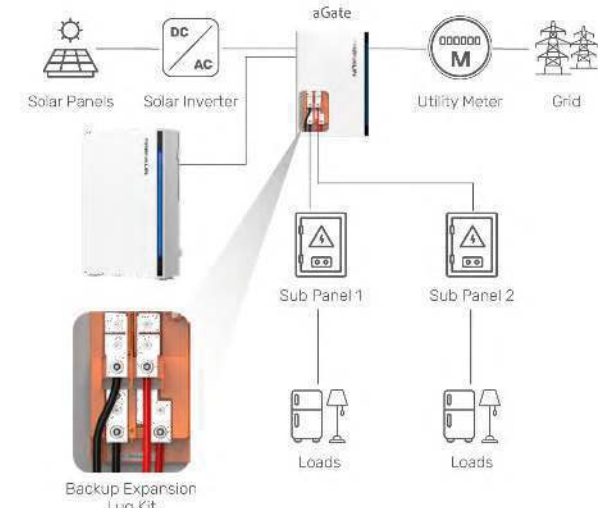

SPECIFICATIONS

Nominal AC Voltage:	120 / 208 V, 120 / 240 V, 60 Hz
Maximum Continuous Current:	160 A
Dimensions (H x W x D):	6.1 x 1.0 x 1.8 in / 6.1 x 1.6 x 1.8 in (155 x 25 x 45 mm / 155 x 41 x 45 mm)
Weight:	0.66 lb (0.33 kg)


WWW.FRANKLINWH.COM

1. If using only the Backup Expansion Lug Kit, the current must not exceed 160A. If using both the Backup Expansion Lug Kit and the backup ports simultaneously, their combined current must not exceed 160A.


DATASHEET

Franklin Home Power Solution

Whole Home Backup

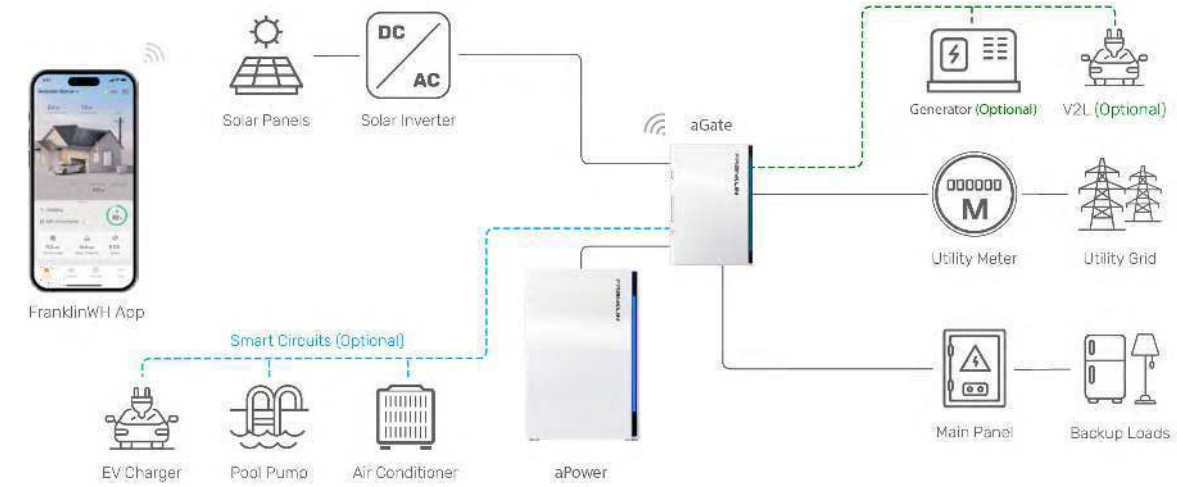

Partial Home Backup

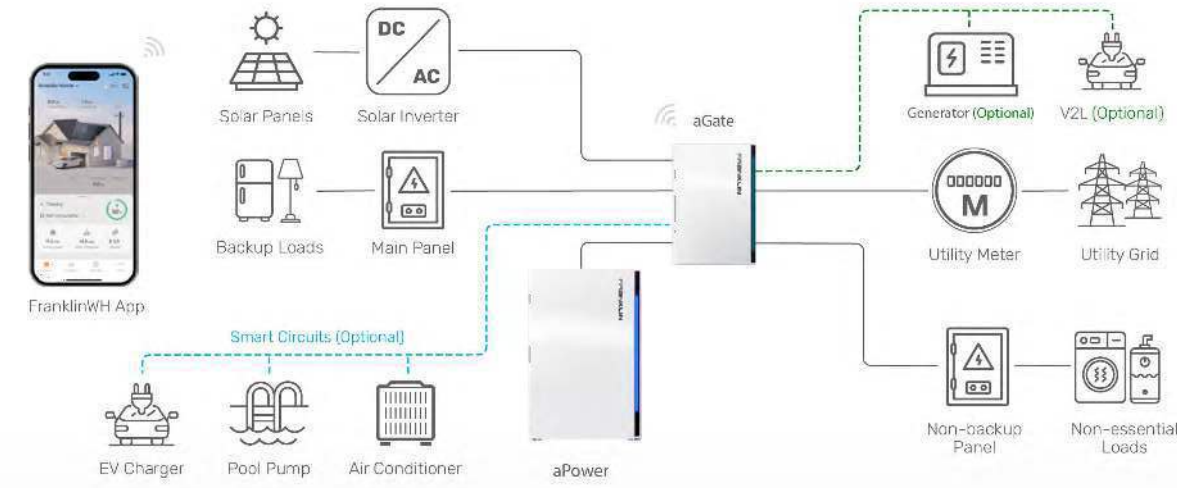

Address: 1731 Technology Dr., Suite 530 San Jose, CA 95110 Telephone: +1 888-837-2655 Email: info@franklinwh.com Website: www.franklinwh.com
Copyright 2024 FranklinWH Energy Storage Inc. All rights reserved. The Franklin logo, FranklinWH, and other trademarks or service names are the trademarks of FranklinWH Energy Storage Inc.
The document is for informational purposes only, data subject to change. 2024-12-11

WWW.FRANKLINWH.COM

FRANKLINWH

PPM.SOLAR

POWER PRODUCTION
MANAGEMENT INC
625 NW 8TH AVE.,
GAINESVILLE, FL 32601

REVISIONS

DESCRIPTION	DATE	REV
CLIENT COMMENT	06/05/2025	A
CLIENT COMMENT	06/12/2025	B

DATE: 05/26/2025

PROJECT NAME

LYE CHARLES
223 SW MEADOWLANDS DR,
LAKE CITY, FL 32024


SHEET NAME
EXPANSION LUG KIT
DATA SHEET

SHEET SIZE
ANSI B
11" X 17"

SHEET NUMBER
DS-05

Signature with Seal

Digitally signed by
Jeffrey A Torres
Date: 2025.06.11 16:32:15 -04'00

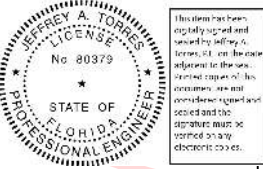

FLASHLOC™ DUO

THE MOST VERSATILE DIRECT TO DECK ATTACHMENT



BETTER SOLAR STARTS HERE

FLASHLOC™ DUO is the most versatile direct to deck and rafter attachment for composition shingle and rolled comp roofs. The all-in-one mount installs fast — no kneeling on hot roofs to install flashing, no prying or cutting shingles, no pulling nails. Simply drive the required number of screws to secure the mount and inject sealant into the base. **FLASHLOC's** patented TRIPLE SEAL technology preserves the roof and protects the penetration with a permanent pressure seal. Kitted with two rafter screws, sealant and hardware for maximum convenience (deck screws sold separately). Don't just divert water, **LOC it out!**



PROTECT THE ROOF

Install a high-strength waterproof attachment without lifting, prying or damaging shingles.

APRIL2021_FLASHLOC2DUO_V1



LOC OUT WATER

With an outer shield **1** contour-conforming gasket **2** and pressurized sealant chamber **3** the Triple Seal technology delivers a 100% waterproof connection.



HIGH-SPEED INSTALL

Simply drive the required number of screws and inject[®] sealant into the port **4** to create a permanent pressure seal.

FLASHLOC™ DUO

INSTALLATION GUIDE



BETTER SOLAR STARTS HERE




PRE-INSTALL: CLEAN SURFACE AND MARK LOCATION

Ensure existing roof structure is capable of supporting the roof attachment point loads stated in the racking system engineering specifications. Clean roof surface of dirt, debris, snow and ice.

Snap chalk lines for attachment rows. On shingle roofs, snap lines 1/4" below upslope edge of shingle course. This line will be used to align the upper edge of the mount.

NOTE: Space mounts per racking system installation specifications.

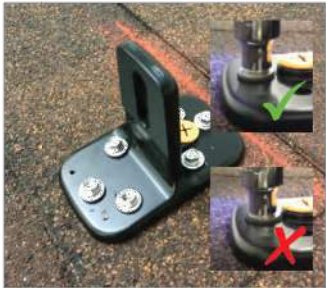

STEP ONE: SECURE

ATTACHING TO A RAFTER: Place FLASHLOC DUO over rafter location with sealant port on up-slope side and align upper edge of mount with horizontal chalk line. Secure mount with the two (2) provided rafter screws. **BACKFILL ALL PILOT HOLES WITH SEALANT.**

ATTACHING TO SHEATHING: Place FLASHLOC DUO over desired location with sealant port on up-slope side and align upper edge of mount with horizontal chalk line. Secure mount with the two (2) provided rafter screws. Next, secure mount with four (4) deck screws by drilling through the FLASHLOC DUO deck mount hole locations. Unirac recommends using a drill as opposed to an impact gun to prevent over-tightening or stripping roof sheathing.

IMPORTANT: SECURELY ATTACH MOUNT BUT DO NOT OVERTIGHTEN SCREWS.



STEP TWO: SEAL

Insert tip of UNIRAC approved sealant into port and inject until sealant exits vent. Follow sealant manufacturer's instructions. Follow sealant manufacturer's cold weather application guidelines, if applicable.

NOTE: When FLASHLOC DUO is installed over gap between shingle tabs or vertical joints, fill gap/joint with sealant between mount and upslope edge of shingle course.

CUT SHINGLES AS REQUIRED: DO NOT INSTALL THE FLASHLOC SLIDER ACCROSS THICKNESS VARIATIONS GREATER THAN 1/8" SUCH AS THOSE FOUND IN HIGH DEFINITION SHINGLES.

NOTE: If an exploratory hole falls outside of the area covered by the sealant, flash hole accordingly. **NOTE:** Read and comply with the Flashloc Duo Design & Engineering Guide prior to design and installation of the system.



USE ONLY UNIRAC APPROVED SEALANTS. PLEASE CONTACT UNIRAC FOR FULL LIST OF COMPATIBLE SEALANTS.

Continue array installation. Refer to SOLARMOUNT or NXT HORIZON Installation Guide for the remaining system installation.

FASTER INSTALLATION. 25-YEAR WARRANTY.

FOR QUESTIONS OR CUSTOMER SERVICE VISIT UNIRAC.COM OR CALL (505) 248-2702

FASTER INSTALLATION. 25-YEAR WARRANTY.

FOR QUESTIONS OR CUSTOMER SERVICE VISIT UNIRAC.COM OR CALL (505) 248-2702

PPM.SOLAR

POWER PRODUCTION
MANAGEMENT INC
625 NW 8TH AVE.,
GAINESVILLE, FL 32601

REVISIONS

DESCRIPTION	DATE	REV
CLIENT COMMENT	06/05/2025	A
CLIENT COMMENT	06/12/2025	B

DATE: 05/26/2025

PROJECT NAME

LYE CHARLES
223 SW MEADOWLANDS DR,
LAKE CITY, FL 32024

SHEET NAME

ATTACHMENT
DATA SHEET

SHEET SIZE

ANSI B
11" X 17"

SHEET NUMBER

DS-07

Signature with Seal

Digitally
signed by
Jeffrey A
Torres
Date:



2025.06.11

16:32:38

'-04'00