

Mobile Home Permit Worksheet

Installation William Price Location # TH 11041936
 Address of home TRD S. H. HARRIS CTR
 being installed LAKE CITY FL 32094


Manufacturer _____ Length x width 64 x 28

NOTE: If home is a single wide fill out one half of the blocking plan.
 If home is a triple or quad wide sketch in remainder of home
 where the endwall has exceeded 5 ft 4 in

Typical pier spacing

Installer's initials WEP

Show locations of Longitudinal and Lateral Systems
 (use dark lines to show those locations)

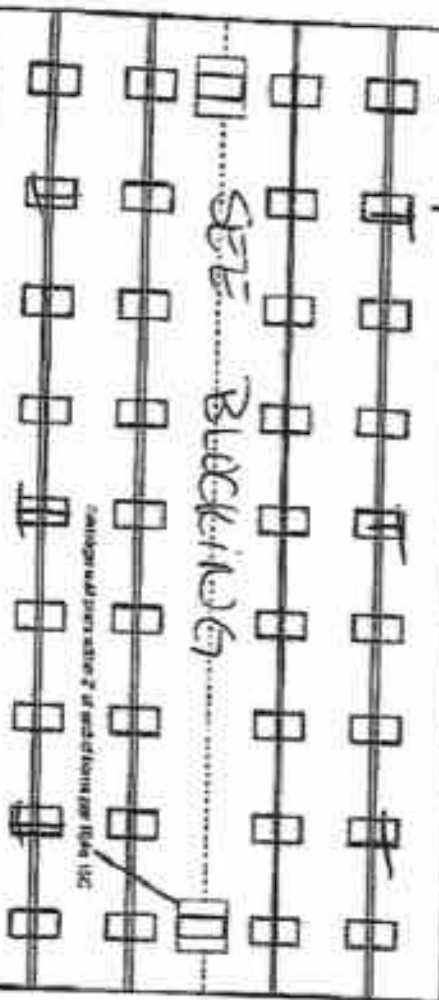

CE 71104V
ONIX System

Application Authority:

APPROVED
 By troy crews at 7:15 am, May 02, 2025

New Home ☐ Used Home ☒

I have installed to the Manufacturer's Installation Manual.
 Home is installed in accordance with Rule 15-C

Single wide ☐ Wind Zone II ☒ Wind Zone III ☐

Double wide ☒ Installation District 11919C

Trailer Quad ☐ Serial # 681CS192377A83

PIER SPACING TABLE FOR USED HOMES

Load capacity (41 lbs)	From 10' x 10' (206)	10 1/2' x 10 1/2' (242)	10' x 10' (190)	22' x 22' (404)	24' x 24' (476)	26' x 26' (516)
1000 lbs	3'	4'	5'	5'	5'	5'
1200 lbs	4'	5'	6'	6'	6'	6'
2000 lbs	6'	8'	9'	9'	9'	9'
2500 lbs	7'	9'	10'	10'	10'	10'
3000 lbs	8'	10'	11'	11'	11'	11'
3500 lbs	9'	11'	12'	12'	12'	12'

Interpolation from Rule 15-C pier spacing table

PIER PAD SIZES

I-beam pier pad size 17W25
 Perimeter pier pad size 16X16
 Other pier pad sizes (indicated by the mfg.) _____

Draw the approximate locations of marriage wall openings 4 foot or greater. Use the symbol to show the piers.

List all marriage wall openings greater than 4 foot and their pier pad sizes below

Opening large Pier pad size 23X31

POPULAR PAD SIZES

Pad Size	Sq. ft.
10 x 10	25
10 x 12	28
12 x 12	36
12 x 14	34
12 x 16	48
12 x 18	48
12 x 20	48
12 x 100	48

ANCHORS

40 X 1/2 1/2

FRAME TIES

within 2' of end of home spaced at 5' 4" oc ☒

OTHER TIES

Number 1

Longitudinal Stabilizing Device (LSD)
 Manufacturer _____
 Longitudinal Stabilizing Device w/ Lateral Arms
 Manufacturer Univertech

Sidewall Longitudinal Marriage Wall Shearwall 1

Mobile Home Permit Worksheet

POCKET PENETROMETER TEST

The pocket penetrometer tests are required down to 6 inches or check hole to determine 1000 lb soil without testing

X 1000 X 1000 X 1000

POCKET PENETROMETER TESTING METHOD

1. Test the penetrometer of the bottom of 6 locations
2. Take the reading at the depth of the border.
3. Using 500 lb. increments, take the lowest reading and round down to that number.

X 1000 X 1000 X 1000

TORQUE PROBE TEST

This results of the torque probe test is _____ inch pounds or check here if you are declaring 5' anchors without testing _____ A test showing 275 inch pounds or less will require 5 foot anchors

Note: A state approved lateral arm system is being used and 4 ft. anchors are allowed at the sidewall locations. 1 underslab 5 ft anchors are required at all centerline tie points where the torque test reading is 275 or less and where the mobile home manufacturer may require anchors with 4500 lb holding capacity

Installer's initials

ALL TESTS MUST BE PERFORMED BY A LICENSED INSTALLER

Installer Name _____

Date Tested _____

Electrical

Connect electrical conduits between multi-wide units, but not to the main power source. This includes the bonding wire between multi-wide units Pg _____

Plumbing

Connect all sewer drains to an existing sewer tap or septic tank Pg _____

Connect all potable water supply piping to an existing water meter, water tap, or other independent water supply systems. Pg _____

Application Number: _____

Date: _____

Site Preparation

Debris and organic material removed 90% 48
Water drainage Natural Swale Pond Y Other

Fastening nails with units

Floor Type Fastener: 10d Length 3 1/2" Spacing: 2'-2 1/2"
Walls Type Fastener: 8d Length 3 1/2" Spacing: 2'-2 1/2"
Roof Type Fastener: 10d Length 3 1/2" Spacing: 2'-2 1/2"

For used homes a min 30 gauge, 6" side, galvanized metal roof will be required over the peak of the roof and finished with gyl roofing nails at 2' on center on both sides of the corrugation

Insulation (separate roofing instructions)

I understand it is properly installed pocket in a requirement of all new and used homes and that construction, mdu, method and backed masonry walls are a result of a poorly installed or no gasket being installed. I understand a ship of ludo will not serve as a gasket

Installer's Initials WLD

Type pocket Foam
Pg 3

Installed Between Floors Yes 1
Between Walls Yes 1
Bottom of rib/corner Yes 1

Weatherstripping

The bottomboard will be recessed under lapert Yes 1 Pg 1
Siding on walls is installed to manufacturer's special corners Yes 1
Fireplace chimney installed so as not to allow intrusion of rain water Yes 1

Miscellaneous

Skirting to be installed Yes 1 No 1
Dryer vent installed outside of skirting Yes 1 N/A 1
Range downflow vent installed outside of skirting Yes 1 N/A 1
Drain lines supported at 4 foot intervals Yes 1
Electrical crossovers protected Yes 1
Other

Installer verifies all information given with this permit worksheet is accurate and true based on the manufacturer's installation instructions and or Rule 15C.1 & 2


Installer Signature WLD

Date 4-30-25

Robert Ford
 Parcel # 23-55-15-00468-004
 Address: TBD SW Airways 61m
 Lake City Fl 32026

28x60
 S# 68251923774

TYPICAL PIER BLOCKING

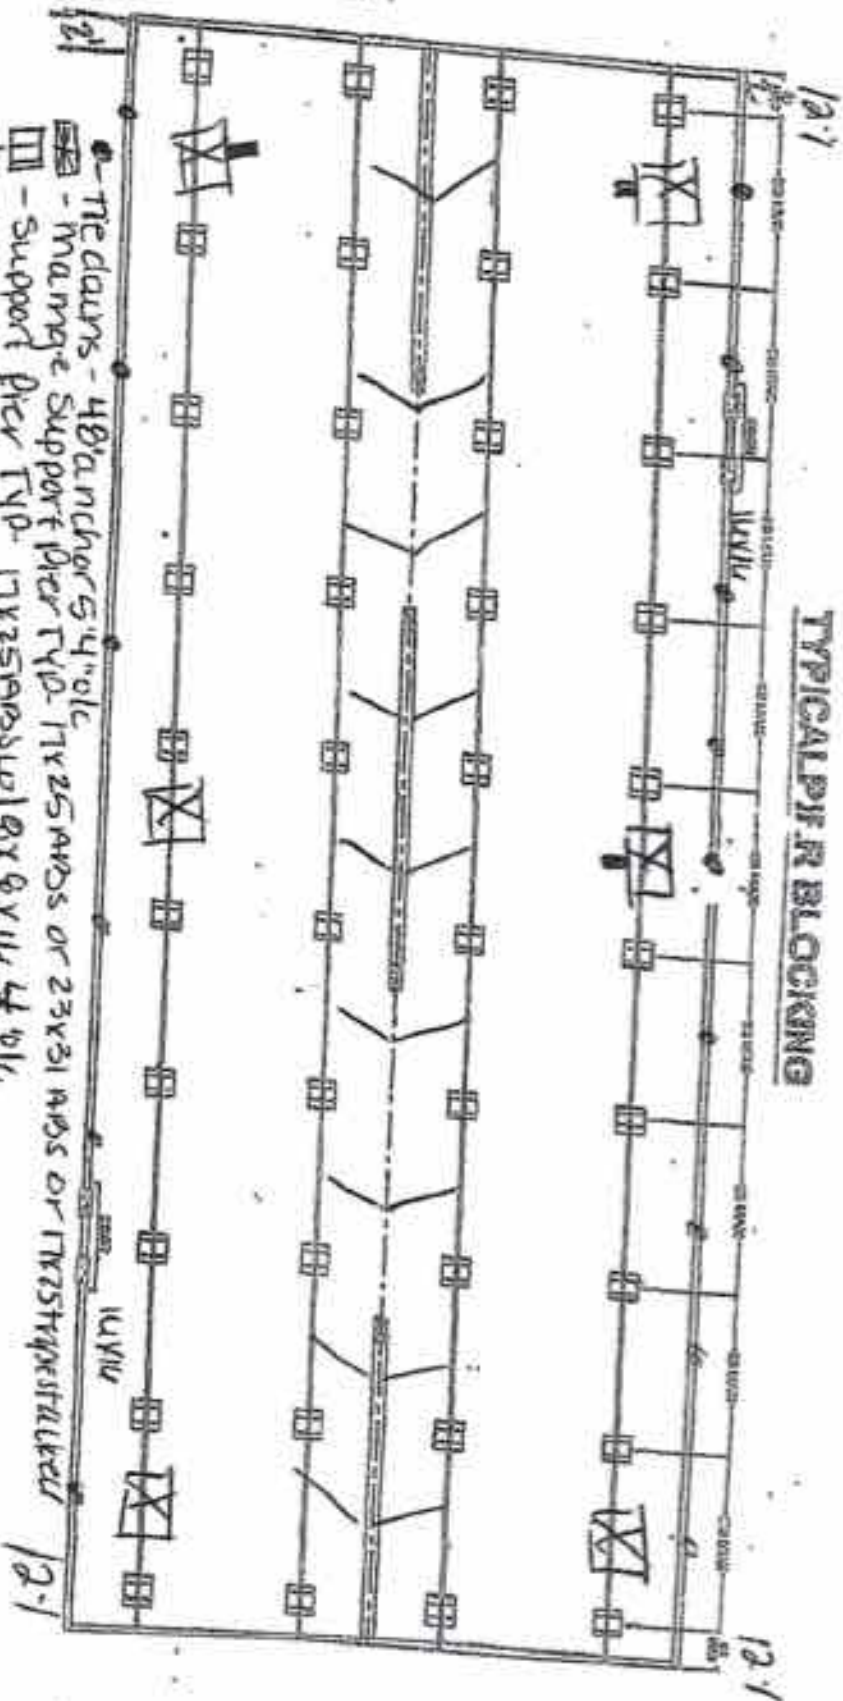

- Tie clamps - 48" anchor 5' 4" o/c
- main support pier type 17x25 AWS or 23x31 AWS or 17x25 AWS installed
- support pier type 17x25 AWS or 17x25 AWS 4' o/c
- Oliver System
- Double frame tie 48" anchor 5' from end with 12' o/c
- All perimeter idlers - 14' x 14'
- All center line shear wall anchors 4' o/c

Robert Ford

28YU4

University
Columbia

License Number: IH / 1041936 / 1 Name: WILLIAM R PRICE

Order #: 6570

Label #: 119196

Manufacturer:

(Check Size of Home)

Homeowner:

Year Model:

Single

Address:

Length & Width:

Double

City/State/Zip:

Type Longitudinal System:

Triple

Phone #:

Type Lateral Arm System:

HUD Label #:

Date Installed:

New Home: _____ Used Home: _____

Soil Bearing / PSF:

Installed Wind Zone:

Date Plate Wind Zone:

Torque Probe / in-lbs:

Note:

Permit #:

STATE OF FLORIDA
INSTALLATION CERTIFICATION LABEL

119196

LABEL #

DATE OF INSTALLATION

WILLIAM R PRICE

NAME

IH / 1041936 / 1

6570

LICENSE #

ORDER #

CERTIFIES THAT THE INSTALLATION OF THIS MOBILE HOME IS
IN ACCORDANCE WITH FLORIDA STATUTES 320.8249, 320.8325
AND RULES OF THE HIGHWAY SAFETY AND MOTOR VEHICLES

INSTRUCTIONS

PLEASE WRITE DATE OF
INSTALLATION AND AFFIX
LABEL NEXT TO HUD LABEL.
USE PERMANENT INK PEN
OR MARKER ONLY.
COMPLETE INFORMATION
ABOVE AND KEEP ON FILE
FOR A MINIMUM OF 2 YEARS.
YOU ARE REQUIRED TO
PROVIDE COPIES WHEN
REQUESTED.