


Mobile Home Permit Worksheet

Installer: Kyle Johnson License # IH/1126657
 Address of home being installed TBD SW Dewey CT
FT White, FL 32032
 Manufacturer Champion Length x width 56 x 14

NOTE: if home is a single wide fill out one half of the blocking plan
 if home is a triple or quad wide sketch in remainder of home
 I understand Lateral Arm Systems cannot be used on any home (new or used)
 where the sidewall ties exceed 5 ft 4 in.

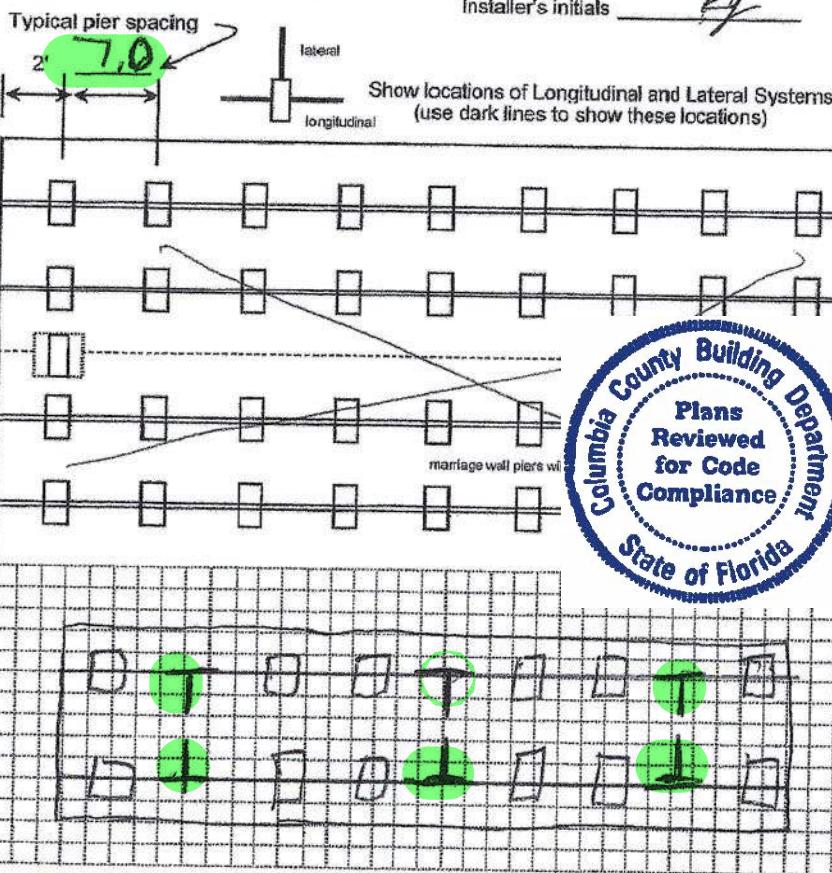

Application Number: _____ Date: _____

New Home Used Home
 Home installed to the Manufacturer's Installation Manual
 Home is installed in accordance with Rule 15-C
 Single wide Wind Zone II Wind Zone III
 Double wide Installation Decal # 115990
 Triple/Quad Serial # FL261-000-H-B-204938A

PIER SPACING TABLE FOR USED HOMES

Load bearing capacity	Footer size (sq in)	16" x 16" (256)	18 1/2" x 18 1/2" (342)	20" x 20" (400)	22" x 22" (484)*	24" x 24" (576)	26" x 26" (676)
1000 psf	3'	4'	5'	6'	7'	8'	
1500 psf	4' 6"	6'	7'	8'	8'	8'	
2000 psf	6'	8'	8'	8'	8'	8'	
2500 psf	7' 6"	8'	8'	8'	8'	8'	
3000 psf	8'	8'	8'	8'	8'	8'	
3500 psf	8'	8'	8'	8'	8'	8'	

* interpolated from Rule 15C-1 pier spacing table.

PIER PAD SIZES		POPULAR PAD SIZES	
I-beam pier pad size	<u>17.5x25.5</u>	Pad Size	SqIn
Perimeter pier pad size	<u>17.5x25.5</u>	16 x 16	256
Oliver 1055-1 outrigger bar	<u>8.0</u>	16 x 18	288
Other pier pad sizes (required by the mfg.)	<u>doors + windows</u>	18.5 x 18.5	342
		16 x 22.5	360
		17 x 22	374
		13 1/4 x 26 1/4	348
		20 x 20	400
		17 3/16 x 25 3/16	441
		17 1/2 x 25 1/2	446
		24 x 24	576
		26 x 26	676

Draw the approximate locations of marriage wall openings 4 foot or greater. Use this symbol to show the piers.

List all marriage wall openings greater than 4 foot and their pier pad sizes below.

Opening Pier pad size

See

factory blocking
Plan + manual

TIEDOWN COMPONENTS

Longitudinal Stabilizing Device (LSD)
 Manufacturer: Longitudinal Stabilizing Device w/ Lateral Arms
 Manufacturer: Oliver 1101 V

Number: 26
 Sidewall: 0
 Longitudinal: 0
 Marriage wall: 0
 Shearwall: 2

4 ft 5 ft

FRAMES TIES

within 2' of end of home
spaced at 5' 4" oc

OTHER TIES

Mobile Home Permit Worksheet

Application Number: _____ Date: _____

POCKET PENETROMETER TEST

The pocket penetrometer tests are rounded down to _____ psf or check here to declare 1000 lb. soil _____ without testing.

1000 _____ _____

POCKET PENETROMETER TESTING METHOD

1. Test the perimeter of the home at 6 locations.
2. Take the reading at the depth of the footer.
3. Using 500 lb. increments, take the lowest reading and round down to that increment.

_____ _____ 1000



TORQUE PROBE TEST

The results of the torque probe test is _____ inch pounds or check here if you are declaring 5' anchors without testing _____. A test showing 275 inch pounds or less will require 5 foot anchors.

Note: A state approved lateral arm system is being used and 4 ft. anchors are allowed at the sidewall locations. I understand 5 ft anchors are required at all centerline tie points where the torque test reading is 275 or less and where the mobile home manufacturer may requires anchors with 4000 lb holding capacity.

Kyle Johnson
Installer's initials

ALL TESTS MUST BE PERFORMED BY A LICENSED INSTALLER

Installer Name

Kyle Johnson

Date Tested

Assumed Oliver 110IV uses 4 1/2' Anchors

Electrical

Connect electrical conductors between multi-wide units, but not to the main power source. This includes the bonding wire between multi-wide units. Pg. _____

Plumbing

Connect all sewer drains to an existing sewer tap or septic tank. Pg. _____

Connect all potable water supply piping to an existing water meter, water tap, or other independent water supply systems. Pg. _____

Site Preparation

Debris and organic material removed
Water drainage: Natural Swale Pad Other _____

Fastening multi wide units

Floor: Type Fastener: Length: Spacing: _____
Walls: Type Fastener: Length: Spacing: _____
Roof: Type Fastener: Length: Spacing: _____
For used homes a min. 30 gauge, 8" wide, galvanized metal strip will be centered over the peak of the roof and fastened with galv. roofing nails at 2" on center on both sides of the centerline.

Gasket (weatherproofing requirement)

I understand a properly installed gasket is a requirement of all new and used homes and that condensation, mold, mildew and buckled marriage walls are a result of a poorly installed or no gasket being installed. I understand a strip of tape will not serve as a gasket.

Kyle Johnson
Installer's initials

Type gasket _____
Pg. _____
Installed: _____
Between Floors Yes _____
Between Walls Yes _____
Bottom of ridgebeam Yes _____

Weatherproofing


The bottomboard will be repaired and/or taped. Yes Pg. _____
Siding on units is installed to manufacturer's specifications. Yes _____
Fireplace chimney installed so as not to allow intrusion of rain water. Yes _____

Miscellaneous

Skirting to be installed. Yes No _____
Dryer vent installed outside of skirting. Yes N/A _____
Range downflow vent installed outside of skirting. Yes N/A _____
Drain lines supported at 4 foot intervals. Yes _____
Electrical crossovers protected. Yes _____
Other: _____

Installer verifies all information given with this permit worksheet is accurate and true based on the manufacturer's installation instructions and or Rule 15C-1 & 2

Installer Signature *Kyle Johnson* Date _____

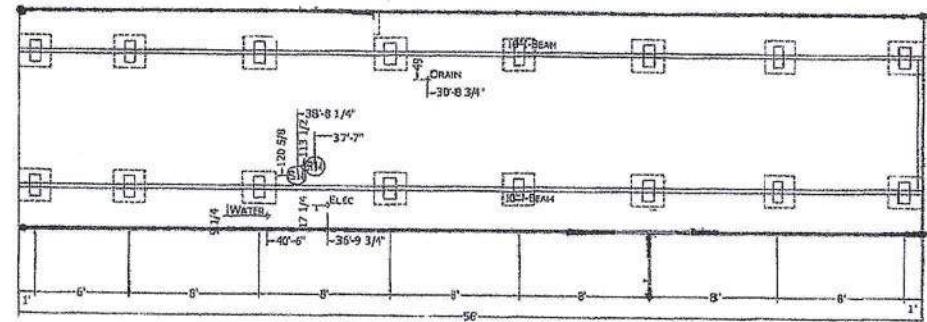

MANUFACTURER DISCLAIMER NOTICE: (THIS PIER PRINT IS FOR HOMES PRODUCED ON OR AFTER JUNE 1ST 2008)

PLEASE READ AND UNDERSTAND THE FOLLOWING INFORMATION. THE MANUFACTURER DOES NOT DO FOUNDATION INSTALLATION OF HOMES. IT WILL BE THE RESPONSIBILITY OF THE DEALER/SITE CONTRACTOR TO INSURE THAT ALL SITE WORK WILL CORRELATE WITH THE UNIT ORDERED.

NOTICE TO HOME INSTALLERS: MANUFACTURED HOMES WEIGH SEVERAL TONS. DO NOT ATTEMPT TO INSTALL ANY HOME ON SITE WITHOUT HAVING EXPERIENCE, KNOWLEDGE, AND UNDERSTANDING OF ALL INSTALLATION REQUIREMENTS. FAILURE TO MEET THESE REQUIREMENTS MAY RESULT IN SERIOUS INJURY OR DEATH TO AN INEXPERIENCED INSTALLER. INSTALLERS: PLEASE READ AND UNDERSTAND THE SETUP AND INSTALLATION MANUAL SUPPLIED WITH THE HOME BEFORE ATTEMPTING ANY INSTALLATION OF ANY MANUFACTURED HOME.

- 1) THE MANUFACTURER ASSUMES NO RESPONSIBILITY FOR ACTUAL FOUNDATION DESIGN AND CONSTRUCTION.
- 2) ADDITIONAL BLOCKING IS REQUIRED AT EACH SIDE OF EXTERIOR DOORS AND AT EACH SIDE OF SIDEWALL OPENINGS GREATER THAN 4 FEET IN WIDTH (I.E., PATIO DOORS, PICTURE WINDOWS, ETC.).
- 3) FOR PIER REQUIREMENTS AT ENDWALL SEE FIGURE 8 IN THE INSTALLATION MANUAL.
- 4) ALL DWV, PLUMBING, GAS SUPPLY, ETC., DIMENSIONS ON PRINT MAY BE + OR - 12".

- 5) IT WILL BE THE RESPONSIBILITY OF THE SITE CONTRACTOR TO VERIFY THE PROPER LOCATION OF COLUMN SUPPORT BLOCKING AND TO VERIFY THE PROPER MATING LINE GROWTH DIMENSIONS BASED UPON ACTUAL SITE CONDITIONS AND REQUIREMENTS (DOUBLE VIDES ONLY).
- 6) ALLOW 1/2" AT MATING LINE FOR MATE UP GROWTH.
- 7) SEE SET-UP AND INSTALLATION MANUAL FOR PERIMETER BLOCKING REQUIREMENTS.

PERMANENT FOUNDATIONS: CHECK LOCAL BUILDING CODES AND REGULATIONS AND CONSULT A REGISTERED PROFESSIONAL OR STRUCTURAL ENGINEER WHEN YOU ARE SITING YOUR HOME ON A PERMANENT FOUNDATION (SUCH AS A FULL BASEMENT, CRAWL SPACE, OR LOAD BEARING PERIMETER FOUNDATION).

= FRAME PIER
SEE INSTALLATION MANUAL FOR LOADS:

= POINT LOAD PIER

CHAMPION
MANUFACTURED BEAUTIFULLY™
P.O. BOX 2097 Hwy 100 East Lake City, FL 32055

MODIFICATIONS

PROJECT
261-1456H22P01
56'-0" x 13'-4"
2 BD 2 BT

DRAWN BY: Rep
DATE: 05-28-03
SCALE: 5/8" = 1'-0"

TITLE
PIER
FOUNDATION
PLAN


FILE NUMBER: 145927201

SHEET:
1


PROPERTY AND CONFIDENTIAL
THESE DRAWINGS AND SPECIFICATIONS ARE PROVIDED
FOR THE USE OF THE CONTRACTOR. REPRODUCTION OR DISSEMINATION
IN WHOLE OR IN PART IS PROHIBITED.

Champion Homes of Merit /
Lotmodel

X 2nd fl
V Stairway

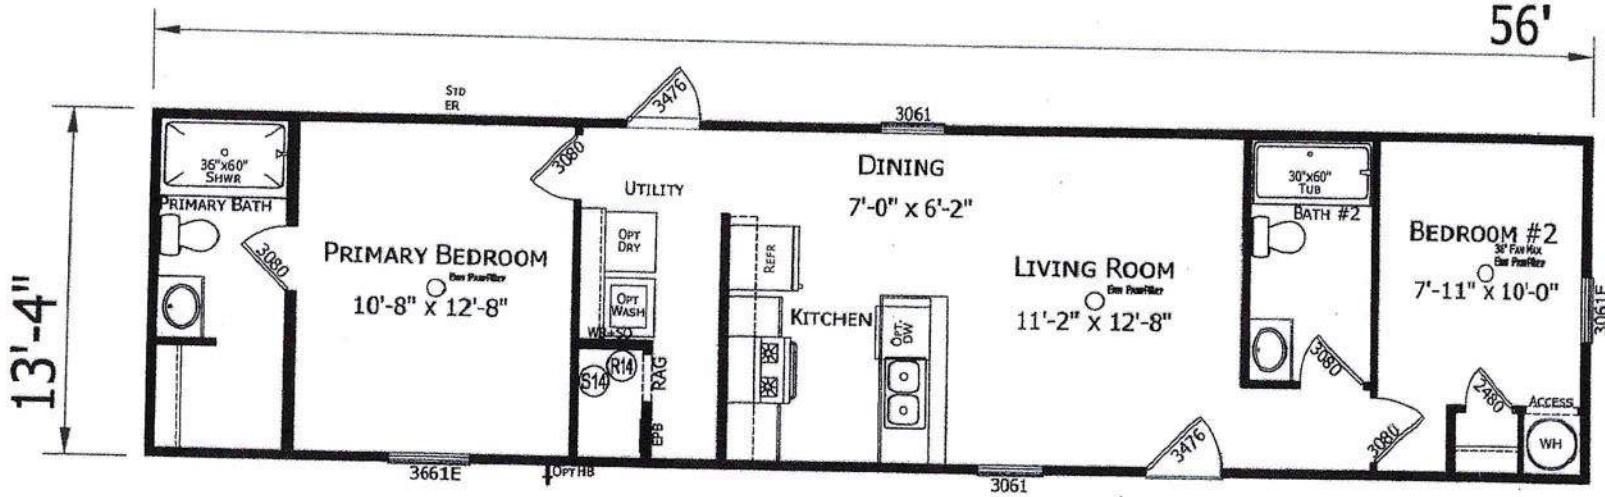

261-1456H22P01
2 BEDROOM 2 BATH
56'-0" x 13'-4"
747 Sq. Ft. TOTAL

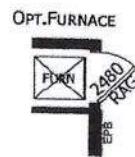

CHAMPION	MANUFACTURED BEAUTIFULLY™	MODIFICATIONS	PROJECT: 261-1456H22P01 56'-0" x 13'-4" 2 BD 2 BT	TITLE: LITERATURE PLAN	SHEET: L-101
P.O. BOX 2097 HWY 100 EAST LAKE CITY, FL 32056			DRAWN BY: Rob DATE: 05-08-23 SCALE: 3/16" = 1'-0"	FILENAME: 261-1456H22P01 11-23	Proprietary and Confidential These drawings and specifications are the original property of Champion and contain material of Champion. Copyright © 1996-2023 by Champion

License Number: IH / 1126657 / 1 Name: KYLE JOHNSON

Order #: 6429	Label #: 115990	Manufacturer:	(Check Size of Home)
Homeowner:		Year Model:	Single
Address:		Length & Width:	Double
City/State/Zip:		Type Longitudinal System:	Triple
Phone #:		Type Lateral Arm System:	HUD Label #:
Date Installed:		New Home: _____ Used Home: _____	Soil Bearing / PSF:
Installed Wind Zone:		Data Plate Wind Zone:	Torque Probe / in-lbs:
Note: _____			

STATE OF FLORIDA
INSTALLATION CERTIFICATION LABEL

115990

LABEL #
KYLE JOHNSON

DATE OF INSTALLATION

NAME

IH / 1126657 / 1

6429

LICENSE # ORDER #
CERTIFIES THAT THE INSTALLATION OF THIS MOBILE HOME IS
IN ACCORDANCE WITH FLORIDA STATUTES 320.8249, 320.8325
AND RULES OF THE HIGHWAY SAFETY AND MOTOR VEHICLES.

INSTRUCTIONS

PLEASE WRITE DATE OF
INSTALLATION AND AFFIX
LABEL NEXT TO HUD LABEL.
USE PERMANENT INK PEN
OR MARKER ONLY.
COMPLETE INFORMATION
ABOVE AND KEEP ON FILE
FOR A MINIMUM OF 2 YEARS.
YOU ARE REQUIRED TO
PROVIDE COPIES WHEN
REQUESTED.